

**Appendix CM (Field Notes And Location Maps)**

**C. M. MOLENAAR AND PARTY, U. S. GEOLOGICAL SURVEY,  
1980, 1982, 1983, 1984, 1985 FIELD SEASONS**

*by* C. M. Molenaar

*prepared for digital publication by* F. N. Zihlman, U. S. Geological Survey,  
Denver, CO

*in* The Oil and Gas Resource Potential of the 1002 Area, Arctic National  
Wildlife Refuge, Alaska, by ANWR Assessment Team, U.S. Geological  
Survey Open-File Report 98-34.

1999

This report is preliminary and has not been reviewed for conformity with U.S. Geological Survey editorial standards (or with the North American Stratigraphic Code). Use of trade, product, or firm names is for descriptive purposes only and does not imply endorsement by the U. S. Geological Survey.

**FIELD NOTES - NORTHEASTERN ALASKA**

**C.M. MOLENAAR AND PARTY**

**1980 '82, '83, '84, AND '85 FIELD SEASONS**

Contents

QUAD

80AMK-1	Kemik ss section - Sharrowik R.	Sag. B-1
2	Base of deltaic sequence - Karvik R.	MM C-5
3	Kemik ss section - Echooka R.	Sag. B-2
4	Sh overlying Kemik ss " "	" "
5	Albian (?) turbidites " "	" "
6	Lower Torok-Canning or Kps - Echooka R.	" "
7	= BOACH Nonmarine Tert. - L. Sharrowik	Sag. C-2
8	390' Kps syncline section - Kemik Cr.	" B-1
9	1200' Kingak Sh (L.K. part) " "	" "
10	Kingak - Kps section - Karvik - Canning R.	MM. B-5
11	Albian (?) turbs - W of Karvik R.	" "
12	147' Kingak Sh - Kemik sec. - W of Can. R.	" B-A
13	Base of tilted syncline section	Sag. A-2
14	Turbs on ridge " "	" "
15	" " " "	" "
16	Albian turbidites - Ivishak R.	" "
17	Recon of shal. mar. Vh sec " "	Sag. B-2
18	120' Kemik ss sec. - W bank Can. R.	MM B-4
19	Albian (?) turbs - Ridge W of " "	" "
20	Albian (?) sh " "	" "
21	Yellow wax tuff (Hue Sh) Juniper Cr.	MM B-5
22	Sh etc in upper Canning Fm - Karvik R.	" "
23	117' Kemik ss section - Fire Creek	" "
24	Mar - nonmar transition - N Sharrowik ant.	Sag. C-1
25	Paleocene turbs - W bank Can. R.	MM C-4
26	Brookian turbs, rubble etc - Ignek V.	MM C-3
27	28 & 34 with Ignek Valley section	MM C-4
82-AMH	17, 18, 47 " " " "	" "

Contents

QUAD

BDAMK-29	Paleocene slope turbs - W bank Can. R.	MM C-4
30	Deltaic ss (Sag. Fm) E " "	" "
31	" " " " E " "	" "
32	Double Kemik ss Ignek Creek	" "
33	Pebble zone in Campanian Ignek Val	" C-3
34	with Ignek Valley section	" "
35	" " " "	" C-4
36	Traverse of Cret. section - Central Ignek V.	" C-3
37	Repeated red zone	C-3
38	Kps/P.Ks contact - W fork Marsh Cr.	C-2
39	" " " " E " "	C-2
40	Kps - Kemik above P.Ks - Trib of Kat. R.	C-3
41	Cret. - Paleoc. turb section - Kat. River	" "
42	Shublik Fm - Fire Creek	" "
43	Albian (?) turbs - W of Kekipetuck River	C-2
44	" " " " NE side " "	B-2
45	Kps(?) E " " "	" "
46	Albian turbs - Headwaters of Arctic Cr.	B-1
47	" " " " E bank " "	C-1
48	" " " " " "	" "
49	Kemik ss section - Last Creek	" "
50	Kps N side Sad. Mtns	C-3
51	Fluv or turbs? ss - Nulavik - Kat. R.	D-3
52	Oil stained Tert. ss - NW bank Marsh Cr. ant.	D-2
53-57	with Battulub Ridge	" "
58-66	Sabbath Cr. section	D.P. C-5
67	Inc zone - E side Sad. R.	MM C-1
68	Kemik ss, W of Sad R., N of Sad Mtns	" "

p. 3

## Contents

## QUAD

80AMK-69	Kps, JK, & UK - Nguanah High	DP D-4
70	Jago River UK (Hut Sh)	" "
71	Petroliferous sh - Jago R.	" "
72	Albian(?) turbs Arctic Creek	MM C-1
73	Kps	" "
74	JK?	" "
75	Kps	" "
76	Bent. turbs	" "
77	" "	" "
78	" "	" "
79-81	with Bathurst Bridge	
82	Kps E of Kekiketik River	MM C-2
83	Kps Jct of " & Sad. Rivers	" "
84	Albian(?) turbs - Kingak Cliff	" "
85	Bent sh & turbs below "	C-1
86	T K sh (Canning Fm) near Tam R.	C-3
87	Eoc sh " - lower Jago R.	DP D-4
88	Kingak Sh	DP C-3

80AMK-27, 28 & 34 Ignok Valley MM C-4  
 82AMK-17, 18, 47 Section  
 84AMK-B

80AMK-53, 54, 55, 56, 57, 79, 80, 81 DP  
 83AMK-27, 28, 29, 30 Bathurst  
 85AMK-28 Bridge

p. 4

## Contents

## QUAD

82AMK-1	Kps(?) Echooka River	Sag B-2
2	Cret or TQ cgl - Echooka River	" "
3	Albian turbs	" "
4	Shalman-nomman.	" "
5		" B-3
6		" "
7	UK sec. - Toolik River	" B-4
8	UK sec - 3 mi E of Sag. River	" B-3
9	Tuff zone E of Sag. River	" A-3
10	Turbs	" "
11	Coal & clinker - E side White Hills	" C-4
12-14	LK? turbs - Lupine River section	" A-3
15	Turbs 6 mi E of Sag. R.	" "
16	Slope Sh	" "
17-18	with Ignok Valley Section	
19	Paleocene turbidites - Kat River	MM C-3
20	" - Canning R.	" C-4
21	UK section (2600'±) Ivishak R.	Sag B-2
22	UK turb section (440'±) "	" A-2
23	Lower Silead Cr.	" B-2
24	Ptes along Silead Cr.	" A-2
25	Sag. Fm - Sagwon Bluff	" B-3
26	" " Rd near "	" "
27	Fortress Mtn Fm near Elusive L.	PS C-3
28	LK Sh below K Fm " " "	" "
29	Lisburne near " "	" "
30	Karen Cr. S. E side Canning R.	MM C-4
31	Shrub-like Fm " "	" "
32	Hot Spring - west end Sad. Mtns	" "

p. 5

## Contents

## QUAD

B2AMK-33	Albian turbs, 250' Silead syn. sec.	Sag. A-2
34	Sh below " " " "	" "
35	" " " " " "	" "
36	Kingak Sh below " " " "	" "
37	" " " " " "	" "
38	Kingak Sh - N side Silead syn.	" "
39	UK turbs - lower Silead Creek	" "
40	Collecting oil - Umiat well #4	Umiat B-4
41	KFm Atigun surge	PS B-4
42	" " " "	" "
43	" " " "	" "
44	Shublik - LK " " " "	" "
45	Sadlerochit Sp " " " "	" "
46	LK sh below KFm " " " "	" "
47	48 with Iqneh Valley sec.	
49	Kingak Sh below Kingak Cliff	MM C-2
50	Kingak - Kps " " " "	" "
51	" " " " " "	" "
52	" " " " " "	" "
53	Shublik S side Iqneh Val.	" C-3
54	Kemuk Sa " " " "	" "
55	Iqneh Creek section Kemuk Sa - Kps	" C-4
56	Shublik - S side Sad. Mtns	" "
57	610' Albian turb sec. - Sag River	Sag. A-4
58	Albian turb etc to S " "	" "
59	Shal. mar UK ss - " "	" A-3
60	Non-mar. " " "	" B-3
61	Shal. mar UK ss E of Sag River	" A-3
62	2400' Shavrovik ant section	" C-1

p. 6

## Contents

## QUAD

82AMK-63	420' L. Shavrovik R sec (Tert.)	Sag. C-2
64	Sh below lower Silead Cr. sec.	" B-2
65	Turbs " " " "	" A-2
66	Kingak Sh, N side Silead syncline	" "
67	Shublik - Karon Cr. " " " "	" "
68	Albian(?) turbs - Echooka River	" B-2
69	Shublik - Kemuk Creek	" B-1
70	Kingak Sh - " " " "	" "
71	UK cont sh w/ pebbles Kavit R.	MM B-5
72	Sltg sh (Canning Fm) - " "	" C-5
73	Shublik - Kingak - Fire Cr.	" C-3
74	Turbidites Hudakula R.	" C-1
75	" Kingak Cliff	" C-2
76	Kps(?) - lower Kibukituk R.	" "
77	" " " "	" "
78	Oil stained UK(?) turbs - W side Can R.	" C-4
79	Albian(?) sh W of Canning R.	" B-4
80	Kingak - Kemuk between Can. & Kavit R.	" B-5
81	Kingak Sh - east of Juniper Cr.	" "
82	Tertiary etc - Iqneh Valley section	MM C-4
83	590' lower Shavrovik R. section	Sag. C-2

	Contents	p.t	QUAD
83AMK-1	Sag Fm - Tamarak R.		MM D-3
2	" " oil stained - E of Kavik		" C-5
3	" " W side Canning R.		" C-4
4	" " E " " "		" "
5	Fluv. or turb - Kat - Nularvik R		" D-3
6	Angun Pt oil seep		DP D-3
7	UK sh - Niguanak River		" D-4
8	Hue sh - " "		" "
9	Sadlerochit Sp - E of Aichilik R.		" C-4
10	Kayak sh " "		" B-4
11	Shublik Fm Aichilik R.		" C-4
12	Karen Cr ss " "		" "
13	Kingak sh " "		" "
16	Arctic Cr. facies - Okerokovik R.		" "
17	" " " " " "		" "
18	Kps " "		" "
19	Salobath Cr. section sampling		" C-5
20	Hue sh Jago River		" D-4
21	22 Eocene sh " "		" "
23	Kps Niguanak high		" "
24	Hue sh & Jur sh " "		" "
25	Eocene sh (Can. Fm) Marsh Cr. ant.		MM D-2
26	Blue clay - Barter Island		B.I. A-5
27	30 with Bathub Ridge		" "
31	Kayak sh - Lellimdwelt Fork		DP A-3
32	Arctic Cr. facies - Okerokovik trib		" C-4
33	Eocene sh Marsh Cr. ant		MM D-3
34	" " " " " axis		" "
35	Eoc? sh - Kat. R. S of Marsh ant		" "

	Contents	p. &	QUAD
83AMK-36	Eocene sh Tam River		MM D-3
37	Kps N side Sad. Mtns		" C-3
38	" " " "		" C-2
39	PRs - Kps - E fork Marsh Cr.		" "
40	Kemuk ss " "		" "
41	Karen Cr. - Kps E end Sad Mtns		" C-1
42	Shublik - Kps - Last Creek		" C-1
43	LK sh Hulahula R		" "
44	46 Arctic Cr. facies - Hulahula R.		" C-1
47	Kayak sh " "		" B-1
48	Shublik - Karen Cr. " "		" "
49	Kingak sh " "		" "
50	" " " "		" "
51	Arctic Cr. facies Okpilak River		DP
52	Kingak sh E of Jago R.		" C-5
53	Arctic Cr. facies - Dodo Cr.		MM C-2
54	Kingak sh S of Sad. River		" B-2
55	Manning Pt. oil seep		" C-2
56	Oil sand Sag Fm - Kat R bluff		B.I. A-5
57	Shal mar ss " - E side Can. R.		MM D-2
58	PRs - Shiahpuke Valley		" C-4
59	Kayak sh Fourth Range		" B-3
60	Lisburne " "		" "
61	Kemuk ss E end Jagnek Val.		" C-3
62	Echooka Fm Fire Cr.		" "
63	PRs/PMI W of " "		" "
64	Karen Cr. ss - Karen Cr.		" B-2
65	Kingak sh		DP B-4
66	PRs samples - Okpirourak Cr.		B-5

Contents

p. 2 10

QUAD

83AMK-67	PKs	Joe Creek	Table Mtn
68	Kingak Sh	" "	" "
69	LK sh	" "	" "
84AMK-1	Shublik-Kingak	Loney Cr.	Herschel ls
2	Kingak Sh	" " syncline	" "
3	PKs	W of Fish Cr, Canada	Dennis Pt
4	Neruokpuk	" "	" "
5	Echooka & PMI	" "	" "
6	Pre Mas	" "	" "
7	PKs	" "	" "
8	with Lagnek Valley section		
9	Hue Sh & Eoc sh	Jago River	DP D-4
10	Eoc sh (Conning Fm)	Niguanak R.	B.I. A-4
11	Ss etc	" "	DP D-4
12	Bent sh	" "	" "
13	JK etc	" high	" "
14	Hue Sh	" "	" "
15	LK sh	Oberokovik trib.	" C-4
16	"	" "	" "
17	Arctic Cr. facies	" "	" "
18	Mio-Plio	Carter Cr, Marsh Cr ant	MM D-2
19	Paleocene	Kat-Nularvik junction	" D-3
20	"	" "	" "
21	Kemik & Shublik contact	Last Cr.	" C-1
22	Kps near Last Creek	" "	" "
23	Lialume/Kat Dolo	- E Sad Mtns	" C-2
24	Footwall cutoff,	Kemik Ss - E Marsh Cr.	" C-2

Contents

p. 4 11

QUAD

84AMK-25	Kingak Sh - N of Sad Mtns		MM C-1
26	PKs thrust on JK - NE Sad Mtns		" "
27	Kemik Ss	" "	" "
28	Paleoc. Sh - Marsh Creek		" D-2
29	Paleoc sh & ss -	" "	" "
30	Kat. Dolo smpls - Kat. R. canyon		" C-3
31	" " thrust against PMI - N side		" "
32	Shublik & Kemik - N side Sad Mtns		" "
33	Kps beneath PMI	" " "	" "
34	Kat Dolo over PKs -	" " "	" "
35	" " on N side Shublik Mtns		" "
36	Neruokpuk - N side Sad Mtns		" C-2
85AMK-1	Near base Nanook ls - Shublik Mtns		MM C-4
2	Burned out Hue Sh along Lagnek Cr.		" "
3	Hue Sh	Jago River	DP D-4
4	Jurassic sh	Niguanak high	" "
5	" " solid HC	" "	" "
6	Kps - JK - E fork Marsh Cr.		MM C-2
7	Hue Sh -	" " trib.	" "
8	PMI faulted against Kps N side Sad Mtns		" "
9	Traverse down W fork Marsh Cr.		" "
10	Hue Sh along Nularvik R.		" "
11	Traverse down section, Nanook - Kat Dolo		" C-4
12	Arctic Cr. facies - Oberokovik R. trib		DP C-4
13	Kemik Ss, PKs, P Fg, & PMI - N of Sad Mtns		MM C-3
14	PKs faulted against Kps -	" " "	" "
15	Kat Dolo, PMI & Cret.	" " "	" "

Contents

P. 8 12

QUAD

85AMK-16	Faulted Hue Sh & Kps in gully - N side Sad.	MM-C-3
17	Kps on hillside N side Sad mtns	" "
18	Structure E end " "	" C-1
19	" " " "	" "
20	Rs, Kps, JK, Kps, Kemuk - Last Cr.	" "
21	Kemuk Sa - Kat R, N side Sad mtns	" C-3
22	Inoc zone & Hue Sh - " " "	" "
23	Rs, PM, PK - Tam R, " " "	" "
24	Paleo turb - W of Kat River	" "
25	" " " "	" "
26	" " " "	" "
27	Shrub-like Springs	B-4
28	with Bath tub Bridge	

1983



5/23/80  
 near east along Chauvick R. (E. bank) 2MM, ACH, ARK  
 SW N 45° E 24-18-20 E  
 80 ANK 1A N 55° E, 35 NW  
 69° 20' 35" N Lat  
 147° 12' 14" W Long

**80AMK-1**

0-5' 5' dark grayish black (N-2)  
 silty shale, base covered (100') 100 cps  
 shale samp 80 ANK-1A  
 "Archia Sublania" frags. in float fr. covered  
 interval also horiz. burrows  
 5-9' 4' silty shale  
 thin joints (< 8" thick) of thin- to thin bedded  
 matrix and grain supported sandstones cont.  
 gr. up to pebble size;  
 lith. samp 80 ANK-1B 40 cps  
 9-49 16' silty shale ss at 1A  
 fossil sample Archia Sublania(?) fr. middle  
 shale samp 80 ANK-1C - 15' above base of unit 85 cps  
 shale samp 80 ANK-1D - at top of unit 90 cps  
 N 55° E, 38 NW  
 49-64 15' siltstone - v. fine gr. ss. 60 cps  
 coarsens upward, v. thin bedded at base  
 to thin bedded at top; non-calc.; micaceous  
 low to med; trace sands  
 sparse horiz. burrows in sandstone

6/23/80 pg 2

**80AMK-1 (Cont)**

64-72 8' silty shale 60 cps  
 w/ thin - r. th beds of med coarse gr ss  
 72-88 16' silty shale w/ v. th. interbedded siltstone 75 cps  
 shale samp 80 ANK 1E at base  
 shale samp 80 ANK 1F 4' below top  
 siltstone - low to med. x bed  
 N 55° E, 28 NW  
 88-92 1/2 4 1/2 transgressive (?) granule bed 60 cps  
 orange weath. (w/od. br. 5YR 4/1)  
 poorly sorted (silt-granule); fresh - 10YR 4/2  
 granules - mostly quartz; glauconite  
 massive - v. poorly bedded  
 lith. samp 80 ANK 1G  
 92 1/2 - 95 1/2 3' clay shale grayish black - N 2  
 shale samp 80 ANK 1H 90 cps  
 95 1/2 - 97 1/2 2' sandstone - clean, quartzose 40 cps  
 lower fine gr., v. poor porosity, non-calc.  
 sharp base w/ lead coats  
 97 1/2 - 104 1/2 7' covered  
 shale in lower part  
 104 1/2 - 118 13 1/2 sandstone 50 cps  
 lith. samp 80 ANK 1I  
 white points - tripolite  
 yellow spots - weath. glauconite (?)  
 clean quartzose ss., non-calc., v. poor porosity

June 23, 1980 Malenaar Huffman  
 & Kirk Pg 3

80AMK-2 NWNE Sec 20 - 3N-72E  
 Mt. Michelson C-5 Quad

Otc along W. bank of Navik River  
 about 100' at exposed (topo).  
 Fairly flat lying

Delta fringe buildup - mostly sh  
 in lower part w/ a few thin VF ss  
 beds, flat bed, con carb, building  
 up to thick bedded VF-F ss  
 above (broken otc), con but scatt-  
 ered chert and qtz. pebbles through-  
 out. This prob indicates narrow  
 delta plain near fluvial influx

Looking back from below, there are  
 three separate buildups or cycles

sh sample Sh sample 80AMK-2 from near base.

This regressive sequence is about 300'  
 below fluvial conglomeratic sequence  
 that is exposed on hilltop in Sec 12  
 3 miles to NW.

6/24/80 pg 1  
 CIMM, ACH, A.R.K.

80AMK-3 NENE SW Sec 36-15-18E  
 Bag B-2 Quad  
 Measuring Kennel & section on SW  
 side of Echooka River

6/23/80

N 40° E Dip 42° E

0'	0'		
sample	80 AMK 3a	@ base of section	BR-60
silt. st. sample	80 AMK 3b	@ b + 23'	silt. st. = 90 cps
silt. st. sample	80 AMK 3c	@ b + 70'	limonite conc. = 90
silt. st. sample	80 AMK 3d	@ b + 100'	
140'	0-140'	vg poorly bedded argil. siltstone, w/ conc. beds up to 1' thick, dark vertical burrows, med grey iron calc.	nonstone
186'	140-225'		dip @ 38° E
fine samp.	155'	80 AMK 3E belemnite (fossil) @ b + 155'	
silt. st. samp.		80 AMK 3E siltstone @ b + 155'	CPS = 90
		coarse siltst., belemnite in float from sandstone above @ 186 + b	69° 18' 43.3" N Pat 147° 40' 22" W Long
		@ 208'	N 52° E 42°, med beds, cyclic lam, w/ sh

Kennel Section  
Pahokee River (cont)

6/24/80 pg 2

308 223-312 lower up to grad ss, g trace, argil, vertical  
buccoys, very light gray, sth calc., low  
porosity,

fossil sample @ 250' +6 -80 AMK 3F fossil ammonite  
vertical burrows 69° 18' 43.3" N Lat.  
147° 40' 22" W Long.

lower very fine, less argil mat'l BK=50  
w/ some of slightly more argil ss. CFS=55

@ 195' and st. st. in 1-3' beds, non calc.  
chg. to dip 45°

top not exposed. @ 312 +6.

lower very fine sand, and well sorted CFS=60  
sub rounded, M4, sandstone

heavily burrowed zone above mx section along  
strike of coarse calcareous interbeds  
organic or laminar

ss sample

80 AMK-8 ss near top of section

sh sample

shale unit above mx section, rubble autotrac

high gamma ray, M2, clayey shale BK=30

80-AMK-4 CFS=135

80-ACH-2 approx 30'

above last ss measured

(80AMK-4) C W/2 Sec 36-15-1BE  
Sag B-2 Quad

CMM, ACH, ARK,

6/24/80

pg 3

(80AMK-5) SWSW SE Sec 26-15-1BE

Sag B-2 Quad

80  
35 Y  
55  
Zonal sample of sh in turbidite sequence  
Nannukuk equiv? VF ss beds up to 1' thick,  
w/ sh to no grading, com groove casts on  
base, sharp basal contact, gradational upper  
contact, Bouma a or b and minor c.  
Dip N55E 35NW

About 100' exposed 1/3 ss

80 80AMK-5 C W/2 NE/4 Sec 35-15-1BE  
Sag B-2 Quad

(80AMK-6) C W/2 NE/4 Sec 35-15-1BE  
Sag B-2 Quad

80  
Zonal sample of black sh, thick section  
partially exposed along hillside. No ss  
in section - is this pebble sh or lower  
Torok

80 80AMK-6

(80AMK-7) NWNW Sec 32 E, SW SW Sec 29  
T3N, R1E Sag C-2 Quad.

= 80ACH-SR Measured nonmarine  
section on Sharovick R. w/ very thick  
100'± coal section.

C.M. Moore, A.C. Huffman 6/25/80  
A.R. Karch pg 1

80AMK-8 SWSW Sec 8-15-21E  
Sag. P-1 Quad

Syncline section (Kps - ?) along Kemik Cr.

Starting at base of continuous pt.  
There are more sh. slat. ocs below, but  
discontinuously exposed and there could  
be structural complications.

Att N65E 67.5

BK=60  
CRS=110

@ 5' 80 AMK-8A 8  
greyish black, fissile silty claystone

@ 12' greyish black, fissile shale, N3, dis  
interbedded w/ discont. non calc. ironstone  
conc. w/ limonite stains

@ 50' 80 AMK-8B 8 greyish black fissile BK=60  
shale w/ jarosite (?) yellow ox CRS=115  
secondary along fractures  
secondary gypsum along laminations  
cannon ball concretions

@ 95' 80 AMK-8C 8

BK=60  
CRS=96

6/25/80 pg 2  
sh. 80 short 2 syncline sections Kemik Cr.

sh. samp. @ 125' 80 AMK-8D 8 blackish gray,  
fissile shale, out of concretionary  
zone ~~at~~ crds @ about 100'  
and replaced by scattered round  
concretions

sh. samp. @ 155' 80 AMK-8E 8 dark grayish black BK=60  
fissile shale good concretionary zones CRS=100  
as discontinuous lenses.  
hematitic and yellow jarosite (?) ox  
zones

@ 175' pyrite coral conc. in yellow stained zone  
N65°E 60°

sh. samp. @ 200' 80 AMK-8F 8  
@ 205 dark gray fissile shale interbedded w/ thin (6"-1")  
limy shale bed that w/ limonite staining  
clayey shale,  
@ 230' pyrite "pebbles" pyrite replacing something  
interbedded BK shale (N3) and ironstone  
concretions

sh. samp. @ 235' 80 AMK-8G 8

sh. samp. @ 250' 80 AMK-8H 8 fossil sample  
lith. samp. 80 AMK-8H P lith. L quartzite cobble  
w/ pyrite along fractures, in shale dark gray fissile  
BK=60  
CRS=116

6/25/80 page 3 Synclinal Section Kamik Cr. 6/25/80 p 93

@ 280' 80 Amk B-I 80 dark grayish black fissile shale, interbedded with buff 104R/2, thin stringers may be gouge on near bedding plane slip surfaces, another quarter of pyrite. possible include of log 80-Amk-H ±

@ 315' black fissile shale (113) with scattered conc., thin 4" thick 54R 4/4 bentonite bed. 80 Amk B-J 80 (80 Amk B-J ± frag.) BK=80 OR sh=750 CRS bent. 300

sh. samp  
lith sample

@ 330' black fissile shale @ 330' non calc. BK=130 CRS=180

sh. samp.

@ 350' black fissile shale 80-Amk-B-K 80

sh. samp.

@ 385' 80-Amk-B-L 80, black fissile shale w/ jarosite staining along fracture, very tightly folded syncline, 15-20' additional section in core at syncline. BK=150 CRS=190

@ 390' CRS = 280

6/25/80 pg. 4 N 80° E 61° SE

6/25/80 CMM, ACH, ARK

80 Amk 9 C 5/2 5/2 Sec. 35 - 11 - 20 E & NWNWNE Sec. 6 - 15 - 21 E Kiemite Cr. - King of the Hill Sag B-1 Quad No bottom on section structural complexity in to NW., max. thickness from map, sample A at base of section

sh. samp

0' 80 Amk - 9A 80 shale, dark grey, fissile, non calc., few floating qtz grains. B.K. = 60 limestone conc., secondary 94psum CRS = 100

sh. samp.

80 Amk 9B 80 BK = 60 good fresh sample black, (N1) CRS = 90 non calcareous, clay shale, no fossiliferous, fissile

sh. samp.

80 Amk 9C 80 dark grey, nonfossiliferous, shale w/ jarosite staining along fracture, micro micaceous, non calc. very low porosity.

sh. samp.

80 Amk 9D 80 dark grey, clayey, shale BK=60 interbedded with lenticular conc. beds. CRS=90

sh. samp.

80 Amk 9E 80 dk grey (N2) non fissile, non calc. shale

6/25/80 pg. 5

6/25/80

R9 #2

sh. samp.

80 AMK 9F B dark gray fissile shale,  
local deformation structures adj. to shear  
RK=60  
CPS=80

fossil samp.

80 AMK 9G C fossil sample  
buchia in float almost complete shell  
second buchia found in float strat. higher(?)  
(labeled higher) 69° 23' 23" N Lat.  
147° 5' 32" W Long

sh. samp.

80 AMK 9H black shale, fissile bk=60  
(N2), concretions CPS=100

Along Creek several hundred feet to SE  
still in Black Shale, mica micaceous  
zones of different dip between here and  
last sample taken

1320' linear outcrop sample  
approximate thickness 1235'

C.M. Malenkar, A.C. Huffman  
& A.R. Nark

6/27/80

80AMK-10 W/2 W/2 Sec 35 to SE Sec 34 and  
SW Sec 35 T1N, R23E  
Photo 7233 (M-35) Mt. Michelson. B-5

See 82AMK-80 for additional data

Measuring and collecting section of Kingak  
Sh - Kemik Sh - Pebble Sh.

Between Kawik & Canning Rivers  
Att. N75-80W 35-45S

Kingak Sh. measured by map & photo scal-  
ing method. SA - 10 1/2°. Dipping N 30E  
from resistant Kemik ridge to base.

900

Sh. dark gray, sh. slty, fissile to  
sub-fissile, ferruginous (rusty) coating  
on plate esp in lower part, minor  
or rare floating VF qty grains in upper  
half

80

80 AMK-10A thru I collected thru  
interval

80

10-G. Buchia in float  
69° 23' 59" N Lat; 146° 25' 59" W Long.  
Top 100 is covered and holds up  
ridge (all covered) is thin Kemik Sh  
5' etc in upper hillside, quartz, LUVF,  
well sort, com with chert grains and

6/27/80 pg 2

± green glauconite ± 80AMK-10J

Continued travers across shale valley to south. Several scattered rubble otes of black fissile shale - (pebble sh.?) no pebbles seen.

B ± 80AMK-10K-N going up section  
No dips available - it looks like somewhat shallower dip. Thickness?

Next ridge to south is held up by Brookian ss rubble otes. Ss VF w/ some LF, hard tight, lithic, no ote in place but scattered bottom marks noted - scours and some flutes  
± 80AMK-10φ

These must be deep-water sands.

See next page for estimated strat. position of samples in respect to Kemik Ss

11/15/84

Section between Canning and Kavik Rivers - Approximate stratigraphic position of samples

Measured\* down from base of Kemik Ss

80 AMK-10	A	900 FT
	B	800
	C	700
	D	600
	E	500
	F	400
	G	300
	H	200
	I	100

82 AMK-80	A	750'
	B	300

Measuring\* up from top of Kemik Ss

80 AMK-10 K		50 FT
	L	100
	M	150
	N	200

\* Measurements are estimates; total section was map or photo scaled.

6/27/80 pg 3

BOAMK-11 SW NW Sec 3-15-23 E  
Mt. Michelson B-5 Quad  
Photo M-35-7233

Checking rubble etc of Brookian ss on  
hillsides west of Kaurik River.  
Ss, greenish gray, VF, w/ minor LF grains  
coarsely, bottom markings - coarse, crude  
flute noted in float between ~~more~~  
thicker ss etc.  
These are prob. deep-water ss.

BOAMK-12 C W/2 W/2 Sec 6-1N-24E  
Photo M-35-7233 Mt. Michelson 1/250,000

1/2 mile west of Canning River  
Measuring and collecting shale below  
Kemik Ss

0-100 100' Ss, dark gray - blk, fissile to sub-fiss.  
firm, minor ironstone concs, rare  
floating VF qty grains  
A = 0  
B = 13'  
C = 40'  
D = 70'  
E = 95'

BOAMK-12A to E

0-15 15' Covered

Ss, base not exposed, see next pg.

BOAMK-12 Cont

6/27/80 pg 4

115-147' 17' Ss, med gray N4, LVF stly, non-  
calc, tilt, flat bed 6" - 7.5" thick  
⊗ at 6-8", some zones of small  
dark organic flecks  
at 12' 1' bed w/ pebbles up to  
ca. 1 cm, dk gray chert, matrix  
still LVF, N2  
at 13-16 is non resistant zone  
of LVF more stly ss.

17-23' still LVF, ripple lam,  
color N3, mod-well sort, w/ shi  
calc

23'-29' med bd VVF ripple lam  
in part, vertical ⊗

29-32 LVF w/ some VVF N4,  
w/ shi calc, well sort  
at top is VVF

± BOAMK-12E at top

Total measured ss = 32'. More is present  
but top is weathered back.



June 28, 1980  
P. M. Molenar, A. C. Huffman,  
D. R. Kirk

BOAMK-13 SE/4 Sec 2B-35-18E  
Sag A-2 Quad

Silead Cr. Area  
Base of Silead Cr. section  
Lower 200'± of ss is greenish gray VF w/  
some LF minor VF hard, p bed, mon  
calc. Quite fractured. There is some  
bedding that may be med scale X bd and  
some scours, but this could all be due  
to fracturing. In upper part and in  
thinner bedded sequence above there  
are some bottom marks - scours etc  
trending N-S, N35W, N60E

also v-sli grading noted

For 300'± above are some thinner bedded  
units w/ several 10-20' thicker bedded  
units. Some of the sands in the thicker  
(2-4) bedded units get up to LM and  
are v poorly sorted. Some appear med  
scale X bd, but could be fractures,  
some scouring and load features  
scours trending N15W

Another 300'± above is more of same  
Some scours trending N45E  
This is at base of thick mo etc zone. Map  
scaling indicates 300 to 900 ft of section

6/28/80 pg 2

BOAMK-14 NW NW Sec 2B-35-18E

Sag A-2 Quad.  
Quick stop on ridge. High up in section  
Many bottom marks noted in float -  
scour marks, crude flutes.  
These are still turbidites.

BOAMK-15 SW NE Sec 31-35-18E  
Sag A-2 Quad.

Another quick stop to examine ss ledges  
down lower, but possibly younger  
sands in syncline.  
ss greenish gray VF-F w/ some med,  
v poor sorting, micaceous  
Very few bedding structures, appears  
flat bed but poorly bedded. Some bottom  
markings in float below.  
These are probably still deep-water sands.

BOAMK-16 = BOACH-14 C SW Sec 9-45-17E  
Sag A-2 Quad

River cuts along Irishak River.  
75'± exposed of well bedded sd on sd trails  
some w/ thin sh between. Bed a few  
inches to 2 ft thick, VF-F w/ M, E, C  
some w/ grading, Bouma A B C. Some  
good bottom marks. Beds are overturned

6/28/80 pg 3

BOAMK-17 E/2 SW/4 Sec 35-15-16E  
Sag B-2 Quad

Well exposed sections along Irishak River. Both flanks of an anticline are well exposed. The north flank exposed more section but the river against cutbanks precluded walking through section so we walked through part of south flank. Attitudes are fairly consistent ranging from N65E 47.5 at base to N70E 52 at upper end. By map scaling thickness calculates to be about 1750' to small(?) fault.

Section is made up of many cycles of lower shoreface delta front ss. buildups separated by offshore shale - siltst. Ss are vt, med gray, firm, flat bed, minor low angle x bed, con small carb debris, scattered nondescript pelecypods. Each cycle builds up to thicker bedded ss but still lower shoreface or distal, then overlain by 30 to 100' transgressive sh. Scat chert pebbles at base of some transgressions. At upper end of section is small(?) fault, then at least another 600-700' of dominantly sh-siltst. - Didn't walk thru that.  
(over)

6/29/80 pg 1

SESESE Sec 30  
BOAMK-18 SW SW SW Sec 29-2N-24E  
Mt. Nicholson 1/250,000 Quad

Kemik ss section on west side Canning R.

Att N60W 27 SW

- 60  
27
- 0-17 17' Sh, blk soft broken clayey covered below a few more ft to river.  
BOAMK-18A-C BK=50  
CPS A = 120  
B 140  
C
- 17-20 3' Ss, dark gray-green (wet) 5 GY 4/1, LF clay w/ VF-M qty grains, minor blk chert pebbles up to 1/4" w/ glauc. w poor sort, more float and M-C grains in upper part non calc  
BK=5 CPS=80  
BOAMK-D
- 20-22 1 1/2' Non calc orange w/ conc bed, iron-stone(?) glauconitic w/ floating qty grains

Some bentonite is present in some of the  
SD tongues in the 1750' section. This whole  
section is undoubtedly post Seabee UK.

6/29/80 pg 2

22-45'

23'

sh slty in lower part dark gray -  
blk, firm to hard, p bed, fractured  
w/ yellow hematitic coating  
2-4" ironstone conc beds  
At base is 2" yellow iron bent (?)  
zone.

± BOAMK-18 E-G

BK=50 CPS E=90  
F=120  
G=140

Base of resistant Kemish

In lower 3-4" immediately over-  
lying sh is pebbly none in  
sh matrix. Above is 3' of  
slty dark gray - blk, p bedded  
w/ scattered chert pebbles, none  
± BOAMK-18 H from basal cgl

BK=50 CPS basal cgl = 100  
CPS slty = 75

50-120

70'

sh dark gray at base, LHV-F-C slty  
coarsening upward. Measured by  
dropping tape over cliff  
at 15' horizontal bed w/ vertical and  
horizontal burrows LVF med gray

at 17' LVF-UVF ripple bed  
att N60W 28 SW

60  
28

BOAMK-18 Cont

6/29/80 pg 3

Remainder of section could not be  
examined closely because of steepness  
of cliff, but most is all LVF w/ some UVF  
flat bed in bed 2-6' thick, bedding planes  
are not smooth, scattered burrows.

± BOAMK-18 I at 40'

CPS is practically zero

No otes above - tundra flat

BOAMK-19 E/2 Sec 2-1N-23E

Photo M-35-7233 Mt Michelson 1/50000

35' otc near top of ridge. Interbedded  
Proterian sh & slty in irregular wavy  
beds 1-3" thick, sh is dark greenish gray  
VF-LF, clay matrix, dirty, no grading, ~~not~~  
apparent. Minor bottom marks (grooves)  
noted in rubble. This must be deep water  
in? or UK? Com carb frags  
att N15E 15W (F)

15  
Y

BOAMK-20 SE SE Sec 1-1N-23E

Photo M35-7233 Mt Michelson 1/50000

20' ± slty, dk gray, hard, platy to pencil  
fracturing, com burrows (hoop), rdie cones  
Prob is lower Torok, att N40W 33 SW

40  
T  
38

6/29/80 pg. 4

BOAMK-20 Cont

Above this etc is Brookian VF ss rubble

BOAMK-21 SWSW Sec B-1N-22E along Juniper Cr. ~~Sec~~ Mt. Mich. B-5 Quad

Otc of very bentonitic, porcellanitic, tuff interbedded w/ thin blk paper sh. About 200' exposed  
BOAMK-21 of paper shale

Overlying several hundred ft of sh-siltst w/ occasional thin VF ss beds com bottom marks - grooves and some flutes

Whole section dips steeply to S w/ some contortions

Underlying couple hundred ft are contorted and probably faulted sh and siltst

BOAMK-22 NENW Sec 7-3N-22E Mt. Michelson B-5

Grab samples of marine siltst on W bank of Navik Riv. 10' exposed, gentle dip  
BOAMK-22A & B

CMM, ACH, ARK 6/30/80 pg. 1

BOAMK-23 CW/2SW Sec 26-1N-21E Mt. Michelson B-5 Quad

Measuring Kemuk ss along Fin Creek

STRIKE N85°E  
DIP 50°N

- 0-19 19' base not exposed but probably close; thin bedded at base medium bedded at top  
sample lith BOAMK 23 A± sandstone sample lower very fine grained well sorted, quartzose ss chert, non calc. NH  
RK-35 CR-10
- 19-29 10' sandstone very silty, lower very fine grained. Coarsens upward into lower very fine grained sandstone.  
RK-35 CR-55
- 29-112 83' vertical and horiz. burrows, lower very fine grained quartzose ss in thin-med. beds thin interbeds of sl. calc. ss also lower very fine grained w/ abundant clay chips and limonite staining, upper part of ss is silty and  
sample lith BOAMK 23 B± 15' below top of unit  
RK-35 CR-50
- 112-117 5' over lain by ss/silt interbeds as if new transition zone, not outcrop well S'

CMM, ACH, ARK 6/30/80 pg 2

BOAMK-24 NW/4 Sec 5-2N-19E  
= BOACH-17 S.d.g. C-1 Quad

Walk thru section along jumper Cr. on north flank of Shavivik anticline. About 100 ft of discontinuously exposed section. Att at SE end: N70E 60N  
Att at NW end: N85E 30± N

Section starts out in a couple 100 ft of poorly exposed shaley silt w/ some fluvial, qtz grains. Above, there are 2'-6" ss beds (F), grading up to more ss. No good shoreface ss exposed - prob. low energy shoreline - then non-marine ss with interbedded thick zones of carb sh - coal. In upper few hundred ft are thicker conglomeratic fluvial ss units separated by carb sh - coal zones.

This whole sequence is regressive from prodelta mudstone to fluvial

ACH has marine sh samples, carb sh and lith sand samples

6/30/80 pg 3

BOAMK-25 SW SW Sec 29-3N-24E  
Mt Michelson C-4

Long etc on west bank of Canning River opposite Nanook Cr.

This is 280' section measured by Palmer et al in DF 79-1634 Plate B

Could not get to basal 50' ss, but section above is all marine and thin ss interbeds are turbidites - good grading (VF-VF) and many sole marks (mostly in float). Most in place trend N70E w/ some a few N20-30E.

CMM, ACH, ARR 7/1/80 pg 1

BOAMK-26 Near C Sec 32-3N-26E  
Mt. Michelson C-3

Logan Valley

Fulcrum of Brookian ss on top of  
hill. ss, LF-VF, greenish gray - lt med gray  
hard, some interbedded silt (mudstone)  
Sole marks rare but locally com-  
mon = grooves. Some sh graded  
bedding one chert pebble, one soap  
stone of LM ± BOAMK-26

One oolite in place on S side of hill  
at N80 W 32° S (E)

CMM, ACH, ARR 7/2/80 pg 1

BOAMK-29 SWNW Sec 4-3N-24E  
Mt. Michelson C-4

Oolite on W bank of Lanning R  
ss that w/ interbedded ss in beds a  
few inches to 1 ft or so. At least  
100 ft exposed  
ss beds show small scale x bd,  
even scouring, some graded VF → VF,  
some w/ several thin VF-LM layers  
(multiple flows?), many chert pebbles  
com calc frags. No sole marks seen.

MT: N80E, 30-70 N

This is not delta fringe - prob deep  
water or slope channel

BO-29 BK 40 CPS 110

SE 1/4 Sec 33-4N-24E

7/2

80 AMK 30a  
siltst. samp

E. bank Canning R.

N60E; 10' NW

transition zone - upper 15'  
thin bedded to med bedded at top  
35-5m scale scour & fill & low  $\delta$   
x bedding at base; rippled at top;  
silt & gr.; gte. & cht.; much organic  
debris on lamms. & sl. calc; well sort;  
sbrd - lt. ol. q. (5-1/2) & lg. plant frags.  
interbedded siltst. & mudst. - bk to 80cps

80 AMK 30b  
siltst. samp  
fabr. base

shoreface ss. - 15'  
lt. gr. w/ u.f.; grease, cht., brn. lithic;  
well sort; lt. ol. q. (5-1/2) & lg. plant  
frags. & carb. debris on lamms.; v. s.  
calc; poor porosity; clay clasts;  
th. med. low  $\delta$  tr. x bed.

8.

lower in Syncline (North) N80W, 30S

7/3 move to Barter Island

7/2/80

pg. 2

80 AMK-31

NE Sec 33-4N-24E

MT Michelson C-4

On east bank of Canning River. Good ocs  
but can't get around because of high  
water. About 20' of ss examined on N  
side of point.

ss med gray, UE, well sort abundant  
carb frags, clay chips, some scouring  
and clay drapes, scattered bimodal  
chert pebbles up to 2" in layers, some  
med scale x beds.

This is prod dist channel system  
Lineations on base = N60E  
Float from upstream is VVF, ripple  
marks, com carb frags, burrows on  
bedding surfaces

att N 45E 6N (F)

± 31

80 AMK-



7/2/80 pg 3

BOAMK-32 C E/2 E/2 Sec 24-3N-24E  
Mt. Michelson C-4

Grate samples of shale between two  
Kermik Sss along Squak Cr where  
Jill Mull and Les Magoon measured  
their section  
Shale is about 60' thick  
One small qtz pebble or granule found

OB 32 A-D

Att: NBSE 53S (G)

7/2/80 pg 4

BOAMK-33 C 9/2 Sec 36-3N-26E  
Mt. Michelson C-3

Stream cut of very ~~horizontal~~ sh interbedded  
w/ lentonite - about 75-100' exposed.  
This is above red zone.  
Sh, med gray, N-3, p bedded, hackly  
w/ con floating M-C qtz grains  
and scattered chert pebbles up to  
1" ~~in dia~~ - a couple ls (+) beds  
OB 33 A & B dip 20° S  
± 33 of pebbles

This is same zone as at about 1000 ft  
on section yesterday (BOAMK-27)

CMM, ACH, ARK

7/5/80

pg 1

BOAMK-36 E/2 Sec 1 - 2N-26E  
Mt. Michelson C-3

Walking through Cret section 5 miles east of measured section to verify sequence south flank of syncline is slightly overturned to vertical. Hemik is exposed but is faulted off. Many small (?) faults but sequence looks okay.

Att in Brookian ss along E side of creek:  
N75E B5N (lenticular interbedded)  
Good sole marks on a few beds which when rotated out trend N60E (G)

Above this a couple hundred feet and prob in synclinal axis is another red wax zone. This is probably a thrust repeat of one red zone.

Brookian ss on N flank of syncline  
Att: N70W 20S (F)

CMM, ACH, ARK

7/5/80

pg 2

BOAMK-37 NWNW NW Sec 1 - 2N-26E  
Mt. Michelson C-3

Sta located on red zone (upper one)  
This is on S dipping N flank of syncline  
Underlying this red zone are several rubble patches of Brookian ss turbes.  
Dipping 20°± to S (est)

± 37A of ss

Red zone is surface weathering or staining of med light grey siliceous fine tuff.

± 37B

Interbedded is dark gray, brittle siliceous sh (like Mowry)

Above is another ss rubble bed.  
This could be underlying red zone across tight syncline, but it could actually be in overlying sequence.

Can't tell

± Ss is Brookian type as below - very hard ± 37C

Later: This red zone is probably a thrust repeat of one red zone. Underlying Brookian turbes are younger than red zone

7/5/80 pg. 3

30AMK-3B SW SW SE Sec 22-4N-29E  
MT Michelson C-2

North side of Sadlerochit Mtns  
Examining N/S Sadlerochit contact  
No Hemish ls except for a 8-10' zone  
of slty org ss & sltst w/ scatt  
small LF pebbles. At basal con-  
tact w/ R.S. is a pebble zone

Nps section above is:

75' ± w slty sh, p bed, w shi calc  
to non calc com chert and quartz  
pebbles up to 2" floating  
About every 10' is a 1' orange  
w/ ironstone conc bed.

cut: N75E 30N (F)  
B 3B A & B

50' + Sh blk fissile, limonite  
w/ on of plates, yellow  
jarosite stain com discontin-  
uous ironstone concs  
Few if any pebbles

B 3B C & D

7/5/80 pg. 4

80AMK-39 SE SE Sec 19-4N-30E  
MT Michelson C-2

On east fork of Marsh Cr on N side of  
Sadlerochit Mtns  
On east side of creek and eastermost  
fork is good exposure of Eschschia (not good  
base though), very good area of Karak sh  
and gradational outer fringe buildup into  
Wishak ls. There are several pebbly  
beds in Wishak and ss increases from  
LVF at base to LF above.

Good contact w/ Cret Transgression  
There is a pebble bed at contact and  
about 6' of arg slty VF ss w/ scat-  
tered pebbles. Above is about 50' or  
75' of w slty sh, laminated and com  
pebbles and 1' beds of ironstone concs.  
This is overlain by the more typical  
fissile pebble sh, but few or no  
pebbles. Didn't examine very much.  
This sequence is very similar to that  
3 miles west on west fork.

CMM, ACH, & ARK. 7/7/80

(80 AMK-40) SENE Sec 32-4N-28E  
Mt Michelson C-3 Quad

On north side of Sadlerochit Mtns on tributary  
of Nat. River  
Cret - Sadlerochit sequence exposed along  
creek bank starting at base:

- 0-5 5+ Top of Irishak ss, lt gray, yellow-  
orange w/x. Fw/M-C in top few  
inches, well sort
- 15 10' Broken etc 8' of which is ss, med gray,  
LF-UF w/ minor M, ll bed.  
Is this still Irishak? or basal transg  
ss of overlying sh section?
- 15-65 50' ~~Sh w/ 20-25% siltst interbeds~~  
Sh, silty, dk gray w/ 2 1' maroon  
sh beds at 19 & 35', p bed, soft firm  
w/ a couple of soft recent sh beds.  
Siltst, tan, w/ sli calc, in beds a few  
inches to a couple ft thick. For Cret?  
Att. N50E 6 SE
- 65-75 10' Ss, blk to brn, F-M w/c, arg, p sort  
some carb, soft w/x. This may  
be basal transgressive unit of LK
- 75-77 1-3' Cgl, p sort,  $\nabla$ , ss matrix, chert &

7/7/80 pg 2

qtz pebbles & cobbles up to 4", one  
chert boulder 15". This cgl cuts  
down thru 5 or 6' in 50'.  
Underlying siltst bed is highly  $\nabla$ .

77-92 15' Interbed ss (Kenik) and siltst (80-20)  
ss, med-dk gray, LF-C silt, ll bed  
1-3' thick scat<sup>d</sup> pbb in lower part.  
com H & V  $\nabla$ , com load features

Siltst interbeds 2"-6" thick, dk gray  
pebbles in upper most part, prob  
base of overlying pebble sh transg

Above is eroded back soft section.  
but it appears to be sh-siltst section

7/7/80 pg 3

(80AMK-4) NENE SW Sec 11-4N-27E  
Mt Mickelson C-3 Quad

Lower Tertiary (?) turbidites along Katak-  
turuk River N of Saddle Rock mtns  
Walked through about 367' of section  
as measured by Lyle, Palmer, Bolm and  
Maxey OF 79-11634

Section consists of turbidites and slty sh

Ss, med gray, VF-VF, some in well graded  
beds but most is LF w/ no perceptual  
grading, hard, beds a few inches to  
2" thick, good Bouma sequences of  
a b c d - mostly b c d, sharp  
bases w/ com sole marks, grooves  
trend N 70-80 E to S 80 E (E)

Com carb material on laminations  
within ss, com small scale X b d  
(Bouma c) at top of beds, com ripple  
marks on top surface.

Sh, slty p bed, firm, no bentonite

This is good deep water turbidite seq-  
uence in ss part. Ss sequences seem to  
be thinning upward, i.e. channel seq-  
uence. Some scouring of a few ft  
noted. Section measured 7/20/80

CMM, ACH, ARK 7/20/80 pg 1

(80AMK-4) NENE SW Sec 11-4N-27E  
Mt Mickelson C-3 Quad

Measuring section of turbidites exposed  
along W side Katakaturuk River  
69° 04' 15" N Lat } near base of section  
145° 76' 06" W Long }

att E-W-30 N

0-36 36' Turbidite sequence Ss E/ sltst

Ss, pale yellowish tan 10YR 6/2 graded.  
To non graded beds up to 2" thick in  
lower part thinning upward to 2" at top.  
LF-VF Bouma a, b, c, d or b, c  
d, com carb material along bedding  
planes, sole marks (mostly in float)  
in place → N 70 E (grooves)

± 41A at 12'

Each bed separated by a parting or thin  
bed of sltst - slty sh, dk gray.  
Ss is at least 80%.

36-57 21' Sh, slty, dark gray, N 3, broken etc

non fissile non calc  
to 41 B & C near base and top

From 5 to 11' is a lense of somewhat con-  
torted ss & sh - pen contemporaneous slump

7/9/84 Revisit. Found lightly oil stain ss in float in  
lower part - either in 36' or 12' interval. Has slight oil  
odor and gives out. ± simpl 80AB4 AMK-41

7/20/80 PG 2

- 57-69 12' Thinning upward sequence of ss & sh  
ss 50% in beds 1' → up 3", VVF  
graded Bouma b c d & c d
- 69-92 23' Slightly thinning upward sequence ss w/  
slat partings in thin beds ss 85% ±  
ss in beds 2' ± near base to 6" ± in upper  
part, graded to nongraded turbes, grades  
about the same as described previously,  
some VF-LM, but fining up to VVF,  
com supplied top surfaces, some ss on  
ss graded beds, but mostly individual  
sequences.  
± 41 D at 15' alt E-W-31M  
Top bed is 8" 9" thick - maybe another thin  
sequence.  
Base of 23' sequence accretes into un-  
derlying unit 1 or 2'.  
Sole marks → N80E, N85W, N85W
- 92-207 115' Slaty clayst, grayish brown, non-fossiliferous  
bedded except for some thin slat-VFss  
interbeds  
80 41 E at 5'  
41 F at 45' sli calc  
41 G at 80'
- 207-216 9' Interbed slat 65-70% and VVF ss in  
beds up to 3" com Bouma c  
flutes trending → N85E

7/20/80 PG 3

- 216-234 18' Slaty clayst as described.  
80 41 H from middle
- 234-44 10' Thinning upward cycle ss 50% ± & slat ss  
ss beds up to 6" thinning upward, sh at  
Top 2 or 3' is slaty sh
- 244-55 11' Thinning upward cycle as above
- 255-71 16' Thinning upward cycle ss beds at  
base up to 2' but thin to 5 or 6"  
to NE These whole sequences  
shingle out to NE (see photo) & sketch  
± 41 I at base  
alt E-W 26-31° N
- 271-77 6' Thinning upward cycle, 6"-4"  
ss beds 40% (all slat slaty sh repp.  
slat)
- 277-92 15' Cycle, lower 5' ss & slat thinning up  
from 3" to 1" 50% ss, upper 10' is  
all slaty sh as described  
80 41 J from near top sh
- 292-302 10' Interbedded ss & sh 50-50  
ss beds 2" and less. There might be  
2 cycles here
- 302-17 15' slaty sh Back on hillside and above is  
another 50' ± of sh - no turbes

CMM, ACH, EARK

7/8/80 pg 1

80 AMK-42 NENEVE Sec 15 to ~~S45W50~~ Sec 11  
T2N, R2E Mt Michelon C-3

Fire Creek - Examining R

At top, ~~Swishak~~ ls - base of Fire Cr Mbr  
is a 2'-4" pebble cgl (basal transg), mostly  
blk chert pebble < 1/2"  
Swishak ss is hard, siliceous ls F ss

Fire Cr Mbr is interbedded firm sh and  
thin ripple bedded slt in beds a few  
inches thick

Att: N60W 32N (G)

80 42 A & B for SR

A 20'± above base; B 35' above base

80 SR Swishak Fm lower 40'± is c slt - LLVF ls  
w/ com blk phosphat? pebbles, abundant  
at base. Some pebbles are irregularly  
shaped - not round. A few thin slt sh  
interbeds B 42 C from 20' above base  
com U shaped H

Above is more shaley section, largely cov-  
ered. Then hard resistant calc slt - ls  
unit w/ coquinas of small pelec. a few  
monotis in ls.

80 42 D from below ls

80 42 E sh - slt interbed more above ls  
SR is very calc, blk, sooty

7/8/80 pg 2

ls beds 1-7' thick lensy, and up to  
4 or 5', com monotis

Section above resistant thicker ls beds  
become thinner bedded

Upper sh mbr is largely covered, couldn't  
get good sample

80 AMK-43 S/2 SW/4 Sec 30-2 N-30E  
Mt Michelon C-2

Resistant ledges on hillside are Brookian  
ss, some sphe marks in float. These  
are undoubtedly turlos

Att N30E 20±S

This is lowest bed on hillside. Checked  
below to N - no otes, some sh rubble  
In creek bank exposures to NE is all  
sh - prob Kingak

7/8/80 pg 3

80AMK-44 NENESE Sec 26-2N-30E  
Mt. Michelson B-2

Hills on N side of Kephukuk River  
Highly folded turbes and bent sh,  
com bottom marks, some graded

UVF-LVF

80 44 A & B

80AMK-45 SWSW Sec 25-2N-30E  
Mt. Michelson B-2

On south side of fault (?) in non bent  
sh, dark gray, indurated, also some  
limonite coating on chips. Several  
hundred ft exposed on ripstream

80 45 A & B

Att N80E 45S (F)

80AMK-46 NWNWNW Sec 33-2N-31E  
Mt. Michelson B-1

On hilltop where Dettmerman et al reported  
ammonite occurrence. All Brookian ss  
rubble VF some sole marks

These are turbidites interbedded in sh.  
Must be Albran.

7/8/80 pg 4

80AMK-47 SESE Sec 16-2N-31E  
Mt. Michelson C-1 Quad

100-150' etc along Arctic Cr.

Interbedded ss 80% and thin paper sh  
20%. ss are mostly VF turbes, com  
small scale ripple bed, com sole marks

Trend on 3 or 4 N55-70E

Att N50E 42 SE (G)

Sh dark gray-blk, fissile, poss bent  
as indicated by surface mud

80 47 A & B

80AMK-48 W/2 NW/4 Sec 2-2N-31E  
Mt. Michelson C-1 Quad

100' etc along Arctic Cr.

Sh w/ thin interbed siltst-VF ss, some  
thicker UVF ss beds, ripple bed Basima c  
in upper part, com sole marks trending  
N40E, N55E

Att N55E 35 SE

No bentonite

80 48 A & B



CMM, ACH, ARK

7/9/80 pg 1

(80 AMK-49) C E/2 E/2 Sec 11-3N-31E  
Mt. Mickelson C-1

Measuring Kemik ss section near East Cr  
at E end Saddleocket Mtns.


Measured and described by ACH & ARK  
Kemik ss unconformably overlies  
Shublike Fm at this location but  
contact is covered. Starting as low  
as possible in Kemik. (Possibly could  
get a little lower. High up on slope  
on cliff face but couldn't get basal  
contact. Got within a few feet though)  
Notes transcribed by C.M.M.

Att: N10W 10N

35' ss med dk gray (N4), L.V.F silty through-  
out except V.V.F in upper 8', mostly  
ll bed, med bed w/ lens & bds at  
4'-6', 17-19 1/2 and 26-27', some  
lens at 4' and 26', non calc, tight,  
abundant vert burrows throughout  
scat qtz and chert pebbles at 0-4',  
14-19', 27-35'  
Ophiomorpha(?) in upper third

± 49A at 1'; 49B at 4'; 49C at 31'

(See 83 AMK-42 for basal contact)

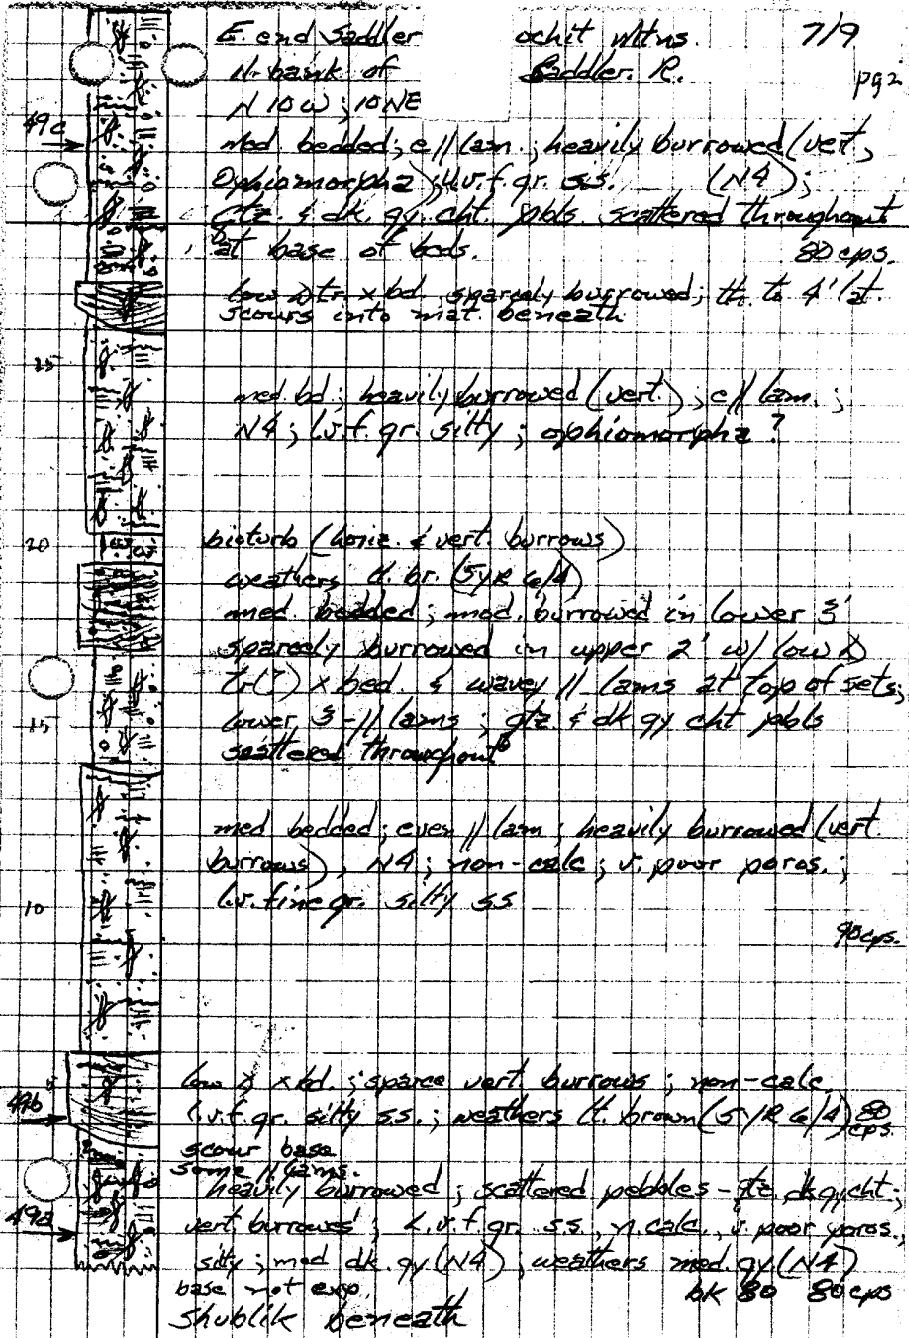

E end Saddle

ocket mtns.

7/9

ll bank of

Saddle R.

pg 2

N10W; 10NE

med bedded; c/l lam; heavily burrowed (vert);

Ophiomorpha; L.V.F. gr. ss. (N4);

qtz & dk. gr. chert pebbles scattered throughout

at base of beds. SD exps.

low intra-bed sparsely burrowed; thin to 4' lat. flows into mat. beneath.

med bed; heavily burrowed (vert.); c/l lam.;

N4; L.V.F. gr. silty; ophiomorpha?

bioturbation (horiz. & vert. burrows)

weathers to br. (5YR 6/4)

med bedded; med. burrowed in lower 3'

sparsely burrowed in upper 2' w/ low D

2-3' x bed. & wavy ll lam. at top of sets;

lower 3-1/2 lam.; qtz & dk gr chert pebbles

scattered throughout

med bedded; even ll lam; heavily burrowed (vert.

burrows), N4; non-calc; v. poor pres.;

L.V.F. gr. silty ss

90 exps.

low & x bed; sparse vert burrows; non-calc

L.V.F. gr. silty ss.; weathers to brown (5YR 6/4) exps.

scour base

some ll lam. heavily burrowed; scattered pebbles - qtz & dk chert;

vert burrows; L.V.F. gr. ss., v. calc., v. poor pres.;

silty; med dk. gr. (N4); weathers med gr. (N4)

base not exp.

Shublike beneath

ok 80 80 exps

80AMK-49 Cont

7/9/80 pg 3

- 2' ss-siltst, arg, LVF w/ stly w/scat  
chert and qtz pebbles up to 3/4"  
This unit is eroded back from  
resistant ss below
- 4' slty sh, dk gray-blk, mm calc p. lrd  
B-49 D <sup>sh calc</sup>
- 3' siltst, dk gray, p. lrd, concretionary  
(ironstone) orange w/x, mm pbb
- 7' slty sh BK 80 CPS 100
- 1' Ironstone conc zone
- 12' slty sh BK 80 CPS 115  
B-49 E
- 1' Conc lrd
- 18' slty sh BK 80 CPS 140  
B-49 F
- 1' Conc lrd.

7/9/80 pg 4

80AMK-50 N/2 N/2 Sec 27-4N-2BE  
Mt. Michelson C-3

Checking to see if we can measure thick-  
ness of pebbly sh unit but upper con-  
tact with bentonitic section is not  
exposed. Base is not exposed either  
but probably close. Lower 50'±  
is slty pebbly mudstone - LVF ss  
zone. Alt. N70E 15.5(F) N?  
Above is at least 200' of fissile  
blk sh, scattered pebbles in float.

About 150' or more above base  
is a quartz ss rubble zone. Appears  
to be in place. Prob not more than 5'.  
ss LVF w/ some LF, quartz, but  
badly w/x  
± 50'

= BOACH-22

80AMK-51 NENE SW Sec 26-5N-27E  
Mt. Michelson D-3

Otc near junction of Nularuk and Katak-  
teiruk Rivers. 15' etc of fluvial ss, LF,  
sh calc, thick lrd w/ abundant carb and  
transported coal along bedding planes, li to  
ripple lrd, abandoned silt-filled scours,  
water expulsion structure at base  
Nearly flat lying

7/9/80 pg. 5

BOAMK-52 W $\frac{1}{2}$  W $\frac{1}{2}$  SW $\frac{1}{4}$  Sec 16-6N-2BE  
Mt Michelson D-2 Quad

etc of oil-stained ls on E side of Katak-  
turuk River. 6 or 8' exposed

ls, gray, dark brown on fresh break (oil  
staining) VF-LM, generally 11 bed w/  
some small scale ripple beds, minor  
med scale x beds, com carb debris,  
Tasmanite (?) pebbles in float below,  
com qty of chert granules and small  
pebbles scattered along bedding  
planes.

This is prob a fluvial ss - Saga-  
wanitch Fm, Sagwon Mbr

Att N55E 20NW (1F)

CMM, ACH & ARK

7/11/80 pg. 1

BOAMK-58 NESE Sec. B-3N-35E  
Demarcation PT C-5

Checking Sabboth Cr. section  
ATP Sample of silt just below 2-  
3" coal stringers. Att: NBW 415  
at unit 2 1/3 on section

Upstream at base of section is  
channeled ss or dist mouth bar overlain  
by marine sh which goes upward  
into a regressive ss - a couple cycles,  
no burrows or other fauna

BOAMK-59 NWNW Sec 4-3N-35E  
Demarcation PT C-5

200' + exposure on W side of creek.  
Fluvial ss w/ pebble cgl, one carb. sh  
zone dug out; Att 54

Lots of scouring in fluvial section, fac-  
eted, but some x ds  $\rightarrow$  N and bed-  
ding crests  $\rightarrow$  N 30W. Mostly 11  
poorly bed. Att NB5E 40N

7/11/80 pg 2

(80AMK-60) CN/2 SE Sec 33-4N-35E  
Demarcation Pt C-5

Several 6"-30" cal bed separated by covered intervals that appear to be carb sh-silt as indicated by squirrel diggings.

Calcs are massive - p bed, pebbles and cobbles to 3" of lith chert, quartz, opx & silicified ss. Not many direction features. Possibles of N30E, N30W  
80 60 of carb silt

(80AMK-61) SWNE Sec 33-4N-35E  
Demarcation Pt C-5

Same as above  
80 61 of carb silt

(80AMK-62) NW/NW Sec 34-4N-35E  
Demarcation Pt C-5

Same as above  
80 62 of carb sh

(80AMK-63) NW/NW Sec 34-4N-35E  
Demarcation Pt C-5

Same as above  
80 63 of carb sh

7/11/80 pg. 3

(80AMK-64) NESE Sec 22-4N-35E  
Demarcation Pt C-5

Low energy fluvial ss, 11 bed & silt. Corn leaf and stem fossils  
One 6" carb coaly bed. Dip 8° north  
80 64 of carb silt

(80AMK-65) NW/NW Sec 4-3N-35E  
Demarcation Pt C-5

In lower part of section. Thick section of shaly fine grained ss. Corn carb material on bedding planes. Marine or nonmarine?  
Down section is some sh.  
80 65

(80AMK-66) NENE NE Sec 17-3N-35E  
Demarcation Pt C-5

On south flank of small(?) roll over at south most ocs. Att: N75E 24 S  
Several fractured ocs of ss & silt  
80 66A & B

7/11/80 p 94

80AMK-58 to 64

### Summary of Saliboth Cr

Entire 1,000' section appears to be an overall regressive sequence changing from shallow marine at the base to transitional delta plain to alluvial plain. In general the section becomes more conglomeratic in the upper part.

The basal marine part contains no fossils & no laminas, but physically it looks like a regressive shoreface above neritic marine siltst. The sands are very argillaceous and not too well sorted - prob was a low marine energy river-dominated delta. The fine-grained sands and cgl are poorly sorted and lithic in composition. Clasts in cgl are blk chert or argillite, quartzite and other chert. There is much channeling and scouring and some med scale trough cross bedding, but mostly  $\frac{1}{2}$  bedded. Direction features are few and far between, but most seem to indicate north to possibly N 30 W transport directions.

CMM, ACH & ARK 7/13/80

80AMK-6T C E  $\frac{1}{2}$  E  $\frac{1}{2}$  Sec 24-4N-31E

Mt. Michelson C-1

69° 41' 15" N Lat. 144° 23' 19" W Long.

E bank of Saddlecreek River - Shale etc. Long hillside exposures - discontinuous - of bentonitic shale w/ abundant bentonite interbeds, thin fissile shale and con. discontinuous layers of prismatic calcite (Inoceramus prisms?) stacked up layer on layer or interbedded w/ shale. Inoc. zone (2 etc) is about 15' thick, base not exposed. B 67 exposed and 10' thick, base not exposed. Structure is contorted but generally dipping steeply SE

80AMK-6B SESE Sec 22-4N-31E

Mt. Michelson C-1

Two miles west of Sad. River. Out of Kemik ss, LVE, about 6' exposed, base covered and top or overlying pebble sh eroded. However pebble zone on top of Kemik indicates this is the top. Prob. not much thicker cause a short way below is blk sh rubble and squirrel droppings of Kungur sh.

6B-6B

Att: N10E 20 E (E)

1 1/2 mi to N is another etc of Kemik dipping to NNW toward Red Sulber rubble

EMM, ACH & ARK

7/15/80

BOAMK-69 SWSE Sec 3-6N-36E

Photo 7070 Demarcation Pt. D-4

59° 53' 57" N Lat, 143° 06' 46" W Long.

Massive sh etc on tributary of Naguanah River (This may be pebble sh - 1983)

Much snow covering much of creek banks and etc.

ATP on east side of creek is a loose shale rubble etc on small nose. If dip is steep prob 30-40' exposed.

Sh, dk gray-blk N-2, uniform firm, appears to be very clayey, but is mainly rubble, scat calc cones.

± 69 A & B

Immediately across gully on south side 50' ± is a very muddy, bentonitic, side-hill gap in which a small gully draining it contains abundant bentonite and a few small ammonites

± 69 C

Also coming out of this same goo are chunks up to 1/2" of black, light weight, coal-like material. Is this a solid hydrocarbon, ie gilsonite? ± 69 D

From 1000' to 1400' upstream are some shale paper sh, bent etc in and along stream.

Dip: NBSW BOS some are contorted

0.5 to 0.6 mile upstream are more bentonitic shales, wet muddy contorted etc (slumped?)

(over)

7/15/80 pg. 2

NENE Sec 4-6N-35E

BOAMK-70 ~~SESESE Sec 33-7N-35E~~

Demarcation Pt D-4

59° 54' 40" N Lat; 143° 23' 28" W Long

Bentonitic, organic shale exposed along west side of Jago River

About 150-200' exposed, steeply dipping and somewhat contorted, dipping 60-75° to 55W.

Interbedded sh and bentonite with zones of prismatic calcite similar to *Inoceramus* prisms. They are separate stringers usually pinching out in about 12" but some are longer. But there are so many of them and they overlap so it appears as many long veins along bedding planes ± or ±? 70 zone is 12-18" thick 20' ±

Sh is dk gray-blk, fissile, very soft and paper, organic, oily smelling w/ yellow jarosite or sulfur specks ± 70 A-C

Bentonite beds up to 4" thick, soft, yellow to white, makes up 10-20% of etc.

Upstream a short way above JK  
outcrop, probably where side drainage  
comes in from east, found large  
Belemnite in creek bed (float)

3 80AMK-69E

7/15/80 pg. 3

80 AMK-71 SE SE NW Sec 34 - 7N - 35 E  
Demarcation PT D-4

Down river 1/2 mile from Sealree sh etc  
on W side Jago Falls  
30-50' exposure of soft sanduced sh  
w/ orange-brown w/ beds or conc layers

sh or mudstone, silty, olive gray, 5Y 3/2,  
very soft, non fissile, p bedded, contains  
rare scattered chert (gray) pebbles up to 2",  
but most are < 1/2", smells petroliferous  
8 71 A & B No bentonite seen, ~~but soft~~

± Com layers of non calc conc beds 1-4" thick,  
some contain isolated or scattered pebbles and  
granules. One looked like pebble had dropped  
into soft mud

± 71 alt: N40E 20 NW (P-F)

This must be Tertiary

CMM, ACH & ARK 7/16/80 pg 1

80 AMK-72 SE NE Sec 28 - 2N - 31 E  
Mt Michelson C-1

Ridge where map shows Albian ammonite collection

Rubble etc, some close to in place of  
Brookian ss w/ common sole marks  
ss VF-F w/ some VF-M  
etc seems to be dipping gently (10-25°)  
to south. These are turbidites  
above and below (stratigraphically)  
is shale rubble  
Took soil and veg. sample

Prior to this stop we landed near  
a rubble etc 900' to west  
which was quite slicked and sheared.  
This may be large fault in which  
Albian is thrust up to or over  
Upper Cret.

80 AMK-73 NW SE Sec 27 - 2N - 31 E  
Mt Michelson C-1

75-100' sh exposed on hillside, mostly rubble  
but enough in place, sh dr gray-bk,



7/16/80 pg 2

B Hard, sub-fossil, some manganese stain, scat pebbles in float (chert & quartz) undoubted 2 dly from sh. This is prob pebbles sh  
80-73 A-c no concs, non bent.

(80AMK-74) NE SW Sec 22-2N-31E

Mt. Michelson C-1

About 100 strat ft below a cross covered interval. Dip slope of hematite stained sh rubble, below is 10-15' partly exposed sh, dk gray, non fossil, hard no pebbles in float, some small manganese? pebbles or 1/8" nodules. Qtz crystals in float

80 74

Att: N75E 30S (G)

(80AMK-75) NE SW Sec 22-2N-31E

Mt. Michelson C-1

B A few hundred ft NW across covered zone is 50' of sh with, fissile w scattered ironstone concs, some pebbles in float. Prob all pebbles sh 80-75

(80AMK-76) C W/2 Sec 22-2N-31E

Mt. Michelson C-1

Large reddish w-x etc on rounded ridge. Looks like red zone from distance but is ss and covered bent sh. Sh is VF-E, rubble etc, sole marks, some is weathered reddish or hematitic, appears to be dipping to S or SE although

7/16/80 pg 3

it is not consistent. Prob just south of ridge is large fault that brings pebbles sh against upper Cret

(80AMK-77) NW Sec 21-2N-31E

Mt. Michelson C-1

Checking outcrops on noosing ridge. Brookian ss interbedded w/ sh. Several units of ss or possibly same unit offset by faulting

Att: N75E 18S (F)

(80AMK-78) C W/2 Sec 30-3N-32E

Mt. Michelson C-1

E Near top of Kingak Hill Brookian ss, one unit about 30' thick w/ thin shale interbeds, highly fractured, mostly VF, well sort, fairly coarse for a Brookian ss, beds 1-3' thick, scat. sole marks (?) trending N65E, N70E, N75E. Sole marks com in float. hard, tute

80 78

CMM, ACH, & ARN 7/19/80 pg. 1

80AMK-82 C 5/2 Sec 23 to C SW/4 Sec 14  
T. 2 N, R. 30 E  
Mt Michelson C-2

Traversing down hill from 7535 knob  
to N 1/2 miles.

From 7535 knob in C 5/2 Sec 23 to  
head of gully in C NE/4 Sec 23 is puffy  
soil of bent sh and turbidite ss float.  
at C NE/4 Sec 23 is rubble etc of  
pebble sh, manganese w/ scat pebbles  
just N of this to C N/2 N/2 N/2 Sec 23  
is soil and rubble of bentonitic sh.  
From there to NW on east side of gully  
to C SW/4 Sec 14 are discontinuous  
rubble etc of pebble sh, some w/  
ironstone concs and manganese and  
pebbles, some very fossiliferous.  
# 82 A-D from SE to NW

80AMK-83 C 5/2 Sec 2 - 2N-30E  
Mt Michelson C-2

Quick stop to examine sh etc just east  
of junction of Keketch & Sadlerock Rivers  
sh w/ ironstone concs, minor pebbles  
This is pebble sh

7/19/80 pg. 2

80AMK-84 NW/4 Sec 12 - 2N-30E  
Mt Michelson C-2 Quad

Two shattered ss etc separated by  
bentonitic sh. ss beds are 10'-20'  
thick, highly fractured, steeply dipping,  
turbidites. Whether these are two  
separate ss units or are duplicated by  
folding or faulting was not deter-  
mined. Sole mark trend: N15W

Between sta 84 and 83 is a lt gray,  
weathering, bentonitic-looking sh w/  
thin turbidites.

80AMK-85 NE/4 Sec 5 - 2N-30E  
Mt Michelson C-1 Quad

Quick stop to try to get sh sample, but  
too covered w/ float and weathered.  
But is same as that between sta 84  
and 83.

Lt gray w/ bent sh w/ thin VF turb-  
idites, many sole marks.  
Traces of bedding indicates uniform  
gentle dip to south all along here.

7/20/80

BOAMK-B6 NW SE Sec 7-4N-27E  
Mt. Michelson C-3

Tributary of Tamayacale River. A couple  
hundred ft of sly sh, med dk gray, N-3,  
? led, v-sly, bentonitic but no bent-  
onite beds. Dipping 20°± to N  
⊗ B6 A-C non calc to v sli calc.

CMM, ACH & ARK 7/21/80

BOAMK-B7 NE/4 Sec 27-7N-35E  
Demarcation Pt. D-4

On W bank of Jago River  
OTC of soft gray brown mudstone w/  
yellow brown siltst. Very soft, poorly  
exposed, bentonitic (?). Dipping v  
slightly to N  
⊗ B7

This is location where Cons. Div got  
Eocene paleo.

BOAMK-BE NWNW Sec 23-3N-39E  
Demarcation Pt. C-3

Isolated outcrop along small stream.  
About 200' of near vertical dipping  
Mungah Sh. (?) v blk, fissile, clayey  
non calc ⊗-B8

7/1/80 pg 2

80AMK-27 NE Sec 6-2N-26E  
Mt. Michelson C-4

South side of Igneof Valley  
Measuring up section from top of Kemik  
ss where Bill Mull measured Kemik  
Att in Kemik N 85 E 67 SE (overturned)

Contact covered but loose pebble shale  
within 10'. Pebble sh is largely covered  
with its own rubble and bedding dips  
are hard to see - probably some con-  
torting and dragging. Measurements  
given are taped horizontal distances

0-210 210' Sh, dk gray-lk (N-2), fissile, rare  
pebbles in float - quartz graywacke,  
one up to 3". Sh is iron stained on plates  
B A-E or F BK=80 CPS=130

Scattered ironstone concs  
ATP dug out interbedded benton-  
itic lk sh w/ gray swelling  
clay, lt gray (altered ash)

B G BK 130 CPS = 200

0-300 90' Fissile lk paper sh w/ bentonite  
B H, I, J H BK=150 CPS=350  
I " 130 " 220  
J " 150 " 310

Some thin, hard, sh calc stly sh beds

Ignof Valley Sec.

7/1/80 pg 3

300-400 100' Sh, blk, N-2, fissile, w/ about  
15-20% 1/2" - 1" bent lds

⊗ K & L      K BK 150; CPS 300  
                  L   " 110   " 130

400-600 200' More of same

⊗ M, N, O, P      M BK 100; CPS 140  
                          N   " 100   " 140  
                          O   " 130   " 200  
                          P   " 120   " 150

600-800 200' Largely covered w/ sh rubble and  
red silicified tuff. Much more  
soft muddy bentonite in section

± Sample of red silicified tuff = Q  
at 725'

⊗ R at 800'

800-950 150' Largely covered as above

⊗ S & T      S BK 120 CPS 150  
                  T   " 120   " 135

at 100' ± is rubble of 1/2-1" ls  
± BOAMK-27 U of ls.

pg 4

950-1100 150' Sh dark gray N-2, splintery, stgy  
limonitic stained surfaces, interbed  
w/ bentonite.

Bentonite percentage seems to be  
abruptly less than below 950'

Upper 50-100' is softer, med gray  
N-4 stgy sh w/ 10% ± bent.

scat pebbles

⊗ V, W, X      X-BK 100 CPS 150  
                  V at 1000'  
                  X at 1100'

1100-1250 150' Sh as below becoming less bent  
upward,

⊗ Y & Z      Y BK 60; CPS 100  
                  Z   " 90   " 170

Com chert pebbles in float up to 1 1/2"  
in lower and middle part

Platy VF as float w/ sole marks  
in upper 20'

⊗ Z at 150'

1250-1328 78' Sh as below, bentonitic, com as  
float as described, mostly covered

⊗ BOAMK-28 A & B  
                  BKA CPS  
                  " B 100   " 150

pg 5

1328-1339 11' Ss, med gray, VF-LF, planar bedded fractured, largely rubble but some in place, plant frag com sole marks in rubble interbedded w/ bent sh

70-  
78

± 2B C  
⊗ 2B D

Att N70W 78S  
overturned

1339-1416 77' Broken etc sh as below, bentonitic w/ thin < 1' ss interbeds

1416-1422 6' Ss as in 11' interval above. No sh interbeds. Sole marks trending NE ±

1422-1512 90' Broken etc or covered soft section sh w/ thin ss interbeds  
BK 60 CPS 120 ✓

1512-17 5' Ss as described, fractured, rubbly BK 50; CPS 50

1517-25 3' Sltst - slty sh interbedded  
⊗ 2B E BK 50 CPS 90 ✓

1520-30 5' Ss as described

~~1520-30~~ Mostly covered sh w/ ss float  
Cont on next page

Cont. 7/2/80

pg # 6

1530-1730 200' Mostly covered bent sh w/ ss rubble, prob 10-15% SS UVF-LF, some sole marks

1730-2005 275' Blk sh & bent, broken etc soft fissile blk sh (N-1)  
⊗ 2B F BK 70 CPS 210 at 60'

⊗ 2B G at 90' BK 80; CPS 200  
⊗ 2B H at 120' " 80 " 150  
⊗ 2B I at 183 " 80 " 170  
⊗ 2B J at 225' " 70 " 140

Last 75' ± is not fissile and is dk gray (N-3), slty

2005-20 15' Rubble etc blocky ss, lt gray LF-UF w/ M

2020-2140 120' Mostly covered - broken etc Sltst slty sh, 5YR 4/1 grayish brn, non fissile, non bentonitic apparently. ⊗ 2B K BK 40; CPS 80

No otos above


CMM &amp; ARK

7/3/80 pg 7

Photographing and checking Lagnek Valley section - sta 27 & 28

Discovered there is a tight incompetent-sediment plunging synclinal fold that we missed below. At N end of fold is a fault and section continues on normally with an unknown amount (probably small) of section cut out.

Re-measured parts of section on ridge top to correct errors in duplication

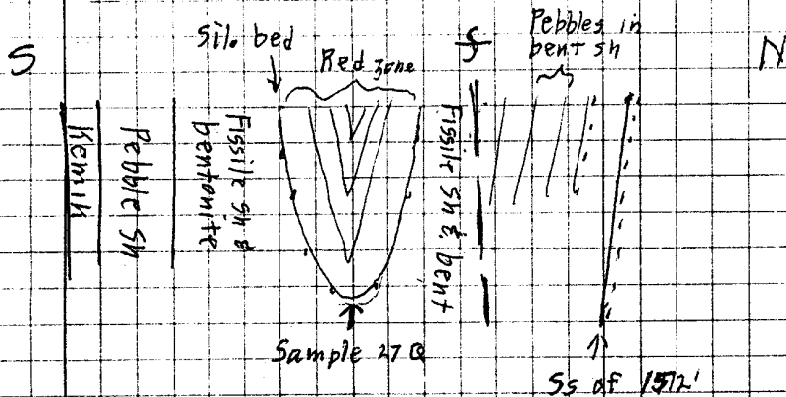

Plan View

7/3/80 pg 8

## Lagnek Valley Section

Measurements (horizontal distance (chain) across strike - beds are near vertical):

From base bentonitic sh (top Kpg) to resistant silicified tuff bed (porcelanite) which was where  $\pm$  sample 27 Q was taken below = 400'

About 50'  $\pm$  more section (estimate) is present from here to syncline axis.

From fault to where there is an abrupt lith change from fissile papyry sh and much bentonite to splintery silty, limonite-stained sh and much less bentonite across fault. This was noted at 950' in section measured the other day. From this fault to resistant ss bed at 1572' on section below is 578'. Pebbles were noted in bentonitic sh at 200' and 300' in this interval.

Putting all this together section is approximately as follows: Refer to intervals measured on first day for details of lith.

7/3/80 pg 8

0-210 210' Pebble sh  
 210-610 400' Blk fissile sh and bentonite  
 Samples 27 H-P going up section  
 Samples B, S, T & U of this interval  
 but reversed order  
 Sample 27 Q at top of interval  
 610-60 50' (Estimate) Red zone - red w/ siliceous  
 tuff (porcellanite) sh and bent.  
 f Fault  
 Interval measured above 528'  
 Same interval ± measured below 567'  
 Average = ~~547~~ 545  
 660-760 100' Splintery w/ slty limonite-stain sh  
 w/ bent (less)  
 Sample 27 V W  
 760-910 150' Sh mid gray soft w/ pebbles & bent  
 Sample 27 X & Y  
 910-60 50' Sh becoming less bent w/ ss float  
 in upper 20'. Sample 27 Z at top  
 -1032 72 Refer to 78' interval  
 -1043 11 do  
 -1115 22 Refer to 77' interval  
 -1121 6 do  
 -1205 B4 Refer to 90' interval

7/3/80 pg 90

<sup>1512</sup>  
 -1833 628' Refer to interval 1228-2140  
 1833' Total section (Top covered)  
 All this is below or older than  
 interval seen at sta 34

7/5/80  
 (BQAMK-28) (Cont) SWSWNE-6-2N-26E  
 Mt Michelson C-4


Collecting closely spaced sh samples across  
 contact of non-bentonitic, ie, pebble sh,  
 and bentonitic sh (beabee?) on ridge-top  
 exposures along section.

8 28 L at 0 slty sh non bent.  
 M " 12' " "  
 N " 24' " "  
 O " 40' " "  
 P " 50' " "  
 Contact - condensed zone?  
 Q at 60' Fissile blk sh w/ bent.  
 R " 70' " " "  
 S " 85' " " "  
 T " 105' " " "



7/7/80 pg 5

BOAMN-34 NWNW Sec 5-2N-26E  
Mt. Michelson C-4

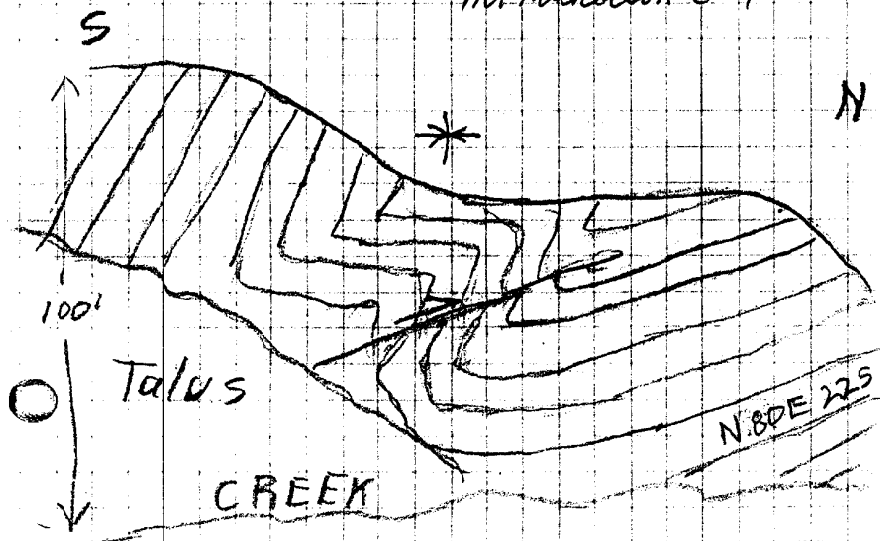

Axis of syncline in Squak Valley

Interbedded sltst-sltty sh and ss.  
So, med gray, LF-VF, 1m beds 2-5" thick  
sharp beds, Bouma B, C, D, sole marks  
trend N 70° E ±, no grading apparent  
but prob are turbidites

BK 40 CPS 50 (U) BK 40 CPS 82 (Z)

sh-sltst, dk gray N-4, non fossil, firm,  
com floating sand grains,  
B 34 A, B, C non bentonitic.

These look like Tertiary Alt on N NBDE  
225

7/7/80 pg 6

BOAMN-34 (Cont)

None of these part of section is exposed  
in section measured 1/4 mile to west  
(Sta 27 & 28). There must be a fault  
in between. These sediments are  
non bentonitic and must be younger  
than section to west.

BOAMN-35 SW Sec 32-3N-26E  
Mt. Michelson C-4 Quad

Walked downstream 1/4-1/2 mile from  
sta 34 to look for underlying ben-  
tonitic section present in measured  
section to SW. This is on N side of  
syncline axis where section is mostly  
sh rubble w/ some ss, but it  
doesn't appear to be bentonitic as  
far as bend in creek (extent of old)  
There are some 1-2' ss beds, some  
well graded, one w/ small pebbles in  
lower part, good sole marks trending  
NBSE

Alt at pt where station is plotted:

N75 W 31 S

Entire hillside appears to dip similarly

31 T

7/20/82

P1

Molokan Kink &amp; Magoon

82 AMK-17 = 80AMK-272B Mt. Nicholson  
NE/4 Sec 5-2N-26E C-4Lonek Valley section  
Measuring gamma-ray count starting  
in Peble sh - low in section and  
measuring every 20 ft. Starting  
low on hillside near creek.

	BK	CPS	
1	130	165	
2	"	180	
3	"	185	
4	135	190	
5		180	
6		200	
7	150	170	wash &
8		180	rusty
9	150	210	rusty
10	250	370	
	= ± top KPS on section		Bent
11	200	430	sh slumped
12	200	350	
13	200	270	
14	200	325	
		(350 in bent)	
15	250	610	
	Simpl 17A		
16	210	340	
17	210	400	

Took 2  
pins

7/20/82

p2

82 AMK-17 Cont

Measuring gamma-ray count on  
top of ridge of Lonek Valley section  
Starting at top KPS or base shale wall -  
sh slumped in first

	BK	CPS	
1	170	170	47A
2	180	320	B
3	190	380	C
4	210	620	D
5	200	310	E
6	200	530	F
7	210	460	G
8	190	370	H
	Saddle - or bent above		
9	200	450	I
10	160	300	J
11	120	200	K
L	120	150	Rusty zone
M	150	210	L
N	180	230	M
O	180	230	N
	Fossiliferous sh		
P	180	240	Simpl 17B & C & SR
Q	175	200	
18	180	230	
R	185	250	
20	180	250	

S

7/20/82 p. 3

	BM	CPS	
S	21	180	210
	22	190	260
	23	190	250
T	24	190	350
U	25	230	330
V	26	240	350
	27	240	320
W	28	220	340
	29	220	330
	30	210	290
	31	200	290
	32	190	250
	33	190	280
	34	190	280
	35	190	270
	36	130	230

Simple 17C SREB BR fossil  
Sh ↓  
Beginning of red zone  
+ sample 17D of red wax tail

This is on ridge near synclinal reversal

7/20/82 p. 4

82AMK-17 Cont

This section starting just above fault above red zone

	BM	CPS	
0'	1	140	160
20	2	150	200
40	3	150	180
60	4	150	190
80	5	160	180
100	6	140	170
120	7	140	200
150	8	130	190
175	9	140	180
195	10	140	150
220	11	130	140
240	12	130	130

Start of pebbles

± sample of pebbles  
± 17E

82AMK-13 NE 1/4 Sec 6-2N-26E Mt. Michelson C-7

Sampled holes 1-17 at base of hill where first BR counts 1-17 of sta 17

82AMK-18A-17 samples for SR

Sample 18A-17 for SR from 30' below rusty zone BK 250 CPS 360

7/29/82  
Molenaar, Kirk & Magron p 4 (B)

82 AMH-47

Re-measuring and re-collecting lower part of Igouk Valley section and plugging in previous samples.

Starting at base of pebble shale on top of Kershik ss, which is covered, near creek level

Ft	Smpl No.	FK	CPS
102	18A	130	165
30	18B	130	180
52	18C	130	185
70	18D	135	190
94	E		185
115	F		200
136	G	150	170
157	H		130
178	I	150	210
200 ±	J	250	370
212	K	200	430
229	L	200	350
238	M	200	250
246	N	200	325
257	O	200	610
268	P	210	340
280	Q	210	400
340 ±	R	250	360

Wash?  
rusty mix  
" "

Bent from here on

Smpl 17A

7/29/82 p 1

Notes on Igouk Valley section  
measuring on ridge starting at  
base of Devonian shale ±

Adj. 57

172	0	
316	144'	saddle
370	195'	base rusty zone
391	219	top rusty zone
497	327'	2' first yellowish orange silty
568	400'	base of red silty float
610	443	yellow silty resistant bed 330-400' flint blk shuff

Measuring below near base of  
shale starting in covered interval  
approx base of KPS

200	200' ±	first bent	200
280	285	17 <sup>th</sup> sample (18Q)	280
378	378	base of rusty zone	370

③ 18C 50' ± above base

7/29/82 p2

Notes on Squib Valley section remeasure  
(Cont)

FT	Sample	SR	BK	CPS	
0	47A		180	150	slump?
21	B		170	330	
40	C	✓	175	350	
56	D		200	620	
74	E	✓	150	375	
92	F		200	550	
110	G	✓	170	430	
129	H		220	430	slump?
161	I		220	440	
177	J	✓	140	200	
190	K		125	200	
200	L	✓	120	150	(195-217 rusty zone)
217	217	M	140	160	
224	233	N	✓	150	210
247	252	O		150	210
265	269	P	✓	190	210
278	282	Q		180	160
290	300	R	✓	150	250
320	340	S	✓	165	240
365	380	T	✓	200	340
377	392	U		200	320
390	406	V	✓	200	300
400	420			220	350
413	433			230	380
420	450	W	✓	210	310

Rewrite 7/29/82 #2  
Plugging in samples and GR readings into  
section & adjusted to 1980 section\*

FT*	F+	Smp No.	BK	CPS	BK	CPS	2nd Time (8 days later)
183		47A	120	150	120	170	slump?
202		B	170	330	180	320	
220		C	175	350	190	380	
235		D	200	620	210	620	
252		E	150	375	200	370	257 17A
270		F	200	550	200	530	
287		G	170	430	210	460	
306		H	220	430	190	370	slump?
327		I	220	440	200	450	18R
353		J	140	200	260	200	Rusty zone
365		K	125	200	160	200	370-392
375		L	120	150	120	150	
390		M	140	160	150	210	
406		N	150	210	180	230	
420		O	150	210	180	230	fracture sh
438		P	190	210	180	240	= 17B
450		Q	130	160	175	200	
					180	230	
462		R	150	250	185	250	
					180	250	
501		S	160	240	180	210	17C
536		T	200	340			Paper sh
548		U	200	320			Very bent
560		V	200	370			" "
							" "
600		W	210	340			" "

\* Measurement from base of pebble shale

11/8/84

Laneke Valley Section - Approximate stratigraphic position of samples measured up section from top of Kemuk ss

Sample	Depth (FT)	Sample	Depth (FT)
80 AMK-27 A	11	BDAMK-28A	985
B	48	B	1015
Pebble shale C	78	C	1033
D	110	D	1038
E	139	E	1215
F		F	1470
G	219	G	1520
GRZ H	251	H	1530
I	290	I	1595
J	330	J	1636
K	370	K	1755
L	428	L	155
M	461	M	167
N	505	N	179
O	544	O	195
P	583	P	205
Q	610	Q	215
R		GRZ R	225
S		S	240
T		T	260
U		U	
V	680	V	
W	740	W	
X	795	X	
Y	885	Y	
Canning Fm Z	960		

80 AMK-34 A, B, & C are from Tertiary (?) unit at top of section.

11/8/84

Laneke Valley Section - Approximate stratigraphic position of samples measured up section from top of Kemuk ss

Sample	Depth (FT)	Sample	Depth (FT)
82 AMK-18A	10	82 AMK-47A	183
B	31	Pebble sh B	202
C	52	C	220
D	73	D	235
Pebble shale E	94	E	252
F	115	GRZ F	270
G	136	G	287
H	157	H	306
I	178	I	337
J	200	J	353
K	212	K	365
L	224	L	375
M	235	M	390
GRZ N	246	N	406
O	257	O	420
P	268	P	438
Q	280	Q	450
R	340	R	462
		S	501
		T	536
		U	548
82 AMK-17A	257	V	560
B	438	W	600
Hue C	510		
Sh D	590 ±		
E	880 ±		

(over)

82AMK-82 NW NW Sec 5-2N-26E  
= 80AMK-34 Mt Mich. C-4

Revisit to Tertiary (?) at top of Ignek  
Valley section for photographs.

Took shale sample 82A & B

84AMK-B Ignek Valley section

near C Sec 6-2N-26E  
Mt Mich C-4

Judy Parrish found ammonite in  
float near Kingak shale outcrop  
below Ignek Valley section.

also collected siliceous tuff sample  
from red zone

± 82AMK-17E

X  
7/29/82 #2

Ignite V. sec: end

Dariusz Rzepa

	FT.	Simpl No.	PK	CPS			
	183	47 A	120	150	120	170	
202	204	B	120	330	130	320	
220	222	C	175	350	190	380	
235	239	D	200	620	210	620	
252	257	E	150	375	200	310	
270	275	F	200	550	200	530	
287	293	G	170	430	210	480	
306	312	H	220	430	190	370	
337	344	I	230	440	200	450	
353	360	J	140	200	160	200	= 18K
5	373	K	125	200	160	200	
375	383	L	120	150	170	150	370-392
390	400	M	140	160	150	210	mostly gone 375-400
406	417	N	150	210	180	230	
420	430	O	150	210	180	230	female sh
433	448	P	190	210	180	240	= 17B
452	461	Q	130	160	175	200	
					180	230	
462	473	R	150	250	185	250	
					180	230	
501	513	S	160	240	185	210	
526	540	T	200	340	Paper sh		= 17C
548	560	U	200	320	Very short		
5	573	V	200	370	"	"	
					"	"	
					"	"	
600	613	W	210	340	"	"	



CMM, ACH, & ARK 7/10/80 pg. 1

(BOAMK-53) NE Sec 7-45-41E  
Demarcation PT. A-3 (SE) Photo # 5453  
69° 06' 46" N Lat, 142° 18' 10" W. Long  
Examining Kongadut Fm type section  
at Batatuk Ridge

Lower part of section is poorly exposed to  
covered, but by walking around we  
could locate units. Landed on flat area  
on small hump made by lower Kemik  
type ss - att N30W 41 S T 53 E  
etc is largely rubble, but some is in  
place. L.F. slty, dark, weathered,  
but looks like quartz Ellesmerian type  
about 10' ± or less thick. Bear digging  
in etc indicates ss immediately be-  
low and above.

2 on hillside below are float on rubble  
etc of hard mudstone - sh, dk gray,  
slty w/ com floating LF sand grains.  
lower half is pencil fracturing, some  
crops out - at least 300-400'  
of section or interval (calculated)  
B-53 A-C going up (350')

Below is covered - no saddle rock

about 30' below Kemik ss is float of  
coquina-like slty ss. Buchia?  
B-53 D

(BOAMK-53) Cont 7/10/80 pg 2

Checked resistant bed on bench below  
large covered interval and found it to  
be Irishak ss. This is 280' in elev  
below base Kemik

(BOAMK-54) SW Sec 7-45-41E  
Demarcation PT A-3 (SE) Photo 5453

On ridge 1/2 mile to west at elev 3750'  
(Chopper) which is 675' above base  
Kemik. This is in small saddle just  
above lower main saddle.  
From here down is all slty sh, w  
hard platy dipping 35-45° S  
This calculates to be about 2100  
feet above base Kemik. Looking  
at adjacent ridges, section looks  
normal, dips are uniform and  
no folding.

Above is more sh, but no hard  
beds sticking out. Chert & qtz pebbles  
in float  
B-54 A-C in 200' interval above  
chopper

Above is all sh (distance view) to about 200'  
below 4700' ridge. First ss appear about  
in upper 200'  
T 54 D from float in gully (of ss)

7/10/80

BOAMK-55 E/2 Sec 18-45-41  
Demarcation Pt A-3 (SE Photo)

High on ridge where section was probably measured. Chopper elev 4720'

Several thick ss etc separated by ss rubble-covered soft silt section  
ss, dk greenish gray, UVF lithic-gray-wacke, no good bedding features - too short a time to look - drained off.  
Dip = 40-45° S.

BOAMK-56 N/2 SW Sec 16-2N-37E  
Demarcation Pt C-4

Quick stop to look at Kungak sh along Achilik River.

sh is dark gray fissile firm and contorted folded and faulted  
56 A & B for SR

BOAMK-57 NW/4 Sec 16-2N-37E  
Demarcation Pt C-4

Kungak sh as above w/ conc.  
57 A & B for SR

CMM, ACH, & ARK 7/18/80 pg 1

BOAMK-79 Sec 18 & 19-45-41E  
Demarcation Pt Quad A-3 (SE)

Photo 5367

Walking down ridge to look at Bathulu Graywacke, started on 5000' peak which is dipping N. Alt. E-W is 40 N. Thus dips into a tight syncline. From peak to south of saddle where chopper landed (130 ft below peak) are structural weaknesses and good south dip doesn't start until about at hump south of chopper.

Section consists of numerous resistant ss beds 15-50' thick separated by rubble and soft silty sh rubble.  
ss greenish gray, mostly UVF-LF w/ con scattered bimodal c grains floating, very hard, p bed or no discernable bedding in much of the highly fractured ones, some trough x bd, but hard to tell w/ all the fracturing, no apparent grading although in upper part of section, granules are in lower part of bed, but matrix is same. Uppermost etc has some granule cal' in trough x bd on upper surface → S. Tidal chan on shelf?

E 79 D & E

8 79 A, B, C & E

7/18/80 pg 2

Sh is slty to sltst, dk gray, hard, had to dig to see - mostly rubble, some blocky patterns on some sltsta - sole marks?

Undecided on what to call environment for this mess - shallow marine shelf or deep water. No good criteria.

There is very little cgl in this section, just a couple thin granule beds, i.e. 1" or so. But ssa have scattered bimodal M-C granules in LF matrix.

Attitudes and samples taken are approximately on Photo 5367.

Traverse down ridge (up section) starts with a folded strata at about high point on ridge where 38° dip is plotted. Flow around folded zone later and estimate that lowest ss in section on N side of peak is about 100-200' below where we started our traverse. According to chopper altimeter, from high pt to low pt at 22° dip is about 1050' drop in elev.

7/18/80 pg 3

80AMK-80 SE/4 sec 7-45-41E

Photo 5453 Demarcation Pt. Quad A-3 (SE)

Landed on break on slope at top of Retterman's sltst member and at base of thick shale unit. He doesn't show on his section.

This thick shale unit calculates to be about 1050 feet thick to base of first ss unit of Bathtub Brayeracke. Calculated by map or photo scaling and using chopper elevations (and later K300a topo).

Sh is dk gray, slty, hard, fissile to platy, com chert ~~and dolomite~~ pebbles up to 1-1/2" in lower 200 ± ft - none above (this is based on float). In upper 100-200' there are some thin 1/8-1/4" sltst interbeds. Contact with first ss is rather abrupt except for thin sltst interbeds. Sh is V.F.V. Hard lithic, fractured. Attitude or dips are 30-35° fairly consistent.

Walked down ridge thru section to base of Kemick ss str 53.

Sltst member part of section is hard platy to fissile slty sh - more resistant. Beds are about the same lith - just a matter of more induration. There seems

Chopper Elev.

AM

Adjusted

Peak	4950	4830
Lowest ss on face to N	4450	4330
2nd " " "	4580	4460
1st landing in high saddle	4820	4700
Landing at 22° dip	3800	3680

PM

Lowest ss on N slope	4400	4200
Saddle at base unreported sh	3910	3740
On lower Kemuk ss 3080 <sup>1/4</sup>	3260	3060
In creek at top saddle rockit	2850	2650

30AMK-80 (Cont)

7/19/80 pg 4

to be no definite contact with underlying Pelvile Sh Mbr just a gradual reduction in platiness and resistance to erosion and becoming more manganeseous. Flint and lithic ss pebbles in lower 50-100' only.

Sandstones of Kemuk Mbr are very thin and mostly rubble etc. Upper most ss is probably only a couple ft, LVF. The middle ss is no more than 15" including silt beds. The lower ss is 6 or 7' in one bed and another rubble etc 5 or 6' above. Lower ss has sharp contacts with underlying and overlying fissile sh. some @, and striations or grooves on base.

30AMK-81 5/2 5/2 Sec 6-45-41E


Photo 5453 Remarcation Pt. Quad  
A-3 (SE)

At top of Sadlerochit (Irshak ss), VF  
Above is shale rubble and squirrel diggings,  
no exposures, no basal cgl or pebble bed  
noted in float  
Sh slty r hard, platy, dark gray-lbllk

80 B1

Att on top Sadlerochit; N60W 25S  
(F)

10/81  
Mangaent Fm Type section  
Bathub-Ridge area Thickness calculations  
using V63360 A-3 Quad

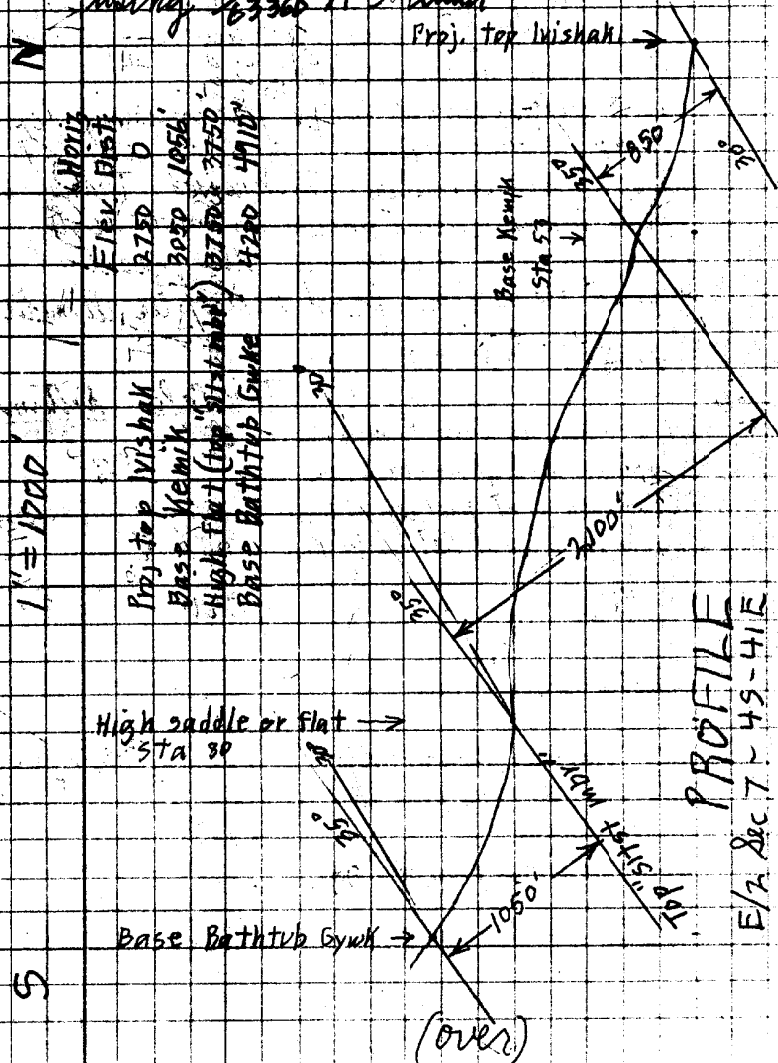

10/81

Summary of calculated thicknesses of  
Kongakuit Fm and Bathub Sraywache  
at a near type section.

Used just-acquired 1/3360 preliminary top  
map, demarcation Pt A-3, to calculate  
(descriptive geometry) thicknesses. Transferred  
points from aerial photos to map with  
fair degree of accuracy. Also, used ad-  
justed elevations from helicopter altimeter

E/2 Sec 7-45-41E

	<u>This Calc</u>	<u>Detterman</u>
Top Irishak to base Kemuk ss	1850	350
Base Kemuk to high bench where	2100	
Detterman et al put top of Kim.	2100	1740
Bench to base of 1st ss of Kbg	1050	
Total	<u>4000</u>	<u>2090</u>

Bathub Sraywache

Part traversed down ridge	1360	SE/4 Sec 18
Calc. remaining part to syncline	1400	T 45, R 41E
Est. additional part at base	150	
Total Bathub Sraywache	<u>2910'</u>	<u>2460'</u>

CMM, ARK, LBM 7/24/83 p. 1

83 AMN-27 Sec. 1-45-39E

Demarcation Pt A-3 (SW)

Bathub Ridge in area of Dettmans West syncline section

Top of Sadlerochit - <sup>LVF</sup> coarse stst, gray very hard blocky, abundant burrows in top 2 ft. Below top 5-10' is 15-20' soft covered section, then main Sadlerochit.

± sample 27 of coarsest ss we could find att E-W 67.5 G

A few ft above is squirrel digging of black sh hard, fissile-platy

± sample 27A

About 75-100' above is good rubble of blk sh ± Geochem sample 27B

Covered to base of hill, then discontinuous fissile shale with some Puchia coquina float

		Ft above base
± sample	27C	300'
" & Geochem sample	27D	600
" "	27E	900
" "	27F	1300
" "	27G Kps	1800
" "	27H	2000

± sample (Puchias) 27C, F & E

CMM, ARK, LBM 7/24/83 p. 2

83 AMN-27 Cont

Puchias in 27F are in fissile platy sh and are fragile. Puchia and large pelecypod in 27E Puchia was found strat below other pelecypod

27G is prob pebble sh - contains rare small pebbles in some manganese? nodules

27H is at base of hard platy shale - Dettmans stst member

Att at base (top PKs) is E-W 67.5 Several attitudes going up section are about the same decreasing to 54° dip at 27H

83 AMN-28 C N/2 Sec 8-45-40E

Demarcation Pt A-3 (SW)

Bathub Ridge Chopper elev 4660' on high saddle above resistant "stst" mbr Hiked up hill and collected samples over 500-1000 ft of section

Geochem samples 28A, B, C, D  
± samples 28B, C, D

7/24/83 P.3

83 AMK-29 C  $\frac{1}{2}$  Sec 5-45-40 E  
Demarcation Pt A-3

Bathub Ridge area  
Collecting samples through upper half  
of "silt" member

Geochem & B samples 29 A, B, C, D

Att: Dip is about 40-45° S

83 AMK-30 NW Sec 5-45-39 E  
Demarcation Pt A-3

NW end Bathub Ridge area  
Landed chopper near top PFS  
Hiked up to pebble sh, found a few  
pebbles and manganese nodules  
Geochem and B sample 30A  
Geochem sample ~~30B~~ " 30B

in lower part of Kps above 3-4' of  
fogy quartzose coarse silt, in  
beds 2" to 6" wavy bedding w/  
shale interbeds, gradational Pass  
± 30C Kemik ls (?)

Below from Kemik to base is all shale, mostly  
covered in lower part. Scattered Brachio  
± 30-D in upper part of this interval  
Geochem sample D & E below Kemik

Att dip 45° ± to S

Molenaar and Kelley 7/18/85

Reconn trip to Bathub Ridge  
on beautiful clear day.

85 AMK-28 Near C NW/4 Sec 5-45-39 E  
Demarcation Pt A-3

Revisit to Sta 83 AMK-30 on south  
side of B.R. and to west:


68° 07' 41.3" N : 142° 45' 50.9" W in saddle  
at base of LK section there is prob.

shale-like fossiliferous dark ls.  
± 85-28A on timber covered dip slope to N.

Immediate west, this bed appears to  
be about 15' thick and continues  
for quite a way. Down gully a  
few hundred ft to E, it is not  
present. There LK sh-silt is  
within 15-20 strat ft of dip slope  
of PFS VFS, dark gray, hard,  
shale calc ± 85-28B

± Basal LK is slty w/ 1-2 mm thin  
sh laminae ± 85-28C

Att: E-W 425

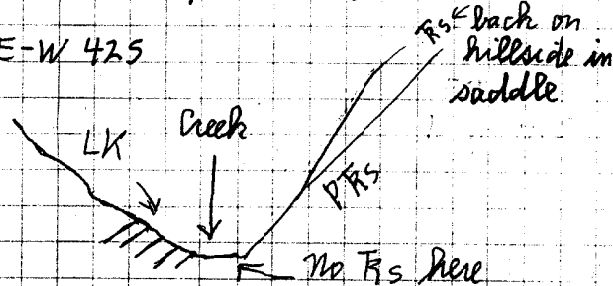



7/18/85 p. 2

85AMK-2B (Cont)

This does not seem to be a fault contact at base of LK -- no slickens, no contortions etc. However, there is no basal transgressive ss or anything to indicate a normal transgressive sequence except for thin laminae of ss.

Away from contact, PT<sub>3</sub> has concentric folding and faulting that does not carry into overlapping LK. However at contact, PT<sub>3</sub> and LK appear structurally conformable. More work needs to be done on this problem.

Walked up through LK section as far as "siltstone" mbr. as described in 83-70. Scintalometer readings were 60-80 background and 60 to as much as 110 on etc. throughout sequence. No increase in pelitic shale. Found some odd-looking

85-2B fossils or burrows (conducted) just below "siltstone" member. 85-2B

John found 1/4" thin hard tuff layers in "siltstone" mbr, which may be why "siltstone" mbr is more resis-

7/18/85 p. 3

85AMK-2B (Cont.)


tant to erosion. It certainly doesn't look any siltier than the other shales.

John took samples of tuff for thin sections and for rad's.

Flew around west and south side of BR and took a lot of pictures. On south side, Lisburn is thrust over PT<sub>3</sub> in places. Seems to be more of an overthrust province like central Brooks Range.

10/81

Bathub Ridge section  
 Calculations on partial thickness  
 of Bathub Range  
 Sta 80AMK-790

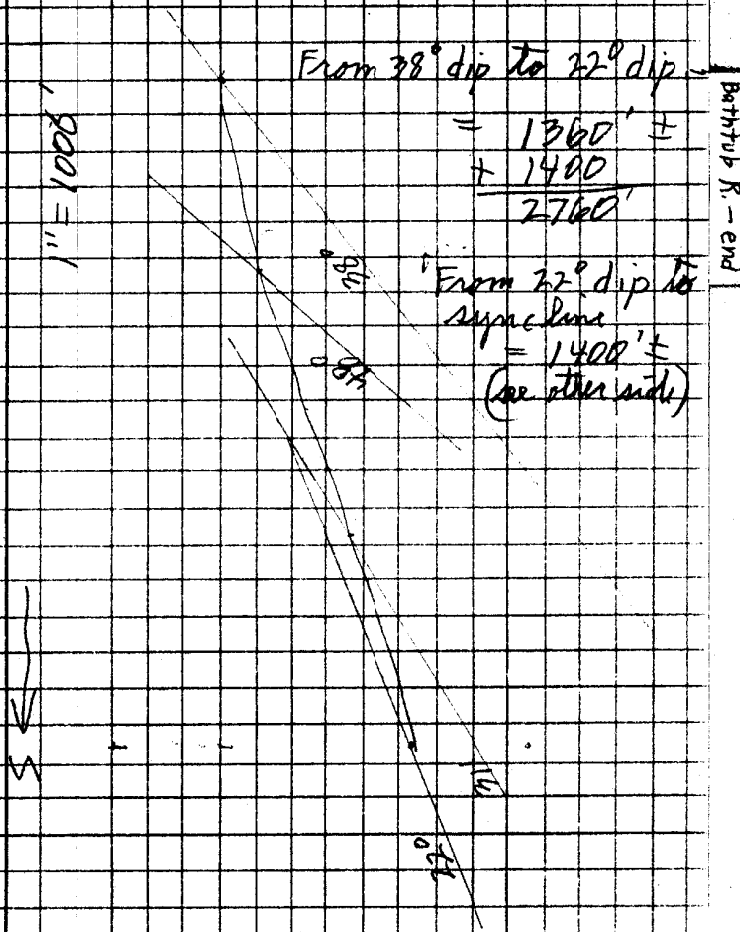

7/17/82 Molenaar & Krah

(82AMK-1) Schooka River area  
 NE/4 Sec 35-15-1BE  
 Sag. B-2 Quad

Area of somewhat slumped KpS  
 black sh, fissile, no pebbles seen.  
 Fairly flat to gently south dip  
 50 - 100' exposed  
 At S end of cr are hard 2-3"  
 ls interbeds. Sh as w/x w/  
 hematitic coating. Above ls  
 bed are v thin bedded Brookian  
 ss, f-v of w/carb streaks.

- L L 80AMK-1 of ls & ss
- B B 80AMK-1A of sh just above  
 ss interbeds. should be  
 Allison?
- In KpS (?) below BK is 250 cps

7/17/82

7/17

82AMK-2 Echooka River  
NW NE Sec 35-15-18E  
Sag B-2 Quad

Checking out locally w/ cgl in  
upper part of bluff, about 30  
thick, poorly sorted, sub-ang. clast  
up to 2', most 2"-5" w/ clasts  
of ss & sh argillite  
about shale clasts & matrix.

Cgl has sharp, irregular scouring  
contact into underlying sh.  
Poorly bedded, but some bedding trace  
basally flat w/ some 5-10' dipping  
and E dipping 10-15° accretion  
beds.

One 2-3' clay sh interbed w/ argillite  
or fracture white or orange clay  
sh. appears concordant w/ cgl.

82AMK-2A of interbed

Cgl has abrupt lateral contact  
w/ sh. 82AMK-2B from sh  
below cgl

Cgl is exposed as knobby protrusions  
on ribs on hillside.

7/17

82AMK-2 Cont

Interpretation: This appears to  
be a debris flow. Question  
is whether it's Holocene or  
Lower Cret.  
Sh interbed suggests that it  
is L. Cret. - a deep water  
channel?

82AMK-3 3/2 5/2 Sec 26-15-18E  
Sag B-2 Quad

SLP Sta along bluff of thin bedded  
sandstone & sh, generally dipping  
N 30-40° w/ some disturbed faulted  
areas.

ATP Turb up to 3' thick, mostly 3"-4"  
100'± exposed F-VI, graded, con  
sole marks - grooves, flutes  
trending N 50-80° E (3), abundant  
conch. plant frags on some bedding  
planes.

sh is siltst p. bedded  
82AMK-3  
Just downstream is several 100' of  
siltst dipping N.

7/17

82AMK-4 Echooka River  
NE SE Sec 25-1N-16E Sag B-2

shallow marine - nonmarine(?)  
sequence

82AMK-3 - more ls-broken etc

82AMK-4

Broken etc F-M ss w/ scat pbb  
com carb-wood frags at base of  
some beds - bluish

covered soft section

4" cgl

Reg. shoreface

82AMK-4 (D)

Interstratified small, curved  
gray mud-filled

129 = 25'

65'

Q14 - N 45E 65 NW G

7/17/82

82AMK-5

NE Sec 9-15-16E

Sag B-3 Quad

Soft section dipping steeply to S  
500' ± section mostly covered but  
several black carb sh-coal etc  
some friable F-M ss between

Coal  
Smp

82AMK-5 Coal sample

82AMK-6

SE Sec 9-15-16E

Sag B-3

On N side of hill S of last station  
Primarily up section from coaly  
sequence is orange w/ rubble of  
qtz - jasper pebbles cgl

82AMK-6

This seems to continue to N

Molenaar & Kirk

7/18/82

82 AMK-7 E 1/2 NE/4 Sec 19-25-12E  
Sag B-4

Measured Toolik Fluvial section on west bank. Plotted on section measuring forms.

Measured 835' of cyclic regressive sequences. All metric and lower shoreface, Upper Cret.

Molenaar & Kirk

7/18/82

82 AMK-8 C N/2 Sec 7-25-15E Sag B-3

Took measuring section for paleo content  
Photo 3 miles E of Sag Fluvial

350' Slat, dark gray, soft (WX) <sup>N75E 30S</sup>  
fine bedding

8A at base  
8B at 35'  
C at 95'

Slat as above but w/ hard beds  
1/2-2" thick, sandy

8D at 195'  
8E at 245'

Slat as above - soft  
8F at 270'  
8F at 350'

Above is 50-100' more. Section is somewhat folded and possibly faulted in upper half.

7/18/82

82AMK-9 C E/2 Sec 17-35-15E  
Sag A-3 Quad

Took  
Photo 100' ± Yellow-orange w/ sil bent - thick  
zone w/ thin zones of fossil black  
organic sh, hard, brittle  
also thin VF ss beds

9A E B SR  
9A E B Ⓞ

dip is about 50° to S

82AMK-10 SE/4 Sec 17-35-15E  
Sag A-3 Quad

Took  
Photo 6 mi east of Sag River  
100'-150' Interbedded ss & silty sh

Ss in silty graded beds (some) VF-LF  
mostly fine, sharp lenses, beds  
up to 2' thick in mostly thicken-  
ing upward cycles 5-10' thick,  
some load casts, groove striations,  
conv ripple marks on top, abundant  
carb on upper bedding planes

One 2' chert pebble cal  
± 10A Ⓞ 10A E B Ⓞ NW N80E 45S G

7/19/82

Molenaar & Kirk

82AMK-11 SW SW Sec 1-2N-12E  
Sag C-4

On east side of White Hills near Toolik  
River

Red chert bed horizon is obvious on  
west side of Toolik River. Found one  
spot that was not burned. At  
least 15' of coal is exposed - probably  
is much thicker

Coal  
Simpl

82AMK-11 Coal sample

Fairly flat lying

This is most likely Tertiary

Molenaar & Kirk

7/19/82

82 AMK-12 to 14 Sta 12 W 2 SW Sec 16-45-14E  
Sta 13 C 3/2 Sec 16-45-14E  
Sta 14 NW NE Sec 21-45-14E  
Sag. A-3 Quad

Examining Rispine River section

Entire section is deep water. So beds have sharp bases, abundant bottom marks, grooves, some flutes, mud scours, gravity structure; com small scale x beds and ripple beds (Bouma C), sli grading. LF-VF w/ minor scat M grains at base of some beds; com ripples and interference ripple marks at top of some beds. Some thick ss beds without structure, fractured - looks like facies B. Direction features (scours) N 15E, 30E, 55E, 70E

One 20-30' sh exposed at 1270' on section, bentonitic, slty.

⊕ 12 A & B

⊕ 12 Rolled over bottom mark on ammonite?

± 12 at 1780' on section

± 13 High in section (contained Inocer. preserv.)

± 14 very high in section

⊕ 14 " " " " Inocer. frag. and possible bivalve

7/19/82

82 AMK-15 C N 1/2 Sec 17-35-15E  
Sag. A-3 Quad


Downstream from Sta 9

Dip-slope exposure of turbidites and sh, about 25' strat ft.

Bottom marks E-W, N80E  
cut N80E 55S

up section is very bentonitic mud. One thin turb. ss + groove trend N70E

Farther up section on N side of side canyon is blk. sh-silt (from distance) w/ penecontemporaneous deformation

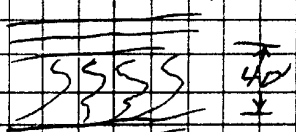


82 AMK-16 SWSW Sec 36-35-15E  
Sag. A-3

100' slty mudstone, well bedded w/ thin calc beds and a few very thin VF ss  
⊕ 16 A & 16 B

At top is a zone of 2"-6" thick ss beds (turky) sharp basal, load casts lam w/ calc layers. Att. N80W-20N  
etc show penecontemp slumping

This is prob slope deposit.

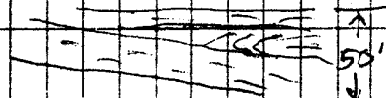

82 AMK-18 Cont

7/20/82  
p. 5

Samples 5R ~~to~~ 18R from  
30' below rusty sand  
BN 350 CP 360

82 AMK-19 SW NW Sec 36-4N-26E

MT. Michelson C-3

North side of Sadlerochit Mtns  
Location #04 of Lyle et al

Task 2 100-150' exposed of Paleocene prodelta  
pico tanks 5-7% + 8% in beds up to  
4' thick. Forams C, D (small scale X bed)  
Lamination at base are abundant - not  
relied on marks, but trends are  
N 75W, 65E, 85E E-W alt: N 65E 24N

82 AMK-20 SW SW Sec 29-3N-24E

MT Michelson C-4

On west bank Cannoning R. examining base  
of Lyle et al's section #13 pl. 8

Looked at basal 25' bottom marks in  
float. Could only see lower part of thick  
29' ss. Sharp basal contacts. Bottom  
marks (Bonds) 3' up. These are deep water  
pebbles and cobbles are reworked iron-  
stone cones  
L 20 of ss.


Mohrman, Kisko & Magoon

7/21/82

82 AMK-21 1/2 Sec 35-15-16 E  
to NW NE Sec 2-25-16 E  
diag B-2

Measuring section on west bank of  
Swishak River. Plotted on section  
measuring forms. Upper Cret.

Measure 2600 ft; 1900' below a  
fault and the remainder above.  
Diag. [?] indicates fault is down on  
south; thereby section is cut out and  
younger on the south. However,  
this is not certain. If it is up on  
the south, the 1900' of section would be  
further up section.

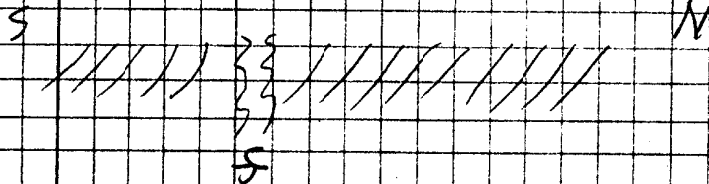



8015

7/21/82

Molnar, Kirk &amp; Magoon

82AMN-22 C 5/2 5/2 Sec 5-35-17E  
 Sag. A-2 Quad

Measuring section of turbidites on  
 east side of Washakie River.  
 Starting at sharp anticlinal fold  
 and going south  
 alt: N89E 45S

0-92 92' 80-90% ss in beds 1" to 8"  
 thick, graded UVF-LVF, some LLF,  
 com bottom marks, - grooves,  
 ropy texture, ss is hard, tight  
 to sample 22A at 25'  
 Grooves trend N10E, N15W  
 (2 observations), some wavy  
 ripples on top of beds  
 Thin sh-silt interbeds - mostly  
 < 1" one 6-12" at 35'  
 Ⓟ sample 22B

92-120 28' Sh & ss ss 25% in beds  
 1-2" thick, grooves → N10E  
 sh, rusty, waxy, silty, bent.  
 Ⓟ sample 22C

120-125 5' Covered

7/21/82

125-163 38' ss and sh 80-90% ss as  
 below

163-172 9' sh & ss 30% ss, 70% sh  
 Ⓟ sample 22D  
 Groove → N10E

172-180 16' ss & sh 60% - 40%  
 ss in beds up to 12" as de-  
 scribed, com ripple bedding at  
 top of beds (Bouma C)  
 alt N70E 54S

Ⓟ 22E

- 180  
 180-350 ss w/ < 10% thin ss beds  
 sh, rusty, waxy, dark gray

Ⓟ sample 22F at 26'  
 " " 22G at 58'

H  
 I  
 J  
 K  
 L

350-380 30' ss

380-416 6' sh Ⓟ 22M

386-436 50' ss 95% as below  
 Inoceramus 22N  
 Bottom mark → N60E

7/22/82  
Molenaar, Kirk & Magwon

82 AMK-23 SW SW  
SE SE Sec 10-25-17E  
Sag. B-2

Measuring section on lower Sulphur Creek  
Plotted on section-measuring forms

Measured 810' of UK shallow marine  
lower shoreface (neritic, very cyclic)

82 AMK-24 S/2 S/2 S/2 Sec 27-25-17E  
Sag. A-2

Checking flow in rain along Sulphur Cr.  
road south of section

ATP shall w/ a few 1-2' tubules  
ATT E-W 73N overturned.

groove → N70W

Section to south is dipping steeply to  
south and appears to be deep water.  
24' sample from fossil at 100' above tank

Section to north is dipping moderately  
to N and may be shallow water.  
There is probably a large fault  
in between

7/23/82  
Molenaar, Kirk & Magwon

82 AMK-25 Sec 10 to 3-15-14E  
Sag. B-3

Sagwon Bluffs - looking for oil-  
stagnant ss for about 1/2 mile oppo-  
site Sagwon. About 200' of fairly  
flat lying section exposed on bluff  
thick coal beds; clay and siltstone  
and a few thick fluvial ss

82 AMK-25A Coal sample from  
coal bed at least 18' thick

25B Coal sample from 12' coal  
bed 30' below 25A

25C Flora sample from lower  
part of section

25D Dark gray claystone from  
lowest part of section

25E Coal sample from base of  
exposed section

Found some fine grained, sh. pet. small  
ss in float. Oil, sd sample 25E

L. sample 82 AMK-25G - Clean friable  
fluvial ss - Kogonkrub fm?

7/23/82

82AMN-26 NE 5E Sec 32-1N-14E  
Along pipeline road on back  
of Saqwon Bluff Sag B-3

12'± thick fluvial ss exposed  
along gully. Lt gray, M w/ c & small pebbles, fining up-ward, though X bds w/ small scale X bds at top, friable, well sort

± 82AMN-26

This is stratigraphically higher than outcrops on bluff - pool is close to top at top of bluff. Fairly flat lying, still dip to west or SW.

7/23/82

82AMK-27 NE/4 Sec 9-9S-15E  
Philip Smith C-3

Walking through road E of Fortness  
Mtn. outcrops near Elusive Lake

Ridge exposures of fractured rocks

ss is in beds 1-4' thick, dark gray w/ greenish cast, very hard, & sorted in lower part of well graded sequence. Course w/ F-M some sandholes at base, fine grained at top, appears to be mostly Bouma A, some minor C, minor bottom marks.

± F sample 27 Very lithic, clay galls. Shale interbeds are mostly covered, but is very dark gray, percol fractures.  
Sample Geochem sample 27

82AMK-28 C Sec 9-9S-15E P.S. C-3

at base of ridge in gully below above station. Dark gray, very hard, sh w/ minor 1-2' thick turb ss. A couple hundred ft exposed

Sample Geochem sample 28

82AMK-29 NE Sec 76-85-15E P.S. C-3

Small sample (geochem) of Dalburne Group north of Elusive Lake  
Black, arg, fat

7/24/82  
Molenaar, Kirk & Magoon

(82AMK-30) SW SW Sec 16-2N-24E  
Mt. Michelon C-4

Otc along tributary on E side of  
Canning River

15' VF ss, w/ hard, blocky, in beds  
1 or 2' thick. At base is a sorted,  
dirty, silty zone 3' ± thick, con-  
sists of subang- rounded pebbles of  
shaly ls.

30 NW: NROW 15W

This is probably a local transgressive  
ss - Sag River ss

(82AMK-31) SW SW Sec 16-2N-24E  
Mt. Mich. C-4

Upstream a couple hundred ft and  
below (strat) str 30

15' exposure of shaly ls w/ calc  
and sil- list w/ monots, phosphate  
nodules, shark teeth?

31 sample 31

SR sample 31

(82AMK-32)

7/24/82  
SE/4 Sec 8-3N-25E  
Mt. Michelon C-4

Hot spring at west end of  
Saddlecreek mtn near saddle  
east of Red Hill.

Strong smell of H<sub>2</sub>S, springs are  
bubbling and have high gamma-ray  
count - 13000 CPS. Prob is  
radon gas.

Took sample of ooze and algal  
mat cover

82AMK-32

Gilead Syn. Sec.

Molenaar & Magoon

7/25/82

82AMK-33

Sec 28-35-1BE

Tag A-7 Quad

Levee syncline section

Measuring section in Levee Creek area.

Starting in shale below main ss package

Alt NBRE 30<sup>N</sup>

115' Silty claystone - mudstone, dark gray  
hard, non fissile, w/ hematite wat-  
ring in fractures. Fine 1/4" brecciated  
bed. Minor thin 1-4" w/ f. ss.  
course alt. interbeds (< 5 ft), sharp  
bottom contacts some bottom grooves,  
very old grading, minor scouring  
noted on ss into ss.  
GR core BK CPS 120-175  
2 1/2 SR samples 33A at 15'  
33B at 60' ±

Upper 1/4 of interval is partially  
covered & rubble etc.

200 Covered - probably is soft section  
inasmuch as it is continuous.

115-  
3/5

Common bottom marks in creek float  
from above

7/25/82 p. 2

315-  
415 100' ss greenish gray, very well indurated  
VF-F, no sequence, poorly bedded  
irregular scallopy bedding (or  
fracturing), some scouring,  
p. med sort, subang

This is prob Facies B turbidite  
Took 2 pics

415-  
432 17' Partially covered siltst-mudstone to  
LVF ss, platy

432-514  
E 82' ss greenish gray, hard, mostly  
UVF w/ LF & VF, med sort, some  
UVF (E 33 D at 15' E), no seq-  
uence, irreg. scallopy bedding  
(took pic) w/ good bedding planes  
every 3-6" in upper half  
ATT N80E 21' N

514-  
522 8' Interbedded thin bedded mudstone  
& ss in beds 3-8" thick, graded  
UVF w/ F → LVF, ripple beds at  
top of ss beds, bottom marks,  
grooves → N & N30E

SR & Ⓢ samples 33 E

7/25/82 p. 3

522-  
507 85' ss as described, mostly VF w/  
LF, com scallopy ripple bedding,  
minor silt partings

607-  
657 50' Partially covered silt mudstone,  
platy - some fossils  
Ⓢ 33 F & G at about 15' E 45'  
SR 33 G at 45'

657  
682 25' Covered

Ⓢ 5' sh-mudstone, dark gray, hard  
Ⓢ 33 H

682-87  
887-  
777 90' ss dark greenish gray, hard, in  
sli graded beds (UVF w/ F →  
LVF), 1-5' thick, separated  
by platy mudstone interbeds  
(10-20%) ATT N70E 28 S  
E 33 I of ss  
Com bottom marks → E-W, N70E

777-  
817 40' Covered

817-  
907 90' Broken etc. ss w/ mudstone inter-  
beds - prob 75% ss in beds up  
to 5' thick, sli graded UVF w/ F →  
LVF, bottom marks ATT N75E 26 N  
some channeling

7/25/82 p. 4

Mudstone, platy to p bedded in  
beds 1" - 2"  
Sr smpl 33 d

907-  
962 55' Ss 80% & Mudstone 20%  
Ss as below, mostly VF in sli  
graded beds 1-5" thick, minor  
bottom marks (no directions noted)  
Ols is rusty, w-x

at N70E 29N

Mudstone as below  
This is at drainage junction near  
middle of E boundary Sec 2B

962-  
1312 350' Mudstone w/ 15-20% (in lower 80')  
ripples bedded  
yellowish w/ silt interbeds 1-3"  
thick, sharp base - turbidites

SR & Ss 33K from near base  
SR & Ss 33L at 100'  
SR & Ss 33M 165'  
SR & Ss 33N 295'

2-1/4" lent beds at this point

Above basal 80' is all soft fissile  
mudstone, well exposed, quite w-x  
on bedding surfaces - may be cash  
but no patterns seen

7/25/82 p. 5

At upper end of sl section,  
strata and dip become erratic.  
Possibly faulting in here or soft  
sediment squeezing in syncline

Offset in section 3/4 mile to SW

Shale section we just measured as in  
large covered (vegetation) area below  
thick resistant hill-forming ss

175' Covered

1487

Starting at base of lowest ss etc  
in resistant hill-forming ss

at N50E 13-15 NW

1582 95' Ss, somewhat broken etc, but most  
seems to be continuous, greenish gray,  
hard lithic, mostly VF (UVF) w/ some  
minor LF, poorly bedded to massive  
irregularly bedded - scalloped  
bedding, fracturing, dish structures (?)  
Minor bottom marks in float  
This is facies B turbidites

1577 15' Covered slope-former some shale  
in float and thin bedded silt  
in upper part.

7/25/82 p 6

1647 45' Broken etc. ls, VF w/ minor  
alt. interbeds, com bottom marks  
→ N75W

Top of knole - Elevation here is  
450' above base of covered soft section  
below (presumably base of 300' as we  
measured up other fork of creek. Strike  
and dip at base and top of this inter-  
val averages N50E 15° NW for  
map scaling purposes

7/26/82 p 7

Mohanan, Kirk & Magoon  
Continuing sidelead syncline section

Starting on knole where we left off  
yesterday. Will use shoper elevation  
and map scaling method to plug in  
thickness of covered intervals and take  
staff method for some detailing of  
ledges. Using 15° dip

1864 222' Covered - float indicates shaly  
silty interval with some ss  
interbeds. ls is VF, bottom  
marks are common

1889 25' ls - somewhat broken, fractured  
etc. Below are some thick bedded  
ss blocks, but discontinuousness  
indicates they are probably slumped  
from above. This is first ss  
that has continuity.  
ls, greenish gray, hard, mostly VF w/  
some LF grains in shaly graded beds  
1-6" thick; Boulders of ls in silty  
interval at top, abundant bottom  
marks (ropy - gray) some → E-W  
ls is more calc, very little, musco-  
nite ± 33 ♂



7/26/82 p 8

1899 10' Covered slope - prob as shaley or thin bedded interval

1929 30' Broken etc ss as described, mostly dislocated blocks of irregularly, scallopy bedded

1959 30' Covered slope or flat - prob thin bedded or shaley

1977 18' ss (broken etc) as above w/ some UF-M E simpl 33P  
w/ irreg supple bedded, no grading sequence, bottom marks, groove  $\rightarrow$  N75E  
alt. N55E 17NW  
55

This is top of large resistant bench which is 120 ft (chopper altimeter) above bench below where we finished yesterday.

2224 247' Covered (calculated thickness) flat area to base of first ss in place on upper slope above. Prob is sh and thin bedded ss. One ss w/ pebbles noted in float

7/26/82 p 9

2262 38' ss greenish gray, hard, non calc, thick bedded, irreg poorly bedded, no other breaks, dish structures? VF-LF, Facies B

Below is large talus block covered and then flat area below

ATP Another large resistant bench  
Chopper elevation is 90 ft above bench below

2492 230' Covered flat as below

2502 10' Broken etc ss as described, top of hill and top of section. Chopper elevation above last ledge is 110 ft. Resistant ss is probably somewhat higher than 10', but is all visible. One piece w/ wood fragments, common marks.  
alt. strike is probably swinging toward N - maybe N35E?

Glend Syn Sec end

7/26/82

(82 AMK-34) NENE Sec 33-35-18E  
Sag. A-2 Quad

Downstream from base of island  
syncline section

150' ± exposed of dark gray-black sh  
non-fossiliferous, med calc, flint, con 4"-8"  
ls conca, limonite staining along  
fractures and platelets, sat etc grains

SR SR " " " " (going down section)

Att is approx N65E 32 NW but  
at S end of etc structure goes  
to hell

Sat sand to granule size grains found  
throughout section, but more common  
in upper part. This unit is probably  
paleol sh

Gamma-ray count is negligible  
BK 105 CPS 120 to 140

(82 AMK-35) NE Sec 33-35-18E Sag A-2

A few hundred yards downstream within  
etc of same sh w/ qtz grains

SR SR " " " " Gamma-ray count  
is negligible

Dip is to NW

7/16/82

(82 AMK-36) SW SE Sec 33-35-18E  
Sag A-2

Downstream from last station  
50' ± etc of black claystone, non fossiliferous  
w/ a few ironstone conca  
No fossils found

SR SR " " " " (going down section)  
This is probably Kungah sh

(82 AMK-37) SW SE Sec 33-35-18E  
Sag A-2

On west side of creek - 20' etc of  
same as sta 36

SR SR " " " " (going down section)

(82 AMK-38) SE SE Sec 6-35-18E  
Sag A-2

Along Island Cr. Side tributary gully  
exposes several 100 ft of Kungah sh,  
dark gray-black, clayey, minor ironstone  
conca, no significant GR count

SR SR " " " " (going down section)

Dipping 45° ± to S

7/16/82

(82 AMK-39)

Sec 27-25-17E

Sag. A-2

40' str of Sa in beds 1-5' thick,  
sharp base, con bottom marks,  
→ N65E, VF, some very slight  
grading. Prob UK tracks  
ATT E-W 20N

Below and little to S is 8' str of  
fossil sh, limonite on platelets

3 B 39 sample

7/27/82

Molenaar, Kirk & Maguire

(82 AMK-40) SW NW NW Sec 2-15-1W

Unit B-4

Collecting oil sample from old Unit  
well # 04. Bailed about 1/2 gallon  
of light-colored waxy crude by using  
5/8 oz fruit juice can weighted with  
a large nut borrowed from O. Smith.  
Borrowed a large bolt of torque from  
GSI. Oil level was 299' below  
casing head. Collecting rate after  
method was established was about  
3 1/2 oz per 3 minutes. This cal-  
culates out to be 0.31 BOPD

7/28/82

Molenaar, Kirk & Maggon

(82 AMK-41) SWSW Sec 16-115-12E  
Philip Smith B-4

at base of KFM clastics - stream gauge

Gradational contact from slty mudstone below to V/F ls - silt to more resistant V/F ss in 50' of section. Ls is greenish gray, med sorted, dirty, w/ minor silt pellets. Some thin mudstone breaks w/ con carb debris and horiz  $\delta$ , some interference ripples. Some larger wood frags up to 6" diam and 2' long.

Dip: N 80 E 60 N G

Found some cylindrical shaped (belemnites?) objects that may be a fossil - prob not, but sampled B 4H very calc.

(82 AMK-42) SE Sec 17-115-12E  
Philip Smith B-4

Walking through KFM section  
Cyclic units of Ls and Cgl

Cgl in units 10-40' thick, in thick

7/28/82 p2

flat bedded units 1-5' thick generally firming up pelitic to granule. Pellets mostly < 1" w/ some up to 2", dominantly chert dark gray to light gray some silicified ls, minor but conspicuous lt green chert, very rare quartz, sub ang to rounded, mudst t smpl 42A of cgl

Ls, in units up to 100' + thick, greenish gray, med brown silt, mostly LF w/ some V/F, some isolated pellets, flat bedded to low  $\delta$  trough  $\delta$  bits - esp just below cgl units. Con horizontal  $\delta$  noted in upper part of section, some carb. Most of Ls section is subbed.

Cgl units are at top of cycle. Cycle begins with Ls possibly slightly coarsening up (V/F  $\rightarrow$  LF). Base of cgl units is sharp - prob indicative of abrupt change in input - eg a river mouth bar or storm surge.

One carb sh coaly interval noted in general diagraphs in soft covered unit 150'  $\pm$  (Top) below top of Mill. Coal-carb sh smpl 42B

7/28/82 p 3a

Attitudes range from N80E 70N at base of section to N75E 50-55N above. Probably N75E 55N is good average.

82 AMK-43 N 1/2 Sec 17 to SE SW Sec 8-115-12E Philip Smith B-4

Continued Non ridge up section. More of the same ls & cgl. In upper part of section, there are a couple of thick cgl units with a few cherts up to 4"-8". No fossils found, no more burrows except for possibly some in uppermost part.

Attitudes or dips decrease to 40° and at end of section is 21-25° (N80E)


Up section (down slope) is a few rounded graye feet of covered ~~ls~~ as rubble chert to syncline axis.

Interpretation of sta 47 E 43  
Depositional environment is shallow marine w/ a minor amount of nonmarine as indicated by the coal. The cgl units are interpreted to be river mouth bars and/or storm surge deposits due to episodic outpouring of rivers into narrow coastal zone. A fan delta.

Sta 82AMK-42 & 43

7/28/82 p 3b

Calculation for thickness of Foothills Mbr. Exp. Sta 42 & 43  
Calculated from top of elevation and distance traverse, and attitude taken along traverse. Top: Philip Smith B-4  
Total thickness: 3550'  
Coal zone of 1300-1350' above base

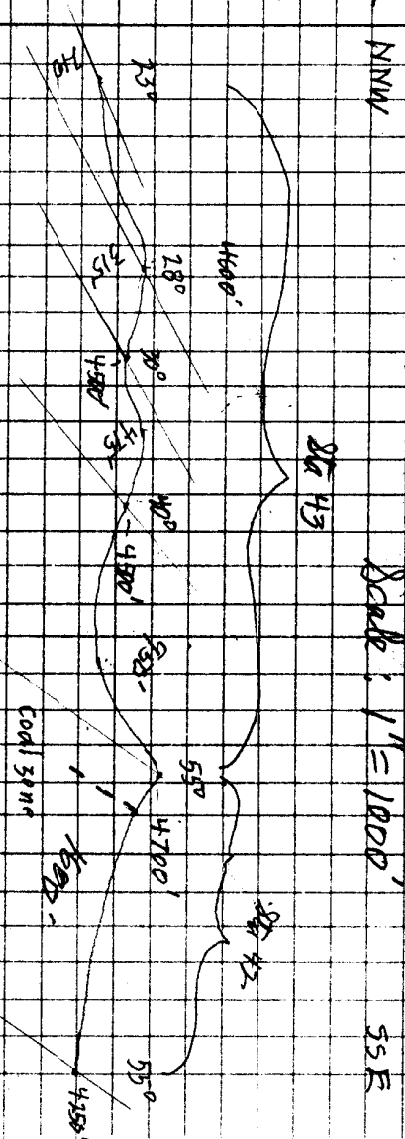

7/28/82 p 4

82AMK-44 NE/4 Sec 23-115-12E

Philip Smith B-4

Landed on small bank of sub-lite in  
Atigun gorge

At top is very fine black sh over-  
lying bedded gray ls 1-2' beds w/  
mollusks and calc sh

SR Impl 44A from ls-sh phosphate  
nodules section CPS 200 (phosphate 250)

SR 44B from fissile sh at top  
BK 100 CPS 300

Above section is disturbed. Float  
from above has blocks of oyster (?)  
local corals, some frags of inco-  
spanned shell (?) prisms (?). One small  
Medusa (?)

44C

82AMK-45 NW/4 Sec 26-SW/4 Sec 23-115-12E

Walked thru upper part (strat) of overturned  
Saddlerock top like fissile clay sh  
Bands of nodules in upper part (strat)  
This is mapped as PKs, but looks like  
Kingsh sh - 1000' ± of solid like sh  
SR 45A-C from lower part (strat)  
of like sh

7/28/82 p. 5

82AMK-46 NW/4 Sec 13-115-12E

Philip Smith Mtn B-4

Collecting samples and topo measuring  
of thick mudstone section below KFM.  
Starting at top - abrupt contact with  
thick coarse-grained KFM ss  
± Impl 46A ATN N75E 55 N G

Although this is an abrupt contact, sh  
section below is conforming upward in  
upper 200 ft from silty mudstone to  
silty to silty VF ss w/ scattered  
granules. Most of section below is  
non-fissile silty mudstone, dark gray,  
very hard, poorly bedded, scattered  
ls concretions up to 12" ±, mudstone  
is non calc. Base not exposed

± samples 46B to L through section  
going down hill and down section.  
Dip studies on dips throughout section  
are steep 50 to 60° although in lower  
part it was down to 30°

At bend in gully 450 to 500 ft topographic-  
cally below top (near sample 46H) are  
a couple ss intervals - slope channel  
ss. The upper one is about 25-30' thick  
and is conglomeratic at base and channels  
into somewhat contemporaneously

7/28/82 p. 6

slumped mudstone. Below a short distance (50' ±) is about 75-100' of ss, LF-VVF, platy, thin bedded, no grading or bottom marks, which also channels into mudstone or has scouring channels within it.

Map scaling data:

Elev diff between top and base	950'
Angle from base to top	25°
Horizontal distance across strike	1900'

Calculated thickness =

1900 to 2000'

7/29/82 p. 7

82 AMK-48) NWNW SE Sec 6-2N-26E  
Mt. Michelson C-4

Kingak Sh - overturned section  
About 115' exposed and covered  
silty mudstone, dark gray, non-  
fossiliferous. Found belemnites at  
2 horizons

③ 48 A at 15' ±  
48 B at 50' ±

SR 48 A B & C  
C is 15' from top

~~85°~~ Mt. at base Kenik Sa N85W 65N  
overturned

82 AMK-49) C 1/2 5/2 Sec 2-2N-30E  
Mt. Michelson C-2

On S side Sadlerochit River below  
Kingak Cliff  
50' ± etc of Sh, black, fissile, no/very  
a few ironstone concs. Found no fossils  
Kingak Sh.

SR 49

7/29/82 p.4

(82 AMK-50) C N $\frac{1}{2}$  N $\frac{1}{2}$  Sec 6-2N-31E  
Mt. Michelson C-2

Looking for Kps, JK contact below  
Kingak cliffs

Outcrop of shale along rounded  
sides of drainage - rubble etc

ATP (upper exposure) dark gray-bk  
fossiliferous shale, w/ pebbles up to 1"  
in float

SR sample 50 A & B

SR " " "

Found some sh w/ coarse grained  
grain. Sample 50 of pebbles for  
D. Blanchard. Also odd rosettes  
collected

(82 AMK-51) C N $\frac{1}{2}$  N $\frac{1}{2}$  N $\frac{1}{2}$  Sec 6-2N-31E  
Mt. Michelson C-2

More rubble - more rubble sh  
etc of fossiliferous sh

SR sample 51 A & B

B may be in Kingak, but found a  
couple pebbles in float?

A is most likely in JK

7/29/82

p.5

(82 AMK-52) C south line Sec 2-2N-30E  
Mt. Michelson C-2

Looking for pebble shale along bluffs  
above Saddle Rock River

Most of the shale is fissile block  
Kingak type. However, found a few  
pebbles and rosettes along and near  
the top of one or two rubble slopes

SR 52 from that interval where  
it is plotted on map

(82 AMK-53) SW SE Sec 3-2N-26E  
Mt. Michelson C-3

S side of Jurek Valley

SR samples from 53 A-D

(82 AMK-54) SW SE Sec 3-2N-26E  
Mt. Michelson C-3

S side of Jurek Valley

SR 54 from Kemik Sh  
Nondescript pelagospira



7/30/82 p.1

Malinsar Kirk E. Magoon

82AMK-55 C N $\frac{1}{2}$  N $\frac{1}{2}$  SW $\frac{1}{4}$  Sec 27-3N-25E  
Mt. Michelson C-4

Lanck Creek section plotted on section  
measuring forms 1" = 50'

Good section from Kemuk Is. thru  
Foliate shale and into UK lenticular  
shale (Shale Wall Mls).

Kemuk Is 62' + Base not exposed

Foliate Sh 290-313' First bent at 290'  
Major bent at 313'

UK Bent Sh 125' +

7/30/82 p.2

82AMK-56 NE NE Sec 27-3N-25E  
Mt. Michelson C-4

Outcrop of Shale-like Fm on S side of  
Sadlarokut Mtn  
SR sample 56A from fusile sh (blk)  
56B Big ls w/ monotis

Very petrolierous odor  
Dip N75W 25S

7/31/82 p1  
Molenaar, Kirk & Magaon

82 AMN-57 C N/2 Sec 16-55-14E  
Sag A-4

Measuring strat section on E bank of  
Sagawabok River 10 miles south of  
Happy Valley.

Measuring using Jacob staff method

Base of section - covered below  
at N 75 E 35 S

21' Ss, med gray, N4 or N5, hard, VF w/  
some silty VF, p bedded, load cast  
under ool bed, com carb frags &  
mud chips in silty ss, small pale  
X 2 d ripple lam (Barnes C) at top  
non calc. No grain size sequence  
Top 2' is contorted slightly w/water  
escape ment flowage features

32' 11' Ss, med gray, hard, UVF-LF, no  
grading, possibly slightly coarser  
upward, non calc, blocky, p bed  
to thick bed, minor carb, no  
bedding features, except rippled or  
load cast at base  
± ampl 57A from top

Sag R. Albion Turb Sec.

7/31/82 P. 2

- 41' 9' Silty mudstone, partly covered, mottled dark gray - brownish gray, ripple lam, some coarse debris  
 Ⓞ 57B SR 57B
- 49' 8' Interbedded ss & silty mudstone (80-20) ss VF in beds 8"-24", sharp asym base, ripple lam at top (Bourne c?) no good grading except at very top into mudstone. Silt mudstone in beds 1-3" thick partially covered  
 alt: N 80E 35 S
- 92' 33' Covered - prob mudstone w/ thin bedded ss
- 94' 12' Broken etc Interbedded mudstone and LVF ss (50-50) ss in beds 2"-3" Bourne b-c going into d in mudstone sharp base. Bottom marks in float  
 Ⓞ 57C near top. Minor bent.
- 124' 35' Interbedded ss & mudstone (75-25%) ss, VF, in beds 4"-10", sharp base Bourne b-c, com groove casts → N 50-60 E (several)  
 alt: N 70E 36 S

7/31/82 P. 3

- 209' 80' ss UVF-LF, thick bed, couldn't examine most of this because sharp deep river cut - had to climb up and around. Com bottom marks in lower part
- 217' 8' ss & Mudstone (50-50) w/ one 4' med in upper part, ss as described, beds 6'-2', graded LF-VF Bourne b-c & d, com coarse one layer of 2-3" concs in ss  
 alt: N 72E 36 S
- 224' 17' ss & mudstone 80-20 ss no beding in beds up to 4' thicker bedded upwards, ripple lam on top surfaces, com grove casts → N 55-65 east (3 readings) large grooves N 75W & E-W
- 289' 55' Partly covered thinly bedded VF ss & mudstone (50-50) in beds up to 10", minor bent. ss VF, ripple lam Bourne c  
 Ⓞ 57D at 38'

7/31/82 p 4

- 304 15' Broken etc sly mudstone  
~~304~~ ~~15'~~ ~~Broken etc sly mudstone~~  
 57F
- 40' Covered  
 344'
- 48' ss med gray VF thick bedded w/  
 some med bed 2' ± in lower part  
 hard, non calc, no good grading, but  
 sharp bases and some ripple lam on  
 top surface going into thin mudstone  
 too parting, com carb on top surf.  
 Bottom marks, grooves → N45E (1)  
 392
- One thin bent sh at 20'  
 E ~~392~~ E simpl 57F at about 20'
- 7' Covered soft section  
 391
- 419 20' ss as described, p bedded, fractured  
~~419~~ ~~20'~~ ~~ss as described, p bedded, fractured~~  
 minor thin silt partings, com carb  
 and sh chips on top surfaces
- 437 18' Covered soft section - prob interbed  
~~437~~ ~~18'~~ ~~Covered soft section - prob interbed~~  
 ss & sh

7/31/82 p 5

- 467 30' ss as at last 20'  
~~467~~ ~~30'~~ ~~ss as at last 20'~~
- 471 10' Covered soft section  
~~471~~ ~~10'~~ ~~Covered soft section~~
- 497 20' ss 90% in beds 1-3' w/ silt  
~~497~~ ~~20'~~ ~~ss 90% in beds 1-3' w/ silt~~  
 partings, VF, some M grains at base  
 of beds, some ripple lam at top  
 of beds, com carb on tops,  
 fractured, p bedded  
 Ditt N65E 365
- 532 35' Covered soft section - sly mudst  
~~532~~ ~~35'~~ ~~Covered soft section - sly mudst~~  
 float, dug out ~~532~~ simpl 57G  
 at 12'
- 558 21' ss LF w/ M-C grains scattered,  
~~558~~ ~~21'~~ ~~ss LF w/ M-C grains scattered,~~  
 med gray, hard, p bedded w/  
 some minor scouring, fractured  
 minor small grading, no silt  
 interbeds. Is this a facies B  
 unit? com carb and sh chips
- E E 57 H
- 563 10' Partially covered ss as below  
~~563~~ ~~10'~~ ~~Partially covered ss as below~~

7/31/82 p.6

588 25' Covered  
~~478~~  
 578 10' Partially covered mudstone  
~~8~~ B 57 I  
~~488~~  
 603 5' ss w/ flute casts at bottom  
~~489~~

82 AMK-5B C E/2 Sec 16-55-14E  
 Sag. A-4

Next etc upstream from section; 40' ±  
 exposed. Thinly lam & ripple lam silt  
 and VF ss, sh grading LF → VF in one  
 14" bed

Dips are slightly contorted but most  
 are about N55E 37 SW

Sag. R, Sec. end 1

7/31/82 p.7

82 AMK-59 SW Sec 34-25-14E  
 Sag. A-3

etc on E side of Sag. River  
 About 75' of shallow marine VF graded  
 sandstone w/ 2 5-10' silt mudstone beds  
 ss, lt gray, flat bed, com 10, various  
 kinds shalthis, diplocraterium

Scattered pelecypoda, some large brachiopods  
 B 59 I  
 G 59 ATT: N78E 13 N

82 AMK-60 C N/2 Sec 35-15-14E  
 Sag. B-3

E side Sag. River  
 50' ± non-marine fluvial ss w/ some  
 interbeds of silt mudstone  
 ss M conglomeratic, X bed, friable  
 ± simpl 60, scouring base

BK 80 CPS 100  
 Silt. mudstone in beds 5' ± thick, dark  
 ss gray-brown, very carb, nonfissile  
 SR B (pollen) & SR (pit) simpl 60  
 BK 80 CPS 160

92 AMK-61 NW SW Sec 29-25-15E Sag. A-3

About 10-15' exposed shallow marine  
 ss w/ abundant HCS com 10, fossils  
 (clams) ATT: Fairly flat

8/2/82 p.1  
Molenaar, Kirk & Magoon

82AMK-62 C Sec 5-2N-19E Sag C-1

Measured section on N flank of Shinarump anticline. Used 100' tape and Brunton compass.  
Measured 7415' starting in shallow marine silt, going through poorly exposed or developed shoreface, to non-marine coal and fluvial channel conglomeratic ss.

82AMK-63 NW/4 Sec 32-SW Sec 29-3N-18E  
Sag C-2

Measuring thick coal beds above fluvial ss section we looked at in 1980  
= POACH - This is Tertiary

Jacking up section:  
42' coal? low rank } broken etc  
40' sand and clay, ventonitic }  
29' coal }  
16' sand and clay }  
60' clay and sand }  
50' coal }  
covered above

Rb = 0.27 (M. B. 1982)

8/3/82 p.1  
Molenaar, Kirk & Magoon

82AMK-64 SE SW Sec 10-25-17E Sag B-2

Collecting silt, mudstone, hard non-fossiliferous samples below lower Sealed Creek section about 300-400' of section collected

SR SR samples 64A-E alt N75E 50N  
SR SR ' 64A, B & E

82AMK-65 NW NE Sec 34-25-17E  
Sag A-2

Sealed Creek - about 50' of lenticular ss w/ a few individual lenticles (1") overlying 40' of fractured VF ss med bedded, p bedded, no grading, no bottom marks. Facies B Turb? alt: N70E 70 S

SR SR samples 65  
This is probably UK on basis of lent.

8/3/82 P. 2

(82AMK-66) NESE Sec 14-35-18E Sag A2

Looking for fossil along open knoll or ridge  
in Niangua sh

Found *Vedemontes* lower down

⊗ 66A

Found ammonite frag higher up

⊗ 66B no attitude available;  
all rubble & float.

(82AMK-67) NWNW Sec 24-35-18E Sag A-2

Resistant bed 5'+ thick that angles down  
hill. siltst, c, gray, p bedded mon-  
tons rounded to angular pebbles of  
phosphate?, some fossil frags -  
one gastropod, some pelecypods

⊗ simpl 67

Dipping 5-10° to SW

This looks like Triassic - shaly or  
Karen Cr. Float down section is not  
shaly - p bedded siltst

Float above is shaly calc sh -  
w/ monotis

8/3/82 12 B

(82AMK-68) C SW Sec 26-15-18E Sag B-2  
Edwards River & downstream from  
KPS

200' sh w/ thin bedded siltst (80-20  
sh is dark gray, fossil to mon-fossil,  
non bent but feels somewhat  
gummy in upper part. No bent seen

Turks are coarse siltst, hard, 1-4"  
thick, sharp base, found b & c  
sequence. Monotis → N40E W

AT N80E 50N

⊗ ⊗ simpl 68A & B

(82AMK-69) SESE Sec 19-15-21E  
Sag B-1

Along upper Kemick Creek to sample for  
SR SR 69A & B AT N75E 25N

Going upward in section is folk, non-  
calc sh to sh calc sh, siltst and  
at the top is lot w/ abundant mon-  
otis. Higher still in float is fossilif-  
erous calc sh.

A is from lower sh; B from ls.

8/3/82 p. 4

82 AMK-70 SE SW NW Sec 35 - 1N - 20E Sag B-1

First etc up side drainage of Kemite Cr  
40' E 2N, dark gray, clayed, and friable  
no alt. one thin bentonite noted  
~~Kingak Sh~~  
Found a Buchia  
3 70

82 AMK-71 C 1/2 Sec 6 - 1N - 23E  
Kingak R. Mt. Michelson B-5

UK bent sh - mudstone outcrop, im-  
mediately S of yellow m. & bent  
part of section. ATP is contains  
floating pebbles up to 2". This  
must be Campanian-Maestrichtian?  
part of section with pebbles at  
Logan Valley

8 71  
E 70 of pebbles  
Structure is very contorted

82 AMK-72 SE SE Sec 24 - 2N - 22E  
Mt. Michelson C-5

82m mudstone w/ thin 1" ± VF ss inter.  
beds (15%) shall?  
8 72 Dipping very gentle to N

Molenaar, Kurb, and Magoon

8/4/82 p. 1

82 AMK-73 NWN NW Sec 14 - SW SW Sec 11  
2N - 28E Mt. Michelson C-2 & C-3

Fire Creek area. Sampling Fire Creek  
altat Member, Shublik and lower part  
of Kingak Sh

SR sampl 73 A & B Fire Creek Mbr  
" " C-L Shublik  
" " M-D Kingak Sh

82 AMK-74 SW SW Sec 8 - 2N - 32E  
Mt. Michelson C-1

Imbricate etc on Hula Hula River  
50' - 50' ss & bent sh. ss dark med  
grey. VF Bouma b, c, & d, bottom marks  
100' ± exposed  
OUT N 75E 30S

82 AMK-75 SW Sec 11 - 2N - 30E  
Mt. Michelson C-2

Top of small bench at west end of  
Kingak Cliff - Rulibke etc of  
VF altat thin bedded turbid and  
bent sh (cont)



8/4/82 p. 2

(82 AMK-76) SE Sec 10-2N-30E  
Mt. Michelson C-2

River cut along Kekohitu River - S end

Dark gray - blk sandy sh, fissile w/  
floating F-M grains and thin  
anticlinal 1" - 2" beds of M-C ss,  
very hard, non calc.

Att N30E 30S

E. simpl 76  
SR & SR 76

(82 AMK-77) NE SE Sec 10-2N-30E  
Mt. Michelson C-2

200' down section from sta 76 at N end  
of etc. Sh, dk gray - blk, fissile w/  
minor iron stone conca - some being  
replaced in center by etc. → pyrite  
One rounded coarse sand grain found  
in sh, some limonite stained zones  
Found some "rosettes" in sh up to 1"

E. simpl 77 of conca  
SR simpl 77 A & B  
SR simpl 77A

This etc is prop. prob. pebble sh

8/4/82 p. 3

(82 AMK-78) C Sec 8-2N-24E  
Mt. Michelson C-4

On west bank of Canning River  
15-25' exposed fairly flat lying, gentle  
west (?) dip. Exposure is for 300' + a  
along shoreline

2 pics

2" - 3" gray, blk mix, F w/ m to strings  
of 1/4" pebbles in graded beds 4" to  
7". Bedding a, b and minor, ripple  
marks at top of some beds. No shaly  
interbeds, minor scouring, p bedded  
in part, abundant carb and wood  
trunk on top surfaces, common clay  
galls, minor bottom marks (load casts),  
Redioleiferous (?) odor on fresh break  
Some very faint cut? and cut  
fluorescence (late)

E. simpl 78

Interpretation: These are turbidite

8/5/82 p1  
Moleman, Kink & Magson

82 AMK-79 SE Sec 1-1N-23E Mt Mich-B-4  
= 80 AMK-20

EW 1320

On west hillside west of Canning River  
well above Kemik sandstone in  
west plunging syncline

400' silty mudstone, dark gray, hard,  
non fissile, & bedded to platy, minor  
thin (1"±) graded silt beds, or  
minor lamination & coarse, mostly no  
bottom marks, minor ripple lam  
(very small scale), small 1/4-3/8" and  
shells w/ hemite staining - pyrite cement?  
One thin belemnite < 3/4" and  
large calc conc. about 1/2 way  
up. No other belemnite seen in  
well exposed section. A few  
small nondescript pelecypods  
found @ 79

@ B sample A-D through section  
@ SR " A & C

Att: N 10-50W - 3B SW

This section may be distal Toroh bottomite

8/5/82 p2

82 AMK-80 SE NE Sec 34-1N-23E  
Mt Michelson B-5

Revisit to 80 AMK-10 - Kinkah - Kemik -  
Kps - Brookman trials to collect fossils in  
Kinkah sh

@ 80A - about 150'± above base in  
float but probably ~~did not~~ came from  
shale bank - 1 Buchia

@ 80B - about same location as collection  
in '82. Many Buchias in shale -  
very fragile. In same zone are  
many "rosettes". Just above is a  
zone of 2-4" round cannonball concs,  
calcareous.  
Blair, collected a Belemnite

In same zone, found 2 chert pebbles,  
1/4" and 1", subround and 1-7"  
silicified petal grainstone (Lisburne?)  
± subangular but definitely in place  
# 80B

8/5/82 p. 3

(82 AMK-81) C W/2 Sec 34-1N-22E  
Mt. Michelson B-5

Shale etc along small creek east of Juniper  
Creek.

Shale dark gray, subshaly w/ scattered  
ironstone concretions. Found a few *Burchia*

③ 81

Estimated alt. N50E 35 ~~SE~~

Molenaar & Kirk

8/6/82

(82 AMK-82) NW/4 Sec 16-2 NW/4 5-2N-26E  
= 80AMK434 Mt. Mich. C-4

Revisit to Tertiary (?) at top of Squack  
Valley section for photographs.

Took 8 samples 82A-E

(82 AMK-83) NW Sec 16-2N-18E  
Sag. C-2

Measured section on lower Shawanuk  
River. Plotted on forms  
Jacobs staff - Brantton.

Measured 595 ft.

July 20, 1983

CMM, ARK, LBM

83 AMK-1 SW 1/4 Sec 25N-26E Mt Mich. D-3

E side of Tam. River, small otc along bank. 5' ± exposed  
Ss, gray, fine grain w/ sort, flat bed, com. horiz. burrows, beds 6"-12" thick, hard well indurated lower 2' overlain by w/ soft well sort LF w/ thin streaks black grains - (detrital coal).

Att N65E 24N

± 83 AMK-1

To south north 200' is small otc of soft silty sh, brownish, non fossil.

83 AMK-1

Interpretation:

These sands - ss are shallow marine.

Mt Mich C-5

83 AMK-2 1/2 1/2 1/2 Sec 34-4N-22E

Hilltop a few miles E of Hank airstrip Large blocks of med grained ss on side of crest of hill - prob. not too far out of place since they are all similar - prob. fluvial. Brown oil stained on fresh exposure.

Dil ss smple 83 AMK-2 gives good cut.

CMM, ARK, LBM

7/20/83 #2

83 AMK-3 SE SW Sec 33-4N-24E

Mt Mich. E-4

Along W. bank of Canning River long riverbank exposure - about 6' strat fit exposed

photo #13 Ss, lt brown, med-lt gray, LF-UVF, well sort, slaty, w/ m flat beds 1-3" thick, flat bed w/ some low angle swaley - hummocky? bedding, some woody frags at base, some vert. burrows (2/3 cm) shallow marine

Att N70E 23N (F)

± and oil? ss samples 83 AMK-3

83 AMK-4 SWSW Sec 10-4N-24E

Mt Mich C-4

On bluff on E side of Canning River siltst, med gray to black, soft coarse, about 20 ft exposed dipping away from glacial-covered hill. Com large 3-8' concs, separated by soft siltst, some small siltst concs.

Some of soft siltst is black - carb? 83 samples 83 AMK 4A & B

Att N45E 12 NW (F)

7/20/83 P.3

83 AMK-5 SW/4 Sec 26-5N-27E

Mt. Mich. D-3

On east bank of Kat River  
25 ± ft exposed ss & sand (20-80%)  
Hard ss ledges 1-3 ft thick, VF,  
med gray, calc, sharp base w/  
well developed groove lineations trend-  
ing E-W, some load casts, some  
horizontal burrows on base of beds,  
mostly flat bed w/ some small scale.  
In between hard ss beds are softer  
sands, VF w/ common thin carb  
streaks.

Dip is 5 or 6° to south

± 83 AMK-5

Vit. sample 83 AMK-5

This is prob nonmarine marginal  
~~marine~~

CMM, ARK, LDM

7/21/83

83 AMK-6 C E/2 E/2 Sec 33-7N-39E

Demarcation PT D-3

Angular PT oil saturated sand  
Q blow and beach sand agglutinated  
by oil making sand very firm or  
hard. Very petroliferous on fresh break.  
Oil sand sample 83 AMK-6

83 AMK-7 NWNE Sec 4-6N-37E

Demarcation PT Quad D-4

Long muddy, etc(?) on E side Niangua R.  
above snowbank.  
Droopy bent sh and bent badly wx,  
slumped, no attitude, prob contorted  
B & SR samples 83 AMK-7

83 AMK-8 SW NW Sec 9-6N-37E

Demarcation PT D-4

280' of black fissile or paper shale and  
lentonite exposed in tight anticline  
with 80° ± dipping flanks. This prob  
Turonian-Coniacian - same as Jago R.  
Geochem sample 8A-G mostly going  
down section. B samples 8A, C, E, F, G  
Sample F (B) was from 10 ft thick, brownish  
zone w/ abundant inoceramus frag.  
Gamma Ray background = 50. Sample  
holes = 150 ±; G was 240

7/22/83

P.1

83 AMK-9 Near center Sec 30-2N-38E

Demarcation PT C-4 &amp; B-4

In small saddle 2 1/2 mi E of Aichilik R.  
near Sadlerochit / Lisburne contact  
Sample Sadlerochit (& Lisburne)

Upper Lisburne has a lot of oolitic ls and  
fine grain med gray ls.  
Geochem sample 9A

Alt E-W 46 N

Overlying Echooka is very fossiliferous  
calc to VF argose ss and ls, com brach-  
iopods, some corals, some pyrite cubes  
± smpl B & D, from Echooka which  
is about 200' thick - mostly rubble

Overlying Kavik is in saddle and about  
300' thick - mostly covered.

Dug out some hard dark gray sh  
Geochem samples C, E, & F

Above is mostly all talus of Ivishak  
to top of hill to south - about 400'  
± samples from base of talus

G (ss) and H (chert &amp; mudstone pebbles cgl)

± sample I of fine grain wht ss from  
rubble near top of hill (top of Ivishak?)

7/22/83

P.2

83 AMK-10 SESE Sec 29-2N-38E

Demarc PT B-4

Low hills of Kakah Sh near valley  
bottom with 100' of good ocs along  
E side of hill along creek

Sh black, hard platy to fissile  
Samples 10 A, B, & C south to north  
and smpl D about 300' farther  
up creek. All samples for Geochem

Alt N45E 45-60 SE  
overturned?

83 AMK-11 SESE Sec 16-2N-37E

Demarc PT C-4

photo

35

Shubik section on W bank of Aichilik R.  
Well exposed - about 300-400' thick  
Geochem samples 11 A-E (5 samples)

Alt N70E 60-70 N

83 AMK-12 same loc as sta 11

Karen Cr. ls - dark gray very  
hard siltst  
± sample 12

7/22/83 P. 3

83 AMK-13 C 1/2 Sec 16-2N-37E

Demarc. Pt. C-4

W side of Achilik River sampling  
Kingsak sh along long bluff

Samples 13 A, B, C, D, E in lower part -  
first good ota prob several hundred  
feet above base

sh is hard, black, small pencil frac-  
turing

Att N 50 E 60 N

all are geochem samples in lower 1000'  
of section

83 AMK-14 ~~C SW 1/4~~ Sec 16-2N-37E

SW NW  
13 F & G Demarc Pt. C-4

Down river up section from sta 13  
and down section from 80 AMK-56

Kingsak  
Geochem samples 14 A & B  
Dip 10° ± to N

83 AMK-15 SE SE SE Sec 8-2N-37E

Down river from 80 AMK-56  
Geochem samples 15 A & B (Kingsak sh)  
Since sta 14, section flattens out, then  
is contorted

7/22/83 P. 4

83 AMK-16 NE 1/4 Sec 17-2N-36E

Demarcation Pt. E-4

Rubble covered hilltop with one 2-4"  
thick fractured ss etc mostly all very fine  
w/ minor VF-LM. Bedding is flat to  
wavy, some small scale X beds → S or SE.  
A couple groove casts in float. This is  
prob deep water but no good turbidite  
features

photo  
#4

Att N-S dipping gently W

This etc is mapped as Manushuk  
on Reiser's et al map.

83 AMK-17 W 1/2 NE 1/4 Sec 8-2N-36E

Demarcation Pt. E-4

Long etc on E bank of creek  
Upper crest bent sh w/ 20% 1-4" w fine  
grained ss turbidites, com bottom  
marks in float. Sh has com iron  
oxide staining. Prob 500' exposed

Att N 80 E 45 S

Geo and geochem samples A, B, & C

83 AMK-18 C W 1/2 Sec 4-2N-36E

Demarc. Pt. E-4

About 300' exposed sh, dark gray, p wd,  
rusty zones of w/ some conc layers, non-  
bent, micromica LH sh? Kps?

photo  
#5

Geo samples A-D; geochem samples A-C

Att E-W 50-60 S

7/22/83 P5

83 AMK-19 Sec 8-3N-35E to Sec 23-4N-35E  
Demarcation Pt. C-5

Plotted on aerial photo # 7599  
Collecting sandstone samples throughout  
Sablatz Creek section for thin section-  
ing and diagenesis studies.  
± Sample 19 A-M 13 samples  
A at base; M at top.

7/23/83 P1

83 AMK-20 NE/4 Sec 4-6N-35E  
Demarcation Pt. D-4

Revisit to sta 80AMK-70 UK bent  
sh on Jago River

Photos  
7-17

Collected geochem smpls 20A-F  
± smpls 20F - near top of exposure  
Inoc fragg smpl 20  
Bentonite smpl 20

Att E-W 50° ± S

Gamma-ray readings, with a back ground  
of about 100, are 150 to 250.

See photo # 7847 for detailed locations

83 AMK-21 NWSW Sec 34-7N-35E  
Demarcation Pt. D-4

West bluff of Jago River

Walked N from sta 20 looking for  
Tailleur's "pebble sh". Found soft w/xy  
bent mudstone, non fissile, very soft,  
w/ orange w/xy flat cones, non Ca CO<sub>3</sub>,  
doesn't flint, except slightly when  
scratched (dolomite?), scattered chert  
(blk & wht) pebble w/xy out, mica thin  
bentonite. This continues all the way  
to pt about 1/2 mile NNE to  
sta 80AMK-71. Petrofiferous odor  
throughout

± smpls 21A, B, & C going down river  
Geochem 21C  
± smpl 21 of conc



7/23/83 p. 2

83 AMK-22 C W/2 Sec 34-TN-35E

Demarcation PT D-4

Continuation of sta 21 down river to point on ledge at sta 80 AMK-71

⊗ samples 22 A & B  
Geochem " 22A

83 AMK-23 SW SE Sec 3-6N-36E

Demarcation PT D-4

Revisit to 80 AMK-69, trib. of Nequanah River - Jurassic etc.

Too much snow filling gullies  
Collected ⊗ and Geochem sample from LK(?) sh (pebble sh?) on N side of gully from where we got Jurassic fossils. Rare chert pebbles in float

Geochem simpl 23  
⊗ " 23

83 AMK-24 SW SW Sec 1-6N-36E

Demarcation PT D-4

checking gullies where USGS map shows Jurassic. Too much snow in gullies. Found UK bent sh to N and to S. One blk sh up gully to SSE

⊗ simpl 24

7/23/82 p. 3

83

83 AMK-25 SW/4 Sec 27-TN-30E

Mt Michelson D-2

Subdued hills at E end Marsh Cr. Ant. dug out brown bentonitic mudstone for sample.

⊗ simpl 25

Att. Dipping 35° to N (if it isn't slumped)

83 AMK-26 SW/4 Sec 18-9N-34E

Barter Island A-5

North shore of Barter Island  
3'± exposure of blue-gray soft sticky clay. Pleistocene?

⊗ simpl 26

7/24/83 p. 4

83 AMK-31 SW/4 Sec 15-35-39E

Demarcation Pt. A-3  
~~South of Bath~~ North of Bathurst Ridge on  
small tributary to Leffingwell Fork  
of Archuleta River.  
Sampling Kayak sh for geochem

Geochem samples 31A, B, & C A at top

Kayak sh is about 150-200' thick here

7/24/83 p. 5

83 AMK-32 Sec 5 to Sec B-2N-36E  
Demarcation Pt. C-4

- Measuring (map scaling) quick section
- 32A N55W 26S interbedded limestone shale  
w/ turbidites (Bouma B-C facies). Approx  
50' exposed on creek bank. Sect 40% turb +  
60% turbite shale. Paleo + geochem. mpls 32A  
at N55W 26S  
C E line Sec 5-2N-36E (500'± above Kps)
- 32B SWSE Sec 5-2N-36E  
E-W, 25 S S/ Lith as last stop  
paleo + geochem mpls. Bottom marks  
turbidite E-W, 25 S S. 50 ft exposed.  
Geochem & paleo sample (1800' above Kps)
- 32C NWNE Sec 8-2N-36E  
E-W, 25 S S/ Lith as first sta  
but 20% turb + 80% shale.  
Small fault at base. paleo + geochem mpls.  
Geochem and paleo sample (2500' above Kps)
- 32D W/2 E/2 Sec 8-2N-36E  
N70W, 50 S S/ Lith but thinner bed  
w/ 10% silt turb. paleo + geochem mpls.  
Geochem & paleo sample (3700' above Kps)  
estimate ↗

CMM, ARK, LBM

7/25  
7/25/83 p.1

83 AMK-33 SW NE Sec 24-6N-27E  
MT Michelson D-3

Bluff on NW side of Kat. River  
Altogether 75' exposed  
sh-clay-mudstone, soft, lenticular,  
med gray, com floating chert pebbles

Att. N 70 E 30 N (F)  
B & Geochem sample 33A & B

83 AMK-34 NE/4 Sec 34-6N-27E  
MT Michelson D-3

W bank Kat River 100± exposed  
Silty sh-mudstone, med gray, soft, com  
small chert pebbles & granules  
B & Geochem sample 34

Photo  
Att N 70 E 50 S (F) but 50' to N  
is rollover to flat and gentle N  
dip. This is prob. axis of Marsh  
Creek anticline

83 AMK-35 NE Sec 14-5N-27E  
MT Michelson D-3

Bluff on E side Kat River  
25' exposed in N gully silty sh-mudstone  
soft, as above, pebbles in float  
B & Geochem sample 35 Att N 85 E 30 N  
May be slumped - Found different atts in

7/25  
7/24/83 p.2

83 AMK-35 (Cont)  
other gullies to S

83 AMK-36 NW Sec 11-5N-26E  
MT Michelson D-3

W side Tam. River  
Possible o/c of conc bed w/ out of sh  
Att N 80 E 45 S ?

83 AMK-37 N $\frac{1}{2}$ N $\frac{1}{2}$  NE/4 Sec 27-4N-28E  
MT Michelson C-3

= 80 AMK-50  
Pebble shale etc  
Geochem & B sample 37A

83 AMK-38 SESW Sec 23-4N-28E  
MT Michelson C-2

Quick stop to collect Geochem sample  
from pebble sh. Sample 38A-D

83 AMK-39 SE Sec 19-4N-30E  
MT Michelson C-2

E fork Marsh Cr. sampling PRs - Kps  
From Geochem sample 39A Lisburn  
E sample 39B Echooka ls

7/25/83 p.3

83 AMK-39 Cont

Geochem spls 39 C, D, E Karvik Sh.  
L. samples 39 F, G, H, I Swishak Ss

Geochem spls 39 J, K, L Pebble Sh

83 AMK-40 SE SW Sec 18-4N-30E  
Mt. Michelson C-2

E. Ford Marsh Cr. } see next  
Sampling Kemik Ss } page  
L. Sample 40 A, B, C, D, E, F

83 AMK-41 W/2-W/2 Sec 31-4N-31E  
Mt. Michelson C-1

Outcrop on E bank of Sadlerochit River  
E. end of Sadlerochit Mtns.  
At S end of etc is about 40' of Ss, dark  
gray, L.V.F., very hard, at base mon calc,  
bedding beds, 1-3' thick, abundant dark  
burrows. Is this Karen Cr. - Sag R?  
E 41 S 7 41

Coming N is disturbed faulted zone and  
then about 25' of L.V.F.-C siltst, minor  
or rare chert pebbles (Kemik Ss) grading up  
to pebble sh.  
Geochem and sample 41

7/25  
7/24/83 p.4

83 AMK-40 Kemik Sandstone @ March Creek section  
SE SW Sec 18-4N-30E Mt. Michelson C-2  
45' of Sandstone, upper 15' is remnant  
section along thrust fault  
N 25° E  
30° S

40A very thin bedded (1-2cm) dark gray  
silty sandstone at base with  
horizontal and vertical burrows  
thin pebble lag in lower most beds, whole  
unit about 2-3 ft thick.

40B overlying sandstone is 8-10' thick  
with medium beds at upper very fine  
grained - fine grained well sorted  
light gray sandstone

40C 12' above the base is 6-8" thick  
chert pebble conglomerate with  
chert pebbles > 3" in diam

40D overlying conglomerate is 10' thick sandstone  
with hematite stained zone 6-12" thick  
at the top, sandstone is upper very  
fine to fine grained and well sorted  
med scale trough x-beds near the top  
below Fox stained zone, sandstone  
& Fox zone overlain by 6-12" thick  
pebble conglomerate black & white chert

7/25/83 p.5

(40E) 10' above second conglomerate.  
med scale trough x-bedded sandstone  
fine to very fine grained, silty matrix  
and light gray in color, horizontal  
and vert. burrows

(40F) sample 2' below top of Keme sandstone

CMM, ARK, LBM 7/26/83 p.1

(83 AMK-42) NE/4 Sec 11-3N-31E ?  
Mt. Michelson B-1 C-1,  
Last Creek area. Collecting samples  
Keme sh. on Shublik, sharp contact but  
no pebble zone although on close inspection  
there are rare small chert and qtz pebbles  
in lower 3 ft.  
Keme is about 25' thick, LVF dark gray  
hard. At base of pebble sh. are scat-  
tered pebbles and then scattered pebbles  
throughout. About 100 ft Kps exposed.  
Near top is a siltst.  
Geochem samples 42A-E in upper 200'±  
of Shublik.  
Geochem sample 42F, G, H, I in 100'± Kps  
± sample 42J from PKs (top)

(83 AMK-43) SW SW Sec 28-3N-32E  
Mt. Michelson C-1  
On W. side of Nulakula River  
50' exposed in side gully.  
Hard dark gray sh., p. bedded, fractured  
blocky, no bentonite, prob. LK  
Geochem and B sample 43

Dir: E-W to N65E 50-70 S

7/26/81 p. 2

83 AMK-44 W/2 Sec 5-2N-32E  
MT Michelson C-1

W. bank of Hulahula River - 200-300 ft  
Highly folded turbidites, many over-  
turned beds dipping 70-80° south.  
These show beautiful bottom marks,  
flutes & grooves → E.  
ss mostly VF beds 6" to 2' thick,  
ss is about 60-75% of section

Bouma a, b, & c

A few Inoceramids found at base of  
some bed, one about 12" across.  
Collected fragment and some others.

Shale is hard to fissile, no bent-  
onite noted

⊗ sample 44

LK or UK?

Dense fog rolls in

Photos

CMM, ARK, LBM, 7/27/83 p. 1

83 AMK-45 SENE Sec 18-2N-32E  
MT Michelson C-1

E bank of Hulahula River  
Turbidites as at sta 44, no bentonite.  
at S end of long etc com bottom marks  
⊗ & ⊕ sample 45 → ⊕ E  
Couldn't see remaining etc because of  
river cutting into etc

⊗ AT N60E 50-60° overturned  
to S

83 AMK-46 SWSW Sec 8-2N-32E  
MT Michelson C-1

Revisit to 82 AMK-74 to check  
bentonitic character. Yes, it is bent

Geochem & ⊗ sample 46

83 AMK-47 NWNE Sec 9-1N-32E  
MT Michelson B-1

W bank Hulahula River  
Sampling Kahyah sh  
Geochem sample 47A, B, C

About 150-200' exposed - sampled  
lower 2/3 rds. Section is overturned

7/27/83 p. 2

83 AMK-48 NWNW Sec 6-1N-32E to  
SWSW Sec 31-2N "

Mt Michelson B-1  
Discontinuous ota of Shubik  
Geochem smpls 48 A-C  
Overlying T<sub>3</sub> is about 50' Karen ls ss  
Is mostly siltst w/ some LL VF ss, very  
hard, dark gray, blocky beds 1-3' thick,  
laminated, phosphate nodules (reworked?)  
in basal part  
± 48

83 AMK-49 SW/4 Sec 31-2N-32E

Mt Michelson B-1  
E bank of Hulahula River  
Sampled Kingak Sh  
Geochem and ♂ smpls 49 A, B, C  
Blk shale, contorted and faulted

83 AMK-50 S/2 NE/4 Sec 34-2N-33E

W bank of Okpilak River  
Slumped? etc of Kingak Sh  
Seems to bed dipping W  
Geochem and ♂ smpls 50

Outcrops are very sparse to nonexistent  
along river - mostly glacial

7/27/83 p. 3

83 AMK-51

Sec 19? 2N-34E

Demarcation Pt # C-5.  
Hillside etc between Okpilak & Jago Rivers  
Mostly rubble but one 3'± thin bedded  
etc dipping to S 15°±  
VF ss, some groove casts and burrows  
on base of beds in float  
♂ 51 smpls

Prob LK turba

CMM, ARK, LBM

7/28/83 p1

(83 AMK-52) SW/4 Sec 2-2N-29E to NW/4 Sec 13

2N-30E Mt. Nicholson C-2

Dedo Creek on S flank saddle rock Mt. Nicholson  
Walking down creek (up section) from  
Shublik through much of Kingak Sh.

Kingak Sh is well exposed and apparently  
very thick. Shale is black, mostly  
fossil w/ sub-fossil, com. marcasite  
and pyrite nodules, mostly in lower  
part w/ some in middle, some zones of  
iron stained shale.

Dip varies from 50° to near zero,  
but mostly 25 to 45°, generally  
E-W strike, common contorted, and  
folded and faulted zone but no large  
reversals in dip.

Collected Geochem, ♂ and fossils through-  
out section. Megafossils - small ammon-  
ites in lower part, pelicyrps in lower  
part and less common above, some Ince-  
ramas and rare ammonites in upper  
part (Middle Jurassic?).

7/28/83 p.2

(83 AMK-52) (Cont)

Impl No.	Geochem	♂	♂	Strike	Dip
A	X				
B	X				
C	X				
D	X	X	X	E-W	40 S
E	X	X	X		48 S
F	X	X	X		15 S
G	X	X	X		45 S
H	X				35 S
I	X				40 S
J	X				step
K	X				20 S
L	X	X			
M	X	X			
N	X	X			
O	X	X			
P	X	X	X		
Q	X	X	X		
R	X	X	X		
S	X	X	X		
T	X	X	X		
U	X	X	X		35-40 S



7/28/83 p. 3

SW NW

83 AMK-53 SE 1/4 Sec 35-2N-29E

Mt. Michelson B-2

Flying in fog up unnamed creek trib-  
utary south of Sadlerochit River.  
Opposite Camp 263 Duck. Located  
sta by elevation on chopper  
150 ft exposed on SE bank of creek  
interbedded YF ss and sh (litholite)  
ss in beds as much as 1' thick,  
numerous bottom marks → N70 E (G)

Sh is nonbentonitic to very slightly  
bentonitic

⊗ and Geochem smpl 53  
Prob is LK (Albian)

Structure: dipping gently to east or SE

83 AMK-54 C. Sec 25-2N-29E

Mt. Michelson C-2

Downstream from sta 53

Sh, blk, firm, fissile - sub-fissile  
Looks like Kingak

Geochem and ⊗ smpl 54

CMM, ARK, CMM 7/29/83 p. 1

83 AMK-55 NW 1/4 Sec 21-9N-34E Barter Is. A-5

North side of Manning Pt.  
Manning Pt. Collecting oil sample  
Checked north end of island - found  
very oily smelling turf and surficial  
deposits - no actual oil seep.

Geochem smpl 55 (give good cut)

83 AMK-56 W/2 SW/4 Sec 16-6N-28E

Mt. Michelson D-2

Revisit to 80 AMK-52 to recollect  
oil sand - SE bluff of Kat River

Geochem smpl 56

83 AMK-57 SESE Sec 33-4N-24E

Mt. Michelson C-4

E bank Canning River - looking for oil  
sand

Shallow marine section - several small re-  
gressive buildup cycles from silt to  
dist channel(?) ss - no good or big  
regressive shoreface buildups, com east

Geochem and ⊗ smpl 57  
⊗ smpl 57 (UF ss)

7/29/83

p. 2

83 AMK-58 SW Sec 31-1N-27E  
Mt. Michelson B-3

N side of 4th range - Shakopee Valley  
Checking gully where shell reported but  
unidentified.

Several hundred of overturned shale and  
thin bedded siltst. LVF ss, ripple bedded,  
com ripple marks on base of beds, some  
groove casts, some burrow tracks.  
The ss is quartzose Ellesmerian type w/  
some altered (oxidized) pyrite.

± 58  
Sh is fissile to slabby, brittle, hard non-  
calc. siltst. Aerial plane cleavage developed.  
Geochem 58

Section is overturned 40 to 70° to S  
Further up gully, section is very con-  
torted and faulted. Further up is Lis-  
burne, but we didn't go that far.

This is probably distal Sadlerochit -  
prob still on shelf (?)

83 AMK-59 E/2E/2 Sec 1-15-27E Mt. Mich B-3  
Fourth Range gabb sample of  
Kayak Sh. Geochem sample 59

83 AMK-60 NW/4 Sec 6-15-28E Mt. Mich. B-3  
Fourth Range gabb sample of  
Lisburne Geochem sample 60

CMM, ARK, LBM

7/30/83 PI

83 AMK-61 W/2 W/2 Sec 2-2N-27E  
Mt. Michelson C-3

Photo Hemik ss etc 3 mi W of Lake Mesa  
about 100 ft thick (measured), base not  
exposed but probably close.  
Sh, lt gray w/ rusty burr zones LVF to UVF,  
some pebbly zones in lower part, then  
shy beds in lower 15', com burrows in  
lower 30' (vertical some ophiomorpha),  
beds 6-12" lower part, 5' + above,  
some hummocky x' bed at about 80' up.

± samples 61 A, B, C, D going up.

Att N40E 35 NW.  
This on W plunging syncline

83 AMK-62 NE/4 Sec 15-2N-28E  
Mt. Michelson C-3

Fire Cr. at Sadlerochit-Lisburne contact  
Sampled upper 100' of Lisburne  
Geochem sample 62 A, B, C

Lower 20' of Echooka is conglomeratic,  
w/ chert pebbles. It is VF of those very  
hard, much iron oxide staining.  
± 62 D

7/30/83 p. 2

83 AMK-63 NW NW Sec 15-2N-28E

Mt. Michelson C-3

On ridge west of Fire Cr. showing apparent  
Sadlerochit channeling into Lislavine.  
Seems like about 30-40 ft of relief on  
channel. Fill is LVF ~~at base~~ w/ minor  
chert pebbles ~~in~~ but at top are large  
blocks of Lislavine and larger chert clasts.  
Whole outc. is poorly bedded and lichen covered  
so it is impossible to see bedding  
features or lithology without breaking  
fresh surface.

photo

C. Sec 11-15-30E

83 AMK-64 NW/4 Sec 29-1N-30E

Mt. Michelson B-2

Karen Cr. - type section of Karen Cr. ss  
Coarse siltst, dark gray, very hard, p bedded,  
laminated or lenticled(?)  
Sampled on crest of small anticline  
where it is less fractured 76 ft thick

L. sample 64 A, B, C (A at base)

7/30/83 p. 3

83 AMK-65 SENW Sec 34-2N-36E

Demarcation Pt B-4

Kingake sh. exposed on broad ridge below  
resistant Karen Creek ss (siltst)  
Steeply dipping to N or maybe S? overthrust  
Geochem sample 65A-H (9 sample)  
 thru 500 to 1000' of section of Kingake

83 AMK-66 Sec 32 E 29-T1N, R 34E

Demarcation Pt. B-5

Upper Okparourak Creek W of Jago R.  
Sampling Sadlerochit in folded  
exposures. Many concentric folds  
along traverse so it is not known  
exact stratigraphic position of samples.

L. sample 66A SE/4 Sec 32  
66B C N/2 N/2 Sec 32  
66C near C. Sec 29

Much of section is hard shale, very  
resistant, slaty.  
ss is LVF or siltst.

CMM, ARK, LBM 7/31/83 P1

83 AMK-67 Sec 33-65-46E

Table Mtn 1/250,000 Quad  
Joe Creek area - looking for shale-like  
landed in high saddle (3250') in saddle -  
rocked for a quick view  
PFRs is sltst to LLVF ss

to smpl 67  
Section must be repeated by folding and/or  
faulting.

83 AMK-68 Sec 33 55-45E

Table Mtn 1/250,000 Quad  
Joe Creek - Outcrop of Kingak sh on bank  
of creek - about 75' exposed  
sh, dark gray - blk, fissile where clayey,  
blocky and hackly where slty, con. floating  
F - C qty grains in silty part, con. conca.  
(ironstone), some elements replaced by  
pyrite or marcasite.

Geochem smpl 68 A-C  
to smpl 68 A & B (not same as above)

Att: Gentle dip to S

7/31/83 P.2

83 AMK-69 C N/2 Sec 31 - 55-45E

Table Mtn 1/250,000 Quad  
Joe Creek area  
Lower Cret (?) part of Kingak sh (mapped  
as Kongakut fm on map)  
On S trending broad ridge from large  
flat above - choppy elev. 3580'. Several  
hundred ft on subtle ridge.  
sh, dark gray - blk, rubble crop, w/ con  
zones of small ironstone conca, fissile  
clay shale in parts, other is hackly w/ x  
some floating F-M sand grains, con.  
well preserved Buchias in float  
3 69.

Geochem & to smpl 69 A & B  
Att N70E 10 N

July 6, 1984 Molenaar, Parrish &amp; Bader

(84 AMK-1) Loney Creek in Canada  
 25 mi SW of Herschel Island  
 Herschel Island 1:250,000 quad  
 69° 20' 18" N Lat. 139° 46' 46" W Long.

Kingak Sh. exposed along complexly folded and faulted south flank of Loney Creek syncline. Just upstream from unfolded top of Shublik - about 75' of calc silt. w/ lime grainstone below some conglomeratic lenses. At top of Shublik is 3-4" basal cal under Kingak Sh. Cal is apparently re-working of underlying lith.


Sh is firm, black, fissile-subfissile  
 Samples Geochem sample 84 AMK-1a & b  
 a is about 30-40' above base.  
 b is 100-150' above base.

Examined Mountjoy's Loney Cr. Shublik section about 1+ mile upstream from this point. Section is about as he described it, but section is overturned striking N 50-60° W overturned 75-80° to S. Section is unconformably overlying shaly phyllitic rocks of Nerrouhpuk. Angularity is apparent.

1984

Molenaar et al 7/6/84 p. 2

84AMK-1 Cont.

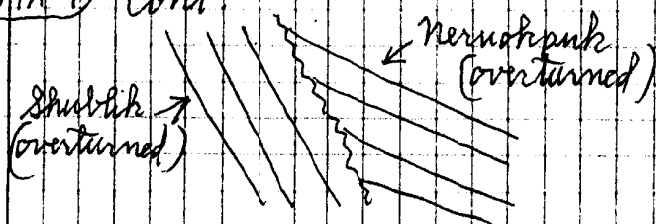

84AMK-2 Herschel Island 1/250,000 quad

Loney Creek syncline near axis as drawn on geologic map. Small tributary of, and 3 miles SW of junction with Malcolm River and 4 1/2 miles NNW of Loney Cr. Shublik section  
69° 23' 26" N Lat. ; 139° 53' 18" W Long.

SR  
Smpl. Small etc. of Kingak SR sampled for geochem. Smpl 84AMK-2

84AMK-3 Demarcation Pt 1:250,000 quad. Canadian part, N & W of Fish Cr. and 10 1/2 mi SW of Komatuk Beach.

Rubble etc near hill top. Dark brown weathering, med gray ss, very fine, Sadlerochet Group - Krishak ss  
±  
± sample

Molenaar, JTP & J.W.B. 7/6/84 p. 3

84AMK-4 Demarcation Pt 1:250,000 quad. Canadian part 2 1/2 mi WSW of Sta 3

Rubble etc on valley sides are red w/ some green slaty shales - apparently Nerutshuk underlying Lisburne ss above.

±  
± sample 84AMK-4

84AMK-5 Demarcation Pt, 1:250,000 quad. Canadian part about 3 mi W of Sta 4 and on ridge just W of 1924' hill top w/ bench mark

On south side of ridge near top is dark weathering Eckooka cgl and ss patch on near-dip slope overlying light gray Lisburne. About 15-20 ft exposed cgl at base, angular to rounded clasts of white and gray chert up to 1" diam. in ss matrix. Above is hard VF-F ss w/ some cgl

±  
± sample of various types  
± 84AMK-5

Molenaar, Parrish, & Baden 7/6/84 p. 4

84AMK-6 Demarcation Pt. 1:250,000 quad.  
Canadian part, across valley  
about 1 mi south of sta #5

Rubble etc of strange granular  
limestone w/ dk grains, lt gray w/  
rounded and elongate blebs (clasts?)  
of dark granular limestone  
1/8 - 1/4" diam ± sample

84AMK-7 Demarcation Pt. 1:250,000 quad.  
Canadian part, on hill about  
1 mi north of sta 4.

Checking dark weathering rocks  
overlying lt gray Lisburne

Rubble etc of Ss, F and M w/ some  
pebble cgl. ± sample 84AMK-7

This must be Echooka again overlying  
Lisburne. If there are no structural  
complications, i.e. thrusts, Lisburne,  
which apparently is underlain by  
Nemah of Sta 4 and overlain  
by Echooka here, is only about  
500 ft thick.

Molenaar, Parrish, & Baden 7/6/84 p. 5

84AMK-7 Cont

From here, we flew to NW  
over what is mapped as Kingak?

No pits seen and where there  
looked like there might be an etc,  
it turned out to be gravel.

There may not be Kingak here.

7/8/84.  
CMM, Judy Parrish and Dudley Rice

Spent day on familiarization trip of Marsh Creek anticline and areas around Sadlerocket Mtns.

Judy found an ammonite in float near Kingak shale outcrop at Squeek Valley section  
84 AMK-8

84AMK-8 Squeek Valley section near  
C Sec 6-2N-26 E MT Mich. C-4

also collected siliceous tuff sample from red zone

± 82 AMK-17 E

Molenaar & Rice 7-9-84

Familiarization trip SE of Barter Island.

Visited bentonite and shale (mid-Cretaceous) outcrop on Jago River  
Sec Sta 80 AMK-70 and 83 AMK-20

Collected tuff sample from inspection from main outcrop

84AMK-9 = 83AMK-20

NENE Sec 4-6N-35E  
Demarcation Pt D-4

± sample of tuff - smpl 9 a

Down river on point where lots of Eocene mudstone w/ floating pebbles is

Collected sample of non calc hard concretion, - dolomitic?

± smpl 9 b = 83AMK-21 ±



Motinson & Rice 7/10/84 p. 1

(84AMK-10) S<sup>1</sup>/<sub>2</sub> / S<sup>1</sup>/<sub>2</sub> Sec 25-8N-36E  
Barric de A-4 Quad

Outcrop along W bank of Nguanek  
River and up small gully  
About 30' exposed  
Silty mudstone, grayish brown soft,  
silty in thin 1/4 - 1/2" platy beds,  
non-fossiliferous abundant grains and  
black floating chert pebbles up  
to 1/2 - 3/4", some paleocontem-  
poraneous slumping and scour holes  
with some material. Some very  
thin wavy VF sand layers < 1/8"  
Fairly flat lying. Upper slope -  
shell break

sh  
smp

sh sample 10 a & b

(84AMK-11) NE NE Sec 20-7N-37E  
Demarcation PT D-4

Nguanek River - small etc on E bank  
Rubble etc of ss, dark gray, lithic VF w/  
M. mudstone hard calc, com clay  
chips, no bedding features on blocks  
# 11

sh  
smp

Dug out calc sh nearby  
sh sample # 11

7/10/84 p. 2

(84AMK-12) C Sec 33-7N-37E

Demarcation PT D-4

Small etc in side gully, partially  
covered by slump.

sh Very laminatic sh, soft, med gray  
Smp possibly dipping 15° E to NW  
sh sample # 12

(84AMK-13) SW SW Sec 1-6N-36E

69° 53' 56" N 143° 02' 57" W

Remot to 83AMK-27

Not so much snow in gully this  
year. Hiked up gully to SSE  
before JK is mapped. Found  
a few shale etc on side of gully  
sh samples 84AMK-13 a & b

sh  
smp

sh is non bent. Smp a is  
barren gully on E side - may  
be pebble sh? Smp b is  
on W side lower down.

Further up gully is bent paper  
sh (VH). On immediate SW and  
NE side of bend in drainage is  
VH bent paper sh - no pebble  
shale there

7/10/84 P. 3

(84AMK-14) SWSW Sec 1-6N-36E  
Demarcation Pt D-4  
Maguanah area near JN outcrop

Walked down main gully to NNE  
about 1000 ft and all his bent sh  
and bent, steeply dipping. Found  
red w/ abundant *Inoceramus*  
prisms a short way down. No  
pebble shak

Sh  
smel  
Took sample 14 at N end of  
outcrop - soft bent. sh.

Returned to Barter Is to pick up  
Judy and try to go to Shuklik  
section on Kahrin River, but still  
fogged in to west, so we returned  
to area SE of Barter Island.

(84AMK-15) NW Sec 34-3N-36E  
Demarcation Pt C-4

River cut on tributary to Okupoka -  
vika River. About 60' exposed.  
Sh, dark gray, nonfossil, firm-hard,  
common discontinuous calc-ironstone  
beds up to 2 ft thick.

7/10/84 P. 4

(84AMK-15) (Cont)

3 Found large ammonite or part of one  
(5" diam) and one *Buchia?* or  
*Inoceramus* B sample 15  
*Kingak?* *Pleuromya*  
Two shale samples 15.a and b  
Some beds in shale have pyritized  
fossiliferous grains (M-G)

Alt N50E 23SE

(84AMK-16) SWSW NW Sec 34-3N-36E  
Demarcation Pt C-4

Stream cut on E side  
Couldn't get to most of it because of  
high water  
Sh w/ calc-ironstone beds as at Sta 15  
Sh dipping 10 to 25° south  
Sh sample 16

(84AMK-17) SESE Sec 33-3N-36E  
Demarcation Pt C-4. 15 examined  
Sh w/ thin 1-2" discontinuous shak -  
LVF ss tubs, shi grading, no bottom  
marks noted. Non bent except for  
one thin 1/4" bent. Albian? or UK?  
Sh sample 17 Alt E-W - 35S

Molenaar & Kelley

7/17/84

84AMK-18 W<sub>2</sub>W<sub>2</sub> Sec 27-7N-30E  
Mt. Michelson D-2

Center Creek area - tributary of Carter Cr.  
on N flank Marsh Cr. anticline  
Loosely consolidated sd, slit w/ cgl lenses  
and scattered isolated pebbles.

2 pie

150' ± exposed  
Some small faults dipping steeply to SW  
or W. Fault att. N 15 W 25 SW  
Upper block offset 1' ± to NW

Att of strata N 50-55 E 53 NW F  
N 55-60 E 57 N G

Took two paleo samples from 40' section  
of thinly bedded brown silty mdst  
w/ cgl. VF sd layers  
sh smpl 18 a & b

Paleo  
smpl

84AMK-19 SW SW Sec 26-5N-27E  
Mt. Michelson D-3

Revisit to Sta 83AMK-5  
Saw many more turbidite features  
Good bottom marks - grooves, pods,  
brush, and some flutes → N 30 E  
Some bed may be traction current de-  
posits

Paleo smpl 19

7/12/84 p.2

84AMK-20 NE SW Sec 26-5N-27E  
Mt. Michelson D-3

Revisit to 80AMK-51  
Rippled bed ss bed 3-4' thick, LF, hard,  
abundant carb frags and small  
carb. throughout. No med scale cross  
bedding. Ss beds are separated by  
4-12" beds of very carb w/ trans-  
ported coal sd-siltst beds

Paly

Paly sample 20  
sh smpl of ss # 20

Association of this etc with  
nearby sta ~~80~~ where some  
beds are turbidites suggests that  
this may be distributary channel  
well out on delta.

Molenaar & Kelley

7/13/84

84AMK-21 NE Sec 11-3N-31E Mt. Mich C-1

Revised to 83AMK-42

Re-examining Kemik - Shublik contact at Last Creek

Very sharp contact. Shublik ~~is~~ has several calcite veins in top 4" paralleling contact and is somewhat bugged. Lower 4" of Kemik ~~is~~ has fractures that parallel contact - above is fractures normal to bedding. No pebble zone at base as is normal.

This could be a thrust fault contact

84AMK-22 NE SE Sec 1-4N-31E

Mt. Michelson C-1

On hillside 1 mi N of Last Creek  
Squirrel diggings indicate sh, some with pebbles and brooded granules  
Prob. is pebble sh.

Paleo  
small

Paleo sample 22

7/13/84

p. 2

84AMK-23 NW NW NE Sec 12-3N-30E

Mt. Michelson C-2

On ridge east of Itkulyaruk Creek, north side eastern Sacklerock Mt. Elevation about 4000 ft. Contact of Lisburne on Kataktauuk dol. Dk dips much steeper to south - looks like good angular unconformity although Kelly thinks the contact may be a decollement thrust fault. Dk is fine grained dolomite with scattered vugs.

± sample 23a Att: E-W 345

Contact is in covered bench - about 20' covered.

Lower part of exposed Lisburne is grainstone in lower 6-8 ft some cross bedding, common elongate chert lenses 1-2 ft long 1-3" thick

± sample of Ls 23 b  
Above this is 3-4 ft thick breccia with angular clasts up to 12" of chert somewhat foliated in non foliated matrix. Although there are some calcite healed fractures. Is this a sedimentary or tectonic breccia?

7/13/84 p. 3

Spent most of day checking structural relations in eastern Saddle Rock mtns. Concluded that thrust faulting is present.


One thrust moves Vermilion over Lorraine - thrust plane is marked by a color break in the saddle in N/2 Sec 1-3N-30E and N/2 Sec 6-3N-31E. Dip of fault is about  $45^{\circ}$  S.

In N/2 of Sec 5 and near center Sec 4-3N-31E is another thrust showing PM1 over PM2 and P<sub>1</sub> over P<sub>2</sub>. Thrusts seem to join to east and trends down East Creek and south of Kemik sh outcrop on sharp ridge. Kemik - Shublik contact may be a thrust fault - see note at sta 21. Up hill from this outcrop (to west) is section underlying P<sub>1</sub> of Shublik (braggers in upper part), Nungak sh, Kemik sh and Pellet sh. This sequence is in NE Sec 10 and NW Sec 11-3N-31E and is on upper plate of thrust separating it from East Creek section. Kelley is putting these on map.

Molenaar & Kelley 7/14/84 p. 1

84 AMN-24 C N/2 Sec 19-4N-30E  
Mt. Michelon C-2

Marsh Creek east fork near mtn front. Checking structural relationships. ATP is thrust contact of Nungak (P) on Kemik sh. This is first outcrop of Kemik going downstream from contact of pelitic shale (and 6' of basal ss - Kemik) on Saddle Rock. Exposed surface of Kemik is faulted cut off plane of thrust fault. Common slickensides on surface. Att of fault surface: N75E 18.5

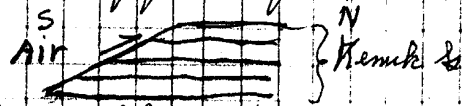

Paleo  
sample

A few hundred ft upstream is a shale outcrop dipping to south. Belemnite and pelecypod found in float below. Must be Nungak. In sample # 24. There is Kemik sh above on hill to west. From here south towards Saddle Rock is discontinuous outcrops of sh - prob mostly pelitic shale. North dipping in southern part, but there are some sharp reversals and disturbed zones.

P. 2

1/2 mile.  
with 2  
parently  
rust silica  
mes in  
on  
bed a  
to indic-  
from  
to del  
therefore

→  
SSE




except  
thrust


photos

7/24/84 P 3

(84AMK-24) (Cont)

Walked upstream through the Sed-  
ferochit and upper part of Lusuma  
fault-bend fold

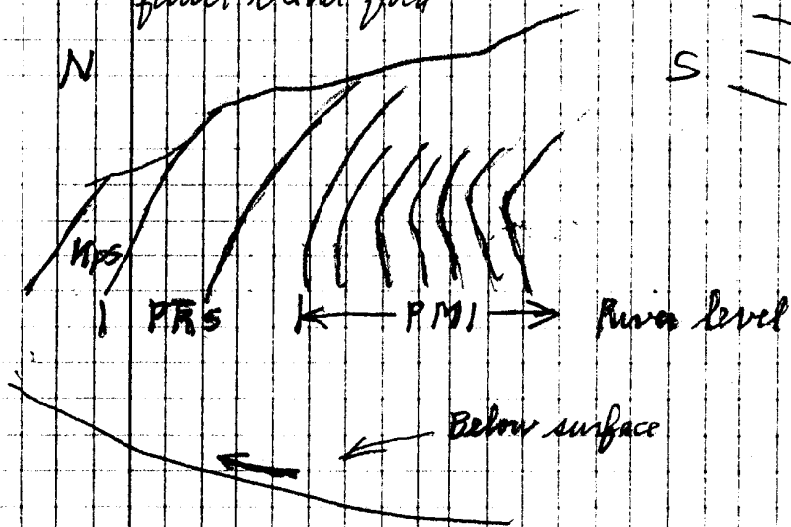

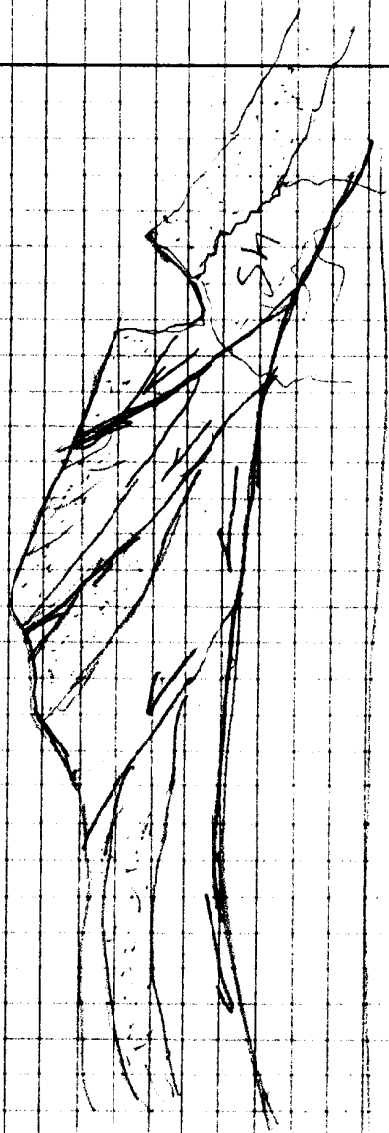

Molenaar & Kelley

7/15/84

P. 1

(8.4 AMK-25)

SE NW Sec 28 - 41N-31E

Mt. Mickelson C-1

3 1/2 miles W of Sad. River

100 ft ± exposed

sh and siltst

Siltst w/ sh interbeds. Siltst in beds

1-2 ft thick, separated by thin

sh interbeds, siltst, irregularly

bedded, small ripple lam. with

irregular burrows, some belemnites -

recrystallized filling, some wood

fragments. Two or three 15-20 ft

cycles of this sequence - prob

shallow marine shelf tongues from

north. Kangas sh?

Below is dark gray-black sh,

Falco non fossils, non chalk

Geochem Falco simpl 25 a & b


Geochem " 25

Whole etc is uniformly dipping  
17° ± to north

69° 40' 30" N Lat  
154° 32' 20" W Long

7/15/84 p.2

84 AMK-26 NW Sec 33-4N-31E  
MT Mich C-1 1 mi S of 25  
N 150' S

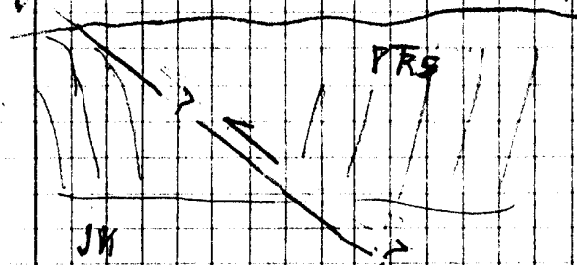

Along front of Sadlerochit mtns

80% Kingak sh like at sta 25 overturned (E-W 60S-7) separated from Sadlerochit by covered interval (but not shaly) from Alt in Sadlerochit E-W 75-80 N

Possibly is thrust fault between. Upper part of Kingak beds are bent over to N. Drag under thrust fault or hillslope creep?

Sadlerochit upper part is thin bedded w/ silt. sh this shoreward. Fire Creek Mbr?

7/15/84 p.3

84 AMK-27 SW SE Sec 21-4N-31E  
MT Mich C-1

Kingak sh etc on NW side of creek valley and also on SE side of creek about 20 ft exposed, top and bottom not exposed. Dipping gently to NE

84 AMK-28 NENE Sec 3-5N-29E  
MT Mich D-2

Squirrel diggings and shale chip soil etc on side of bluff on east bank Paleo of Marsh Creek  
smp Sh, mid gray Sample 28

84 AMK-29 NW SE Sec 14-5N-29E  
MT Mich D-2

Several discontinuous ocs of sh & sh. sh in beds up to 15", UF-VF, minor pellets, some beds coarsen upward, plain bedded, minor small ripples, com. carb, interference ripples, load casts (?) on top, some grooves and some flute (?) in float. ± smp 29  
dip: N 75 W to E-W 50-55 N

assume is right side up, although some features suggest otherwise  
Paleo smp 29a & b 300' strat apart



7/15/84 p. 4

84AMN-30 Dec 7, 18 & 19 - 3N-27E  
Mt. Michelson C-3

Collecting samples from Natakturnuk Dolomite along Kat. River where it cuts through Saddle Rock Mt. going down river and down section A at top; J at the bottom Ten samples; 30A through J


Several of the samples had irregular porosity and two or three were brecciated.

Took attitudes and plotted them on map

Most were around N80W dipping 45 to 55° south.

Section is about 10,000 ft thick if there are no fault repetitions.

Detailed work may show that section is duplexed, etc. repeated by bedding plane thrusts.

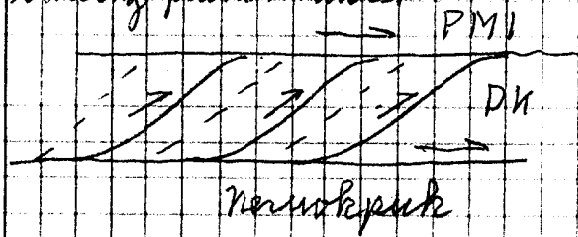


Molenaar & Kelley 7/16/84 p. 1

Checking structure on north flank of Saddle Rock Mt.

84AMN-31 C N/2 Sec 9 - 3N-28E  
Mt. Michelson C-3

In saddle where thrust fault is mapped. Natakturnuk Dolomite on both sides ~~is~~ disburse on hilltop and ridge to north. Probably in décollement. Thrust fault contact with Natakturnuk. Lower part of exposed disburse has contorted folds. Took picture from opposite hill.

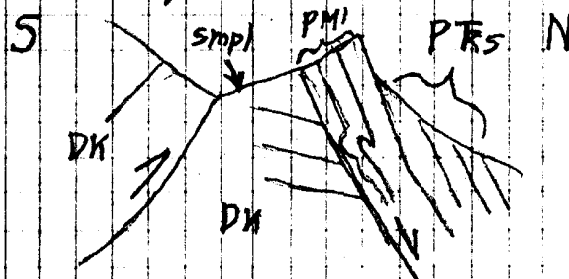

Took sample of Natakturnuk Dolomite on side hill just N of fault Sample 31 Good rugose porosity in dolomitized oolite.

T/16/84 p. 2

84AMK-32 W/2 NE Sec 7-3N-28E  
Mt. Michelson C-3

Outcrop of Shublik along W side  
of Creek - about 50-100 ft exposed  
Att N75 W 66 overturned to S

1/2 mile to NE on ridge east of  
creek are 3 or 4 outcrops of  
Nemok ss and pebble sh and  
possibly Kingak repeated by small  
thrust faults. Nemok dips to south  
at low angle. Did not stop - just  
fly by geology

84AMK-33 C Sec 10-3N-28E Mt. Mich. C-3

Dug out pit on hillside beneath Lullburn  
and above Saddle Rock. Prob is pebble shale  
on footwall of thrust fault. Found a few pebbles

Paleo sample  
Paleo sample 33

L sample 34 - has secondary porosity

84AMK-34 SE NW Sec 10-3N-28E Mt. Mich. C-3

Pebbles of P.R. S on hillside. On footwall lie  
near thrust fault, however, DK over P.R.  
exposed on opposite hillside. Took pic

T/17/84 p. 1

Molenaar & Kelley

Checking and mapping structure in  
Shublik Mtns. - on C-2 quad.  
Kelley mapped some of the structural  
features in all but the western part  
of the range. There seems to be a  
decollement at the base of the Lullburn  
although it can and has been mapped  
as a depositional contact. At the west  
part there is 100 ft plus of Kingak  
Shale at the base. This goes out to the  
east we think by thrust faulting  
along that layer. Where it is pre-  
served it is somewhat sheared as  
seen from the air.

Thrust faults are distinguished by  
abrupt change in structure across fault,  
contorted or disturbed bedding near fault,  
and a light colored band of rubble  
(qtz veins, etc) along fault zone


84AMK-35 SE SE Sec 1-2N-28E  
Mt. Michelson C-3

Random sample of Natakuruk Dolomite  
finely crystalline, waxy porosity  
Sample # 35

Below DK is in apparent thrust contact  
with pebble shale

7/17/84

P. 2

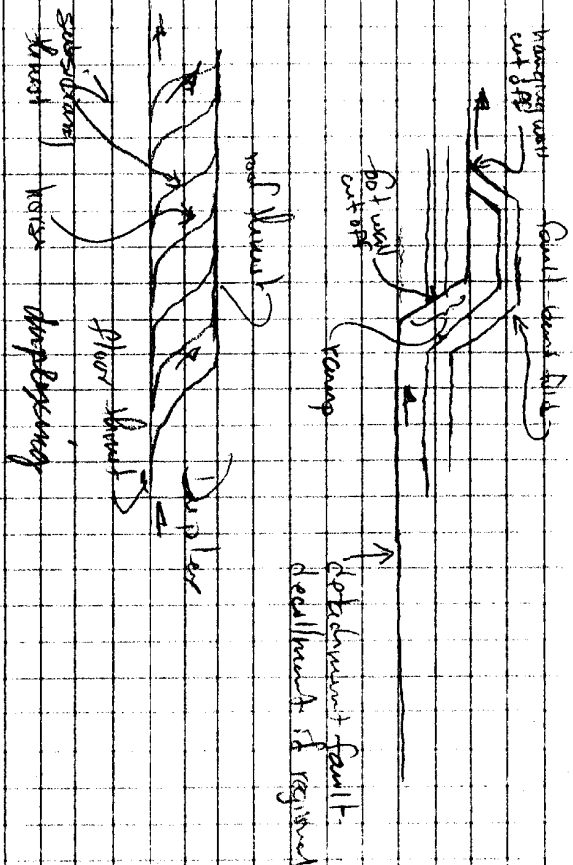7/19/84  
Molenaar, Bruns, and Fisher

Familiarization trip for Bruns and Fisher. Went to Parter Creek Pliocene locality, east bank of Marsh Creek to see Kps on Sadlerochit, walked up canyon into disjunct land at Paleocene turbidites on Khat River, went up Khat River through Sadlerochit Mtns, ran into Dave Tailleur and Peter setting up camp at south side canyon entrance, went to Snake Valley section (cold and windy), flew through part of Shulkin Mtns to Fire Cr., looked at Shulkin from top, flew up Sadlerochit River to Fourth Range, back through Sunset Pass, looked at Vermorel on north side, and then examined mid Cretaceous and Eocene rocks on Jago River.

84AMK-30 near c/w2 sec 6-3N-30E  
Mt. Michelson C-7

In Vermorel on N side Sad. Mtns in saddle between basic intrusions on N and white quartzite on S.

± small 36 a from basic igneous  
36 b from quartzite  
Between is platy phyllite

1985

PT Thomson #1

9000 - 9050  
9400 - 9450  
9750 - 9790  
10200 - 250  
10550 - 600 10950 - 980  
11300 - 330  
11600 - 640  
11900 - 950

PT Thomson #2

9000 - 9030  
9300 - 9400  
9600 - 9700  
9900 - 9860  
10200 - 260  
10500 - 560  
10900 - 950  
11310 - 370  
11650 - 700  
12100 - 140  
12500 - 540  
12700 - 750

#4 32-10N  
-22E

10630 - 700  
11000 - 50  
11300 - 340  
11700 - 750  
12100 - 130  
12470 - 500  
12850 - 900  
13250 - 300  
13700 - 760  
14100 - 140

July 3 1985 Molenaar & D. Bohn

85AMK-D NE 9W Sec 14-2N-25E Mt Mich. C-4  
Shublik Mtns Nanook Cr. area

Reconnoitering for sections of Nanook and  
Katakaturuk in Shublik Mtns

Nanook Creek area

Landed near base of Nanook ls.

Lower couple hundred ft is well bedded  
lime mudstone, dolomitic. At base is  
25-50' yellow wx zone of earthy dolo  
with some maroonish wx finer grained  
dolo. Is this a soil zone?

± sample 85AMK-1A earthy zone  
1B is finely lam ls and some  
black arg ls below yellow zone

Below is thick bedded - massive  
Katakaturuk Dolo, lt gray, good  
ruggy porosity, some interchysalline  
porosity ± 85AMK-1C

Across valley to SW is complete section  
of Nanook ls, fairly well exposed,  
about 1,500' thick (est)

85AMK-B C Sec 24-3N-24E Mt Mich. C-4

Along Igneke Cr. - Burned out organic sh,  
red w/ black clinker, prob in GRZ  
Downstream a short way is Inoc zone  
contorted.

7/4/85  
Molenaar & Dede Bohn

85AMK-3 Revisit to Jago River etc  
= Sta 83AMK-20 & 80AMK-70  
NE 1/4 Sec 4-6N-35E Demarcation D-4

Checking black shale and bentonite etc  
below Inoc zone and exposed higher  
on hillside to see if it is GRZ "it is!"  
Background and count in Inoc zone  
is 50. Took several readings in  
GRZ which are as follows:

	Background	etc count
Inoc zone	50	50
GRZ	170	275
"	100	150
"	100	170

No doubt, this is GRZ.

Took 3 black soft paper shale samples  
Spl 85AMK-3A-C for geochem

Downstream on hillside is about 200 ft  
of steeply dipping shale and bentonite.  
One zone with some Inoceramus but not  
like main Inoc zone. This must be  
fault repetition of section above Inoc.  
zone upstream. This part of section  
was never exposed on previous visits -  
probably was covered by mud.

This year, river cuts into section above  
Inoc. zone. Hard to get much beyond  
Inoc zone.

7/4/85 p. 2

85AMK-4 Revisit to Jurassic shale etc area on Māmanakā High = 83AMK-24 and 84AMK-13 & 14.

SW/4 Sec 1-6N-36E Demarc. Pt D-4  
Plotted on photo # 7849

Located Inoc zone just south of small gully north of bend in main gully. Bed is dipping S (overturned) steeply. Immediately to south is gamma-ray zone. Counts are as follows:

	BK	Otc count
Inoc. zone	50	50
GRZ	120	225
"	120	180
"	140	280
" wash	150	180

At SE bend in gully is pebble sh - Kingak, but is pretty much covered. However, gamma-ray count drops. Much snow in gully. To SE, but did get dug out shale on W side (Kingak?). Farther up gully is much ironstone conc rubble. Found one ammonite impression. Farther up on east side is bent sh etc with high gamma-ray count. Took sample 4B. Traversed down gully to NE and found yellow w/ siliceous tuff a couple hundred ft above Inoc zone, then more sh

85AMK-4A

85AMK-4B

7/4/85 p. 3

and bentonite with high gamma-ray background count.

Farther down creek after last UK sh and bentonite etc is mud gray colored soil, one conc w/ pebble sh etc. Is this Eocene?

Upstream to SW from bend where Jurassic sh is is shak & bent. for a short way - no sign of pebble shale.

85AMK-5 Revisit to 80AMK-69 & 83AMK-23 Māmanakā High SW/SE Sec 3-6N-36E Demarc. Pt D-4

Collected black brittle substance - solid hydrocarbon(?) from poorly exposed Jurassic, etc where we previously collected Jurassic ammonites and belemnites washing out of slope. This is just across gully to south of pebble sh(?) etc.

85AMK-5 solid hydrocarbon


Kelley and Molenaar

7/5/85

85AMK-6 E Fork of Marsh Cr; Mt Mich C-2  
C E/2 E/2 Sec 19-4N-30E  
= 85AK-104

Took 2 sh samples from large etc of  
black sh on E side of creek.

85AMK-6 A & B A above

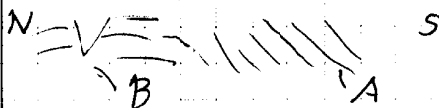

Prob is pebble sh. Look for fossils or  
pebbles; found none, some pebble size  
marchasite nodules.  
Farther east found impression of  
nondescript clam about 1/2" long  
in sh.

Molenaar & Kelley

7/6/85

85AMK-7 At junction of tributary with  
E Fork Marsh Cr. Mt Mich. C-2  
NWSE Sec 6-4N-30E

Inoceramus zone crops out in last etc  
before junction on W side

150' upstream is etc of black fissile  
sh w/ bent. GRZ?

sh  
smp

sh sample 85AMK-7

Walked down tributary from about 3/4  
upstream. Possible dgs and a few  
good ones of sh, bentonitic. It looks  
like all UK.

Along main creek a couple hundred ft  
down stream is a good etc of a fault  
zone - prob part of a duplexed thrust.  
Much contribution in bentonitic sh  
w/ concretions - all UK; no Inoc.  
zone seen

85AMK-B SWSW Sec 24-4N-29E Mt. Mich C-2  
Kps (?) sh rubble mixed with Lis-  
burne wash. Sadlerochit is missing  
across this area - fault out by frontal  
Sadlerochit Mts fault well up on  
hillside. PMI faulted against Kps (?)  
sh  
smp

sh sample 85AMK-B

Molenaar & Kelley

7/7/85

(85A) MK-9 S/2, S/2 Sec 22 to stream junction in  
C W/2 W/2 Sec 15-4N-29E Mt Mich. C-2  
Traverse down west fork of Marsh Creek  
starting in pebble sh below sta 80AMK-38

± In upper part of Kps is 2' LVF ss bed, no  
bedding features, sharp base and top.  
85AMK-9A ± of ss

about 50-100' downstream is 100' wide fault  
zone in bent sh. ~~Part~~ UK

at S end of fault zone is 3-5' thick  
bed - Inoc. This may be higher than  
main inoc zone

next etc appears to be Kps, non bent  
found one polished 4" pebble, etc is  
rubble, however

sh  
smpl

sh smpl 9B Kps?

sh  
smpl

Then we go back into bentonitic sh  
prob GRIS. No siliceous tuff seen  
Then more Kps sh smpl 9C

Farther downstream on E bank is long etc  
of generally S dipping Kps or UK(?)  
fine wx, micro-mucaceous, no fossils found  
sh smpl 9D. 9F & 9G (collected later)  
N/2 of etc is fault zone, prob many repeats  
of Kps

sh  
smpl

7/7/85 p.2

(85A) MK-9 Cont.

Working downstream is ~~some~~ bentonitic sh  
and 2/3 or 3/4 toward E on W side is  
a lt gray-white weathering tuff (fine) bed.

at E is 8-10' thick shattered VF ss  
etc, prob is Brookian. Overlain and  
underlain by sh and bentonite

±

± 9E

E is on W side just S of creek jet.

(85) AMK-10 NW/4 Sec 20-4N-29E  
Mt Michelson C-2

Walking along UK bent sh etc  
along Nulavik River

Starting in red zone - red weathering fine  
tuff, silicified, then discontinuous etc  
and float of bentonitic sh, steep  
dipping to contorted. At end of  
traverse, but not last etc are some  
small tight north verging folds in  
interbedded bent sh and fine silicified  
tuff (beds 2-4" thick). Took photos.



Molenaar, Kelley & Armstrong

7/9/85

85 AMK-11 NW/4 Sec 7, SW/4 Sec 6-2N-26E

Mt. Michelson C-4

Traverse down ridge and down section from lower part of Nanook ls. and about 400 ft of Katakturuk Dolo to fault contact at Hus Creek on N side of Shub-like Mtns. Beautiful clear, calm to slight breeze. Kat dolo is fine crystalline dolo w/ abundant frags. Took two P & P

± samples in upper part

85 AMK 11 A & B P & P

Upper part of Kat dolo is shallow marine sub-tidal - inner tidal, com zones of med scale X beds in pelletoidal packstone, burrowed, com mud (lime) chips

In middle is ~~algal~~ algal supra tidal facies w/ algal heads. Took several pictures


Molenaar & Kelley

7/10/85

85 AMK-12 SE NW Sec 4-2N-36E

Demarcation PT C-4

Tributary of Okerohovich River; downstream from ~~the~~ pellicle sh etc.

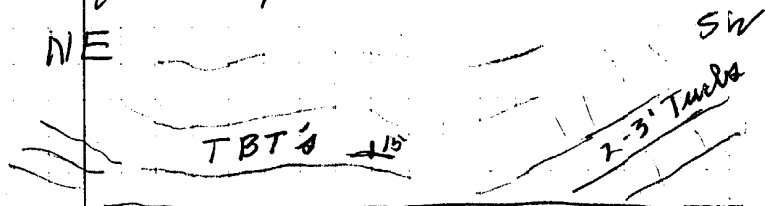

Several 2-3' thick turds ss etc at SW end with 2"-6" sh interbeds.

At NE and main part ss beds are 2"-6" thick w/ 3"-12" sh interbeds

Ss med-dark gray, VF, fairly uniform but graded in top inch or so, Bouma b-c, ripples → sh, common bottom marks in float incl flutes. None seen in place


Sh may be slightly bentonitic but not certain.

Ore is somewhat fractured in SW end, probably is near a fault

Molenaar & Kelley

7/11/85

85 AMK-13 NE/4 Sec 7 SE/4 Sec 6 - 3N-28E  
MT. Nicholson C-3

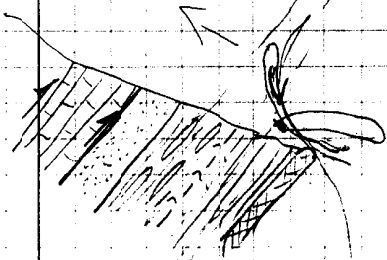

On N side Sad Mtns E of Kat River  
Checking area where Kemik ss is re-  
peated by imbricate thrusting.

Up gully and hillside is overturned  
Lispcomb, Sadlerockit, Shublik, prob-  
ably Kingak and Kemik ss, all over-  
turned and part of Sad Mtn block.

Sh sample near base of Kingak from  
squirrel diggings


85 AMK-13 NE/4 Sec 7

Farther down hill are 2 or 3 repeats  
of Kemik in different blocks.


One is above above and toward mtn  
from in-place Kemik. Relationship  
questionable.

7/11/85 P. 2

85 AMK-14 C SW/4 Sec 3 - 3N-28E  
MT Nicholson C-3

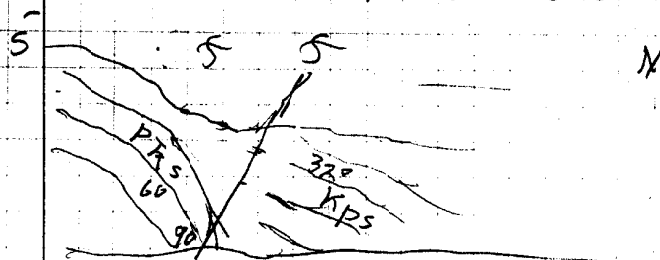

Outcrop along small creek, PRS  
faulted against ~~PR~~ pebbly shale  
(lower part of KPS - the silty part  
w/ pebbles).

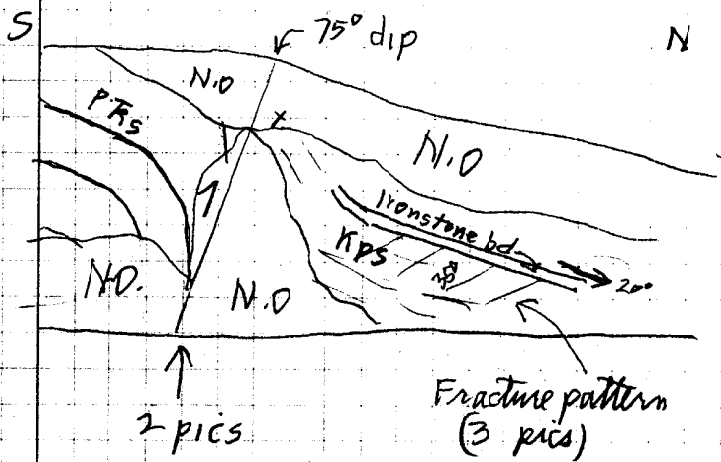

Molenaar & Kelley

7/12/85

(85) AMK-15 N/2 Sec 11, SW/4 Sec 2-3N-27E  
MT Michelson C-3

Traverse down and along tributary stream of Katabaruk River on N side Sad. Mtns

Starting at thrust fault contact of PMI and Kat. Dolo. PMI is N80W dipping to S (overturned) 45° at fault contact decreasing to 75° 100' N. Kat Dolo is shattered rubble near fault.

Several hundred ft downstream is etc of Pfs, fractured, no attitude

Then all covered to just before Kemik ss etc where there is pebble sh float w/ common pebbles

Kemik attitude is N75W 20 NE F  
Farther W along strike is

Sh  
smpl just below in small gully is etc of silty mudstone dipping 45° S  
Sh sample 15. Farther down slope is much more Kps rubble w/ pebbles, then bentonitic sh

Molenaar & Kelley

7/12/85 p. 2

(85) AMK-16 NE/4 Sec 2-3N-27E to  
S/2 Sec 35-4N-27E  
MT Michelson C-3

Traversing small creek with good exposures of shale

Most all is UK bentonitic sh with fair gamma-ray count - background of 100, count of 150-180 I. Prob is some of GKZ. ~~Some~~ Some is non- or little bentonitic, some pebbles, one quartz cobble 3" across.

Sh  
smpls Took sh smpls 16A & 16B of probable pebble sh. Then more bentonitic sh.

Match Most or all of section is dipping 30-45 to S w/ some fault zones repeating section

Just beyond N end of outcrop is separate etc of pebble sh, fairly flat lying.

(85) AMK-17 C SE/4 Sec 35-4N-27E  
MT Michelson C-3

On west side of hill, a couple hundred ft of black brittle fissile sh w/ congl pebbles. One 8" quartzite cobble


Sh  
smpl Sh is dipping N about 35°  
t-17

This is Kps Sh sample 17

Molenaar & Kelley

7/13/85

85AMN-18 Sec 4 95-3N-31E MT Mich C-1  
East end Sad Mtns

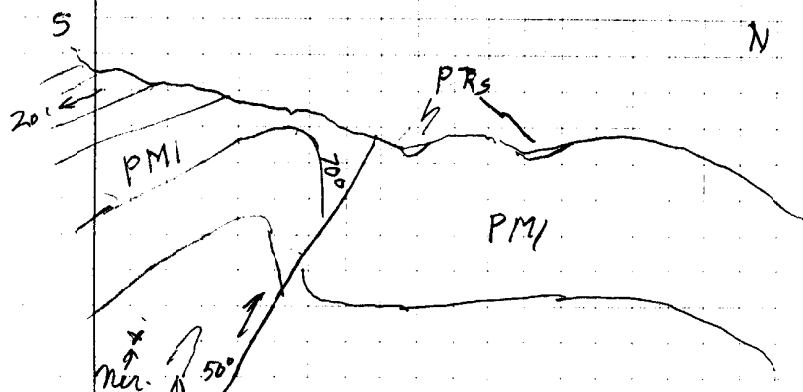


Nerwokpuk quartzite & mangled sh-phyllite

Viewed structure from saddle near center of Sec 4 (view to W above). Then went into canyon near C SE/4 Sec 5 to check out Nerwokpuk quartzite & phyllitic sh in core of tight fold. Also may be some quartzite dragged up along fault near saddle

7/13/85 p. 2

85AMN-19 Sec 3 and vicinity 95-3N-31E  
MT Mich C-1

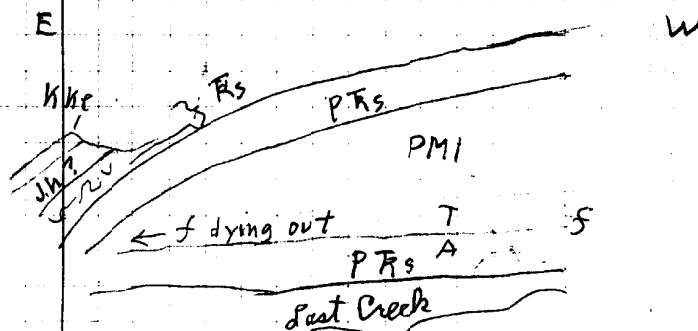

Landed on N side of Last Creek to view E plunge of Sad Mtns and dying out of fault. There are some complications, however with an up-to-the-N fault paralleling lower part of Last Creek, probably south of Last Creek Kemuk section

7/13/85 p. 3

85 AMK-20 S/2 NW/4 Sec 11-3N-71E

Mt. Michelson C-1

Last Creek area - Walking around checking strat. and structural relations in area.

Shulick overlies PFs coming off ridge to W. Within Shulick there is folding and bedding contortions. Upper contact of Shulick with overlying Karen ls and Kingak at this point is well up on hillside below Kemik ss (above plotted point to E). There is a thin poorly exposed Karen Creek(?), prob. only a few ft. thick, but outcrops are poor. Karen Cr. is coarse silt - VVF ss, noncalc. dark, waxy. Then finally black shale - about 200-300 ft thick, rubble etc, mostly covered. Saw quite a few pebbles in float - this may be Kps - but pebbles may be out of overlying Kemik ss, which has a few cal zones.

sh  
samp's

sh samp's 20 A, B, & C C near base then A, and B above.

Above Kemik is some Kps and then more Kemik repeated by faulting

Molenaar & Kelley

7/14/85

85 AMK-21

NENW Sec 9-3N-27E

Mt. Michelson C-3

Small tributary along Mtn front of Kat R etc of Kemik ss, about 25' exposed ss L-VF grading up to c silt, dark gray qt & chert, muddy, small qtz pebbles noted, one cal block in float thin - med. bedded

A

Att N85E 75S overturned

A couple hundred yards upstream is Nat. dolo N40 W 57 & 30 S

No etc in between, all covered by talus

85 AMK-22

NENW Sec 9-3N-27E

Mt. Michelson C3

etc on W side of creek up on hillside. Fault contact of Inoc zone with GRZ. Beds are contorted and serrated. Fault strikes NW, near vertical. Took photo N35W GRZ BK 100 ± etc 200 ±

SLP One squirrel digging - looks like pebble sh  
Up hill to NW in next gully is etc of 15' Inoc zone base not exp overlain by sh & chert Took photo BK 75 etc 125

T/14/85 p. 2

3/2/5/2. 9/2. Sec 4

Next etc downstream on E bank. Tight anticlinal structure w/ borders of 6" thick Inoc beds. Inoc prisms replaced by higher? Is this the main Inoc zone or higher?  
Also is concentric-like syncline in hard black tuff and sh. beds

Took photos



85 AMK-23 SWSW Sec 1-3N-26E  
Mt. Michelson C-3


Tributary of Tam River just W of Kat. Canyon

75' of Shublik exposed. ~~W~~ N80E 60S. ~~A~~ overturned

Just south is PFS, fractured, mostly brush covered. Prob not complete section. Knoll on E side of creek and a little farther S is PMI then fault contact with Kat Dolo. No PMI on W side of creek.

T/14/85 p. 3

Sample 23B ← slope? sh

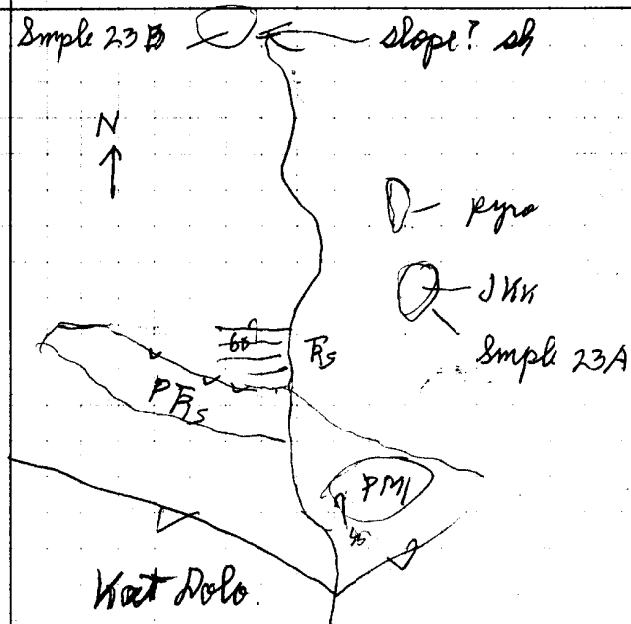

sh.   
smpl Walked along hillside E of creek, took sh sample 23A of squirrel diggings - Kingek?

A little farther <sup>north</sup> ~~south~~ on hillside is yellow w/ UK tuff float - several patches

Still farther N on W side is stly sh etc, non fossiliferous, blocky, non bent (no distinct bentonite beds) slope facies? No att - -  
sh   
smpl all rubble sh smpl 23B

7/14/85 p. 4

85AMK-24 SE Sec 2-3N-26E  
Mt Michelson C-3

Knob etc on broad ridge -- mostly  
subtle but some in place  
att E-W 35 N. (fair)


Ss, med gray, fine grain, blocky,  
qtz and well litric grains, firm, looks  
like Brookian Ss, not Saddle rock or  
Kemik

If Brookian, it must be deep water  
facies B. No bottom marks or  
bedding features, no grading.

± sample 24

7/14/85

Sta 85-14

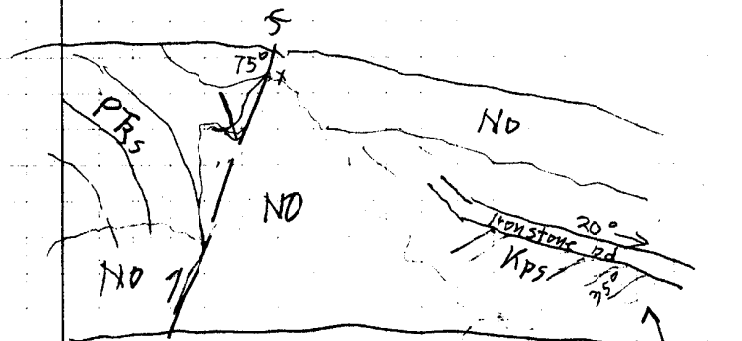

2 pics


Fracture pattern  
3 pics

Sta 85-16

Fault zone

GRZ?

near ~~that~~

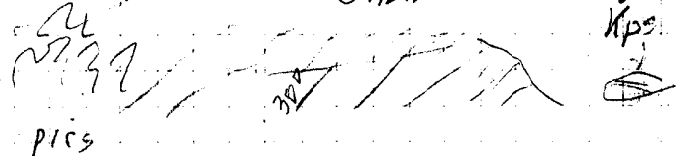

S

N photo # 32



Molenaar & Kelley

7/15/85

85 AMK-25 SWSW Sec 10-4N-2E

Mt. Michelson C-3

Landed on hilltop Brookian ls rubble  
Prob Paleocene turbs. Some in place.

Att: N70E 7-13 N

Oths are slabby to blocky 7-12" thick,  
ls LF-VF minus M, gray-brown, lentic,  
light, com black grains

Some bottom marks in finer grained float

85 AMK-26 NW SW Sec 7-4N-2E

Mt. Michelson C-3

Flattened hilltop knob of Brookian turbs -  
Paleocene - UK? TK<sub>2</sub>

Att: N75E 20 S

Took ss sample for fission track work

Molenaar and Kelley

7/17/85

85 AMK-27 NENW Sec 11-1N-24E M-35

Mt. Mich. B-4 eastern Photo 7232

Shublk Springs (southern one)  
Good flow of water abruptly comes  
out of talus-covered hillside - PFS  
from VF. - Set of facies, common  
large brinell

A few hundred ft to N on hillside are  
oth of PFS with well developed  
fractures trending N 15-25 W dipping  
87-85° E and 15° S plunge on  
fenestrated slicks. Possible sense of  
movement is right lateral.

A secondary set trends N 15 E dipping  
87° S and 15-20° S plunge on  
fenestrated slicks. Apparent left  
lateral slip based on rotated cleavage.

Another spring is 1200 ft to W in  
NWNW Sec 11 1N-24E



Since sta. 17 all outcrops dip ~~to~~ consistently to S.

83AMK-27 through 30 filed under  
Bathtub Ridge in 1980 & 1982  
field notes book.

85AMK-2B filed under Bathroom  
Ridge in 1980 & 82 field notes  
book.


MAPS TO ACCOMPANY FIELD NOTES

C.M. MOLENAAR AND PARTY

NORTH SLOPE OF ALASKA

1980, '82, '83, '84, AND '85 FIELD SEASONS

# Herschel Island, Canada 1:250,000

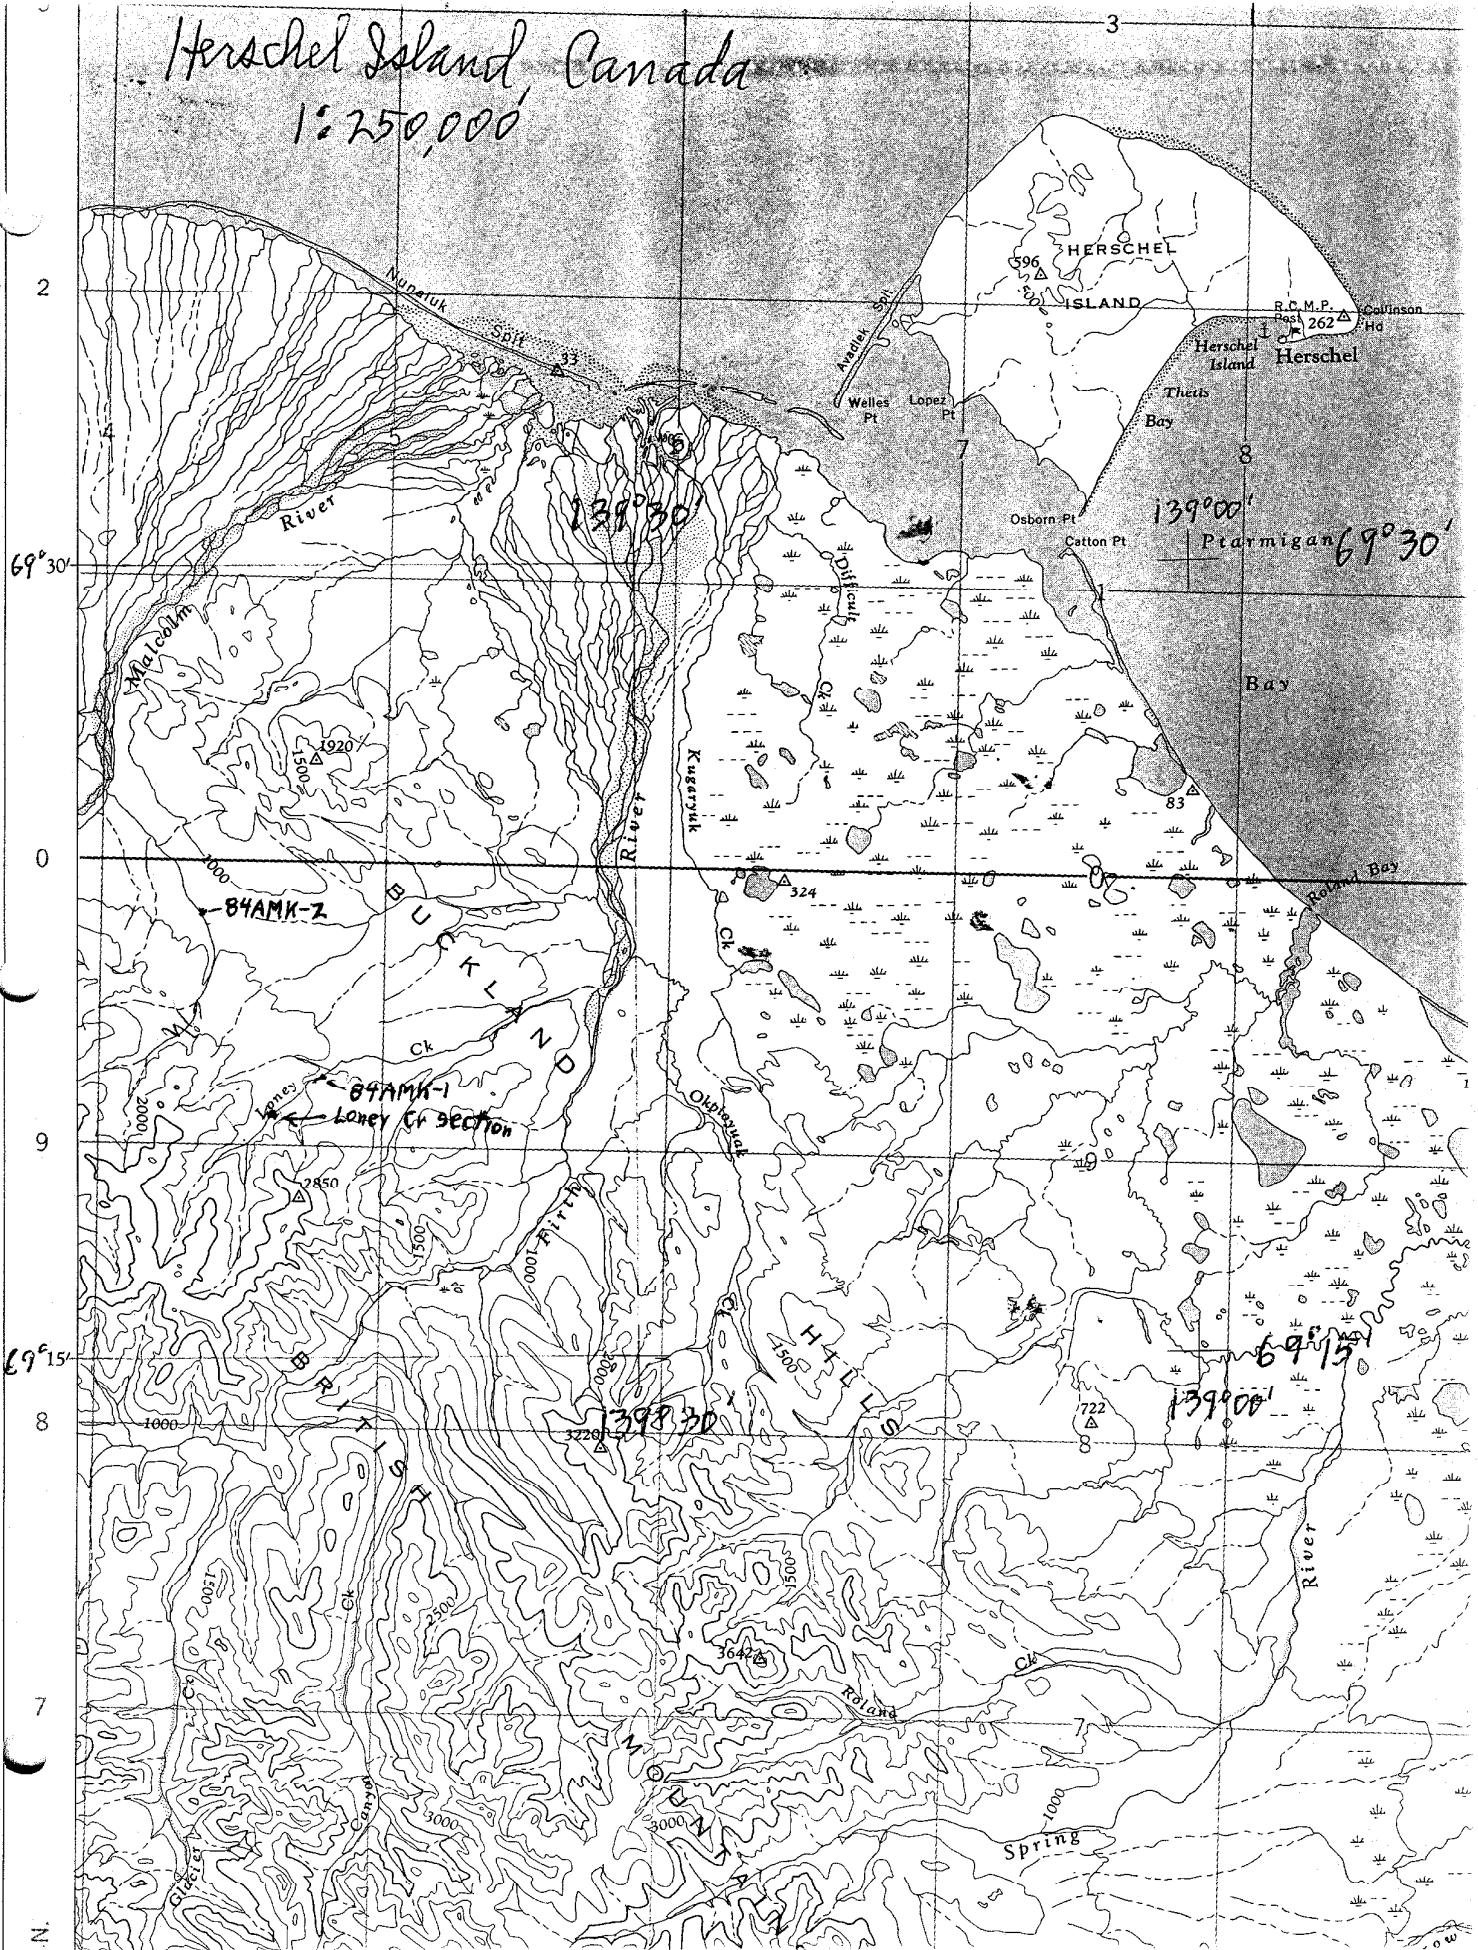

B E A U F O R T S E A

U.S.  
CANADA

1:250,000

on Point  
250,000

on Point

VABM 3

Gordon

Abaw 21

Mood

VABM 21

9

2

347

1

347

347

5

4

45'

3

2

30'

0


9

15'



ALASKA  
TOPOGRAPHIC SERIES


Table Mtn 1:250,000 NE

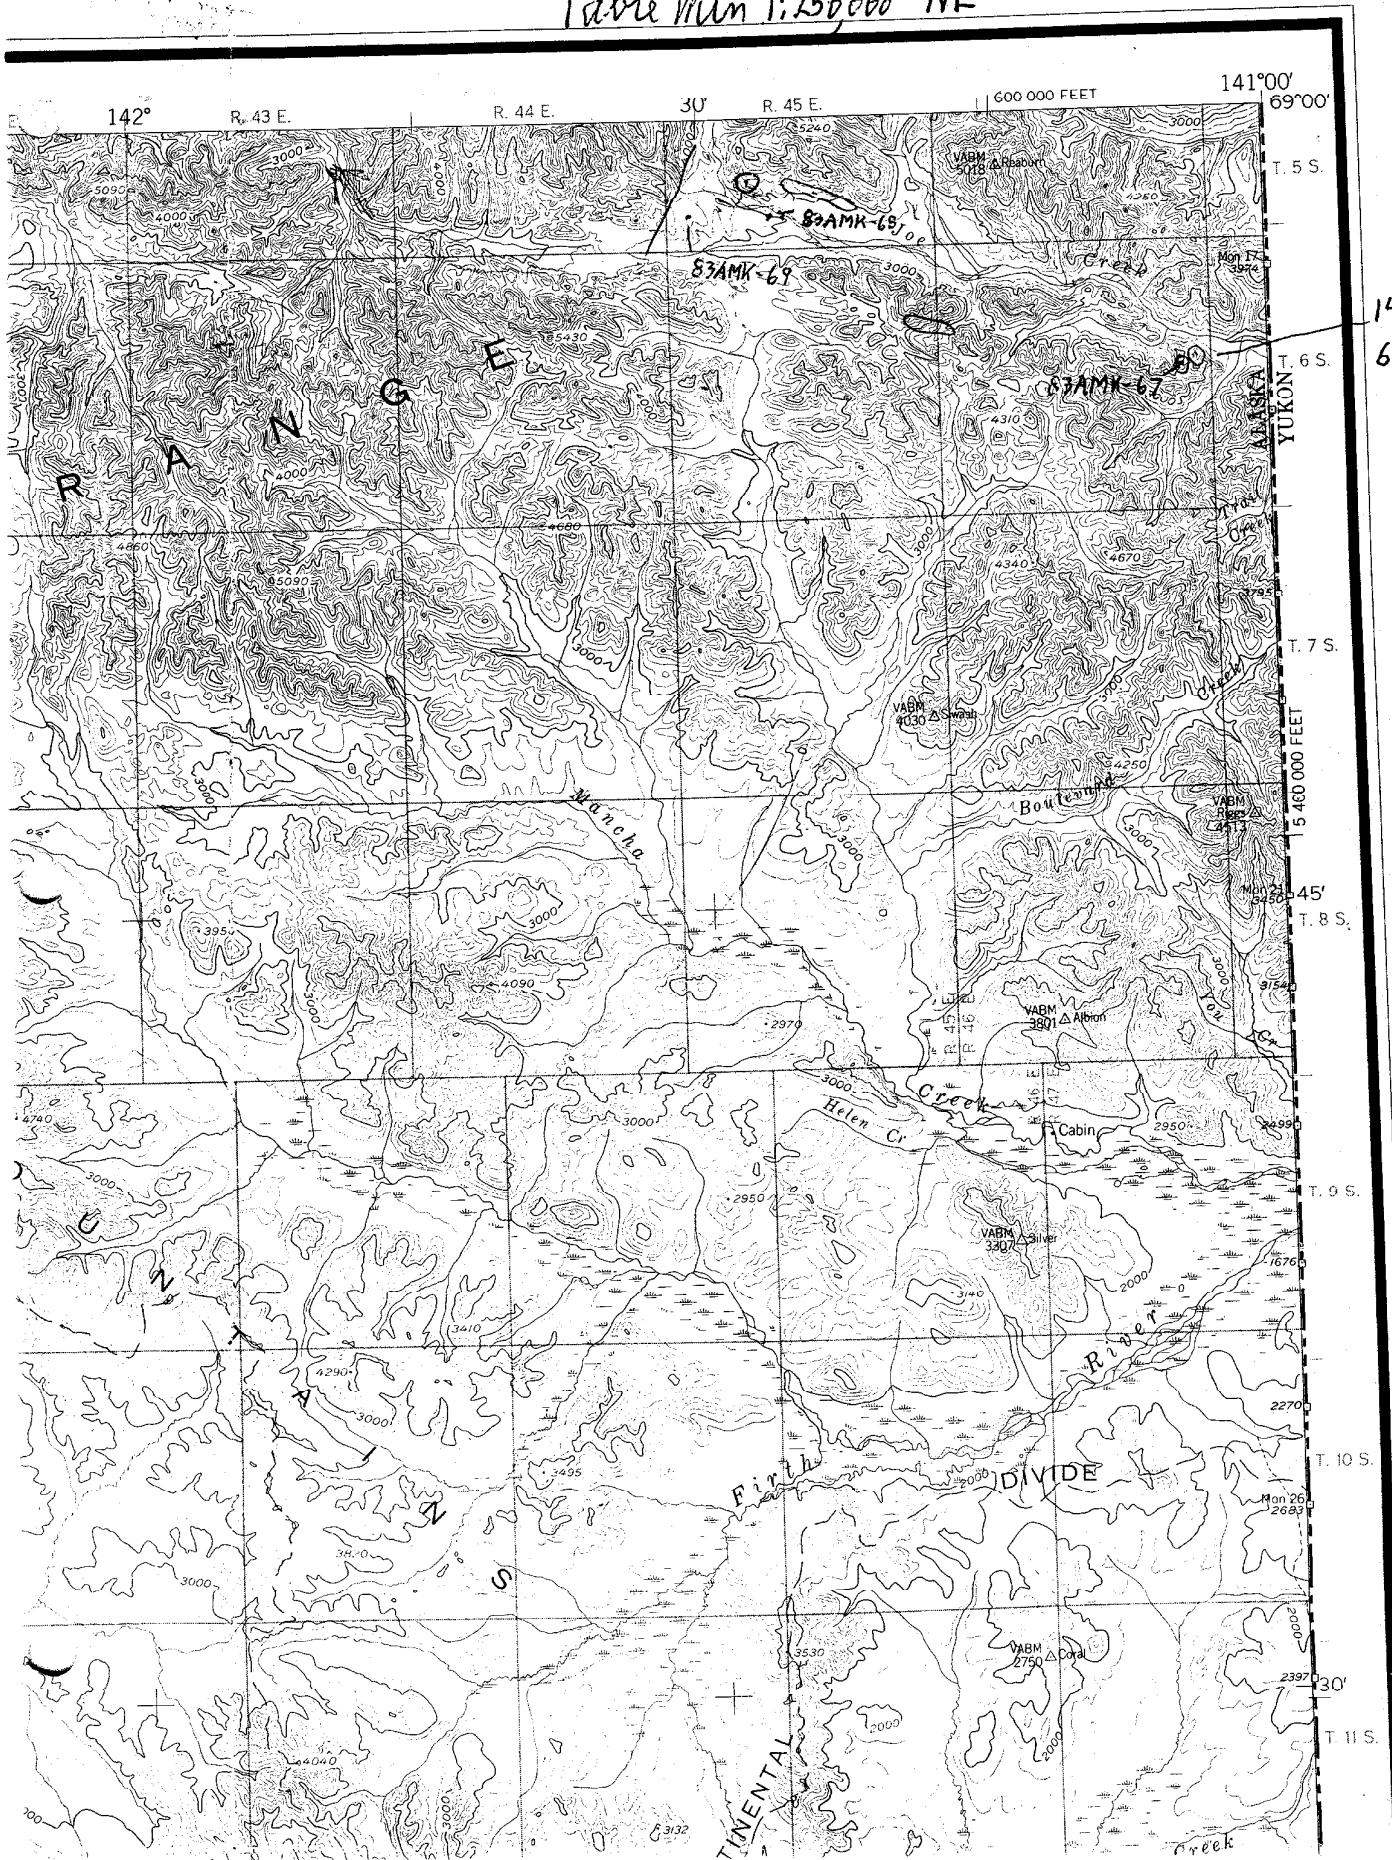

141°05'  
68°55'


UNITED STATES  
DEPARTMENT OF THE INTERIOR  
GEOLOGICAL SURVEY

Demarcation Pt. 1/250000

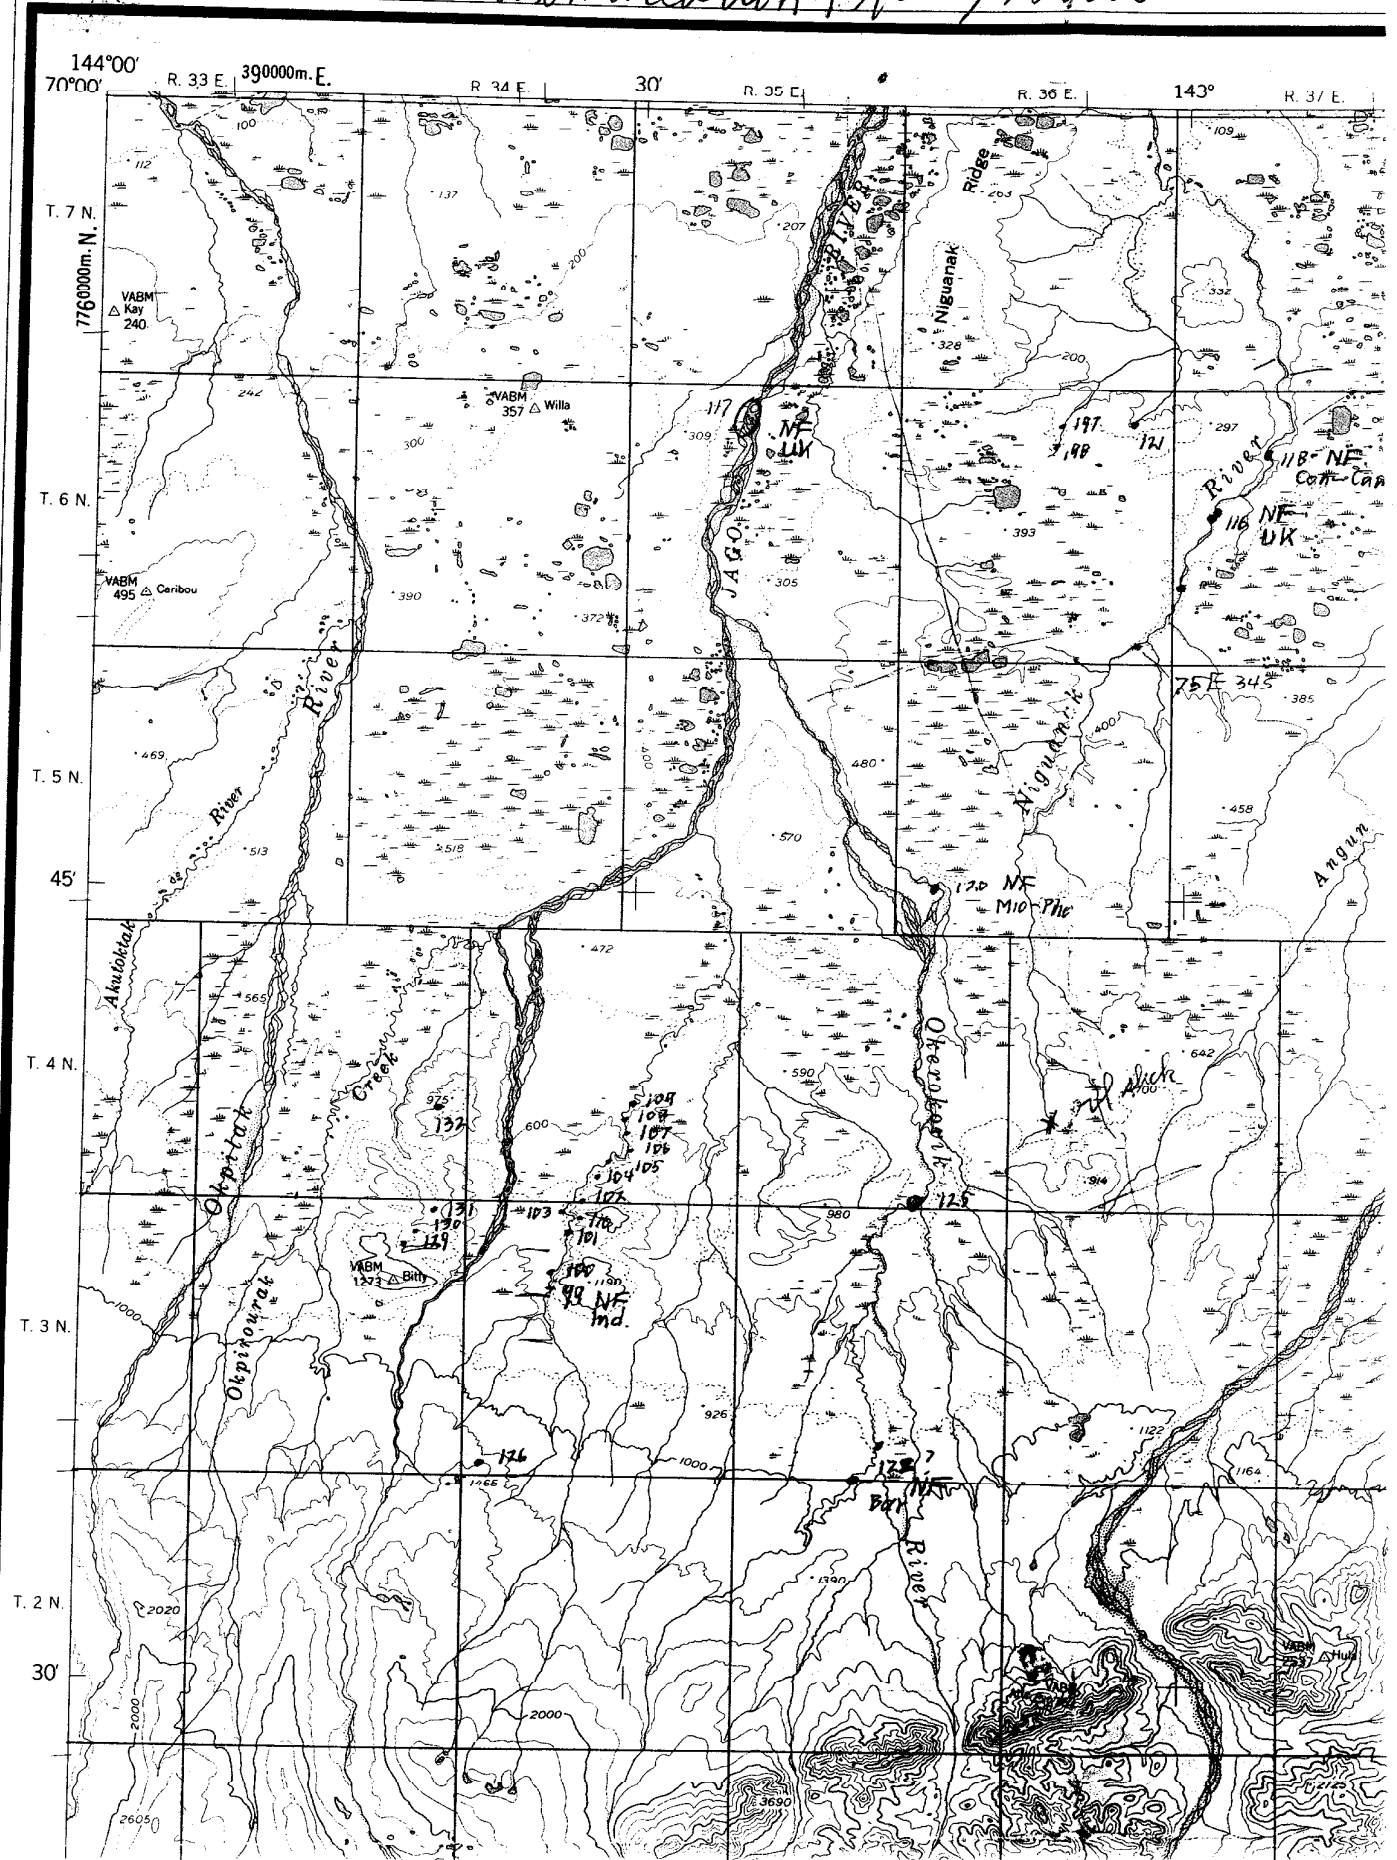

UNITED STATES  
DEPARTMENT OF THE INTERIOR  
GEOLOGICAL SURVEY

Demarcation Pt A-3 NW/4

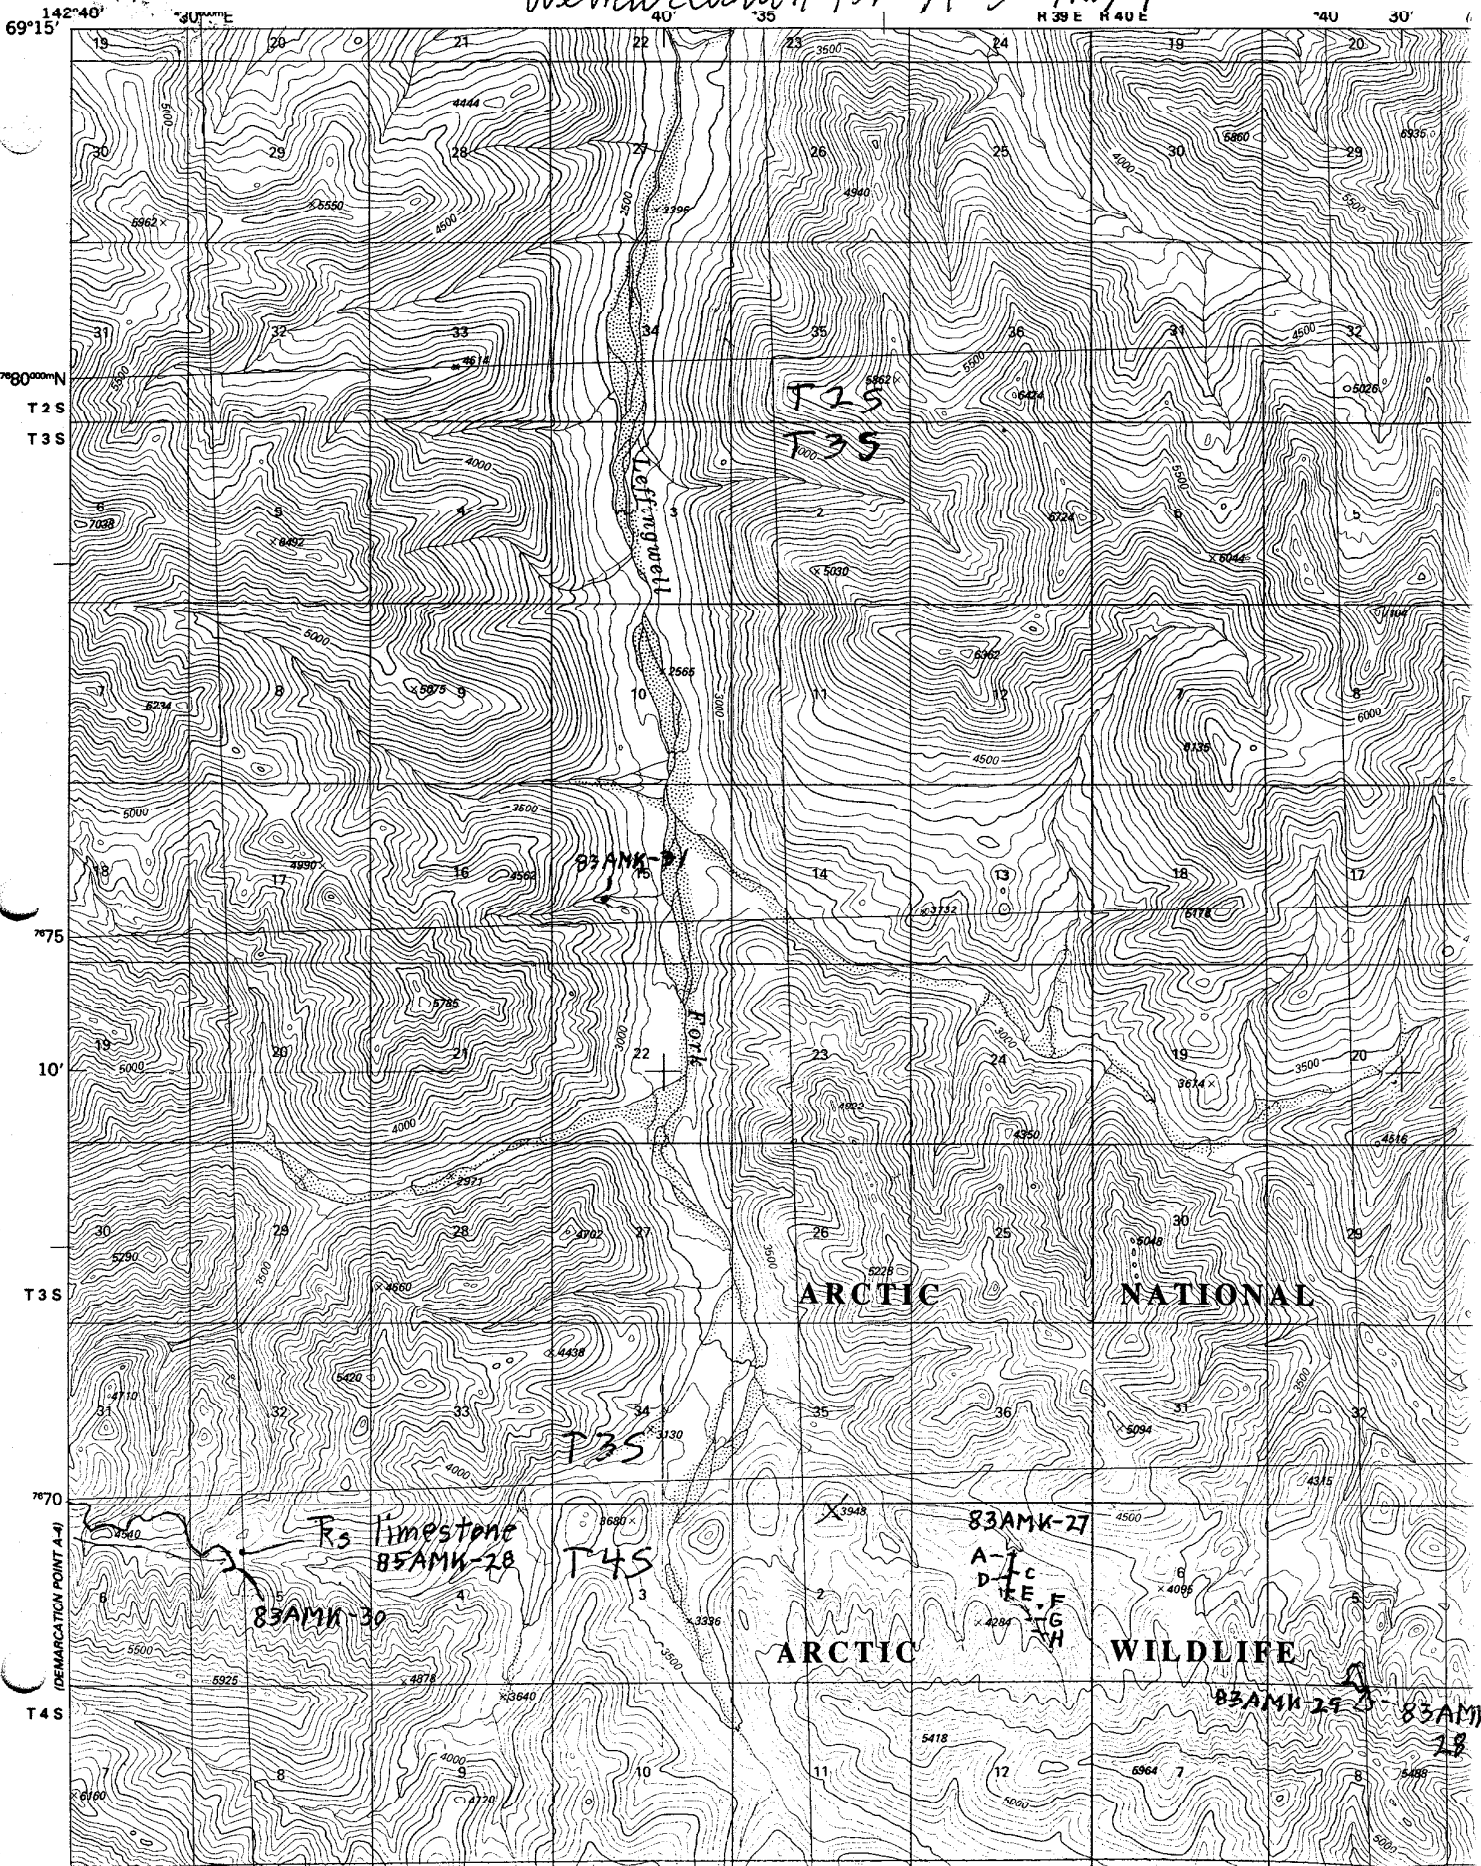



Demarcation Pt. A-3

A-3 SW/4

T3S

R3 Limestone  
85AMK-28

83AMK-30

T4S

ARCTIC

83AMK-27

A-3  
D-1  
E-1  
F-1  
G-1  
H-1

WILDLIFE

83AMK-29  
83AMK-28

BATH TUB

Drain

Creek

ROMANZOF

M

69°00'

142°48'

400 000 FEET R 39 E R 40 E

40'


35'

R 40 E 30' (TAB)


Mapped, edited, and published by the Geological Survey  
Control by USGS and NOS/NOAA  
Topography by photogrammetric methods from aerial photographs

Demarcation Pt. A-3 SW/4

SCALE 1:63361

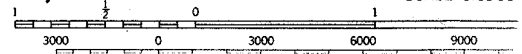

TAIN DA

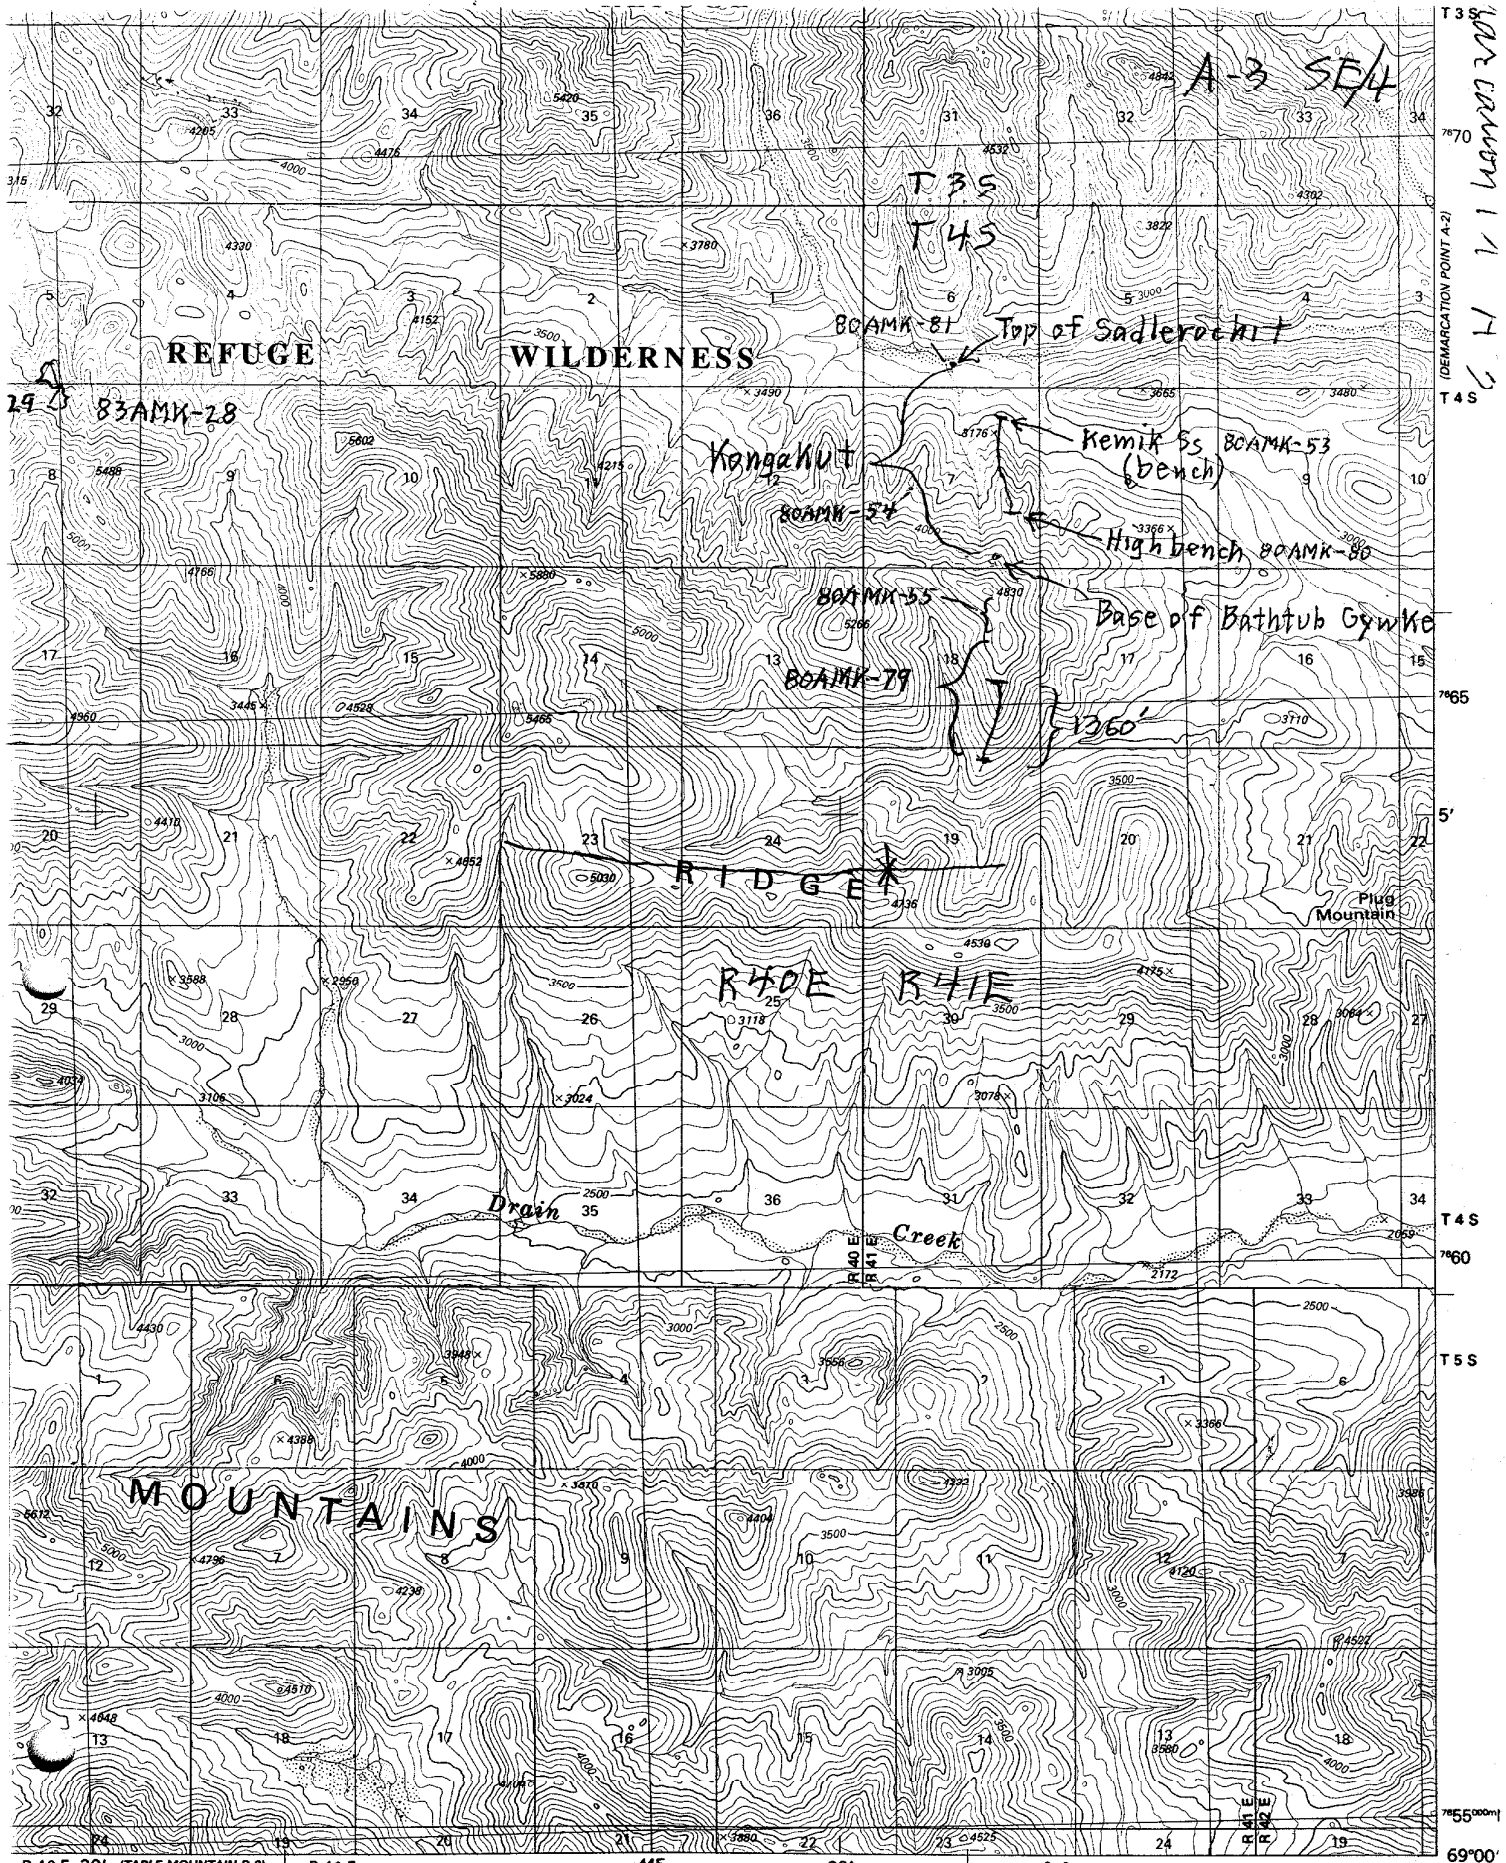

DEMARCATION POINT A-2  
 T 3 S  
 T 4 S  
 T 5 S


7670  
 7665  
 5'  
 7660  
 7655

7650  
 7645  
 7640  
 7635

R 40 E 30' (TABLE MOUNTAIN D-3) R 41 E  
 SCALE 1:63360  
 0 2 3 4 MILES  
 9000 12000 15000 18000 21000 FEET

145 20' 150000  
 69°00'  
 142°12'  
 DEMARCATION PT. A-3 SE/4  
 (TABLE)

ROAD CLASSIFICATION

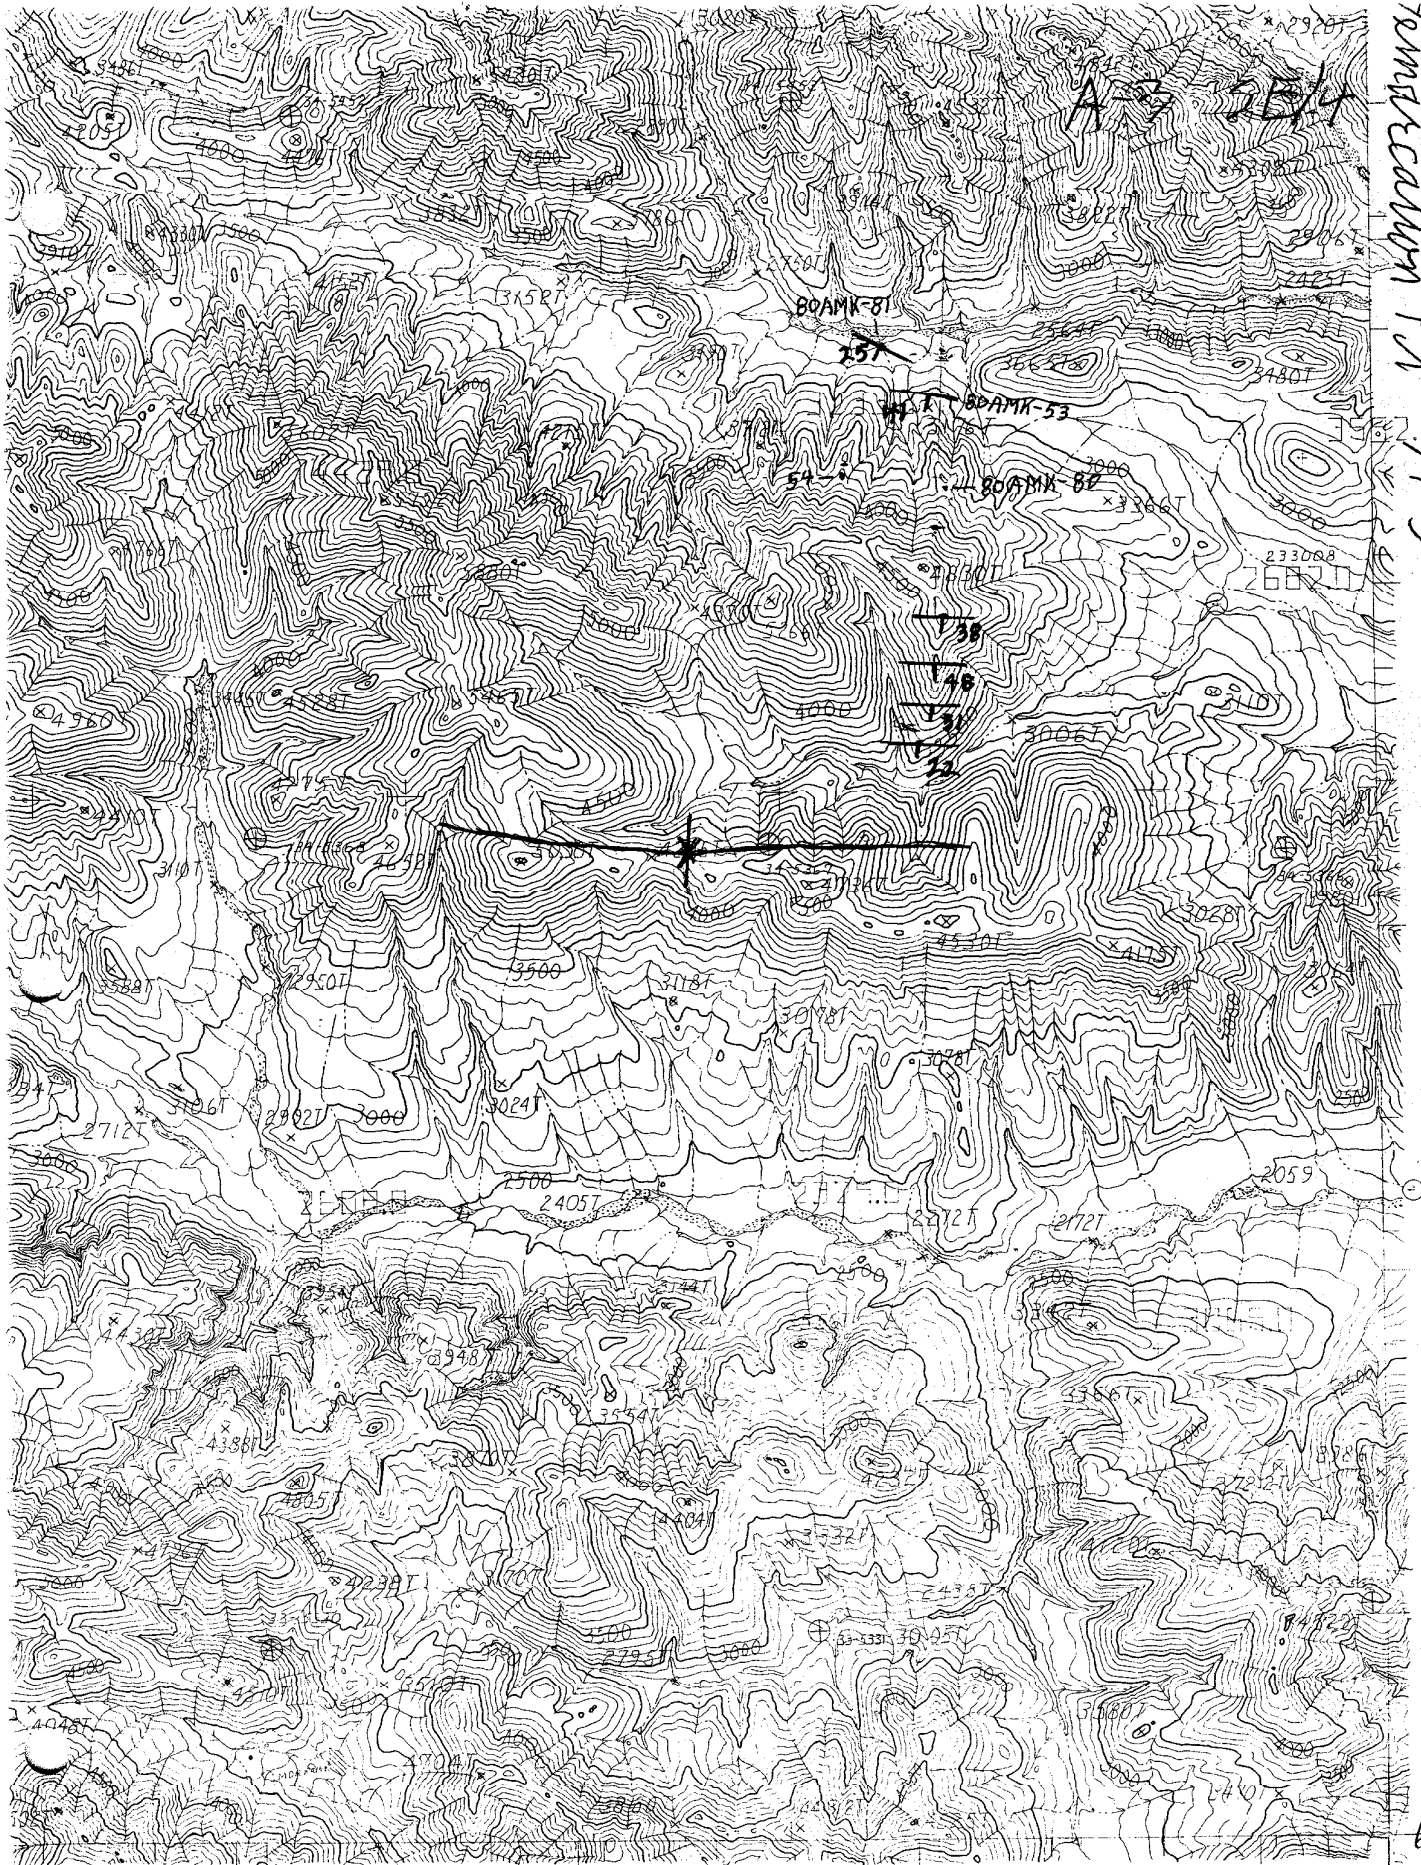

Demarcation Pt A-3

A-3 SE/4

69°01'


Demarcation Pt A-3 SE/4

45200 FE  
147°12'

*Memarc B-4*

UNITED STATES  
DEPARTMENT OF THE INTERIOR  
GEOLOGICAL SURVEY

*Demarcation Pt. B-4 NW/4*

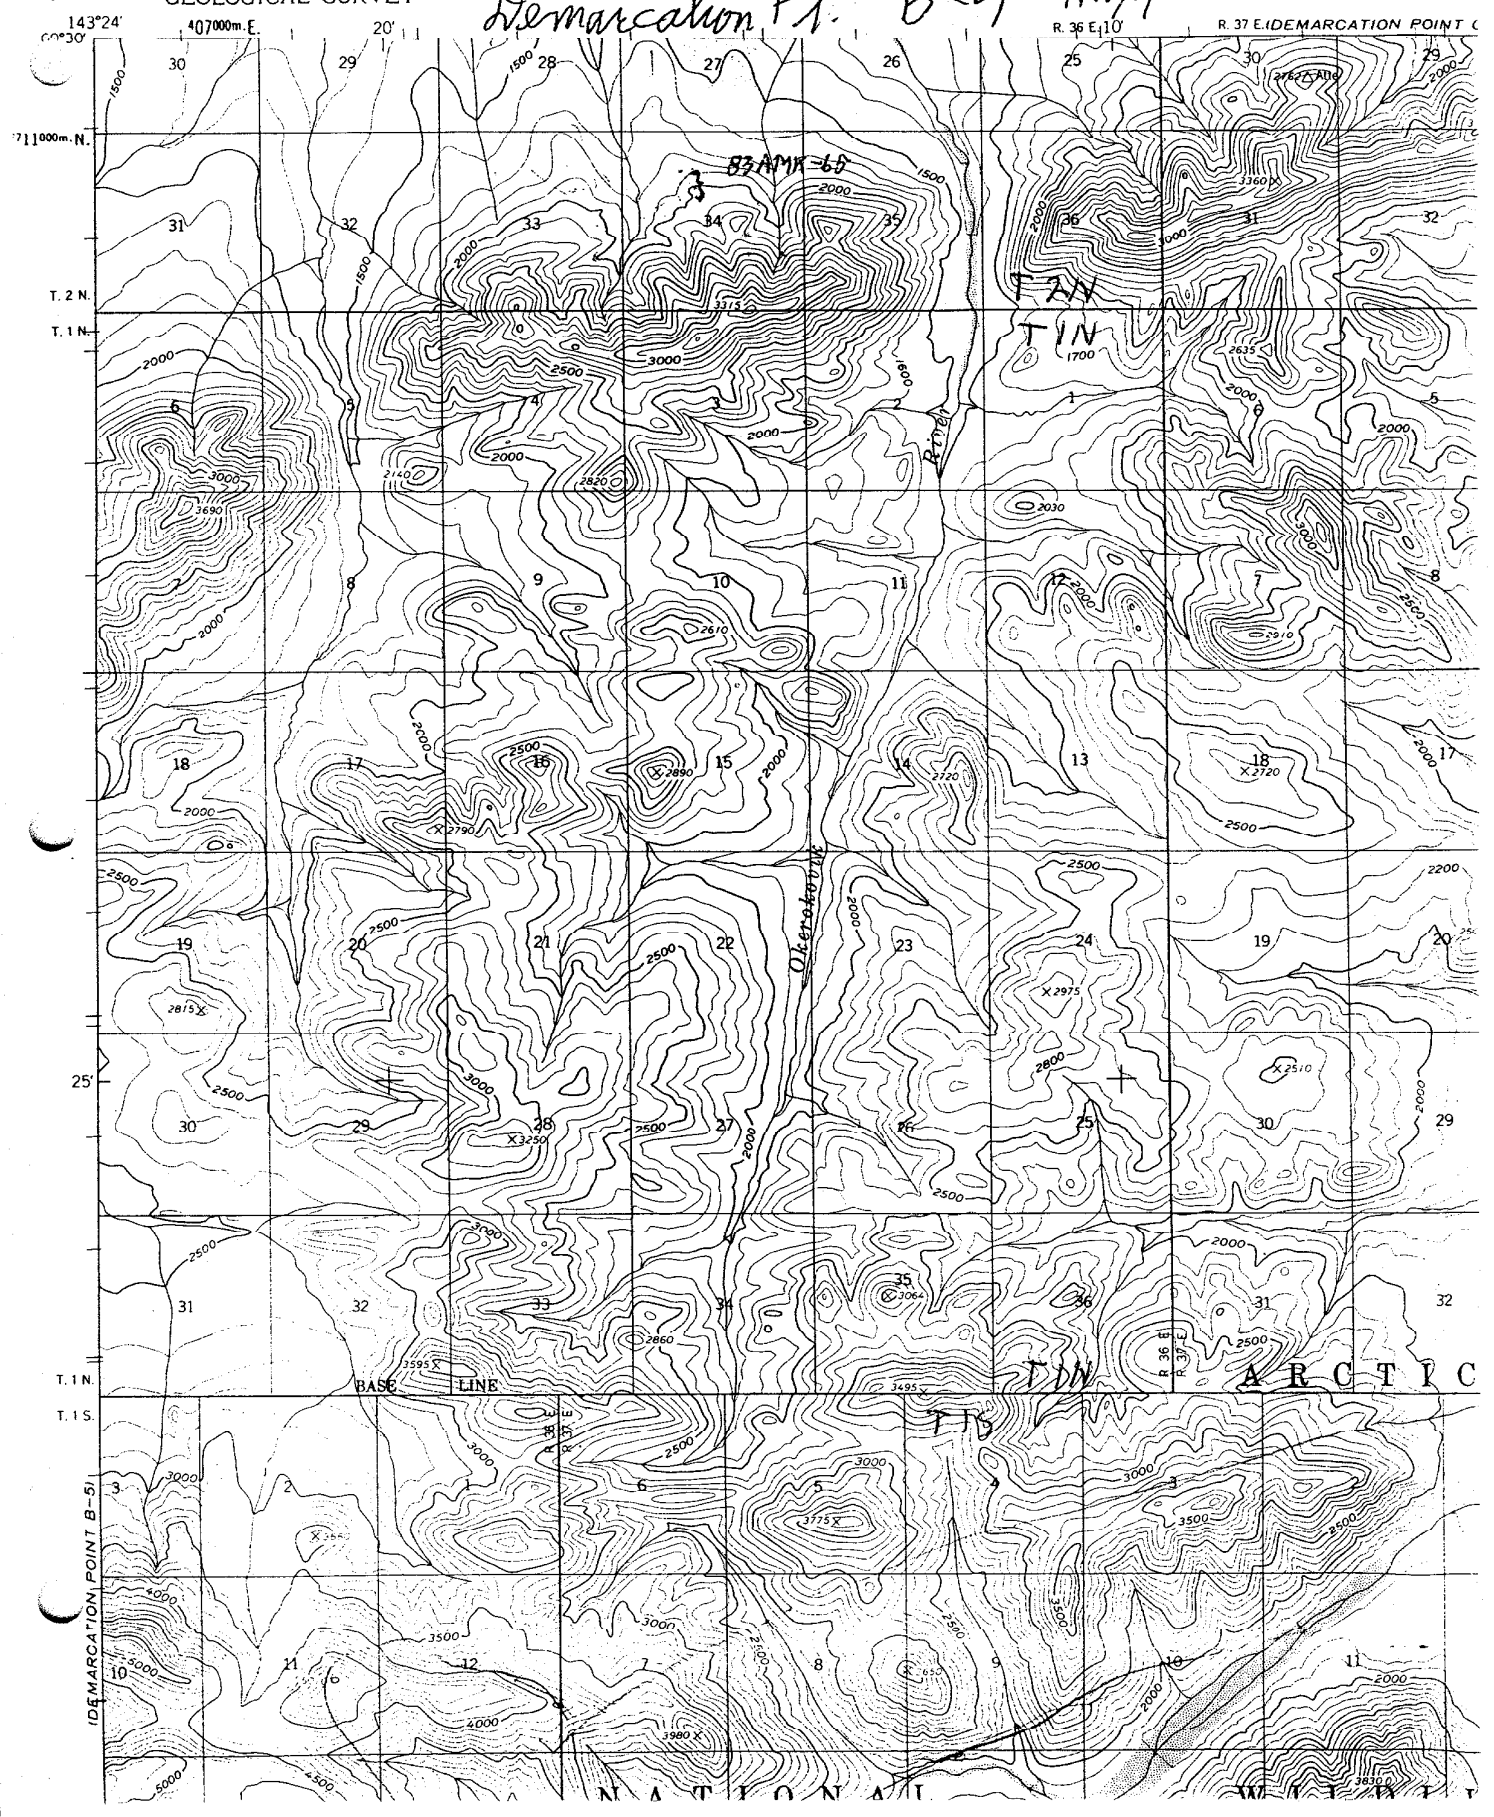

DEMARCATION POINT (B-4) QUADRANGLE


ALASKA

1:63 360 SERIES (TOPOGRAPHIC)

B-4


NE/4


DEMARCATIC

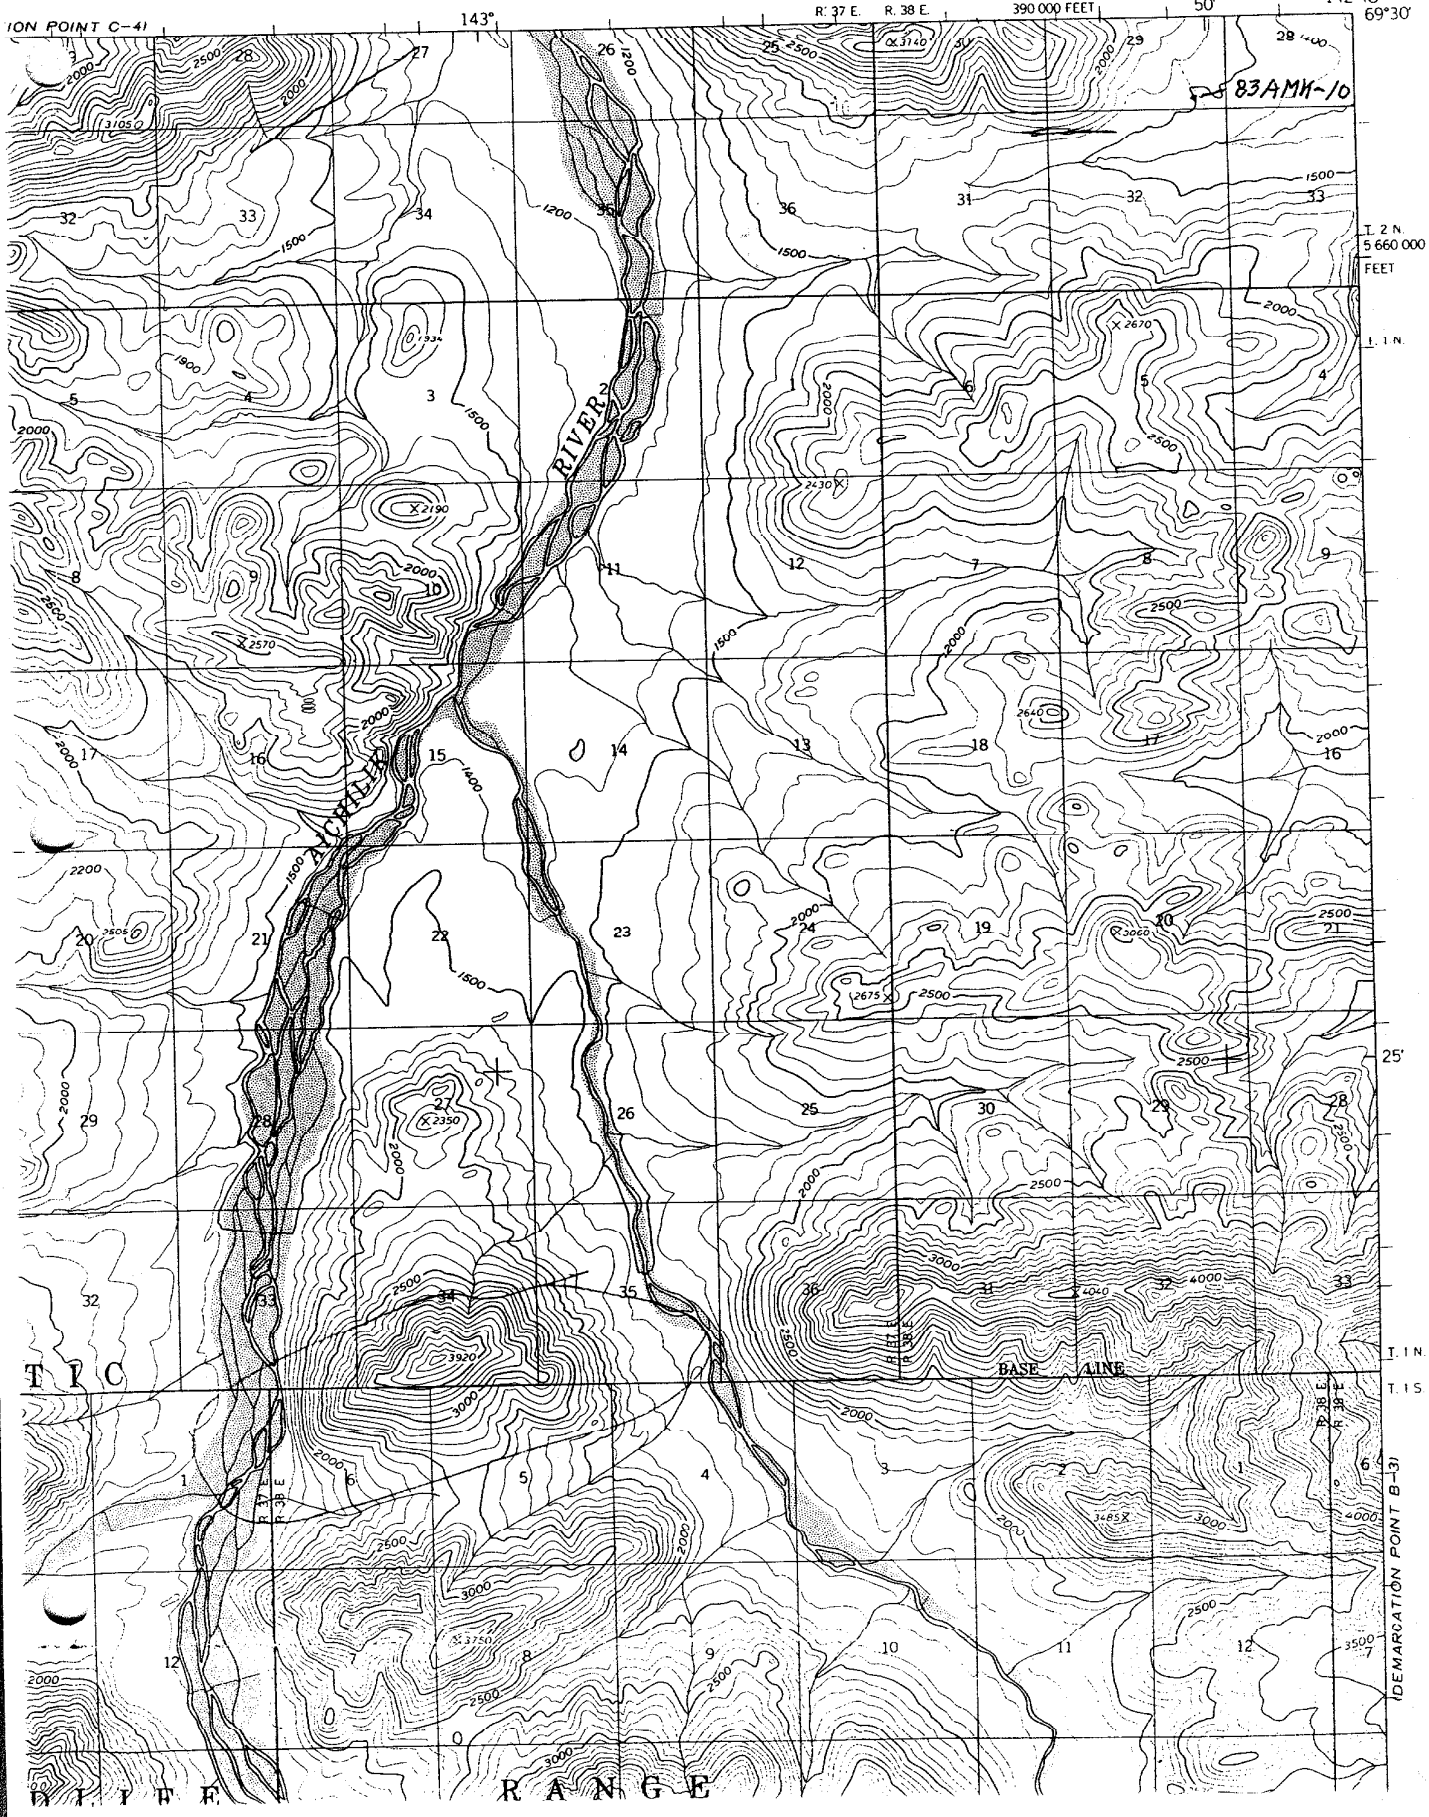

UNITED STATES  
DEPARTMENT OF THE INTERIOR  
GEOLOGICAL SURVEY

Demarcation Pt. B-5 NW/4


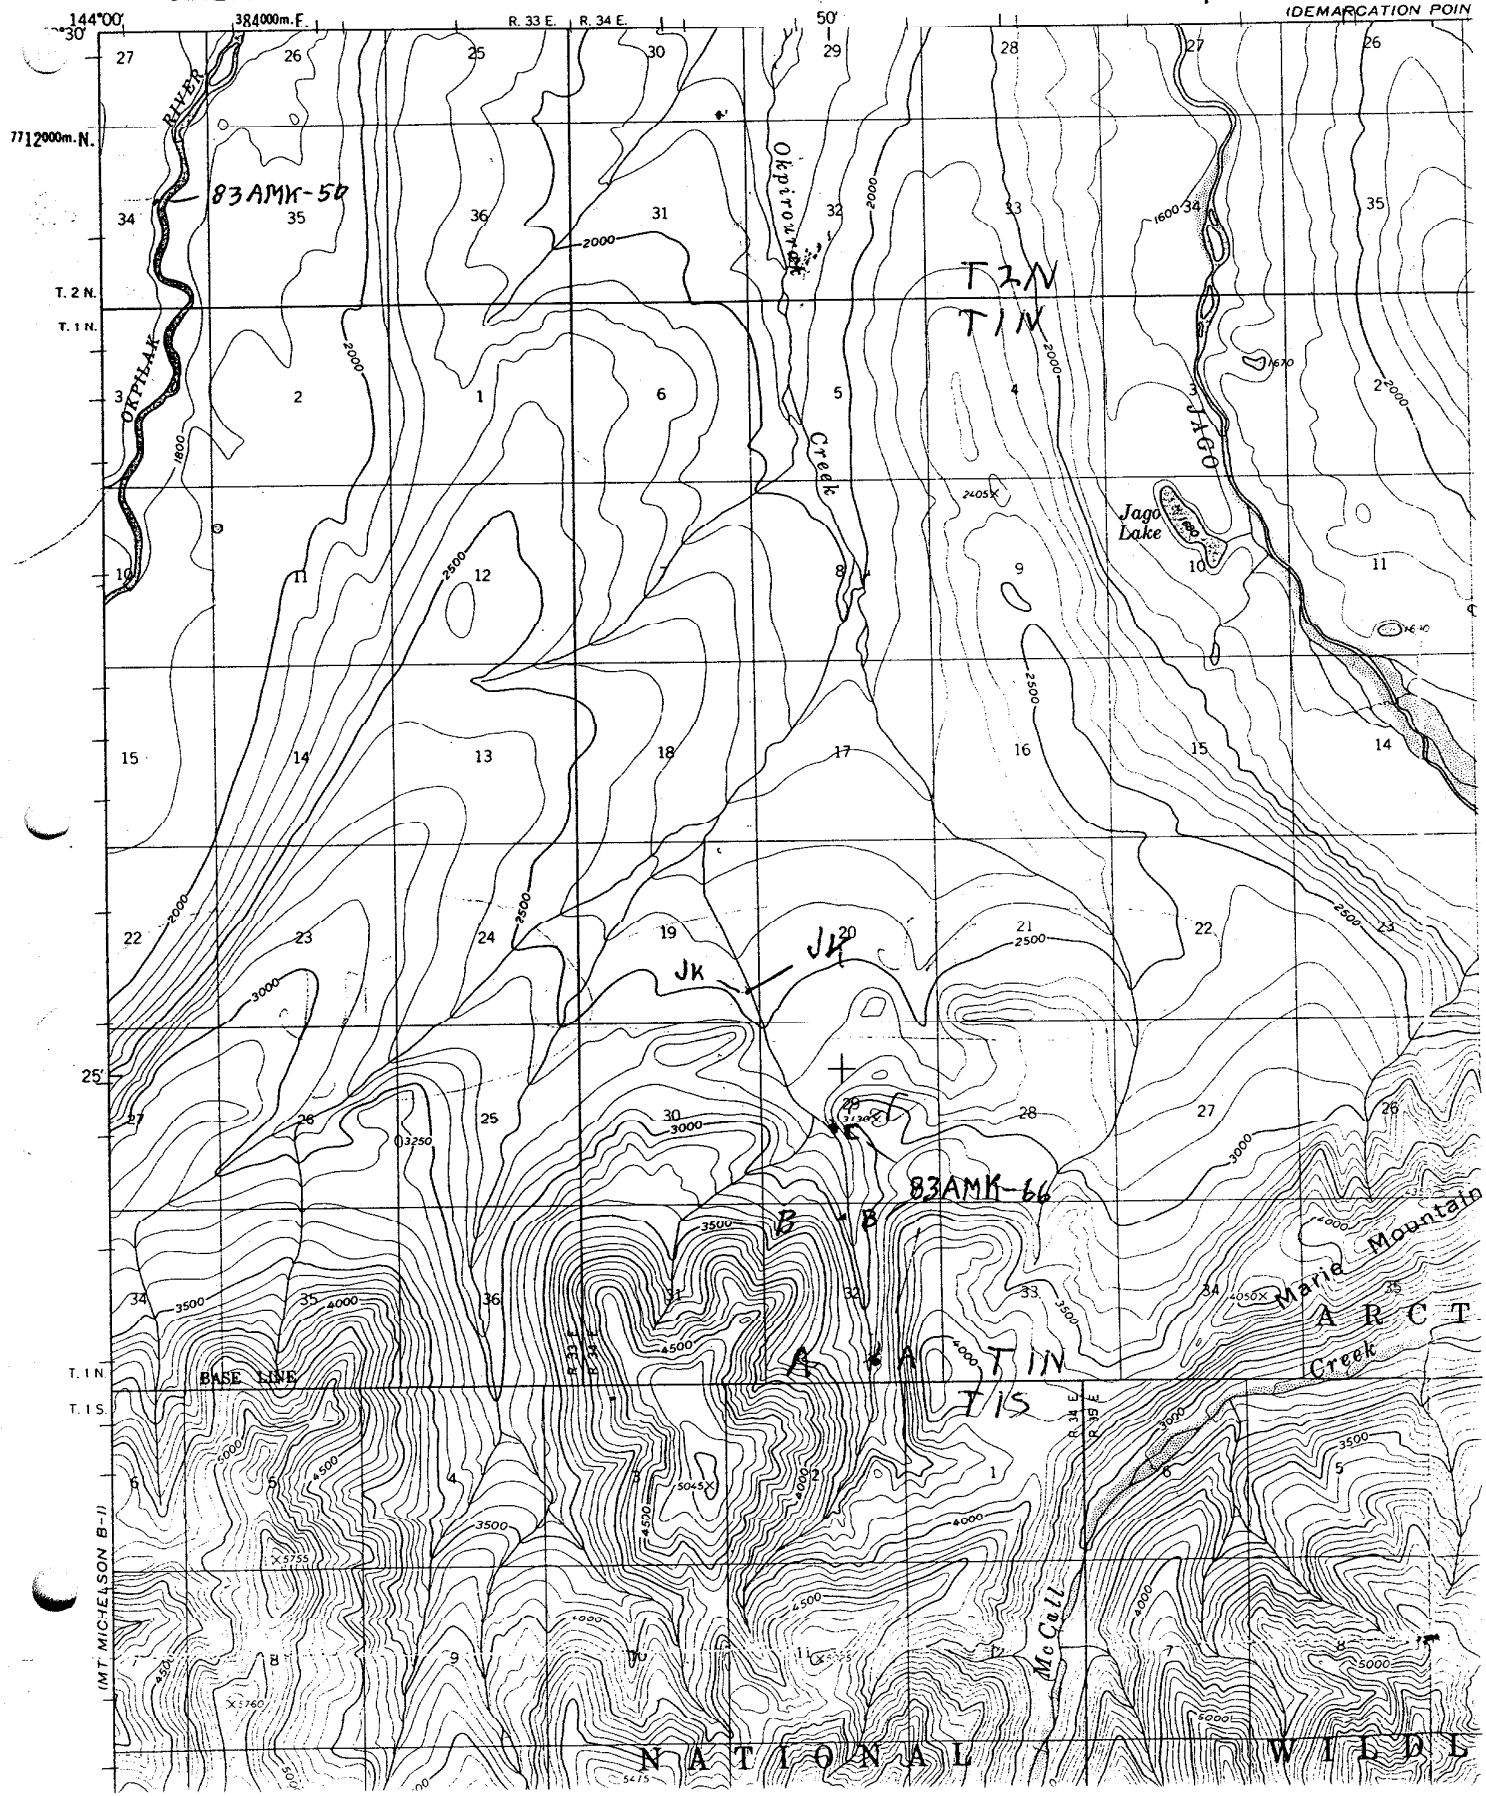


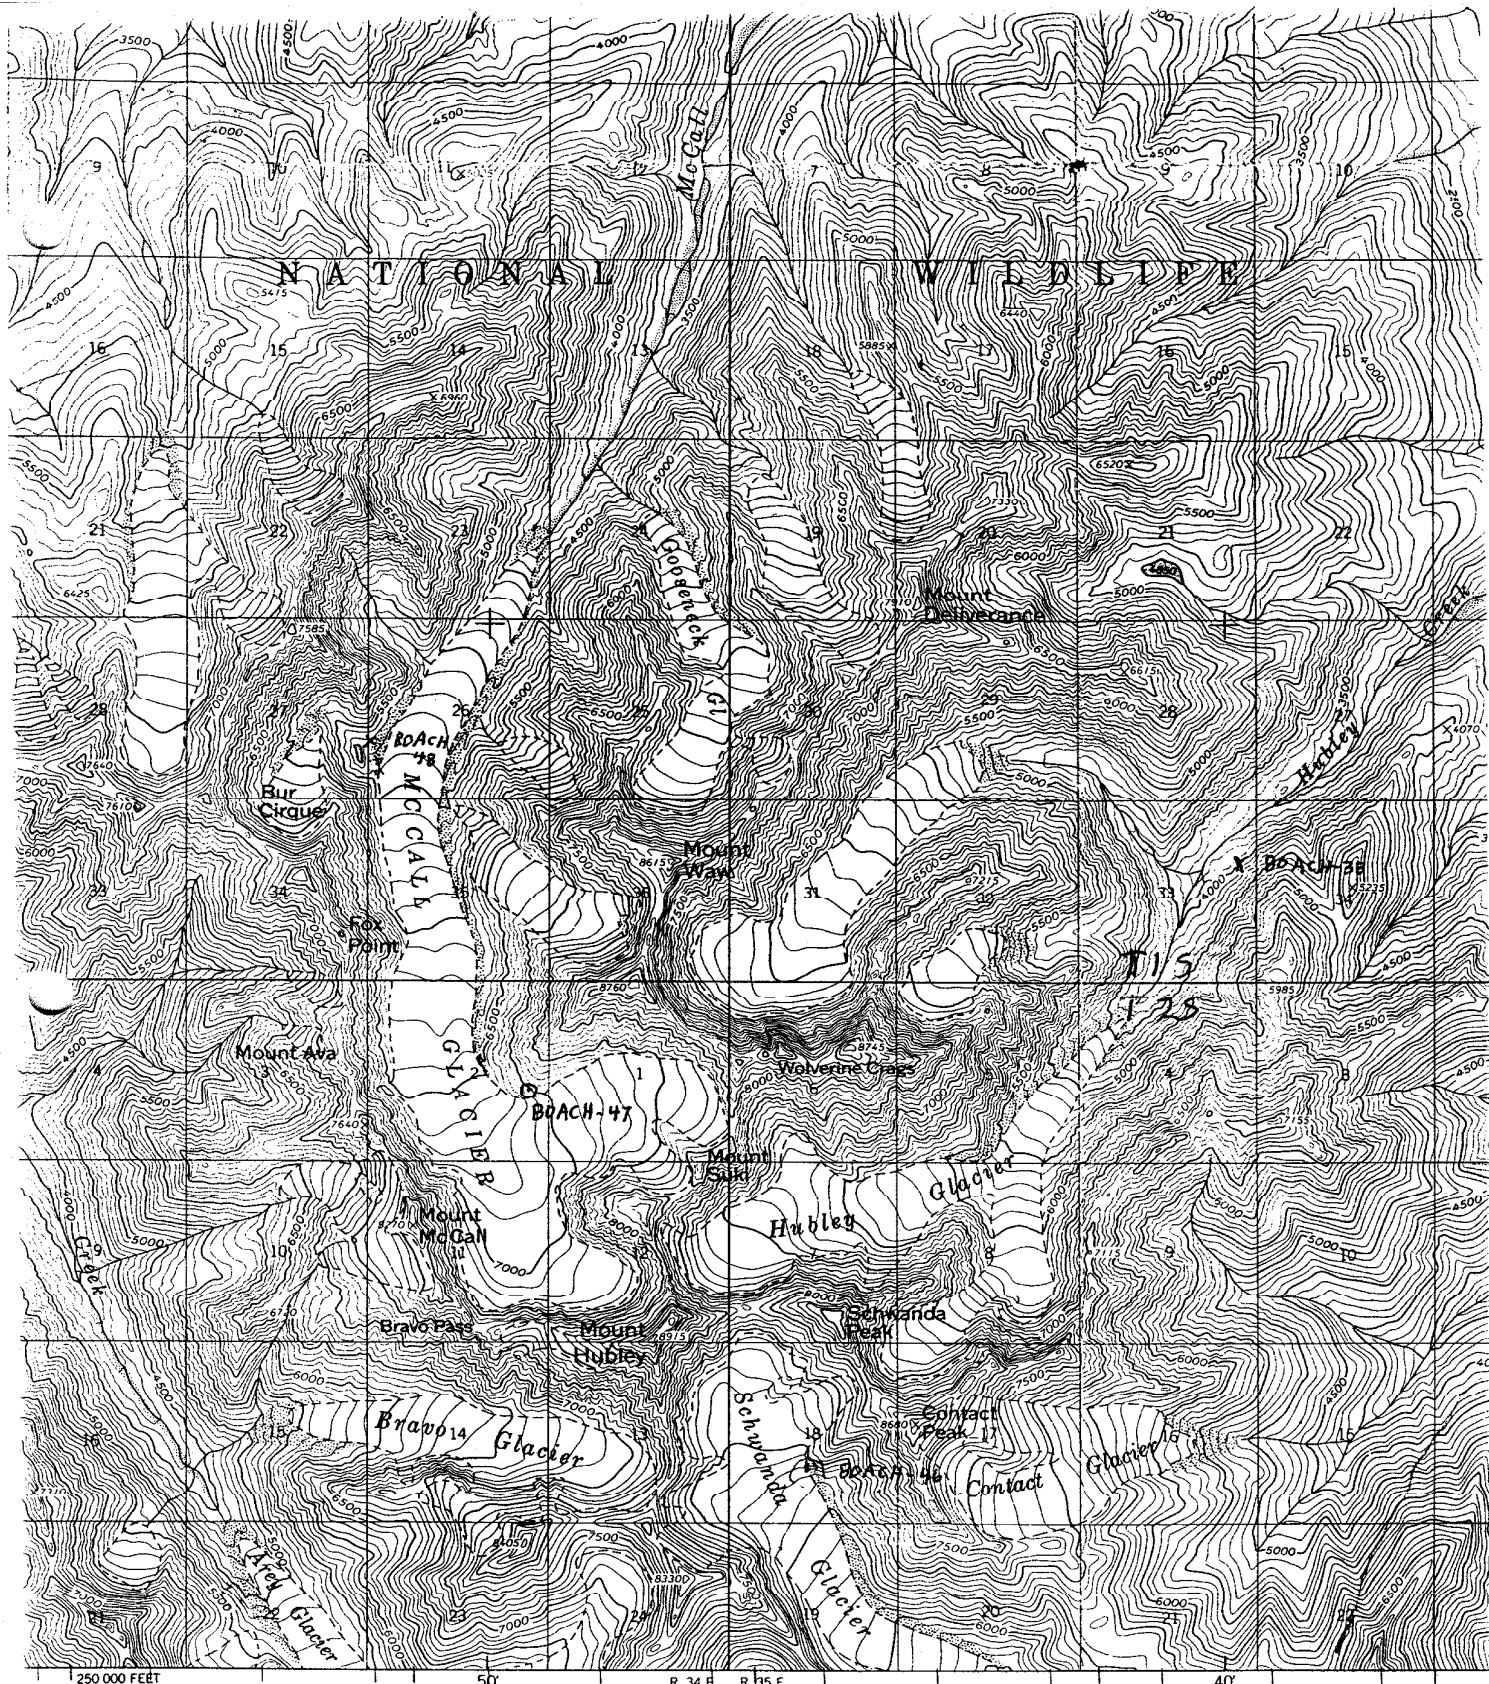

the Geological Survey

Aerial photographs  
 field checked  
 1. 1927 North American datum  
 date system, zone 2  
 for grid ticks,


marked locations  
 anagement

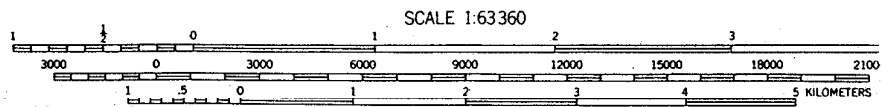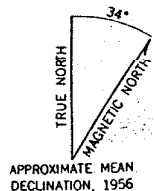

CONTOUR INTERVAL 100 FEET  
 DATUM IS MEAN SEA LEVEL



*Demarcation Pt B-5 SW/4 +*

FOR SALE BY U. S. GEOLOGICAL SURVEY  
 FAIRBANKS, ALASKA 99701. DENVER, COLORADO 80225 OR WASHINGTON, D. C. 20242

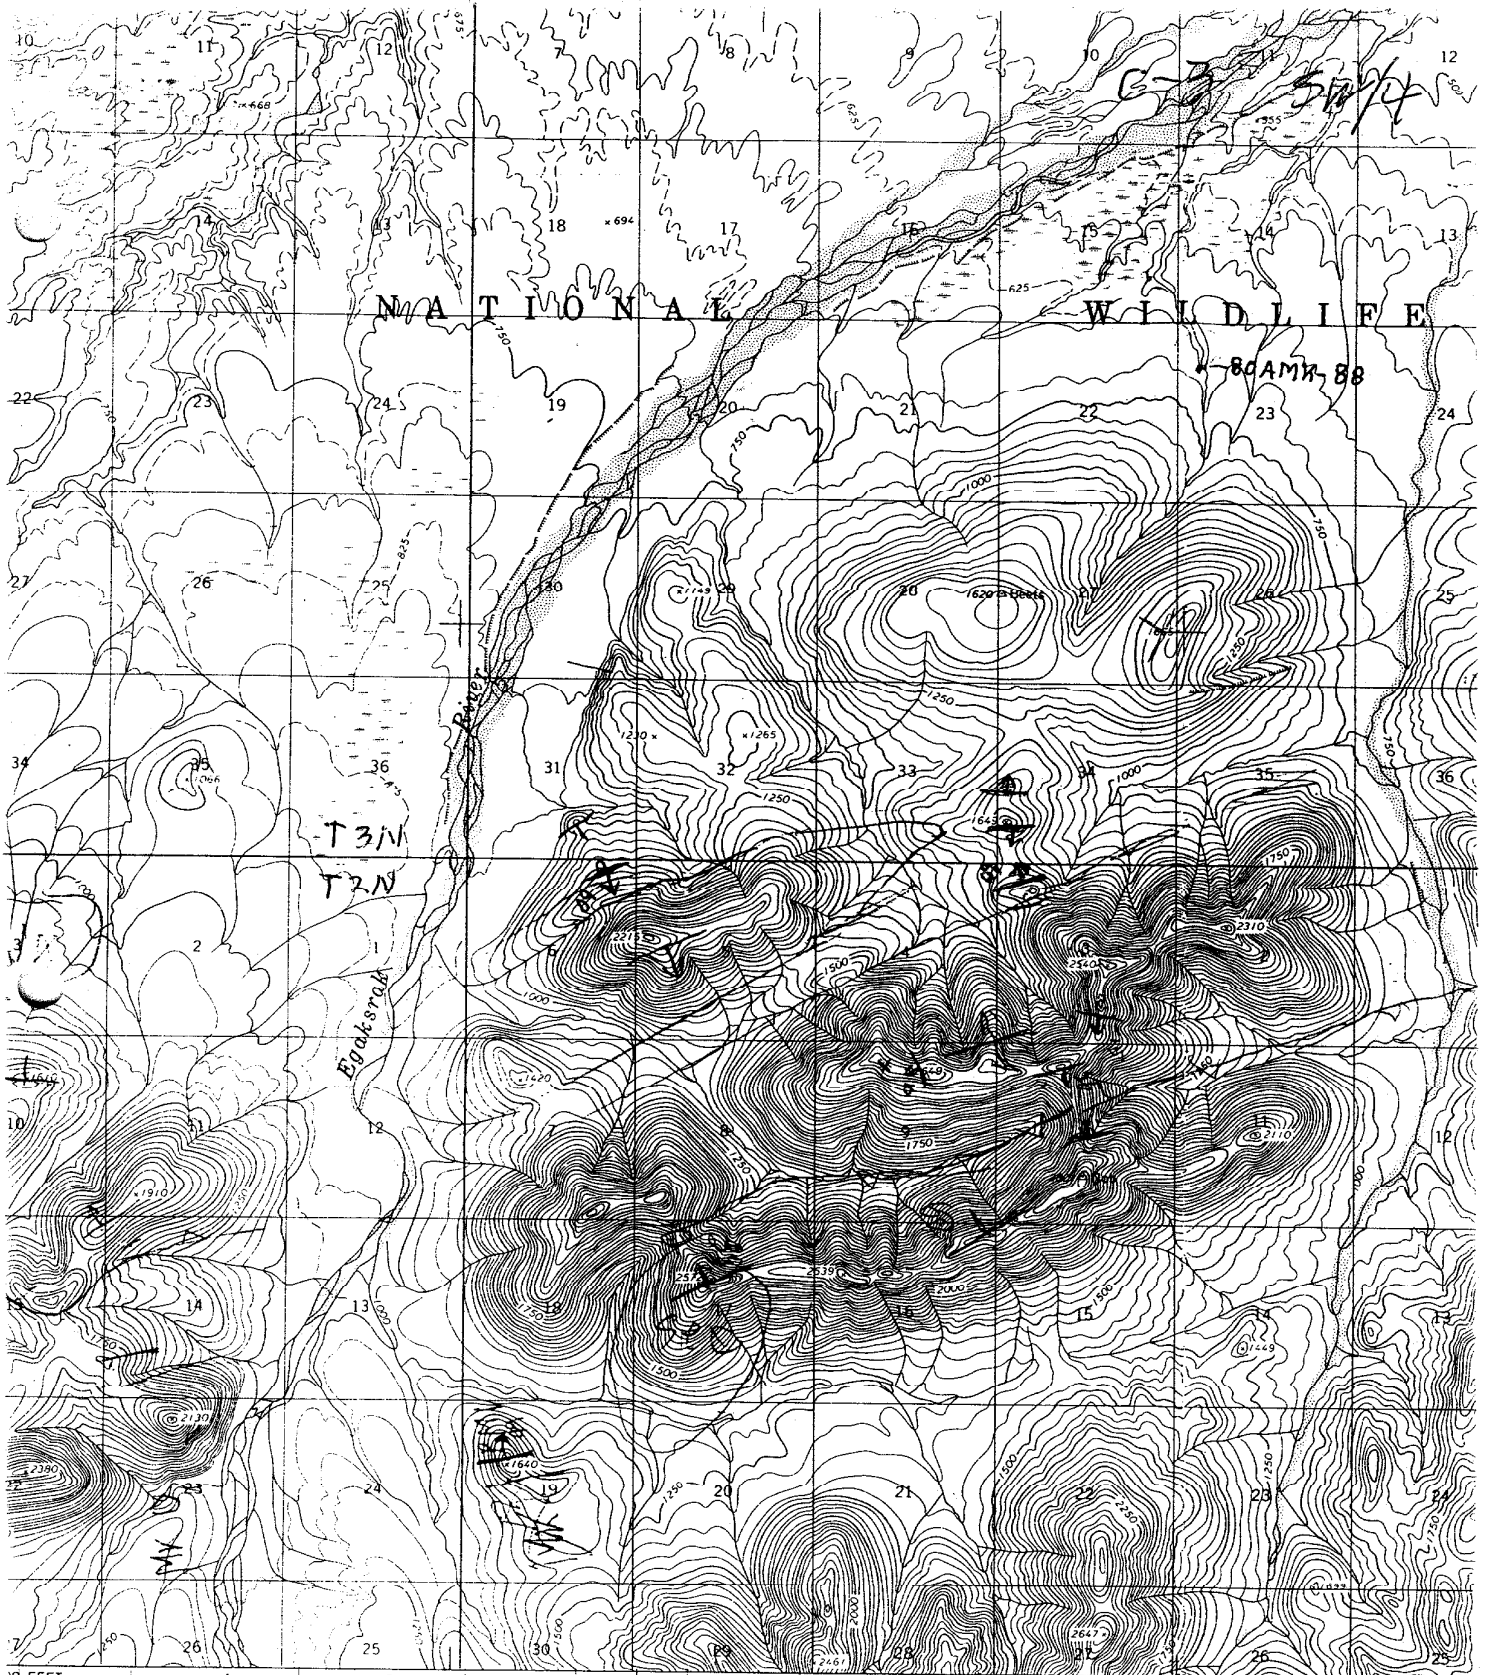

10 FEET R 38 F 40" R 39 F 30' (DEMARCATION POINT B-3)


Army Map Service  
 provided by the Geological Survey  
 Photogrammetric methods from aerial photographs  
 annotated 1955. Map not field checked  
 uses Transverse Mercator projection. 1927 North American datum  
 based on Alaska coordinate system, zone 2  
 shows 2-foot Transverse Mercator grid ticks,  
 but unsurveyed and unmarked locations  
 are the Bureau of Land Management

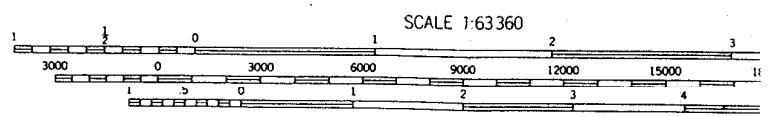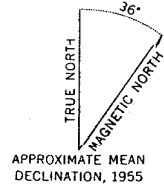

CONTOUR INTERVAL 50 FEET  
 DASHED LINES REPRESENT 25-FOOT CONTOURS  
 DATUM IS MEAN SEA LEVEL  
*Demarcation Point C-3 SW/4*

FOR SALE BY U. S. GEOLOGICAL SURVEY



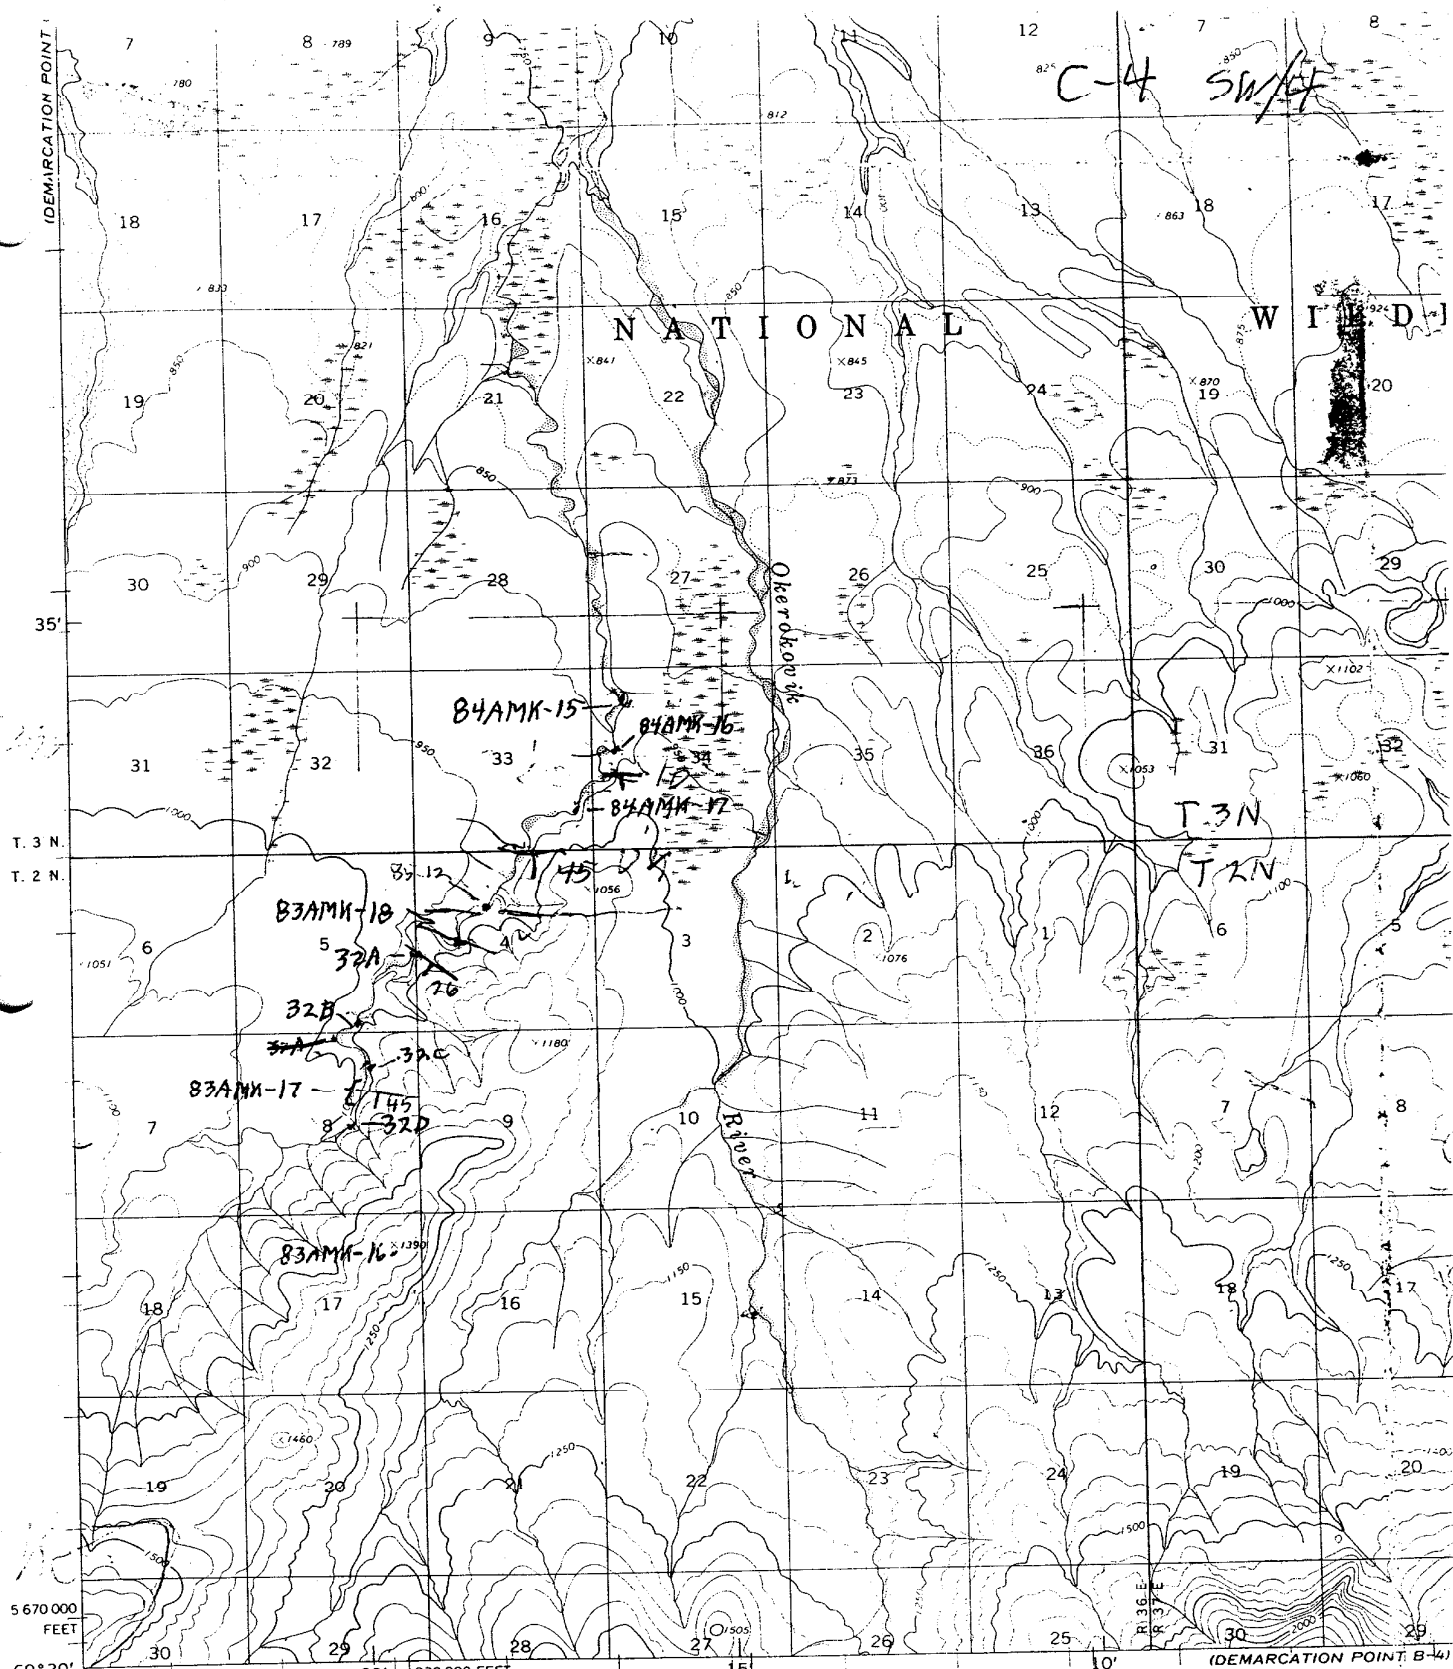

Mapped by the Army Map Service  
 Edited and published by the Geological Survey  
 Control by USC&GS and USCE


Topography by photogrammetric methods from aerial photographs  
 taken 1955, field annotated 1955. Map not field checked

Universal Transverse Mercator projection. 1927 North American datum  
 10,000-foot grid based on Alaska coordinate system, zone 2  
 1000-meter Universal Transverse Mercator grid ticks,  
 zone 7, shown in blue

Land lines represent unsurveyed and unmarked locations  
 predetermined by the Bureau of Land Management


TRUE NORTH  
 35°  
 MAGNETIC NORTH  
 APPROXIMATE MEAN  
 DECLINATION, 1955

Demarcation Pt. C-4  
 SW/4

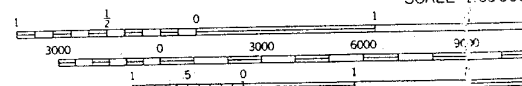


CONTOUR INTERVAL  
 DOTTED LINES REPRESENT 25-F  
 DATUM IS MEAN SEA L

FOR SALE BY U. S. GEOLOGICAL SURVEY  
 FAIRBANKS, ALASKA 99701, DENVER, COLORADO

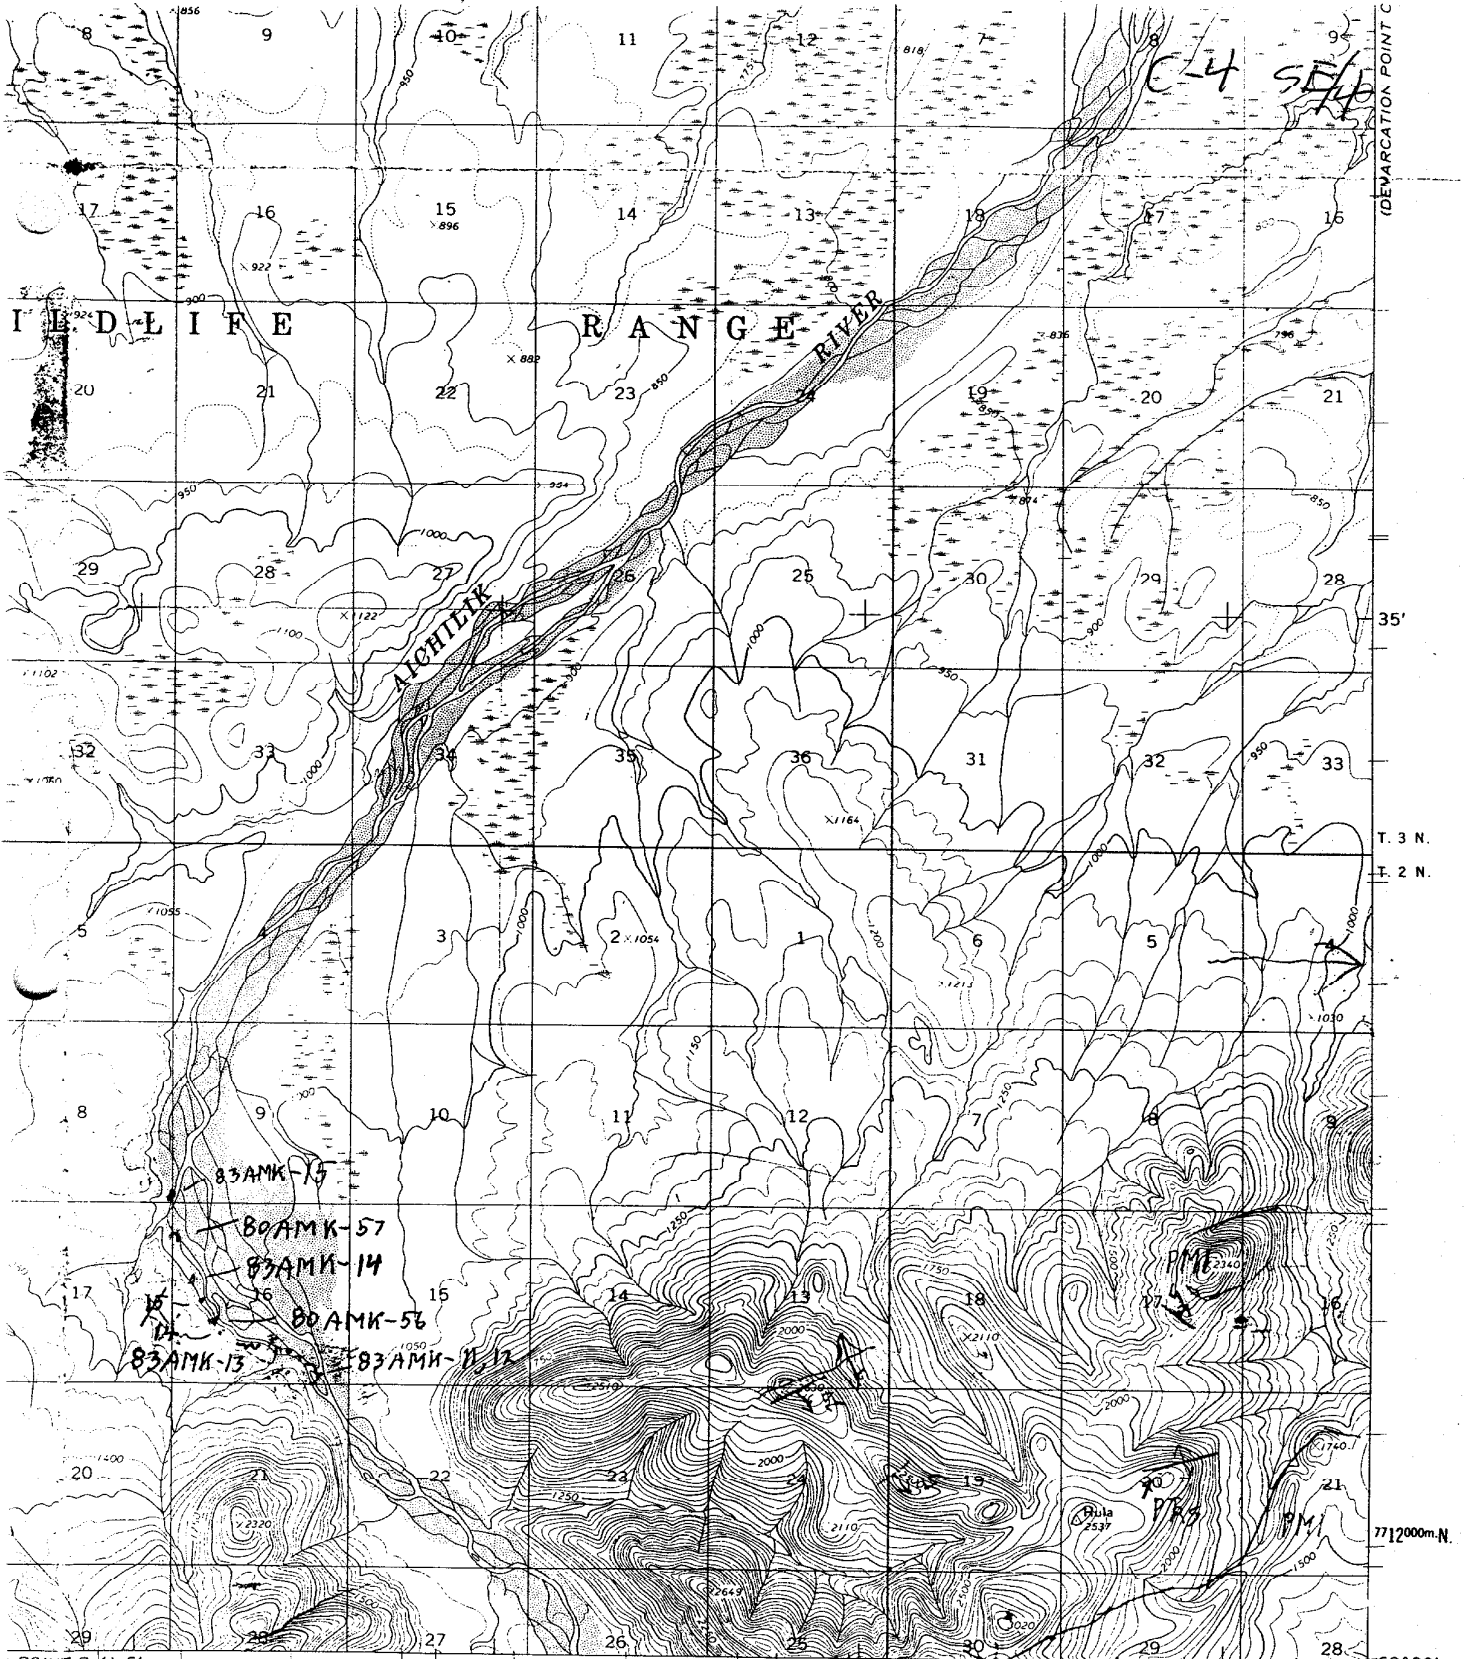

POINT B-4) 5' 143° 48' W 424000m E 55' 00" N 69° 30' N  
 SCALE 1:63360 R. 37 E. R. 38 E. 7712000m N. 142° 48' W

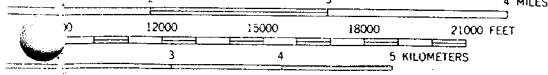

CONTOUR INTERVAL 50 FEET  
 REPRESENT 25-FOOT CONTOURS  
 IS MEAN SEA LEVEL



U. S. GEOLOGICAL SURVEY  
 COLORADO 80225, OR WASHINGTON, D. C. 20242

C-4  
 ROAD CLASSIFICATION  
 No roads or trails in this area  
 SE/4  
 DEMARCATION POINT (C-4), ALASKA  
 N6930—W14248/15X36


Demarcation Pt C-4


NE/4

320 000 FEET

143°24' 60" W



SECTION POINT D-51 40'

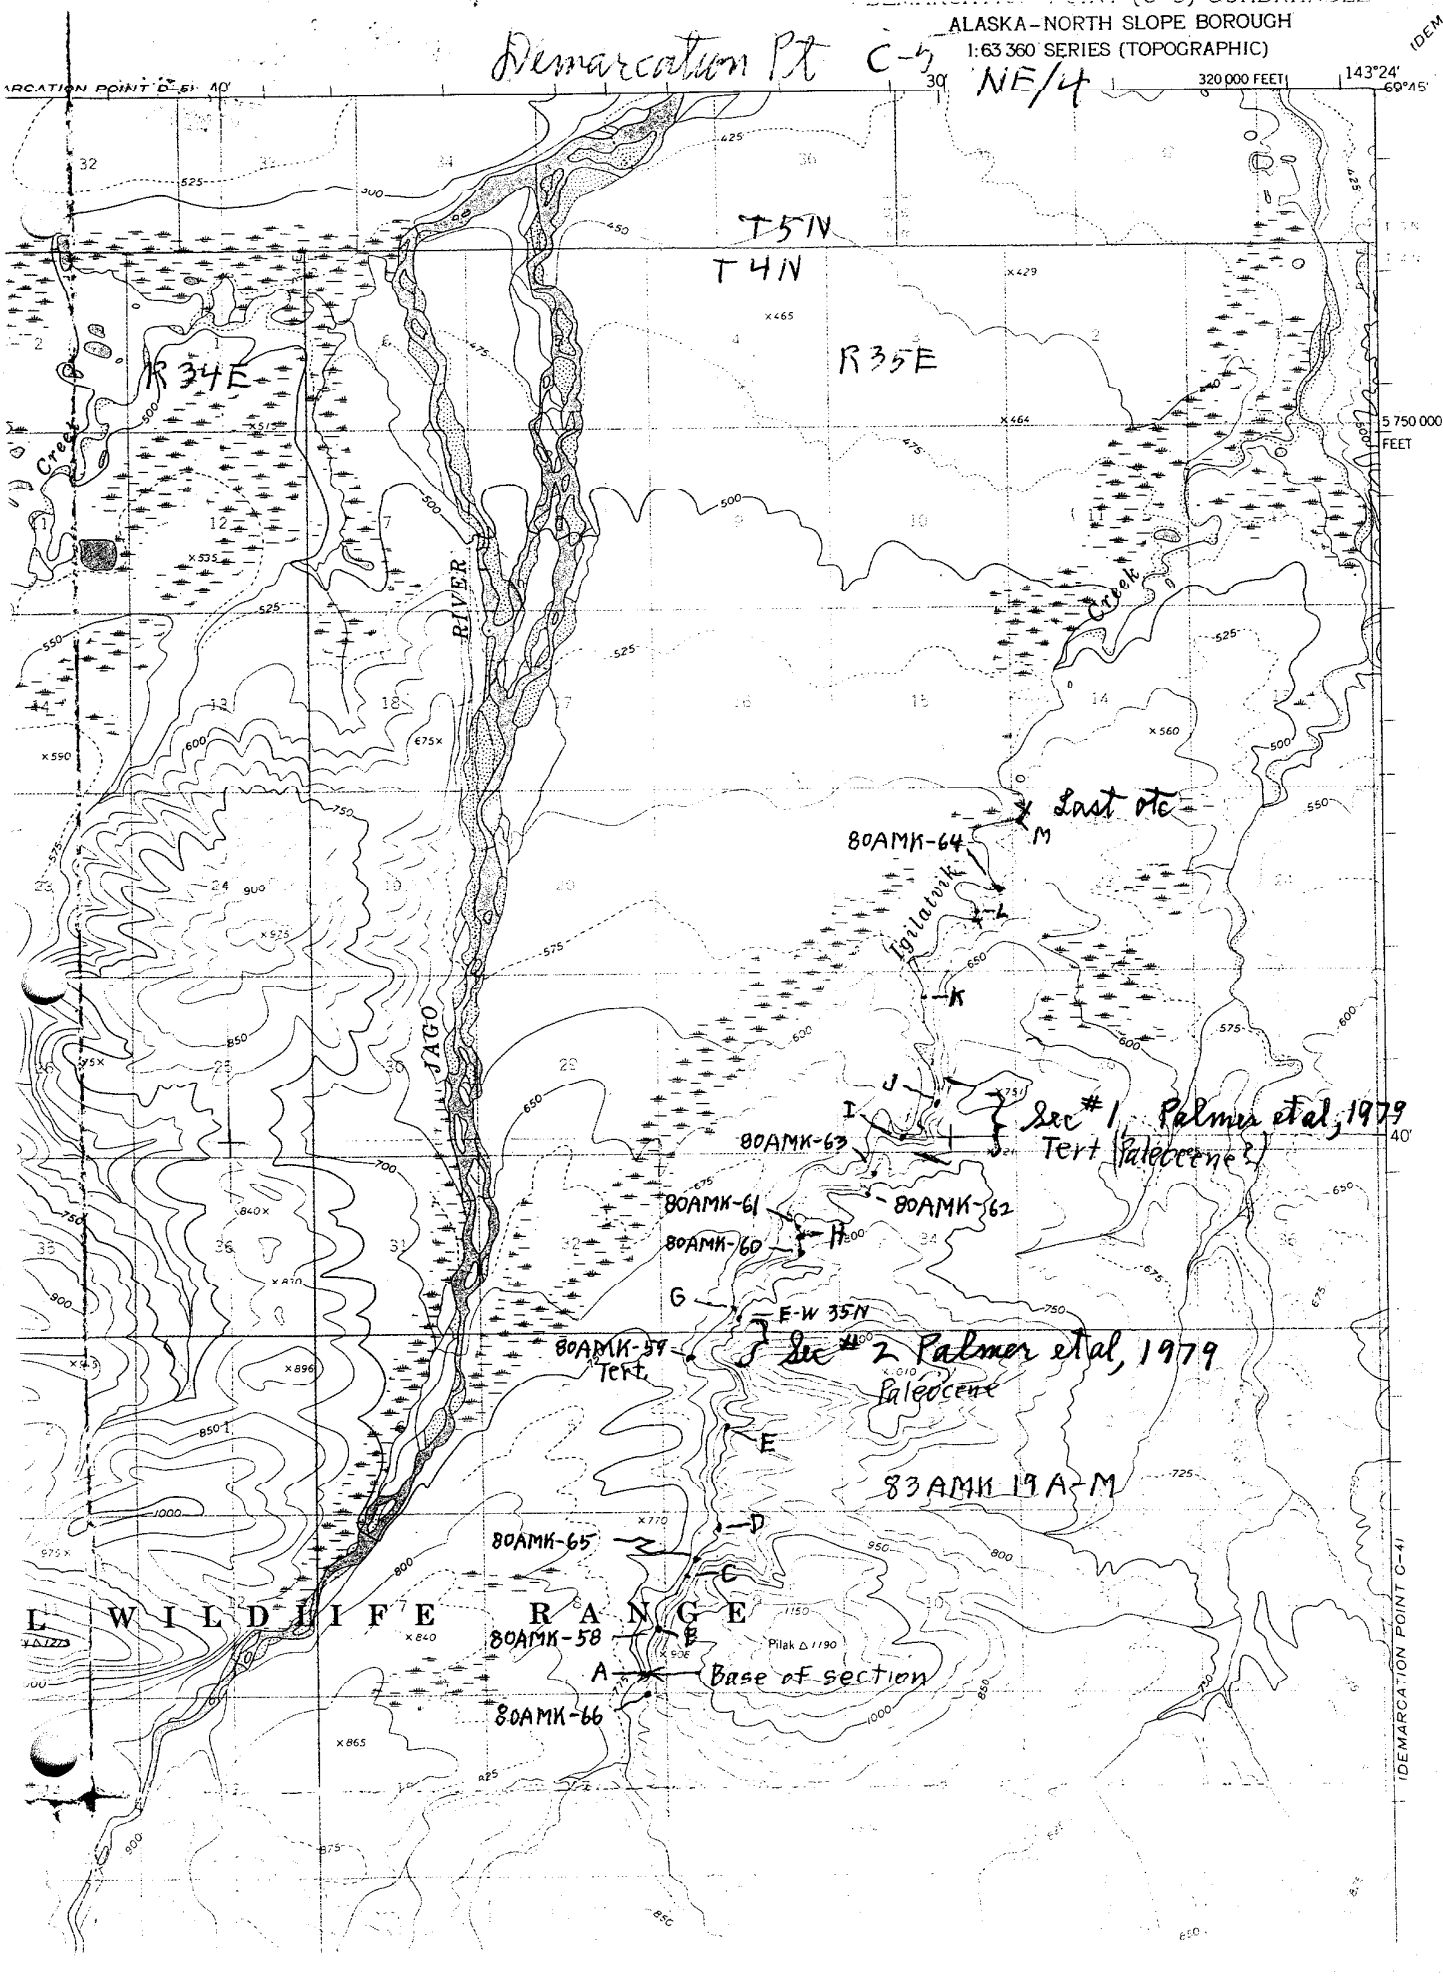

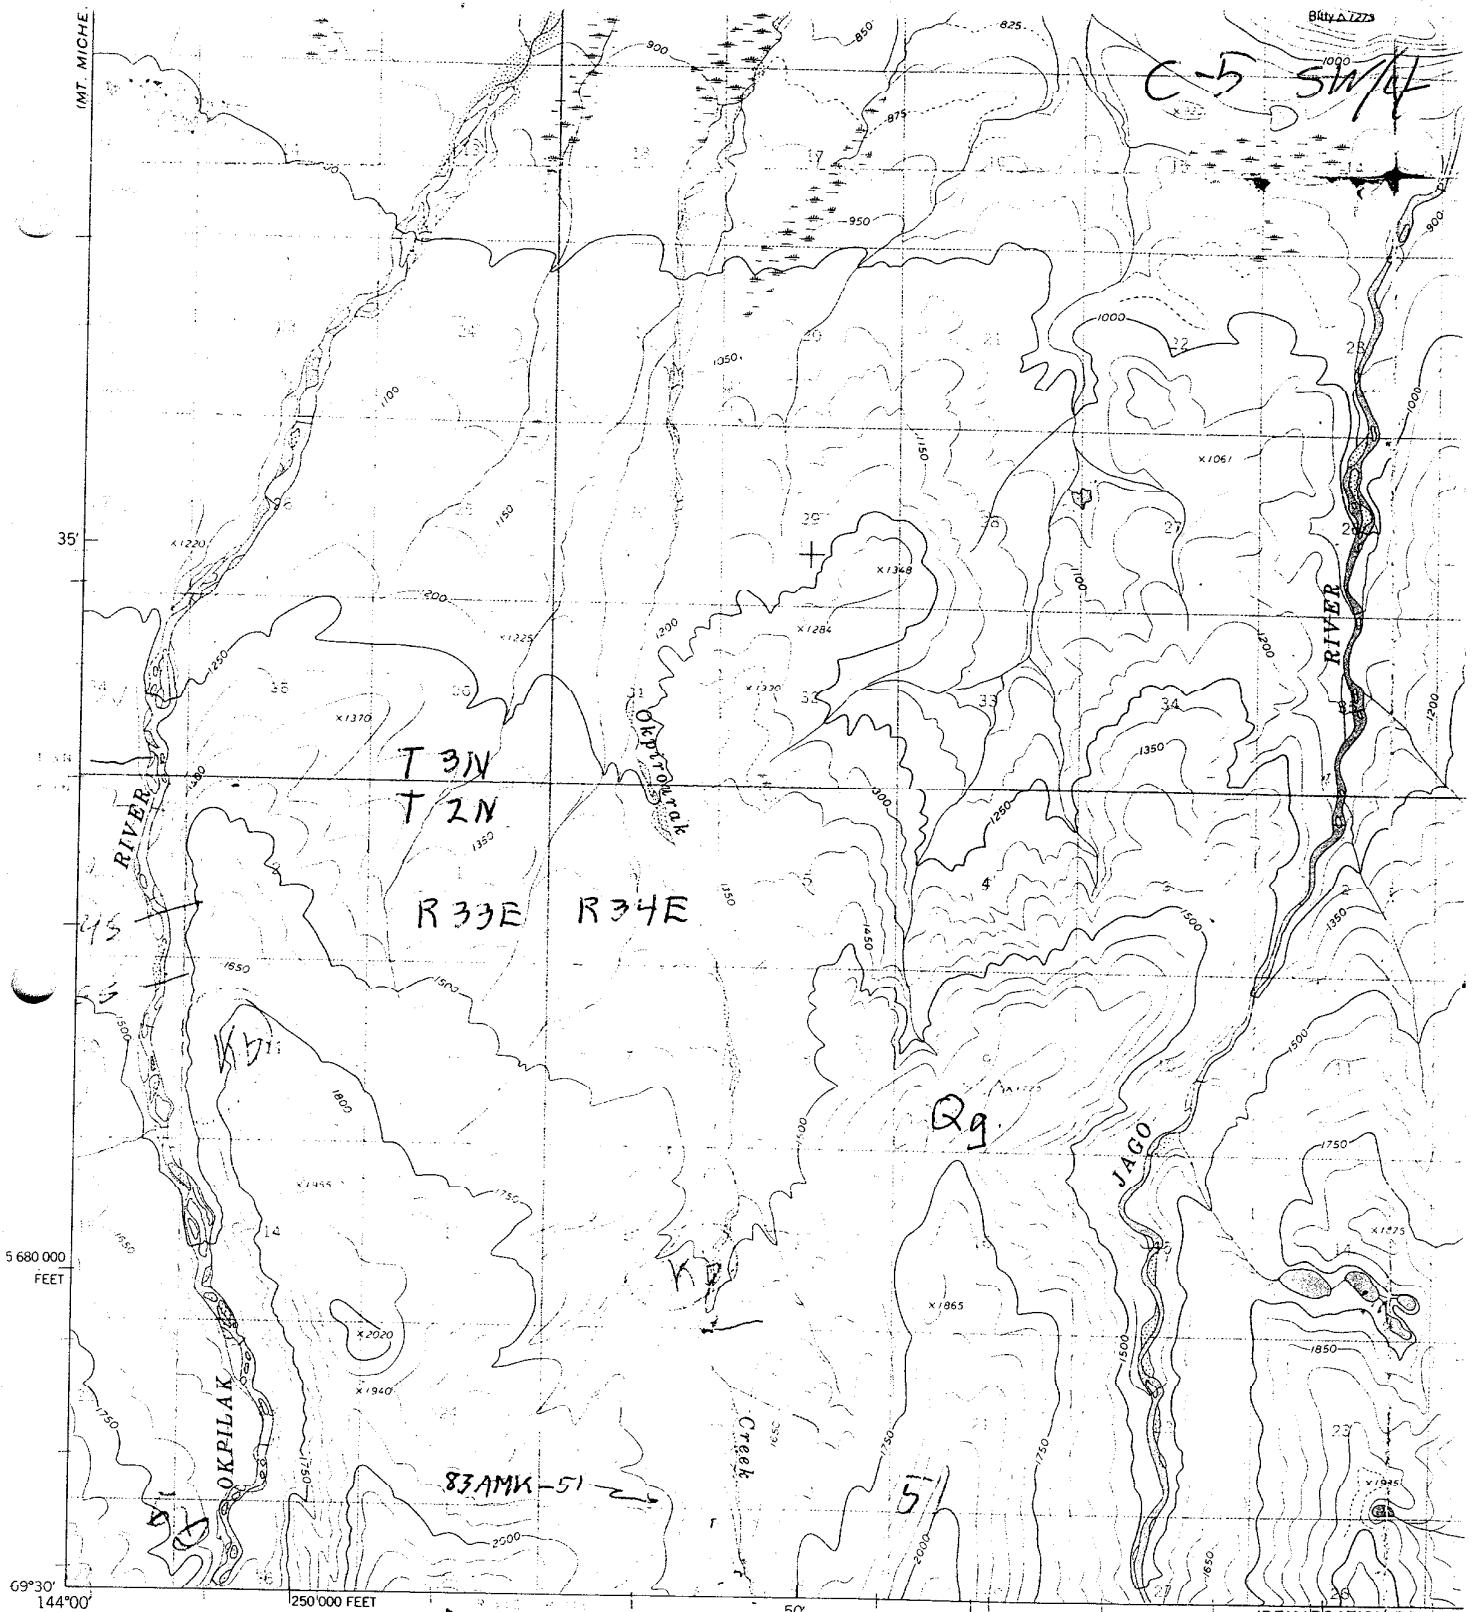

B-11 Mapped by the Army Map Service  
 Edited and published by the Geological Survey  
 Control by USC&GS and USCE  
 Topography by photogrammetric methods from aerial photographs  
 taken 1955, field annotated 1955. Map not field checked  
 Universal Transverse Mercator projection 1927 North American datum  
 10,000-foot grid based on Alaska coordinate system, zone 2  
 1000-metre Universal Transverse Mercator grid ticks,  
 zone 7, shown in blue  
 Land lines represent unsurveyed and unmarked locations  
 predetermined by the Bureau of Land Management  
 Folio U-1. Umiat Meridian

*Demarcation Pt. C-5*  
*83AMK-51*  
*18° SW/4*

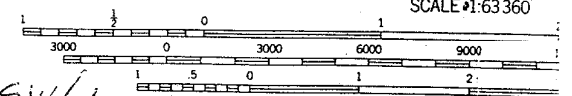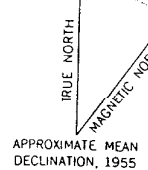


CONTOUR INTERVAL 50  
 DOTTED LINES REPRESENT 25 FOOT  
 NATIONAL GEODETIC VERTICAL DATUM

FOR SALE BY U. S. GEOLOGICAL  
 FAIRBANKS, ALASKA 99701, DENVER, COLORADO 8022  
 A FOLDER DESCRIBING TOPOGRAPHIC MAPS AND SYMBOLS

DEMARCATIION POINT (D-3) QUADRANGLE  
ALASKA


1:63 360 SERIES (TOPOGRAPHIC)

D-3 NE/4

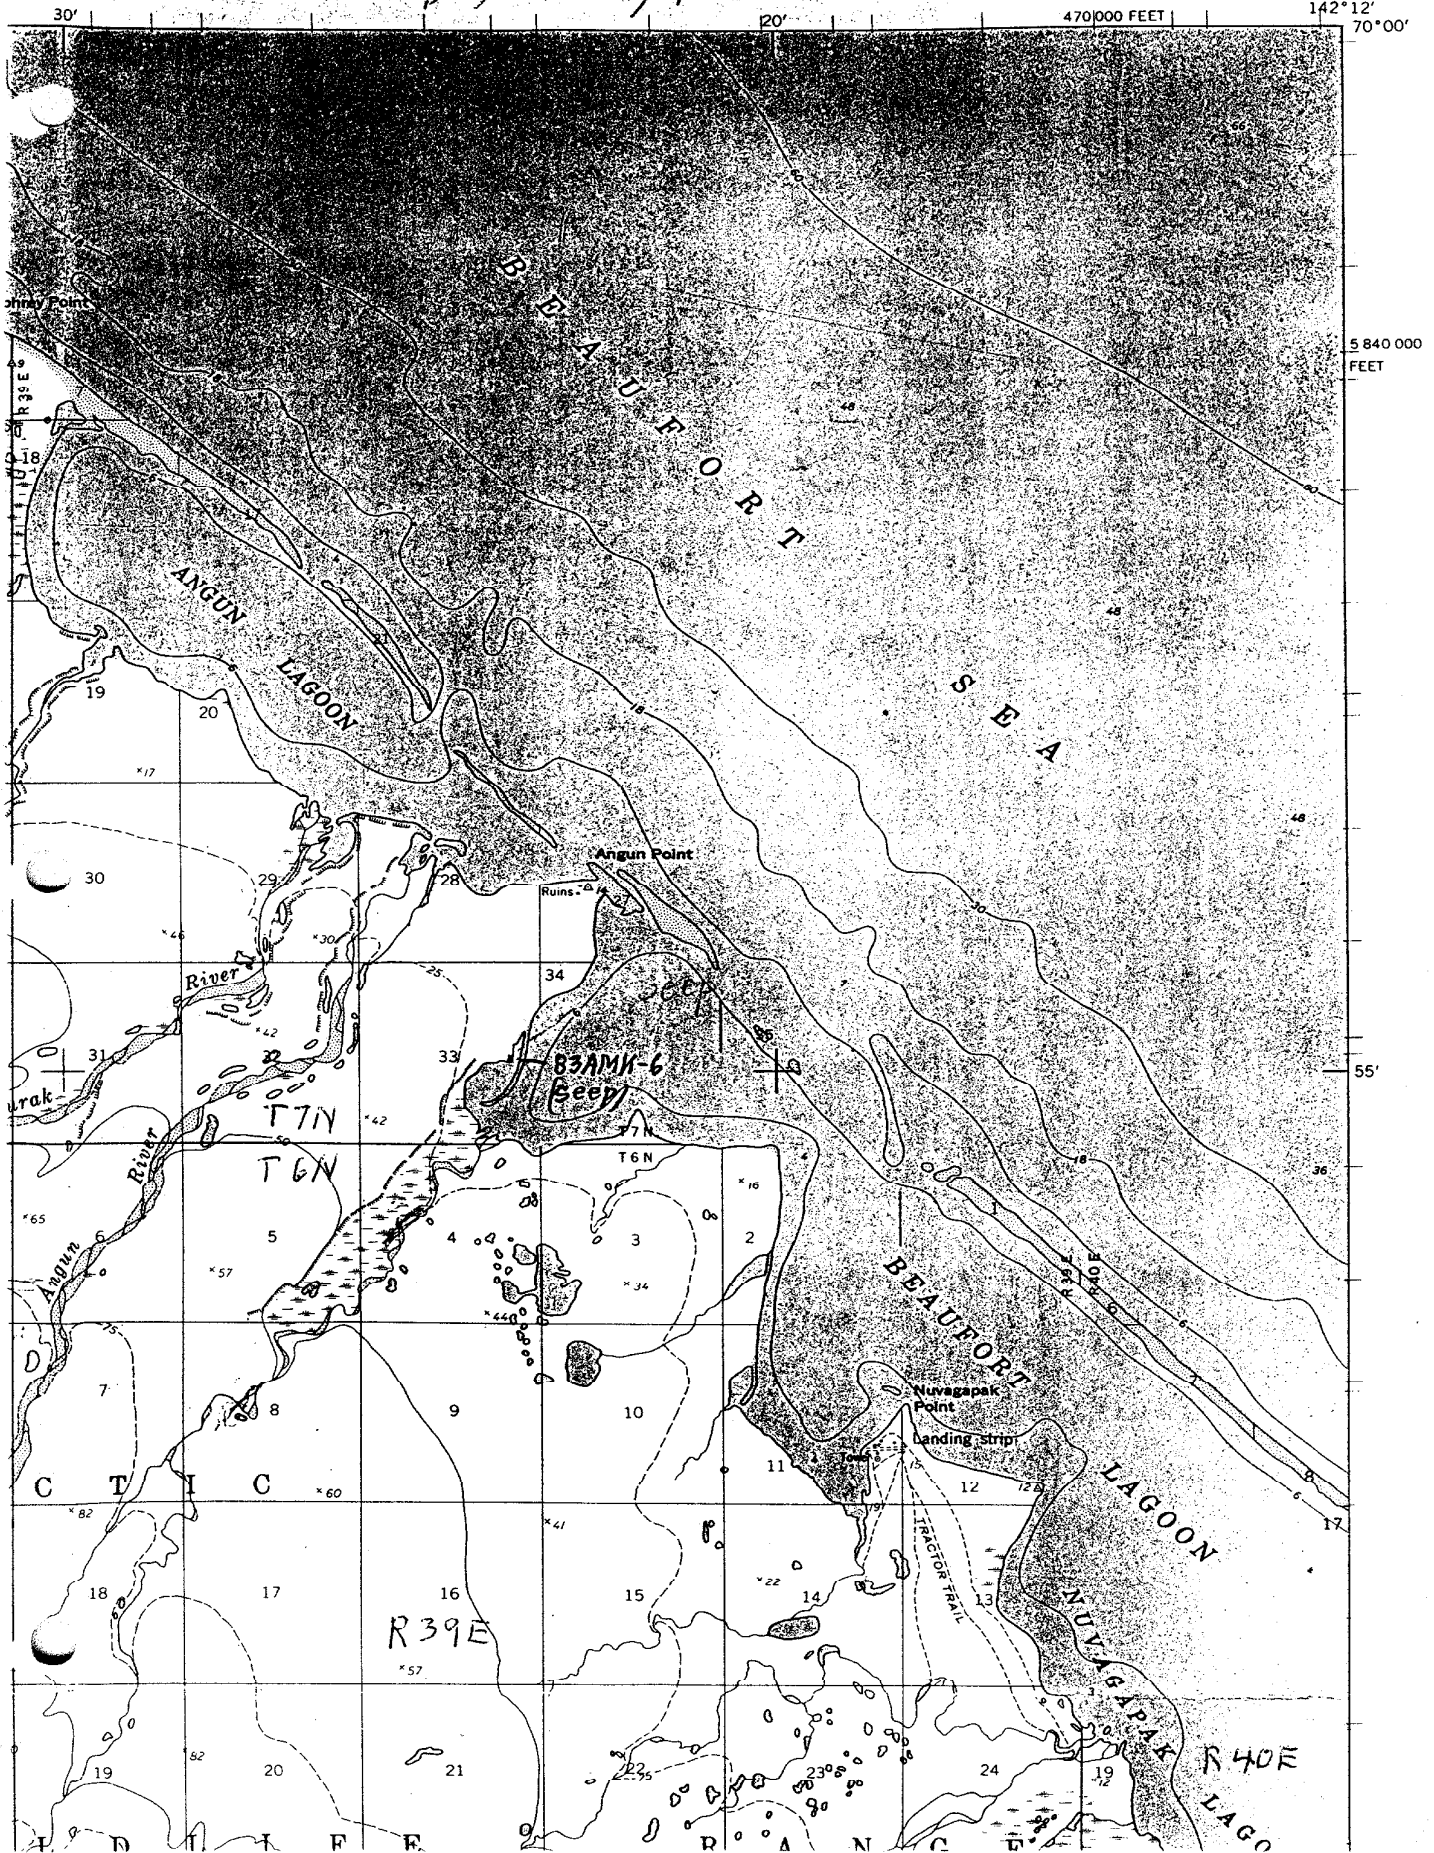

UNITED STATES  
DEPARTMENT OF THE INTERIOR  
GEOLOGICAL SURVEY

Demarcation Pt. D-4 NW/4

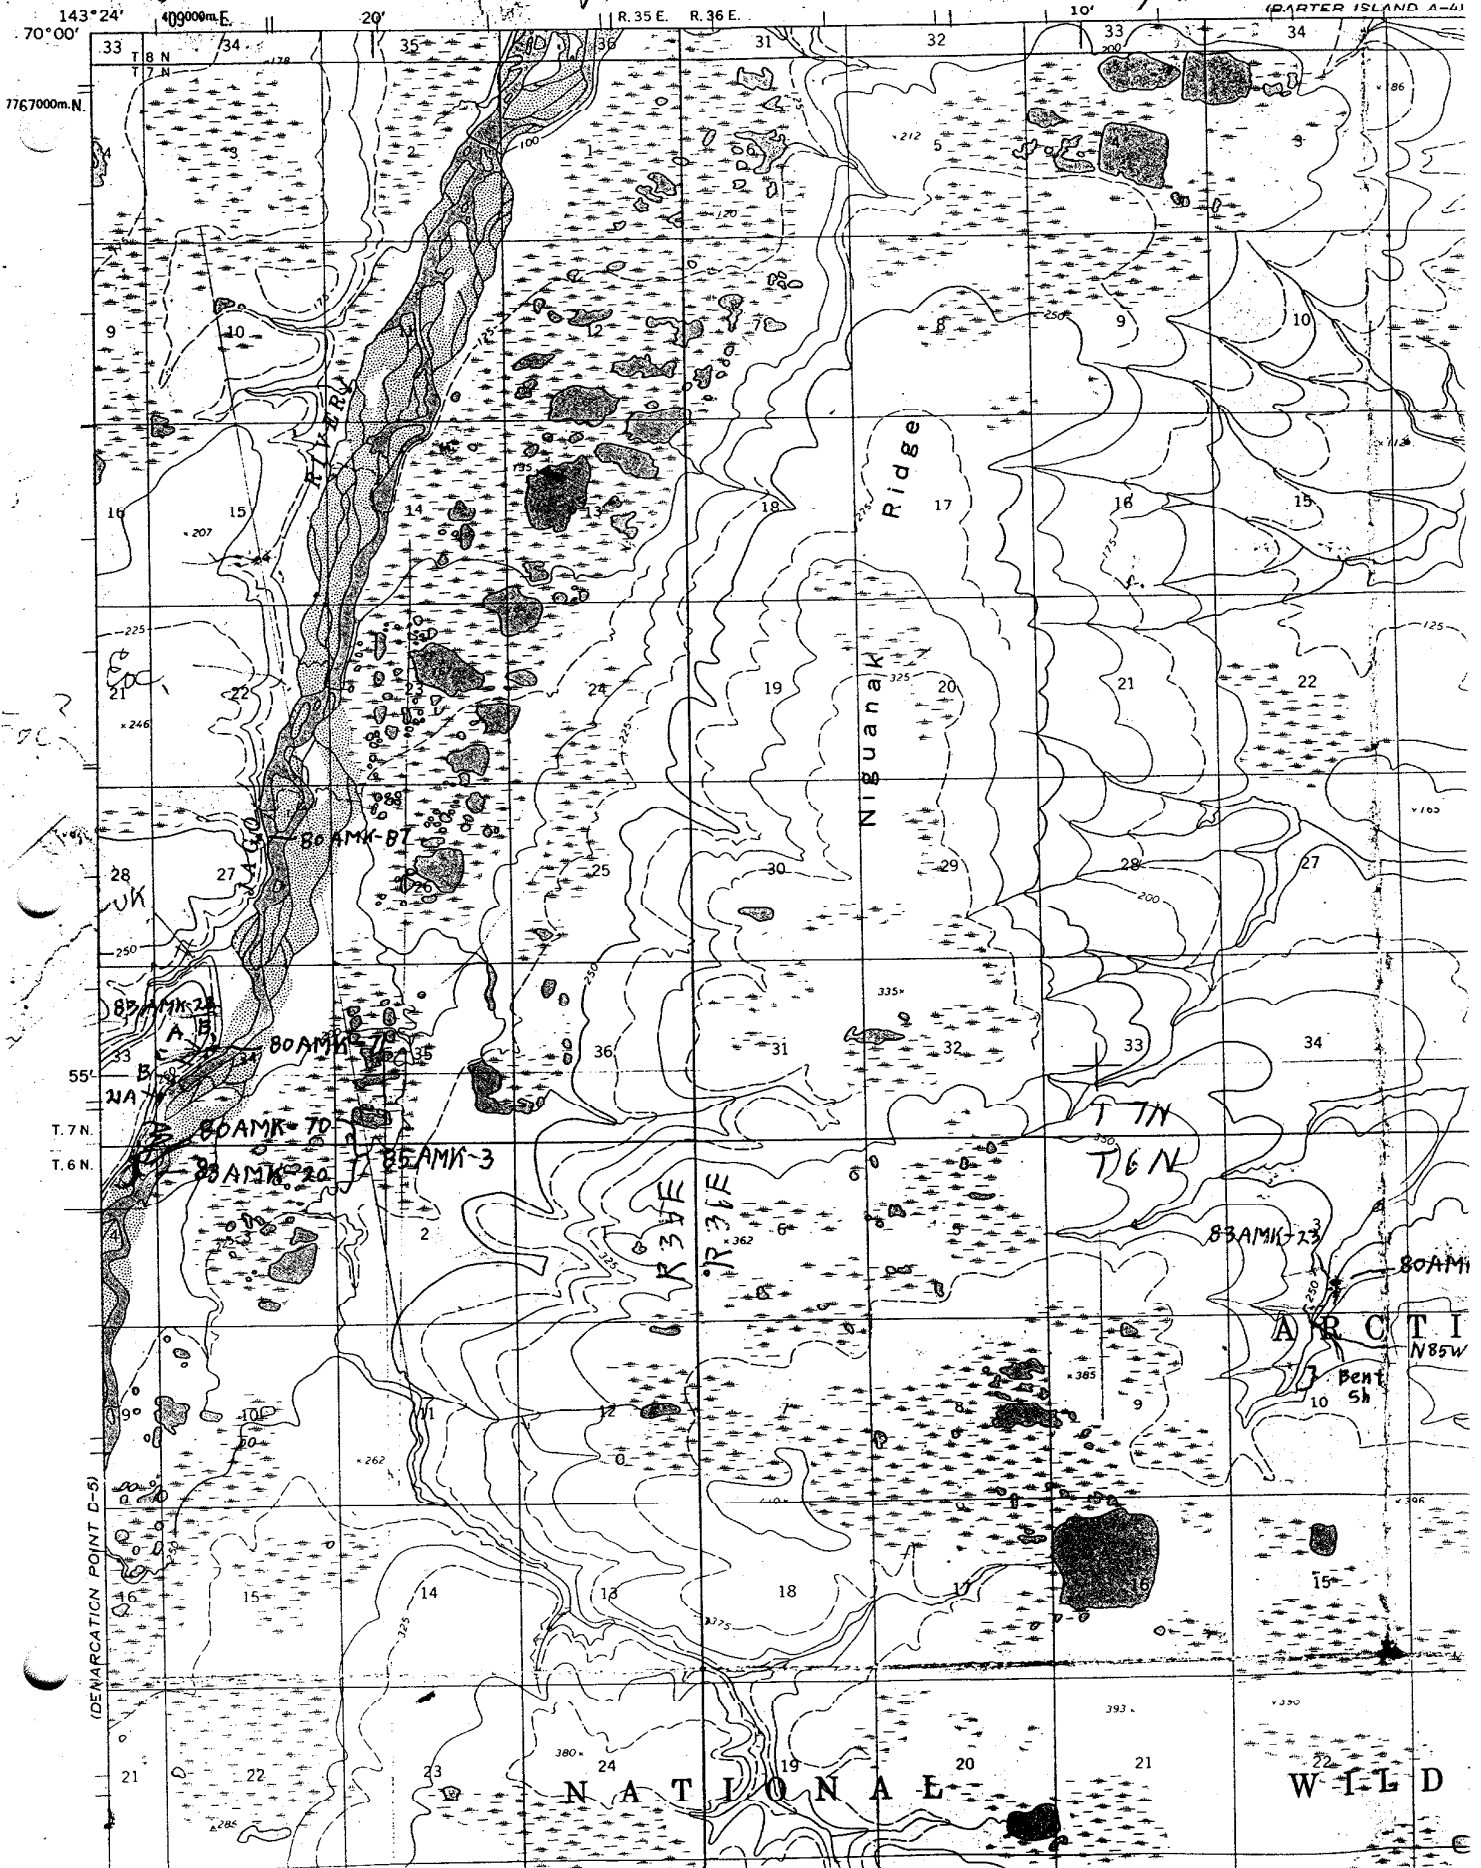

143° 5' 30"


DEMARCATON POINT (D-4) QUADRANGLE  
ALASKA

NE/4

1:63 360 SERIES (TOPOGRAPHIC)

(BARTER ISL.)


R 36 E 143° R 37 E 390 000 FEET 50' 142° 48' 70' 00'

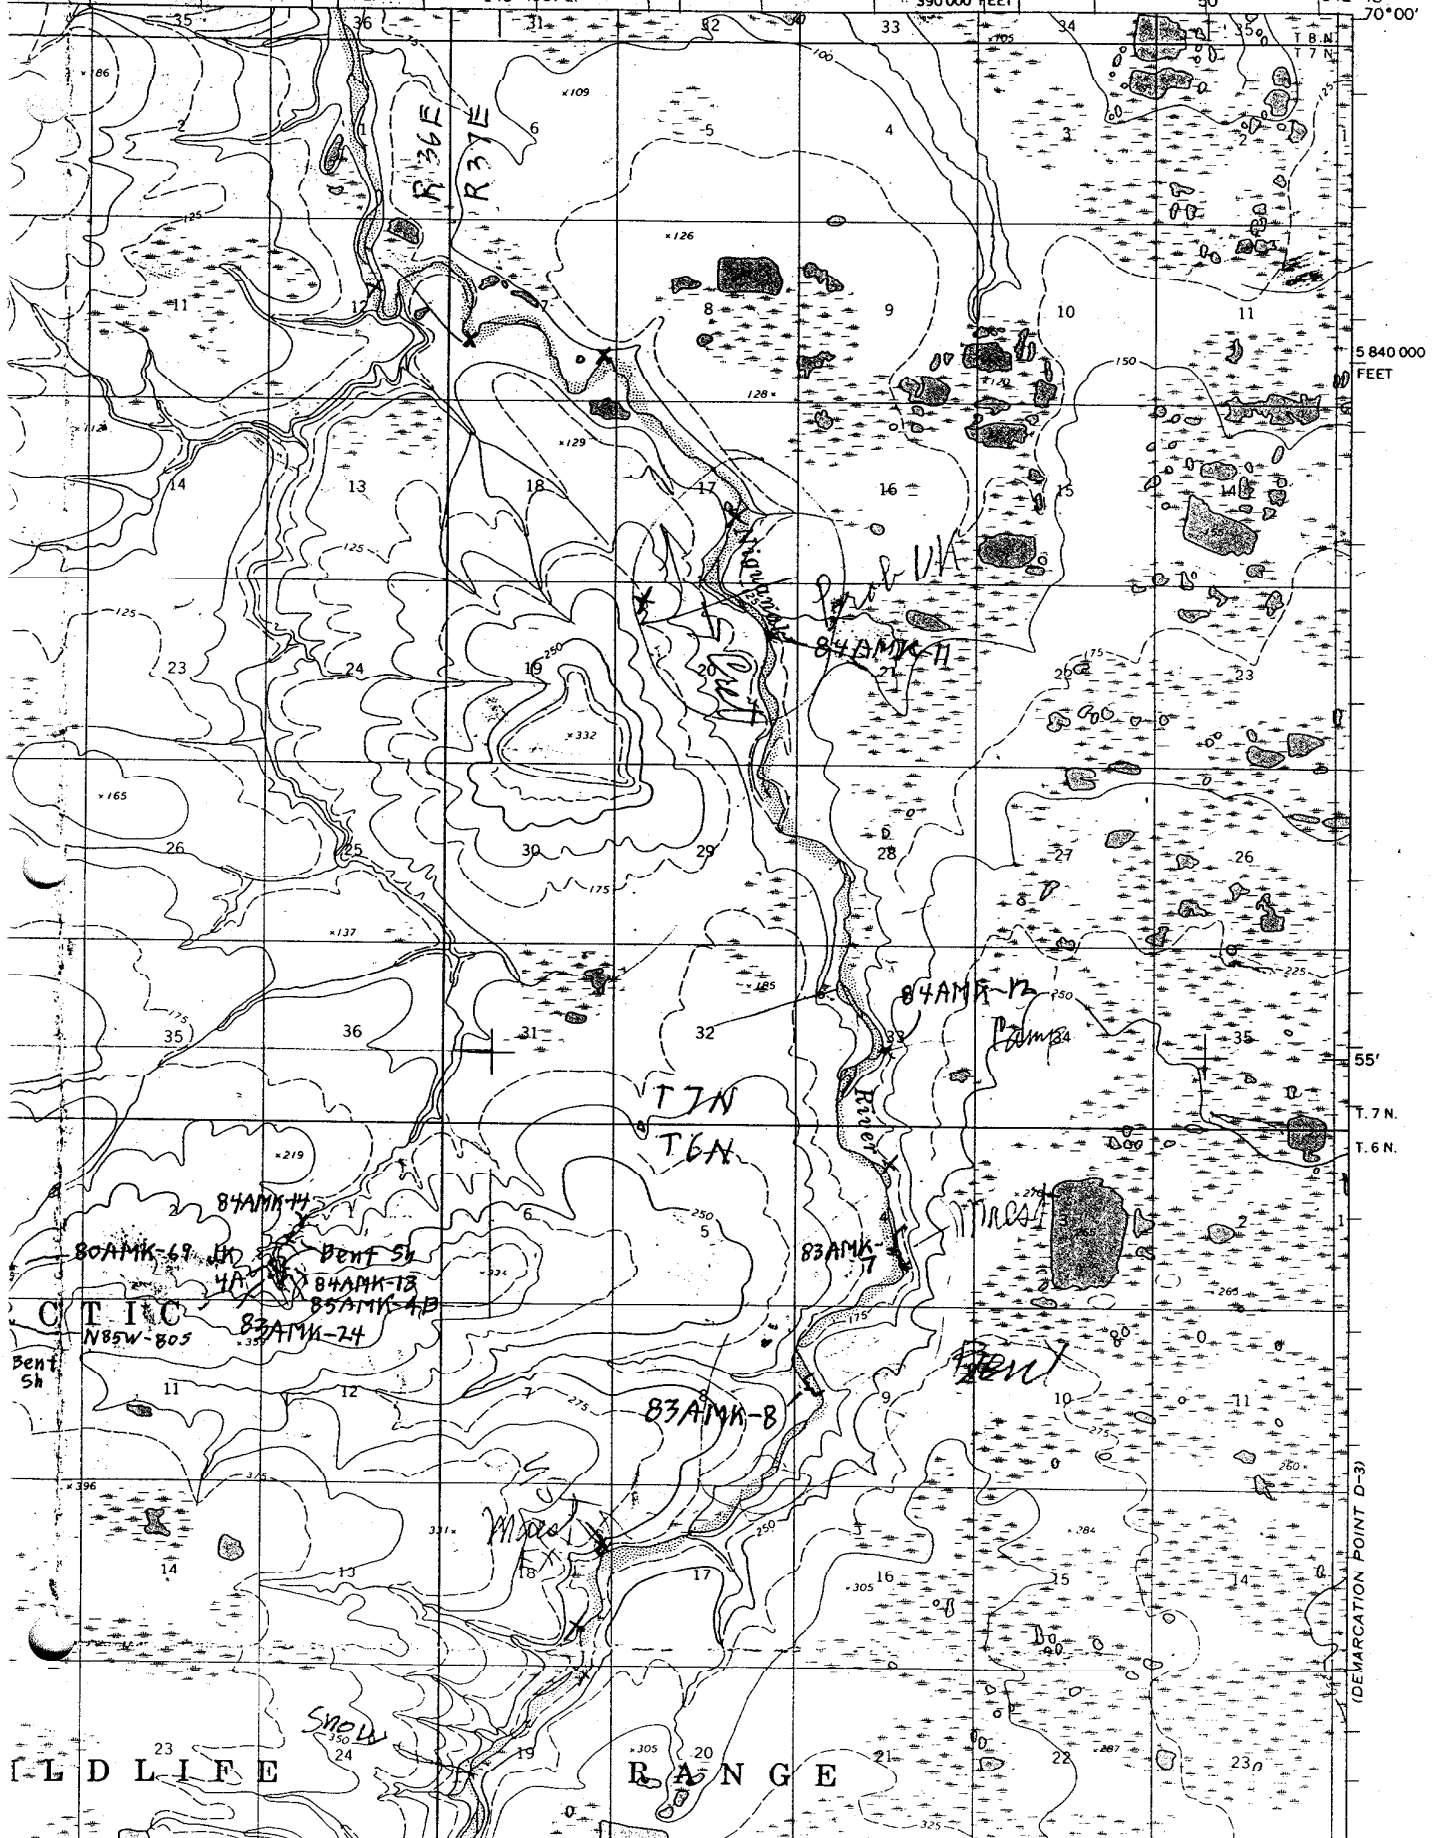


5 840 000 FEET

55'  
T. 7 N.  
T. 6 N.

(DEMARCATON POINT D-3)

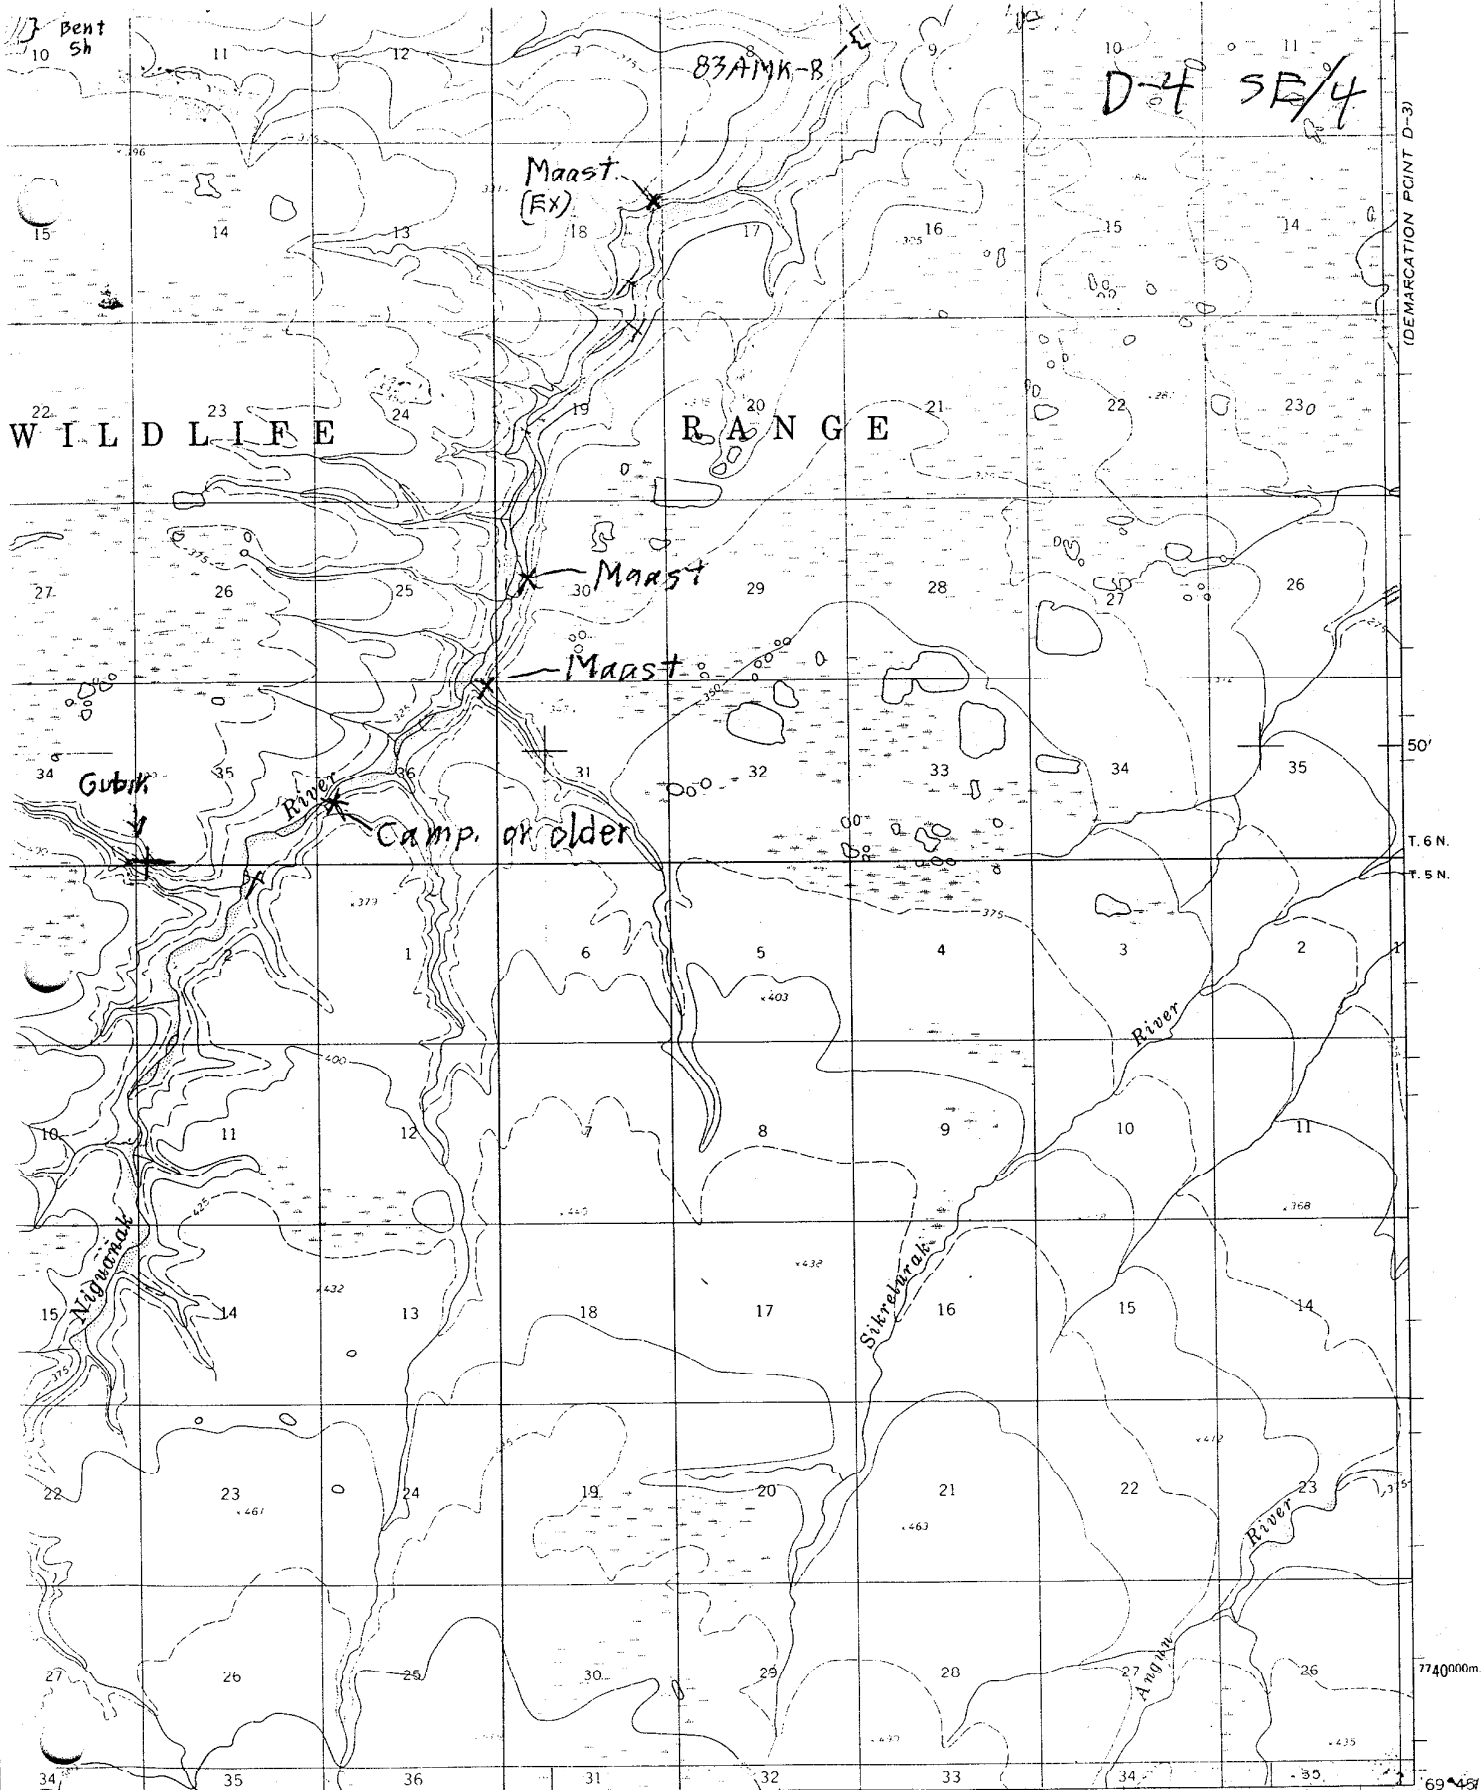

DEMARCATIION POINT C-4) R. 36 E. 143° R. 37 E.

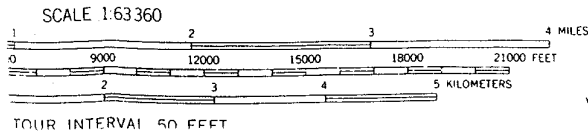

Demarcation Point D-4 SE/4

ROAD CLASSIFICATION  
No roads or trails in this area

INTERIOR-GEOLOGICAL SURVEY, WASHINGTON, D. C. 20508 1970 429000m.E. 50'

142° 48'

69' 48'

774000m

DEMARCATIION POINT D-3)


50'

T. 6 N.

T. 5 N.





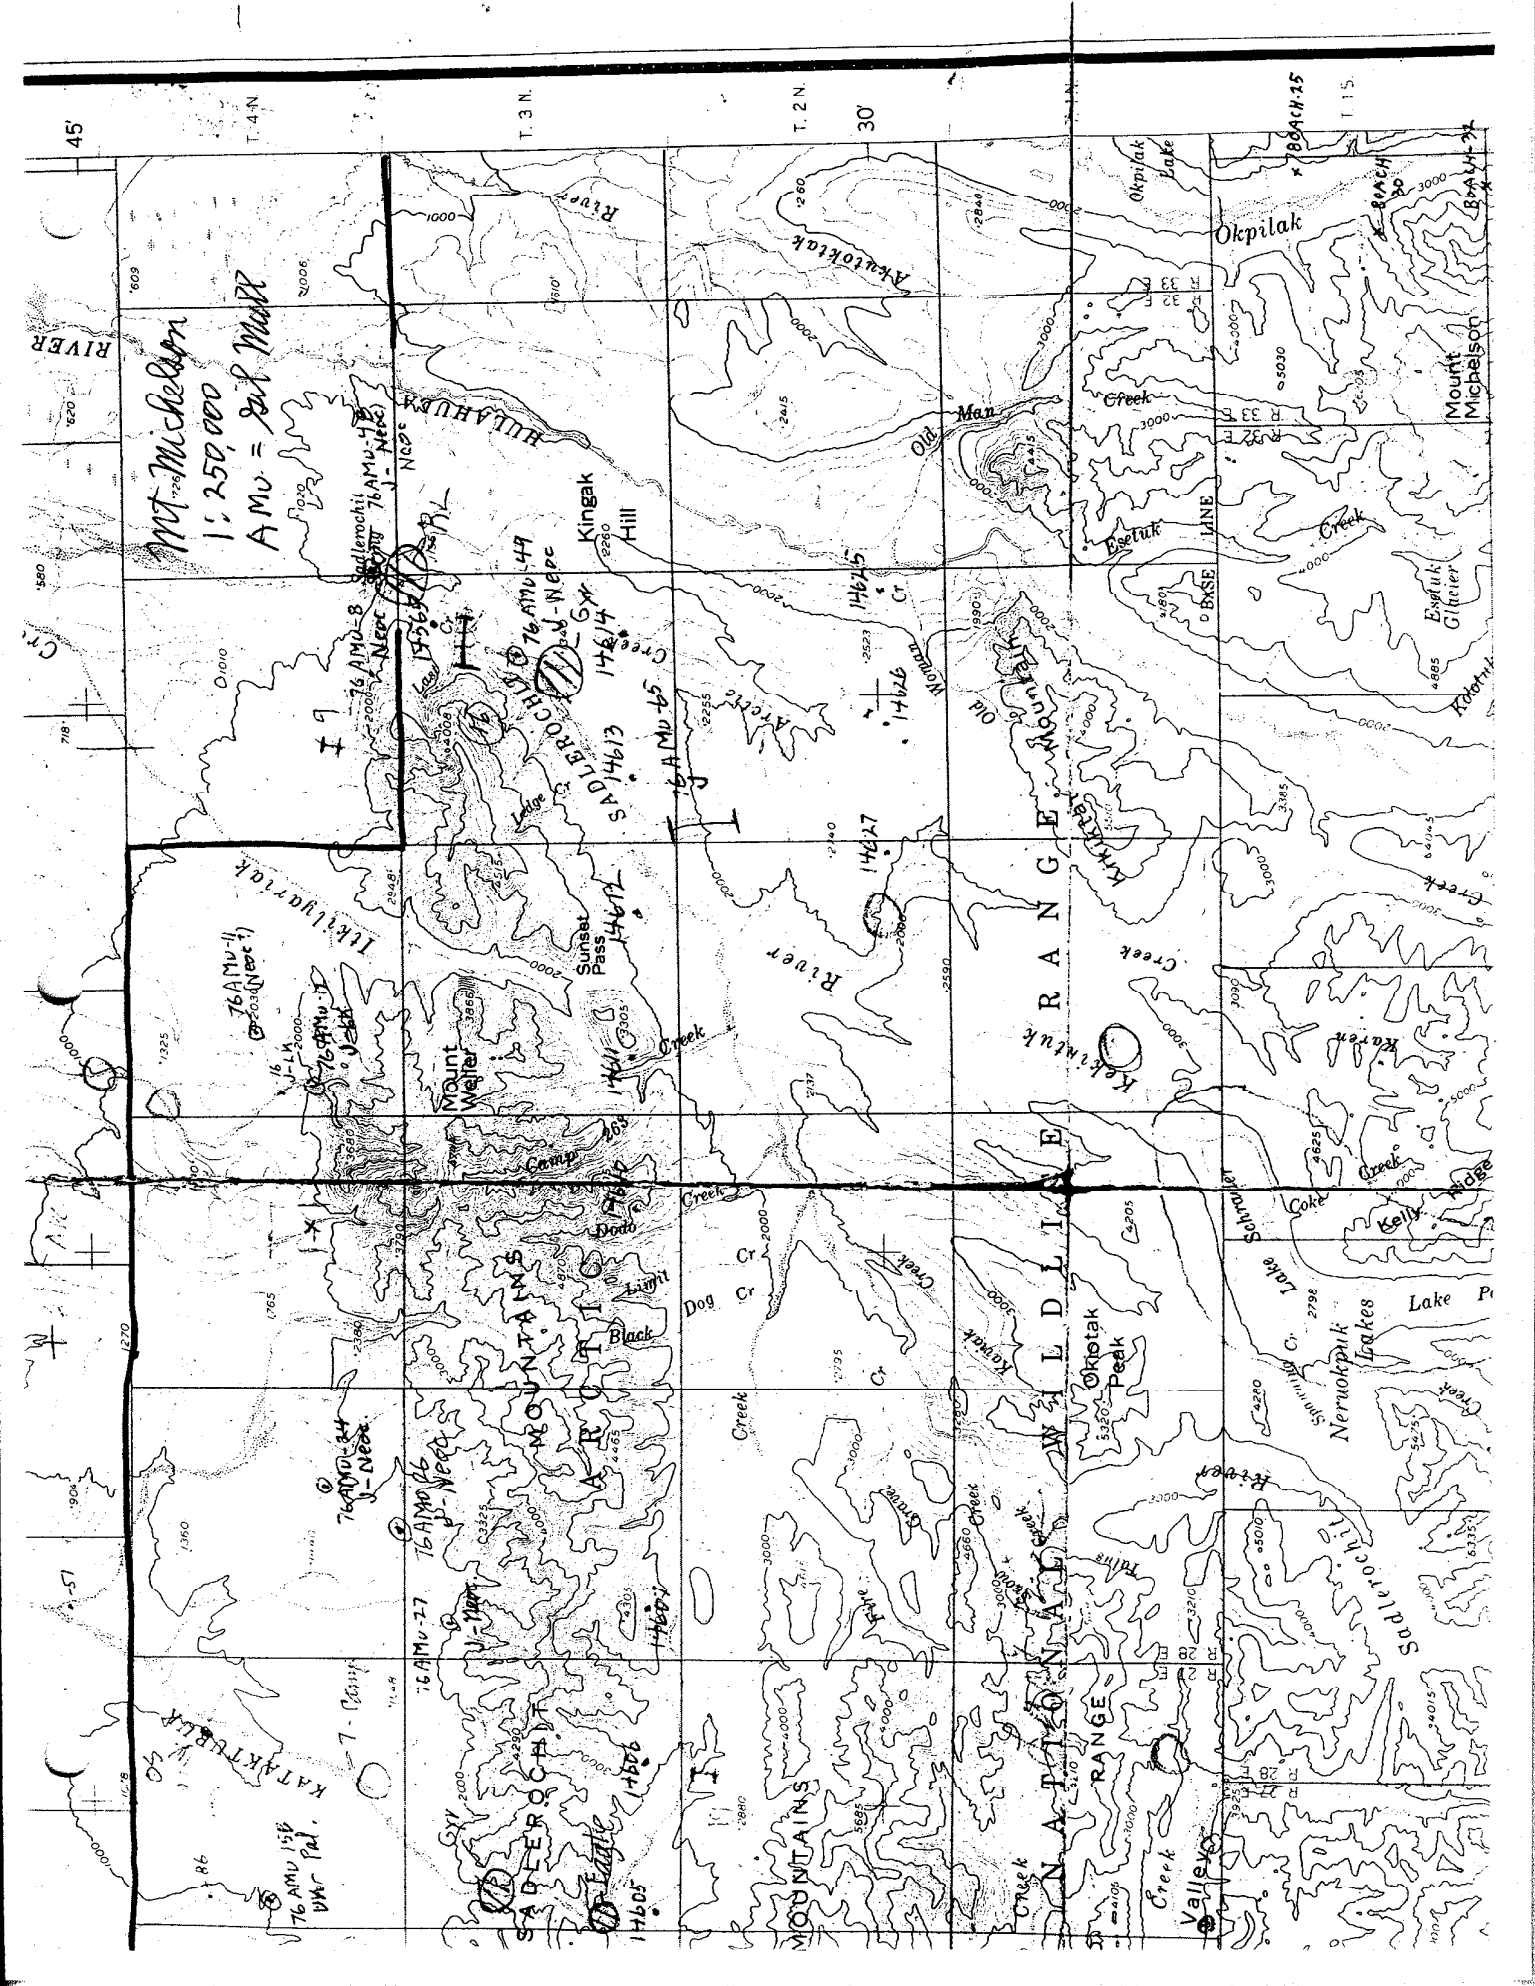

45

T. 4 N.

T. 3 N.

T. 2 N.

30

R. 25 W.

R. 24 W.

MT. Michelson  
1:250,000  
AMU = 2nd March

76AMU-4  
16-14  
76AMU-5  
16-14  
76AMU-6  
16-14

76AMU-24  
NEC.

76AMU-27  
NEC.

76AMU-26  
NEC.

76AMU-25  
NEC.

76AMU-24  
NEC.

76AMU-23  
NEC.

76AMU-22  
NEC.

76AMU-21  
NEC.

76AMU-20  
NEC.

76AMU-19  
NEC.

76AMU-18  
NEC.

76AMU-17  
NEC.

76AMU-16  
NEC.

76AMU-15  
NEC.

76AMU-14  
NEC.

76AMU-13  
NEC.

76AMU-12  
NEC.

76AMU-11  
NEC.

76AMU-8  
NEC.

76AMU-7  
NEC.

76AMU-6  
NEC.

76AMU-5  
NEC.

76AMU-4  
NEC.

76AMU-3  
NEC.

76AMU-2  
NEC.

76AMU-1  
NEC.

76AMU-11  
NEC.

76AMU-10  
NEC.

76AMU-9  
NEC.

76AMU-8  
NEC.

76AMU-7  
NEC.

76AMU-6  
NEC.

76AMU-5  
NEC.

76AMU-4  
NEC.

76AMU-3  
NEC.

76AMU-2  
NEC.

76AMU-1  
NEC.

76AMU-14  
NEC.

76AMU-13  
NEC.

76AMU-12  
NEC.

76AMU-11  
NEC.

76AMU-10  
NEC.

76AMU-9  
NEC.

76AMU-8  
NEC.

76AMU-7  
NEC.

76AMU-6  
NEC.

76AMU-5  
NEC.

76AMU-4  
NEC.

76AMU-3  
NEC.

76AMU-2  
NEC.

76AMU-1  
NEC.

76AMU-17  
NEC.

76AMU-16  
NEC.

76AMU-15  
NEC.

76AMU-14  
NEC.

76AMU-13  
NEC.

76AMU-12  
NEC.

76AMU-11  
NEC.

76AMU-10  
NEC.

76AMU-9  
NEC.

76AMU-8  
NEC.

76AMU-7  
NEC.

76AMU-6  
NEC.

76AMU-5  
NEC.

76AMU-4  
NEC.

76AMU-20  
NEC.

76AMU-19  
NEC.

76AMU-18  
NEC.

76AMU-17  
NEC.

76AMU-16  
NEC.

76AMU-15  
NEC.

76AMU-14  
NEC.

76AMU-13  
NEC.

76AMU-12  
NEC.

76AMU-11  
NEC.

76AMU-10  
NEC.

76AMU-9  
NEC.

76AMU-8  
NEC.

76AMU-7  
NEC.

76AMU-23  
NEC.

76AMU-22  
NEC.

76AMU-21  
NEC.

76AMU-20  
NEC.

76AMU-19  
NEC.

76AMU-18  
NEC.

76AMU-17  
NEC.

NEC.

76AMU-19  
NEC.

76AMU-35  
NEC.

76AMU-34  
NEC.

76AMU-33  
NEC.

76AMU-32  
NEC.

76AMU-31  
NEC.

76AMU-30  
NEC.

76AMU-29  
NEC.

76AMU-28  
NEC.

76AMU-27  
NEC.

76AMU-26  
NEC.

76AMU-25  
NEC.

76AMU-24  
NEC.


76AMU-23  
NEC.

76AMU-22  
NEC.



UNITED STATES  
DEPARTMENT OF THE INTERIOR  
GEOLOGICAL SURVEY

MT. Michelson B-1 NW 1/4

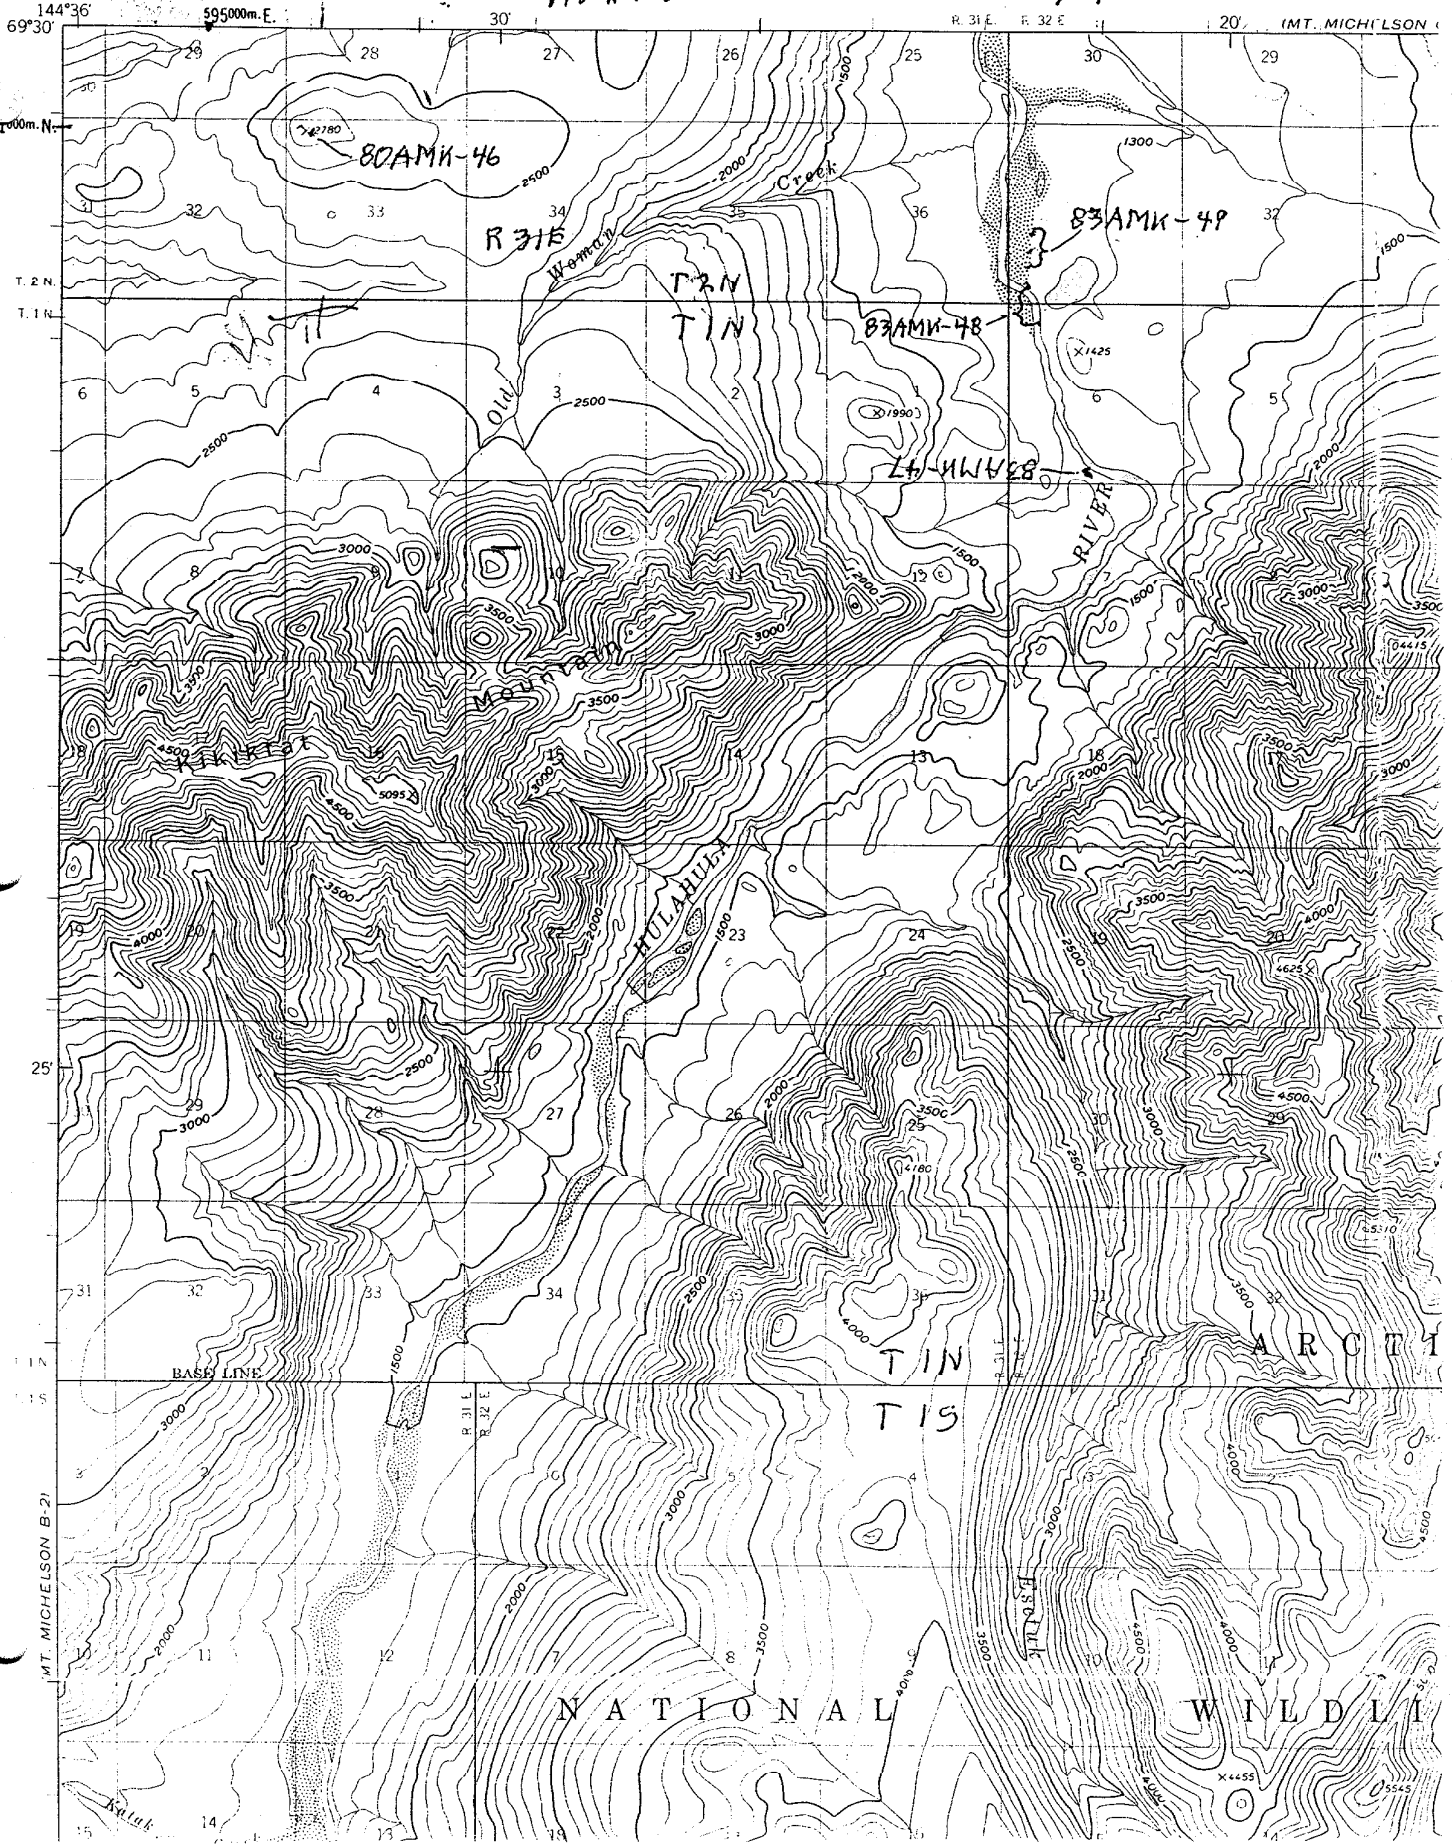

LSOW C-2

144°36'  
69°30'

595000m. E.

R. 31 E. R. 32 E.

20' MT. MICH'ELSON

1000m N

T. 2 N  
T. 1 N

25'

31  
32  
33  
34



MT. MICH'ELSON B-2

NATIONAL

WILDLIFE

X+55

(1)

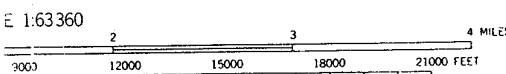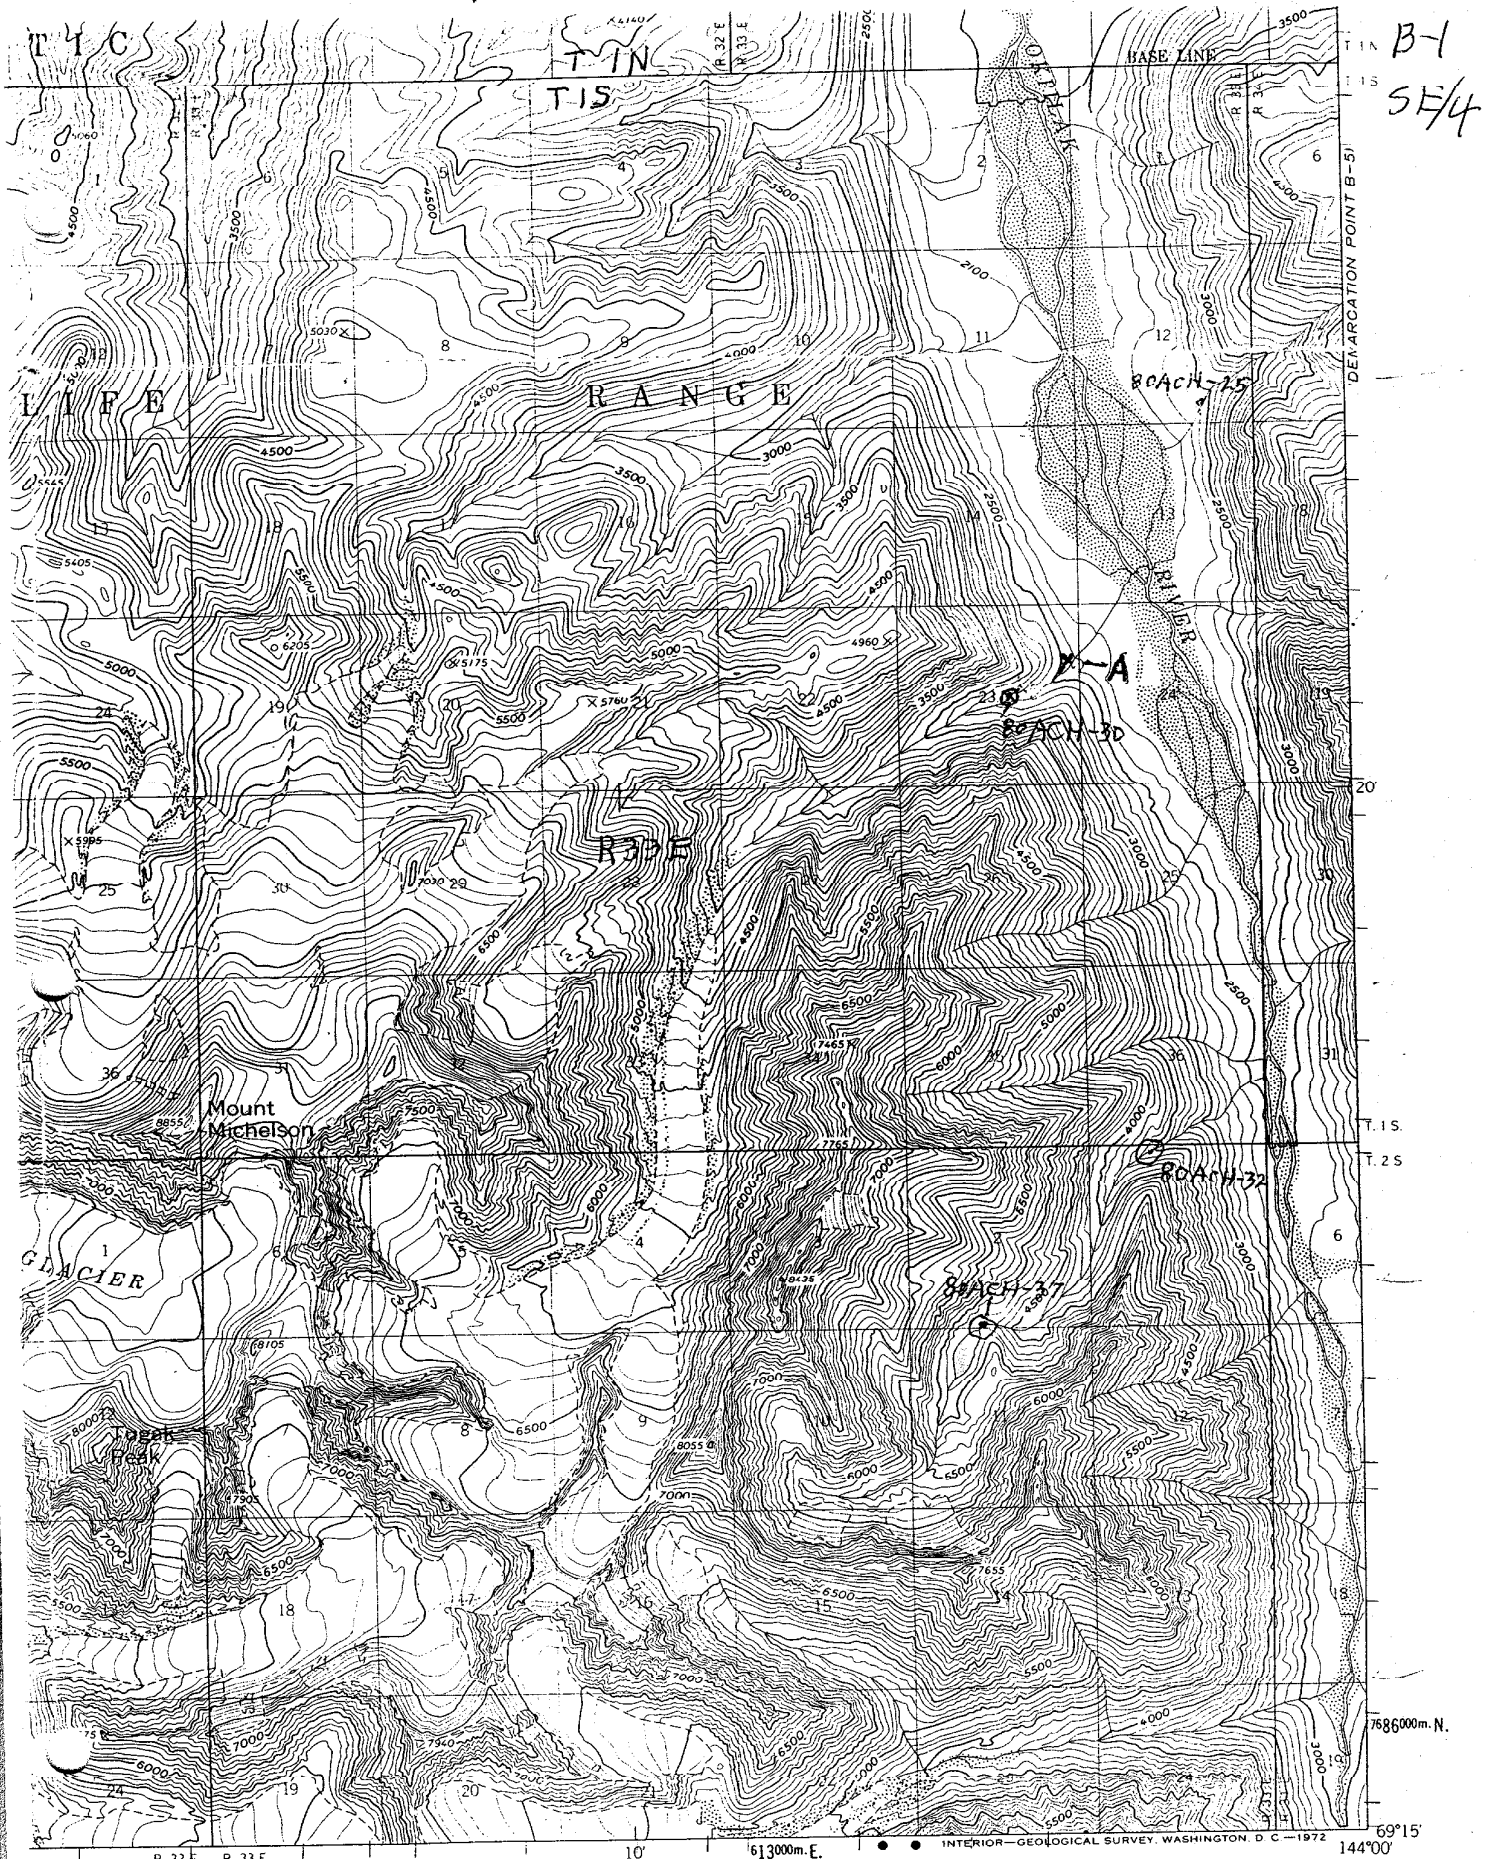

Mt Michelson B-1 SE/4

ROAD CLASSIFICATION

UNITED STATES  
DEPARTMENT OF THE INTERIOR  
GEOLOGICAL SURVEY

MT Michelson B-2 NW/4

145°12' 10' 572000m E. R. 28 E. R. 29 E 145° R. 29 E. IMT. MICHELSON

7710000m. N.


T. 2 N.  
T. 1 N.

25

T. 1 N.

T. 2 S.

IMT MICHELSON B-31

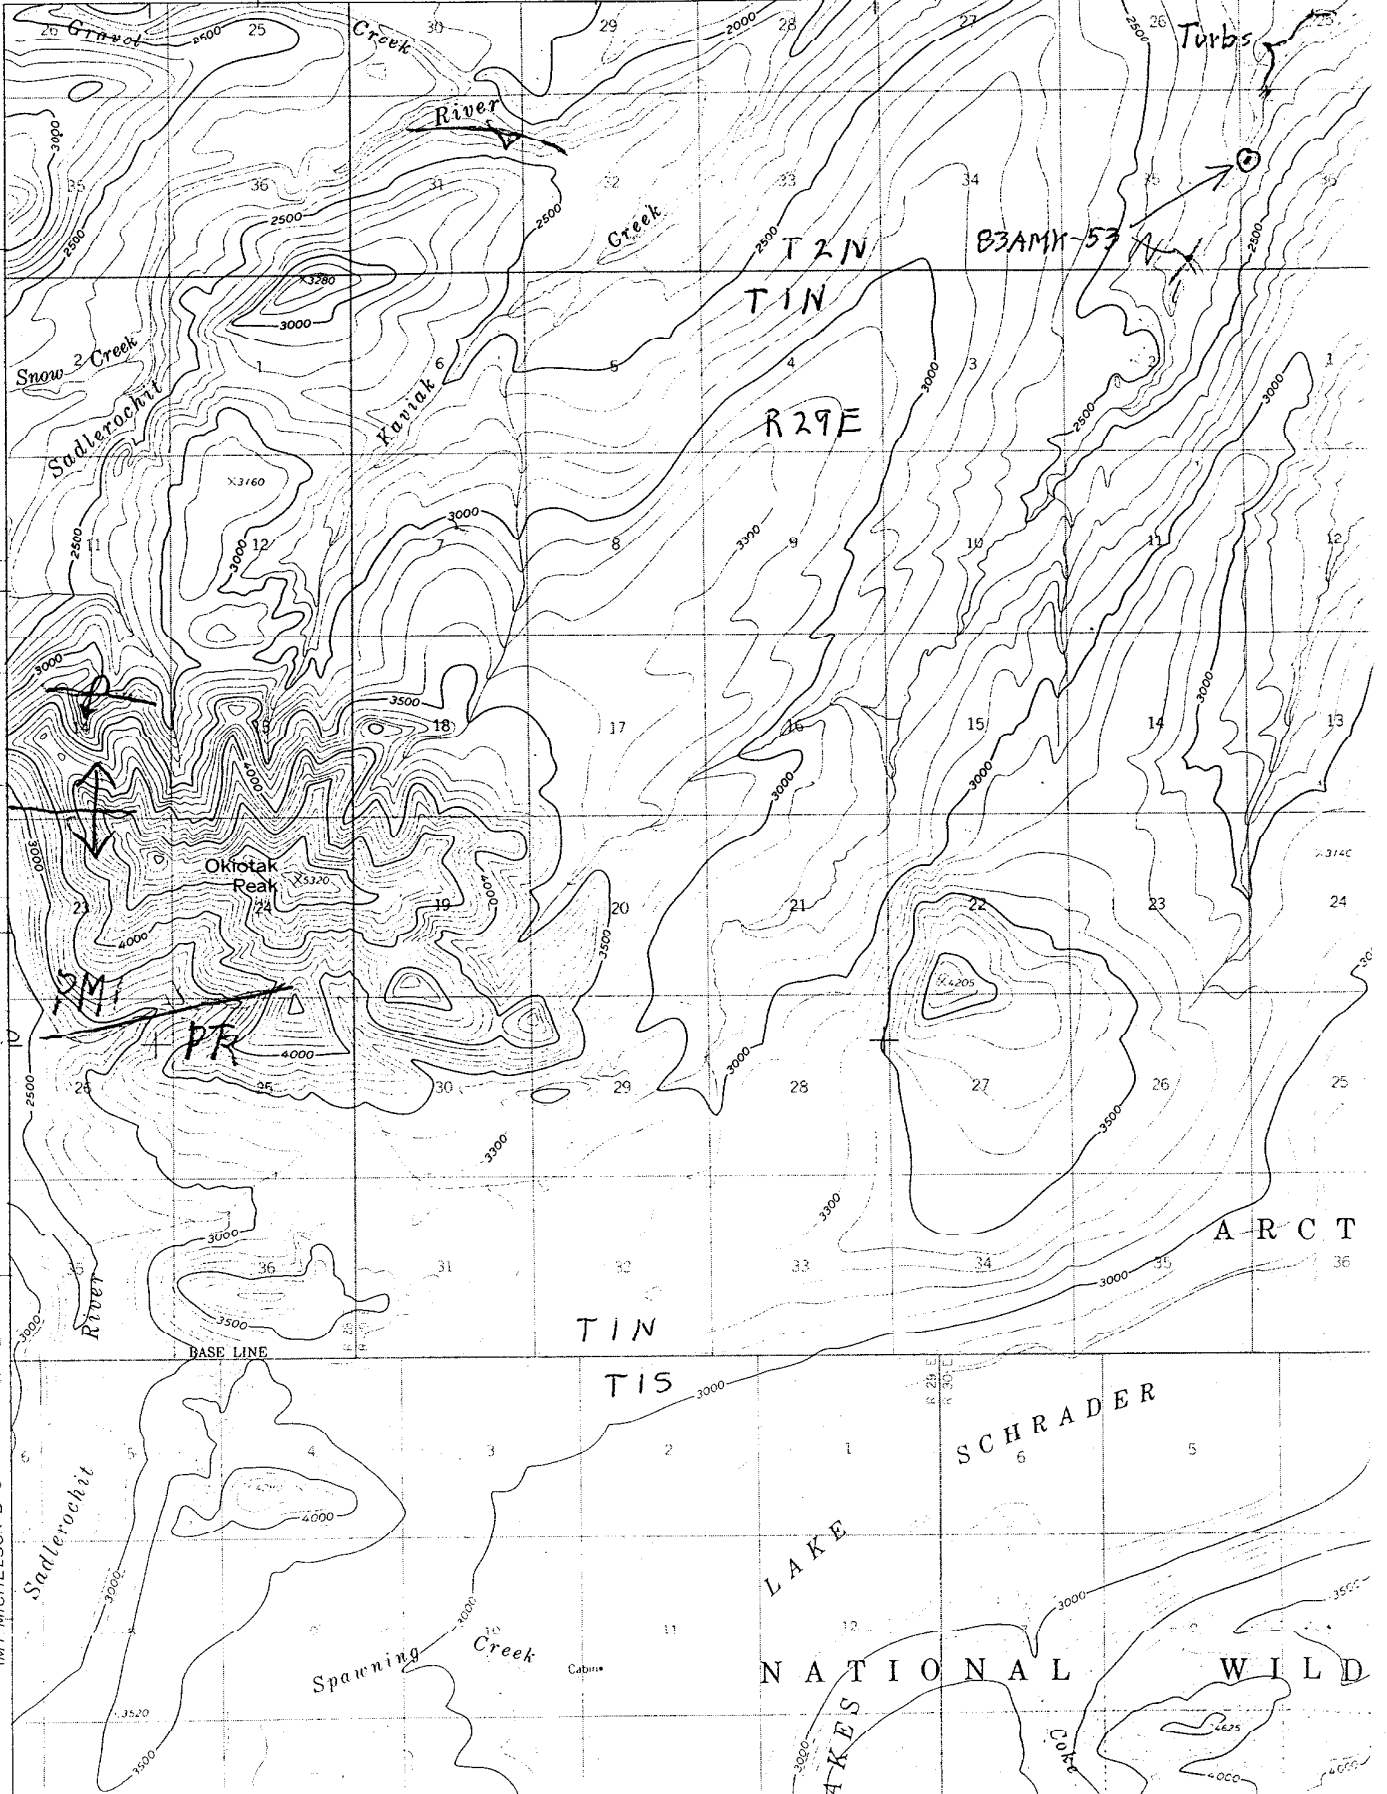

# Mt Michelson B-2 NE/4

MT. MICHELSON (B-2) QUADRANGLE  
ALASKA  
1:63 360 SERIES (TOPOGRAPHIC)

MT. MIC.

MICHELSON C-27


50° R. 30 E.

670 000 FEET


40' R. 30 E. R. 31 E.

144°36'

69°30'

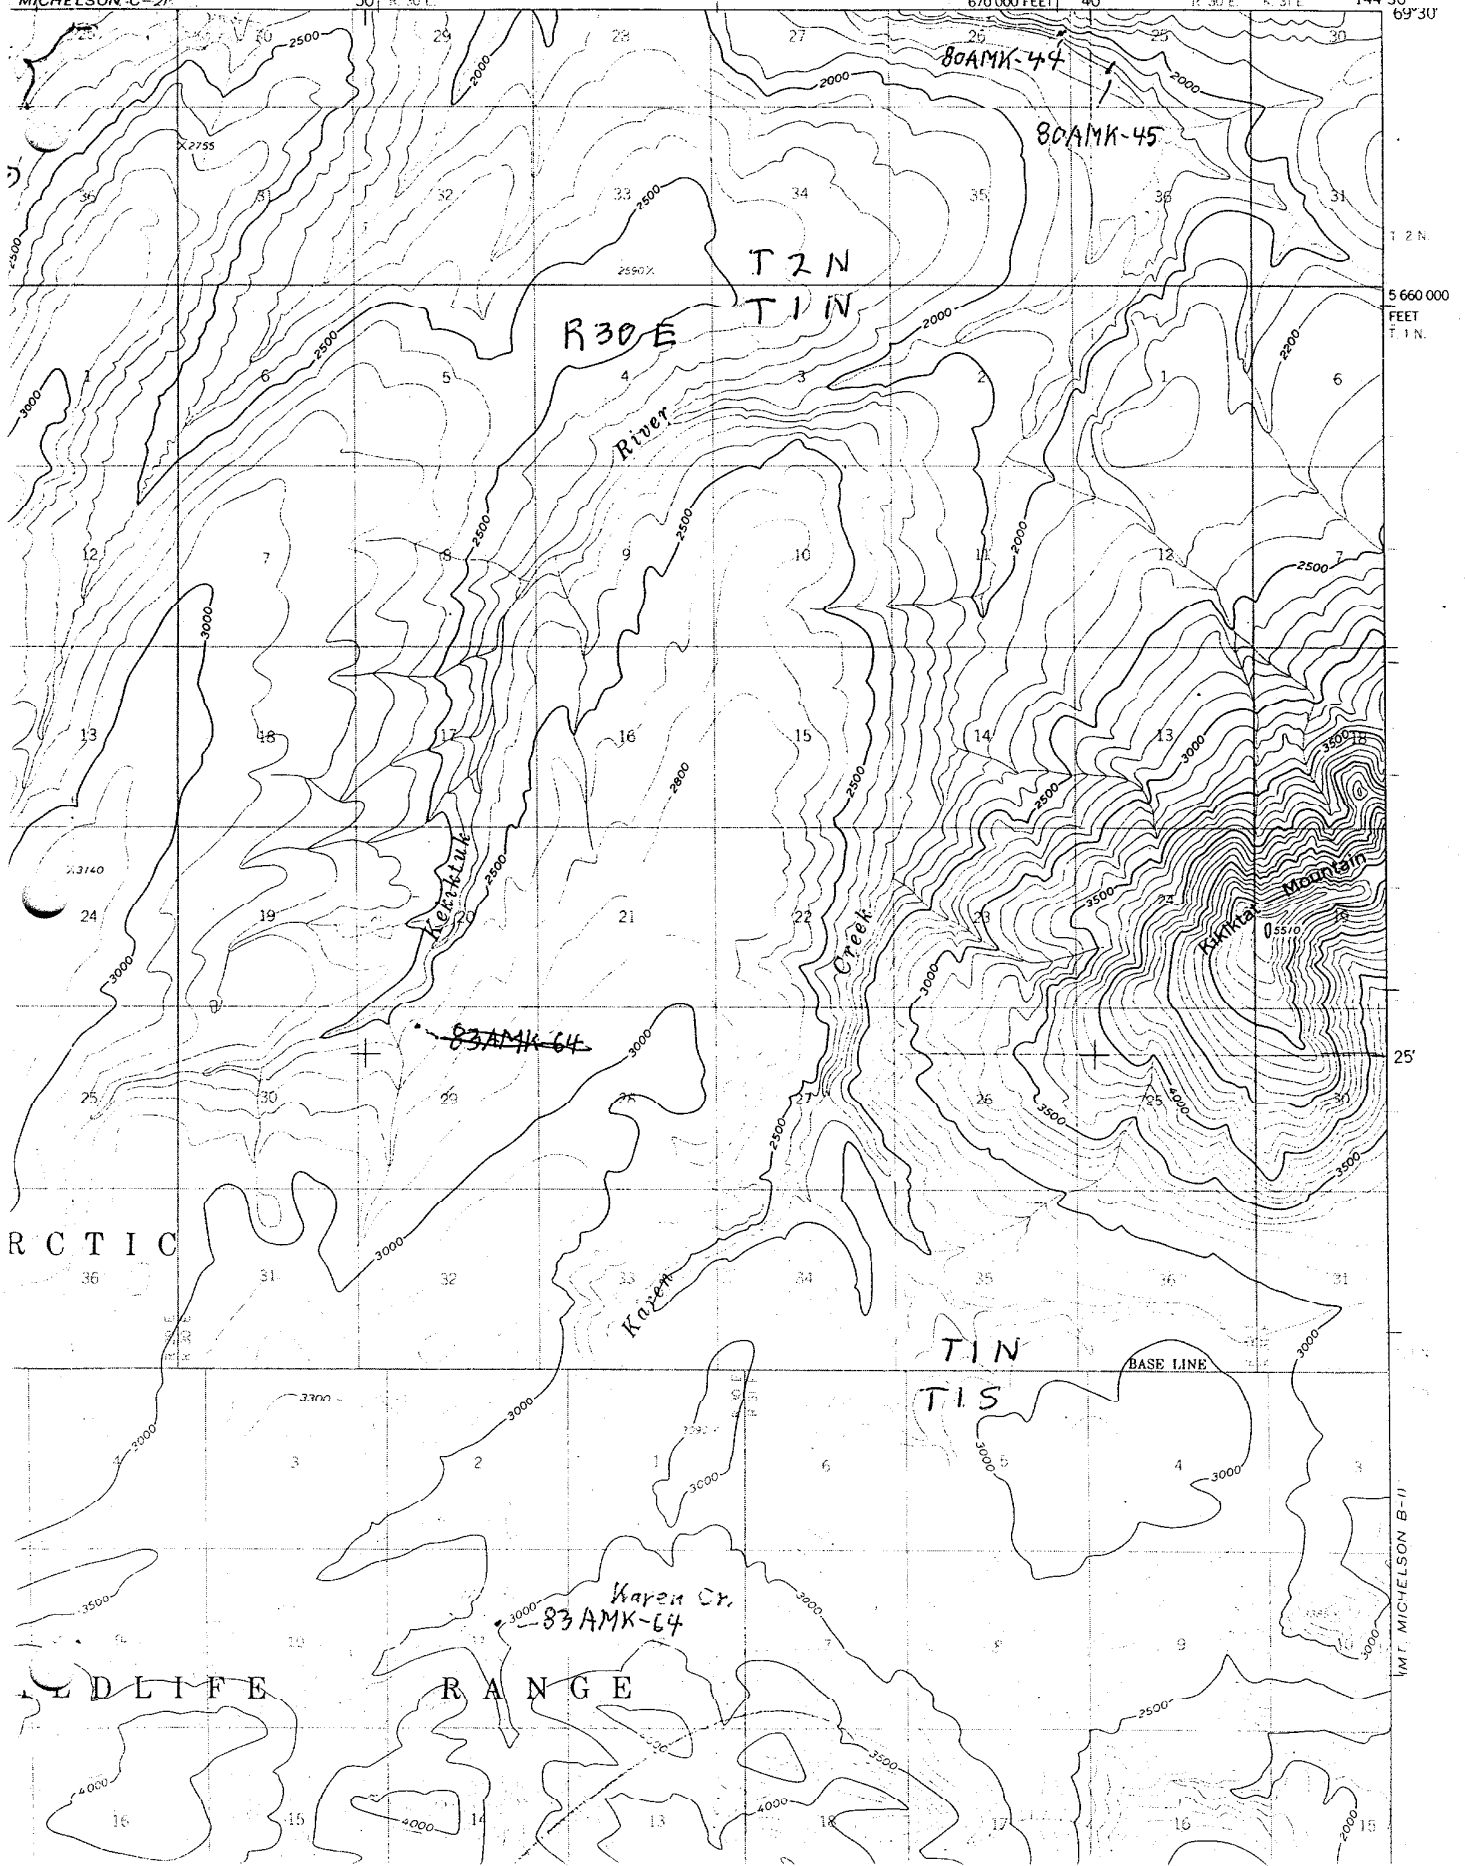


B-2 SW/4

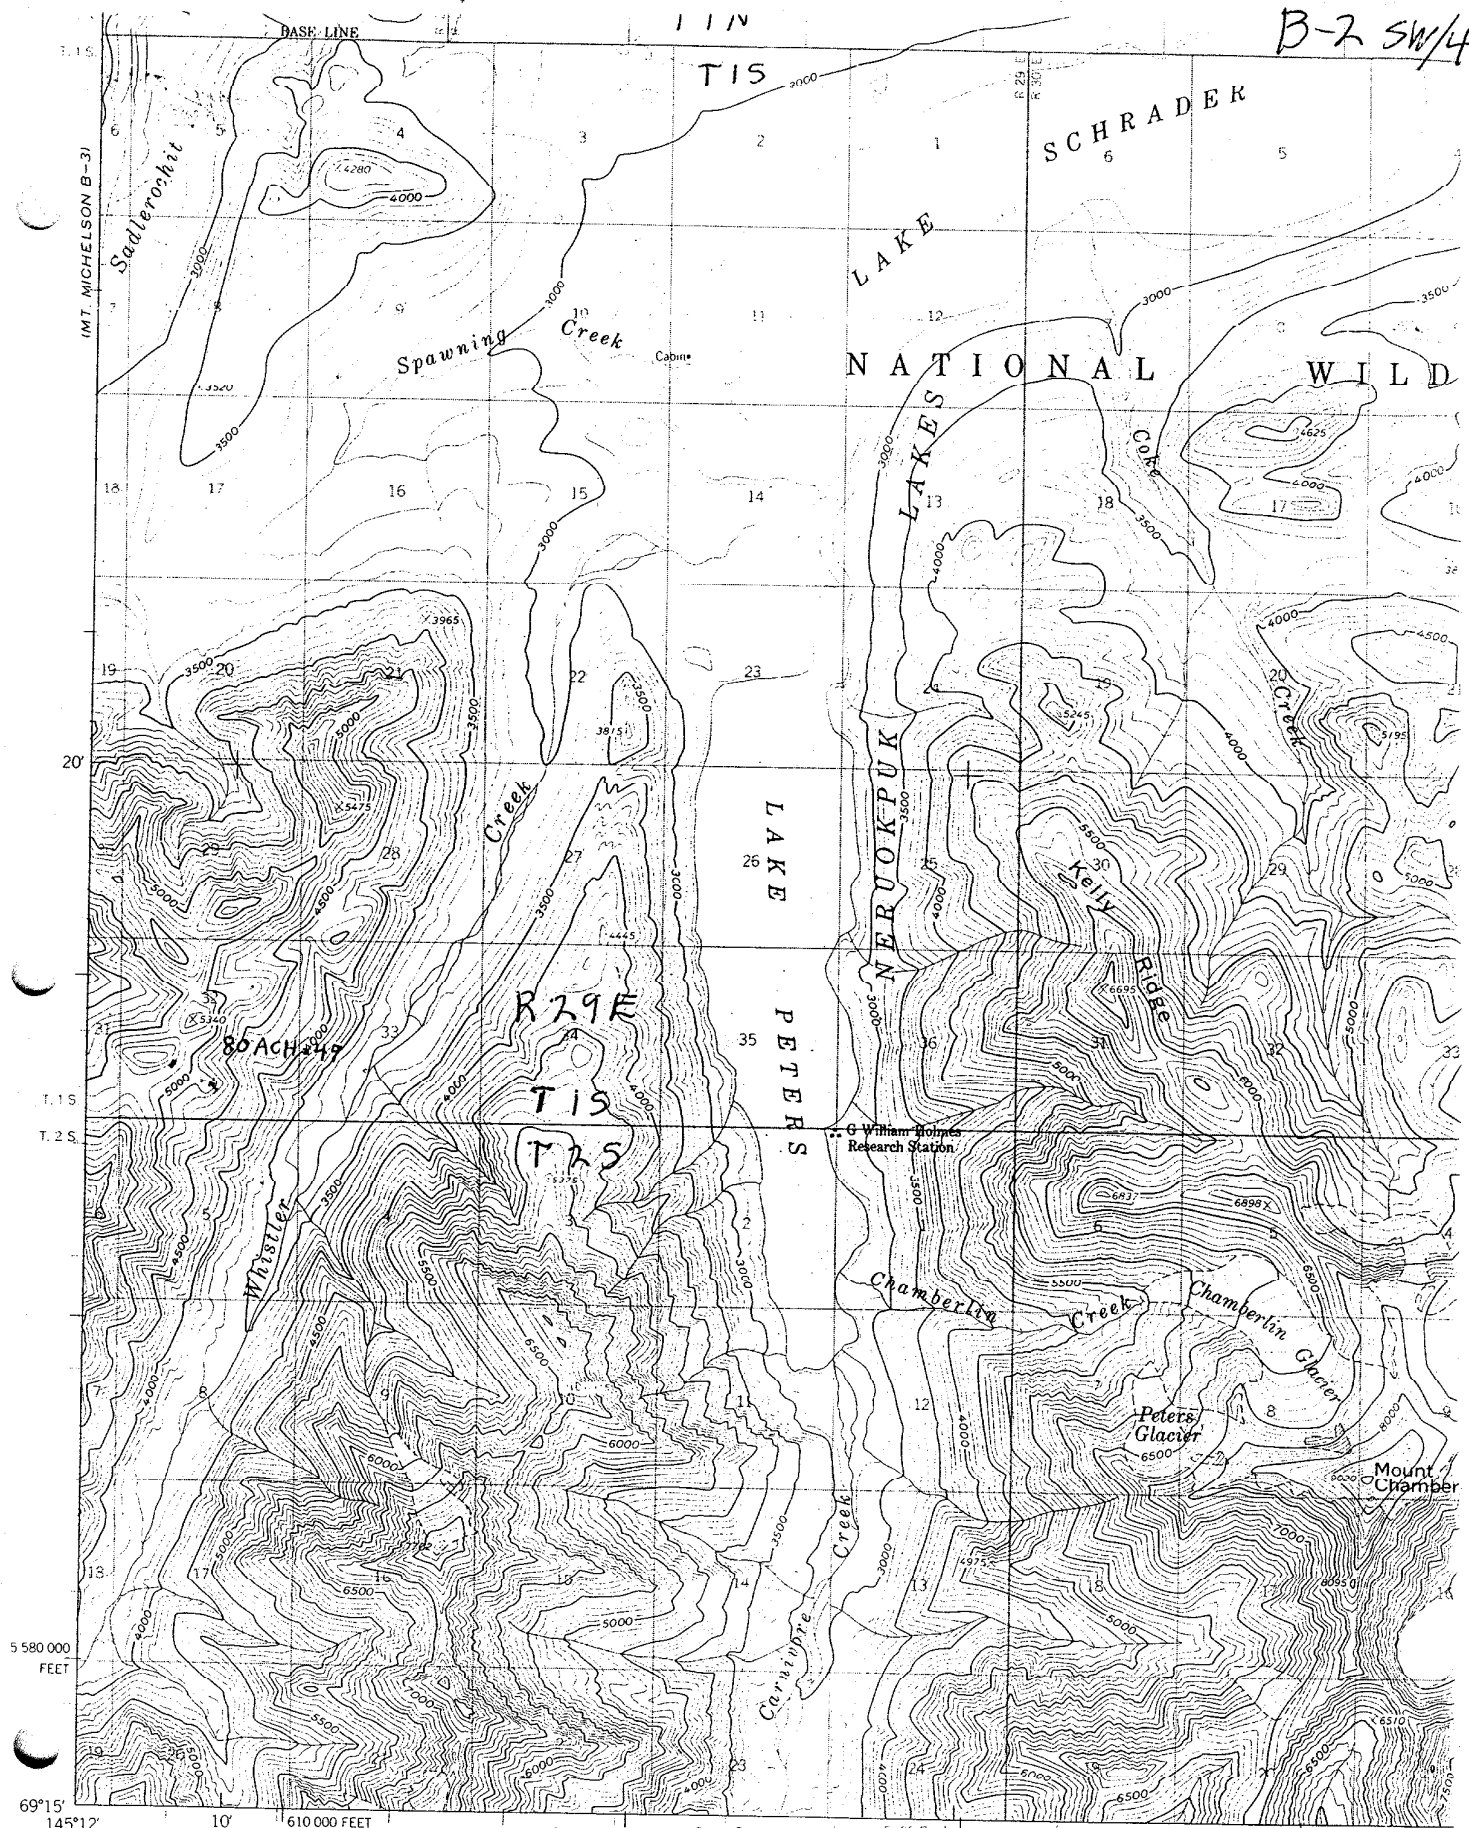

Mapped, edited, and published by the Geological Survey  
 Control by USC&GS and USCE  
 Topography by photogrammetric methods from aerial photographs  
 taken 1956. field annotated 1956. Map not field checked

Mt Michelson B-2 SW

SCALE 1:63360

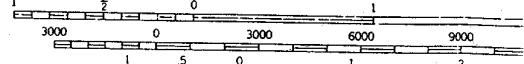

5 580 000  
FEET


69°15'  
145°12'

610 000 FEET

P. 29 E 145° P. 30 E




MT Michelson B-3 (NW)

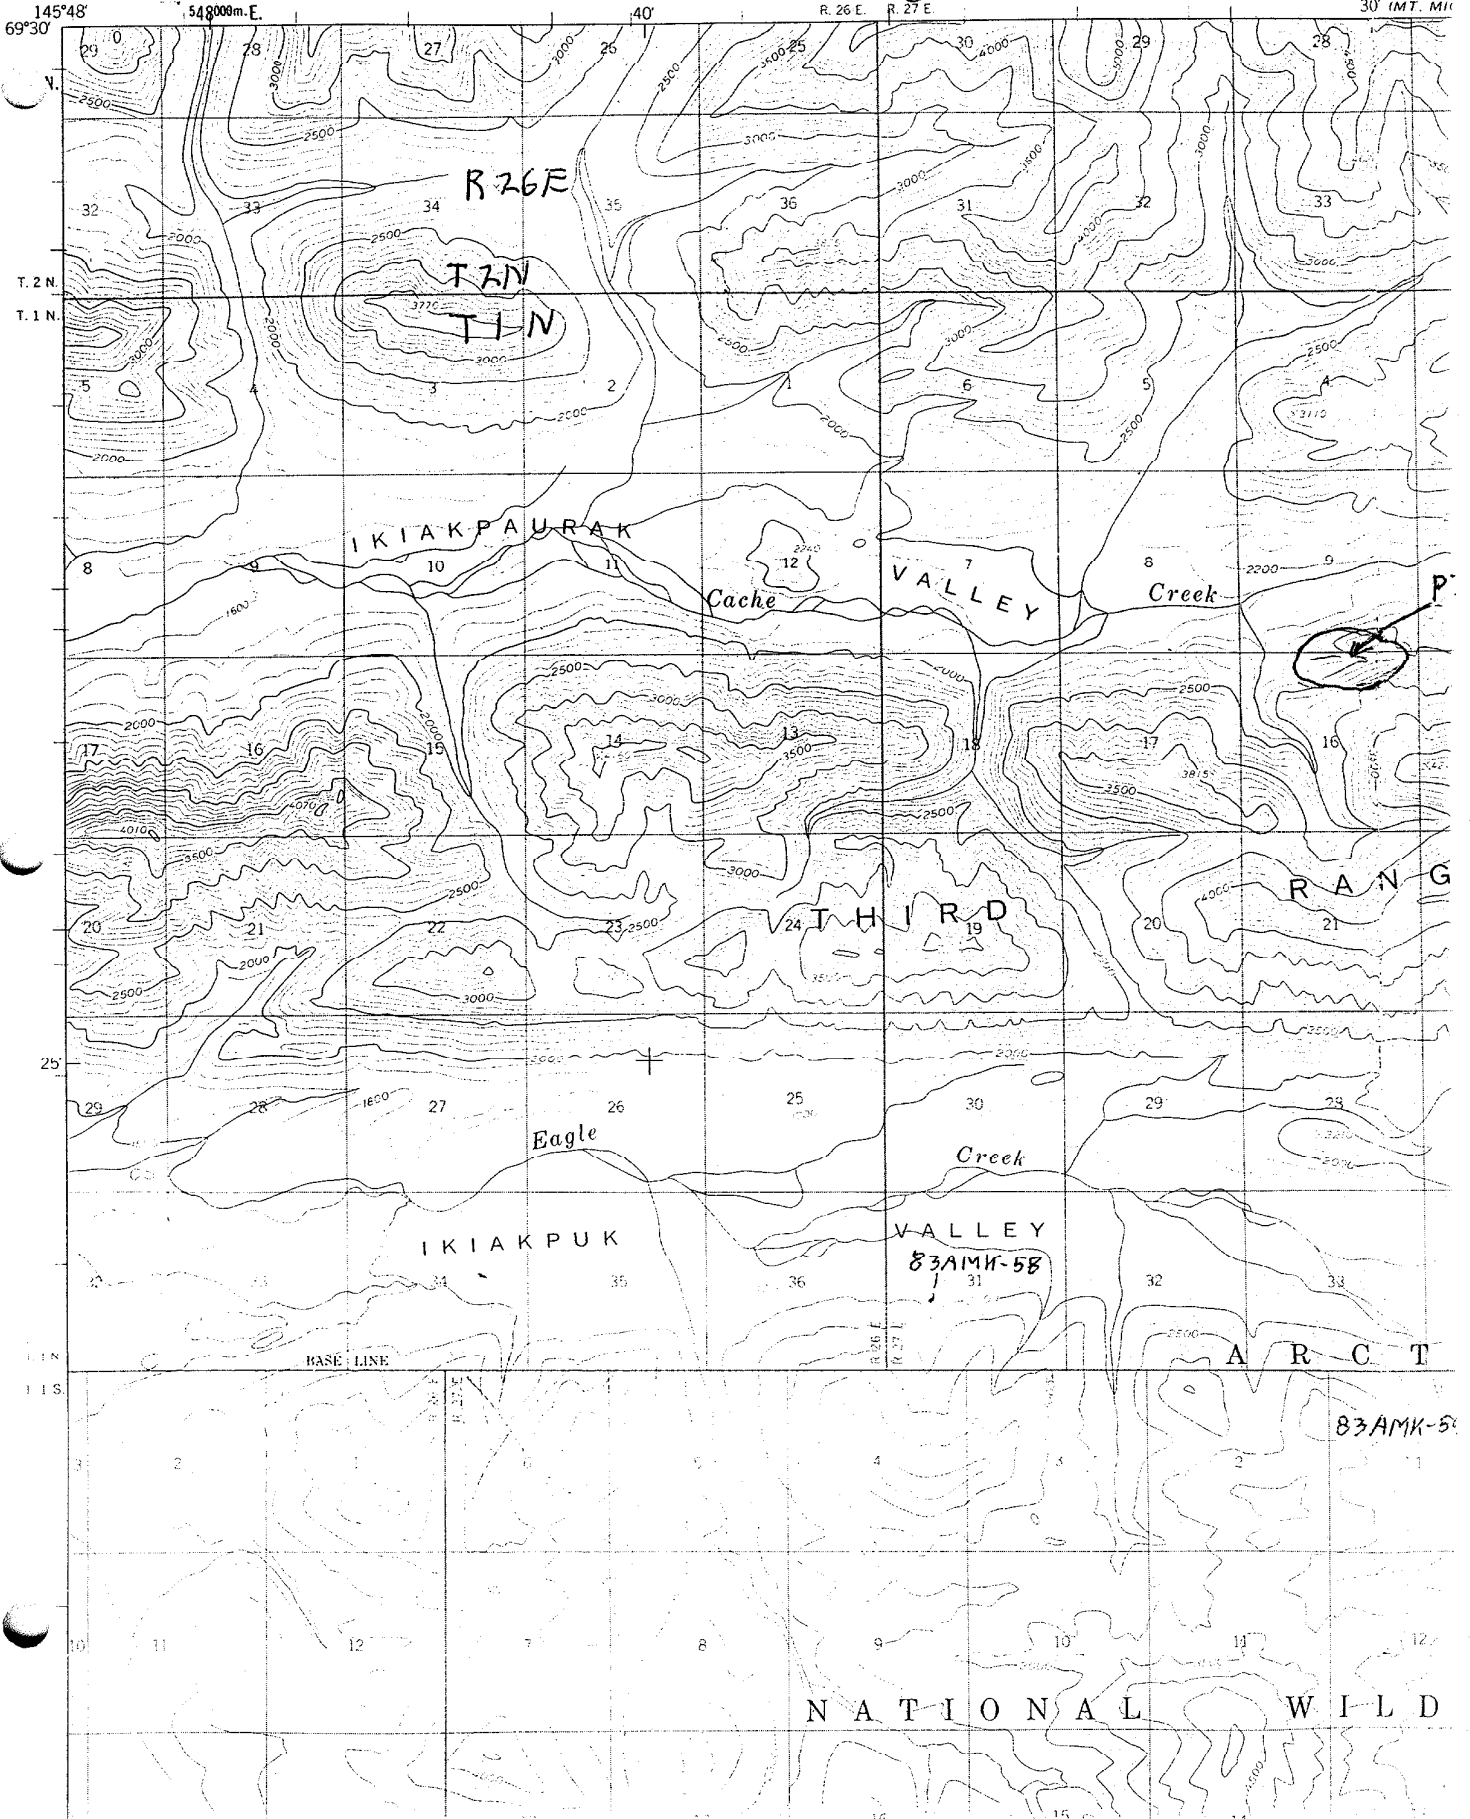

MT Michelson B-3 (NE/4)

MT. MICHELSON (B-3) QUADRANGLE  
ALASKA NORTH SLOPE BOROUGH  
1:63 360 SERIES (TOPOGRAPHIC)

MT. MICH

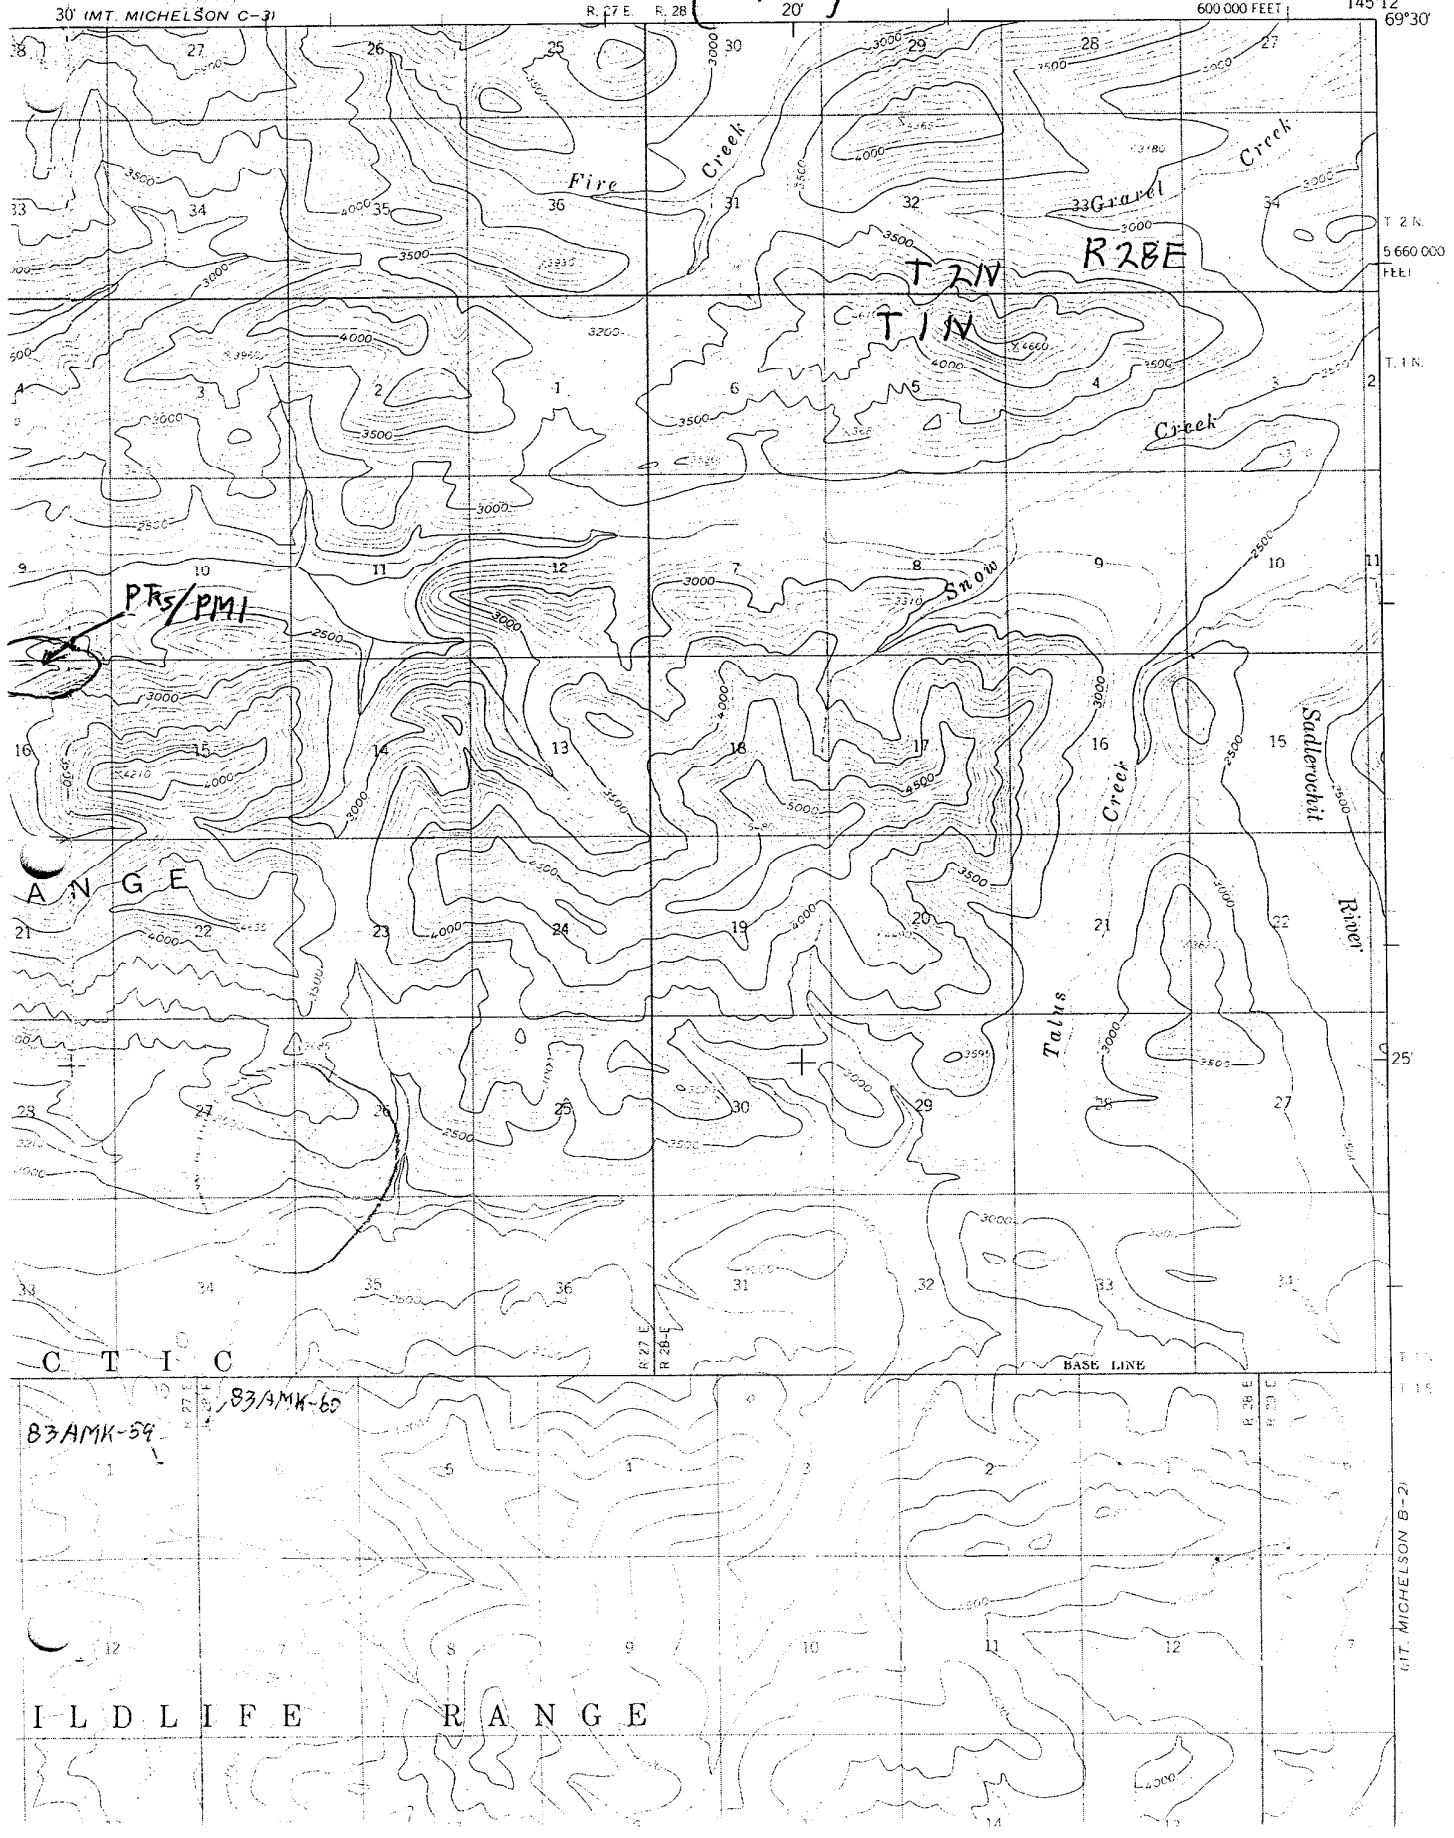

B3AMK-59

B3AMK-60

ILD LIFE RANGE


MT. MICHELSON B-3


UNITED STATES  
DEPARTMENT OF THE INTERIOR  
GEOLOGICAL SURVEY

Mt Michelson B-4 NW  
(Station prefix is 30 AMK)

146° 24' 525000E 20' 69° 30'

10' 535

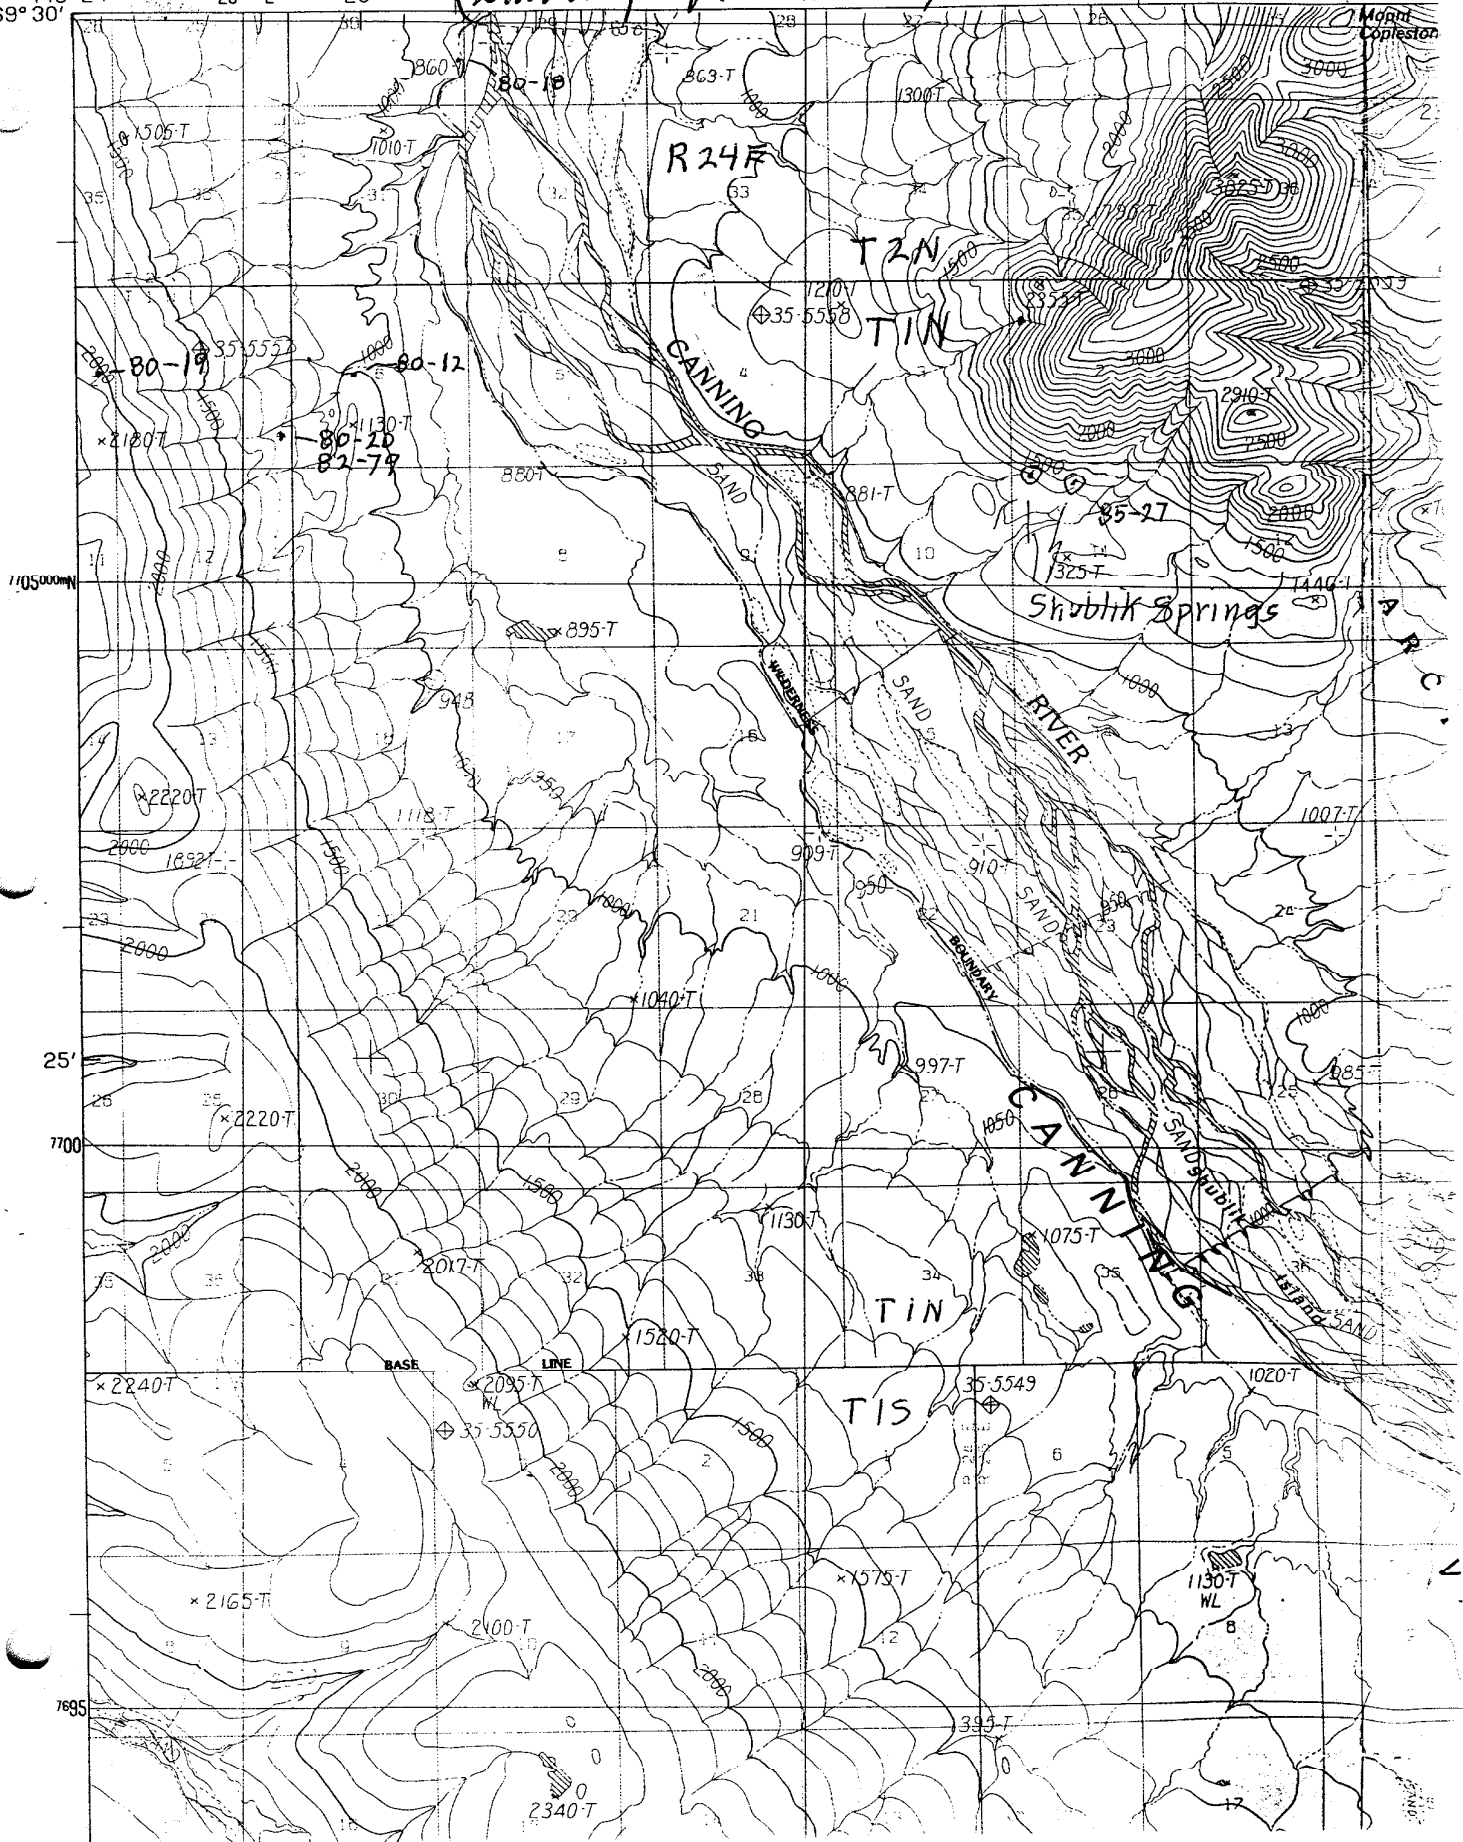

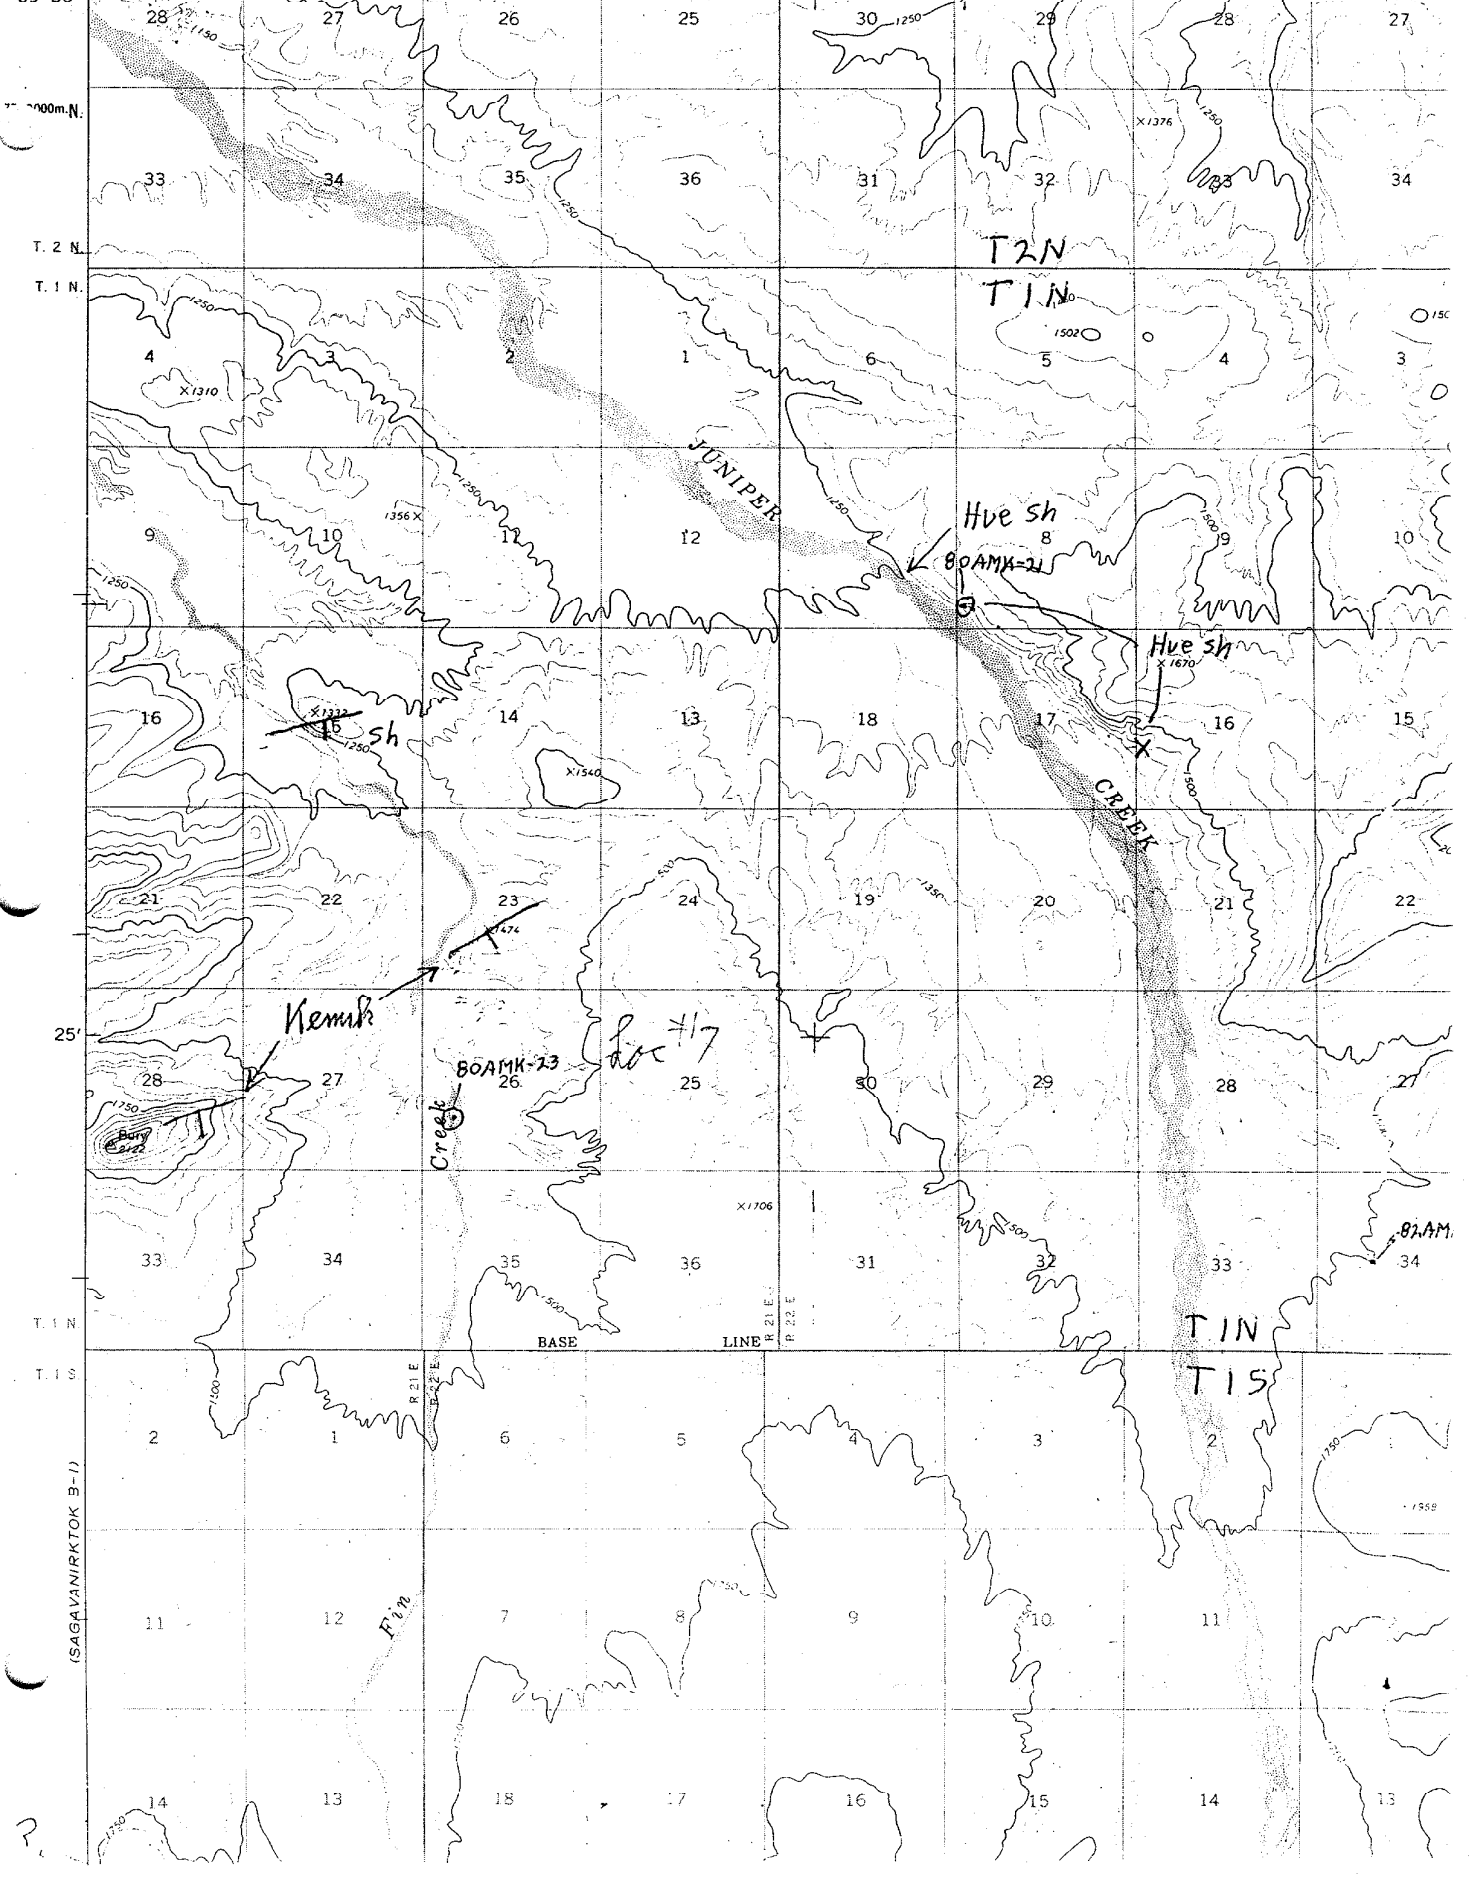


ISAGAVIRKTOK B-11

# MT Michelson B-5 (NE)

ALASKA  
1:63 360 SERIES (TOPOGRAPHIC)

(INT. MI)

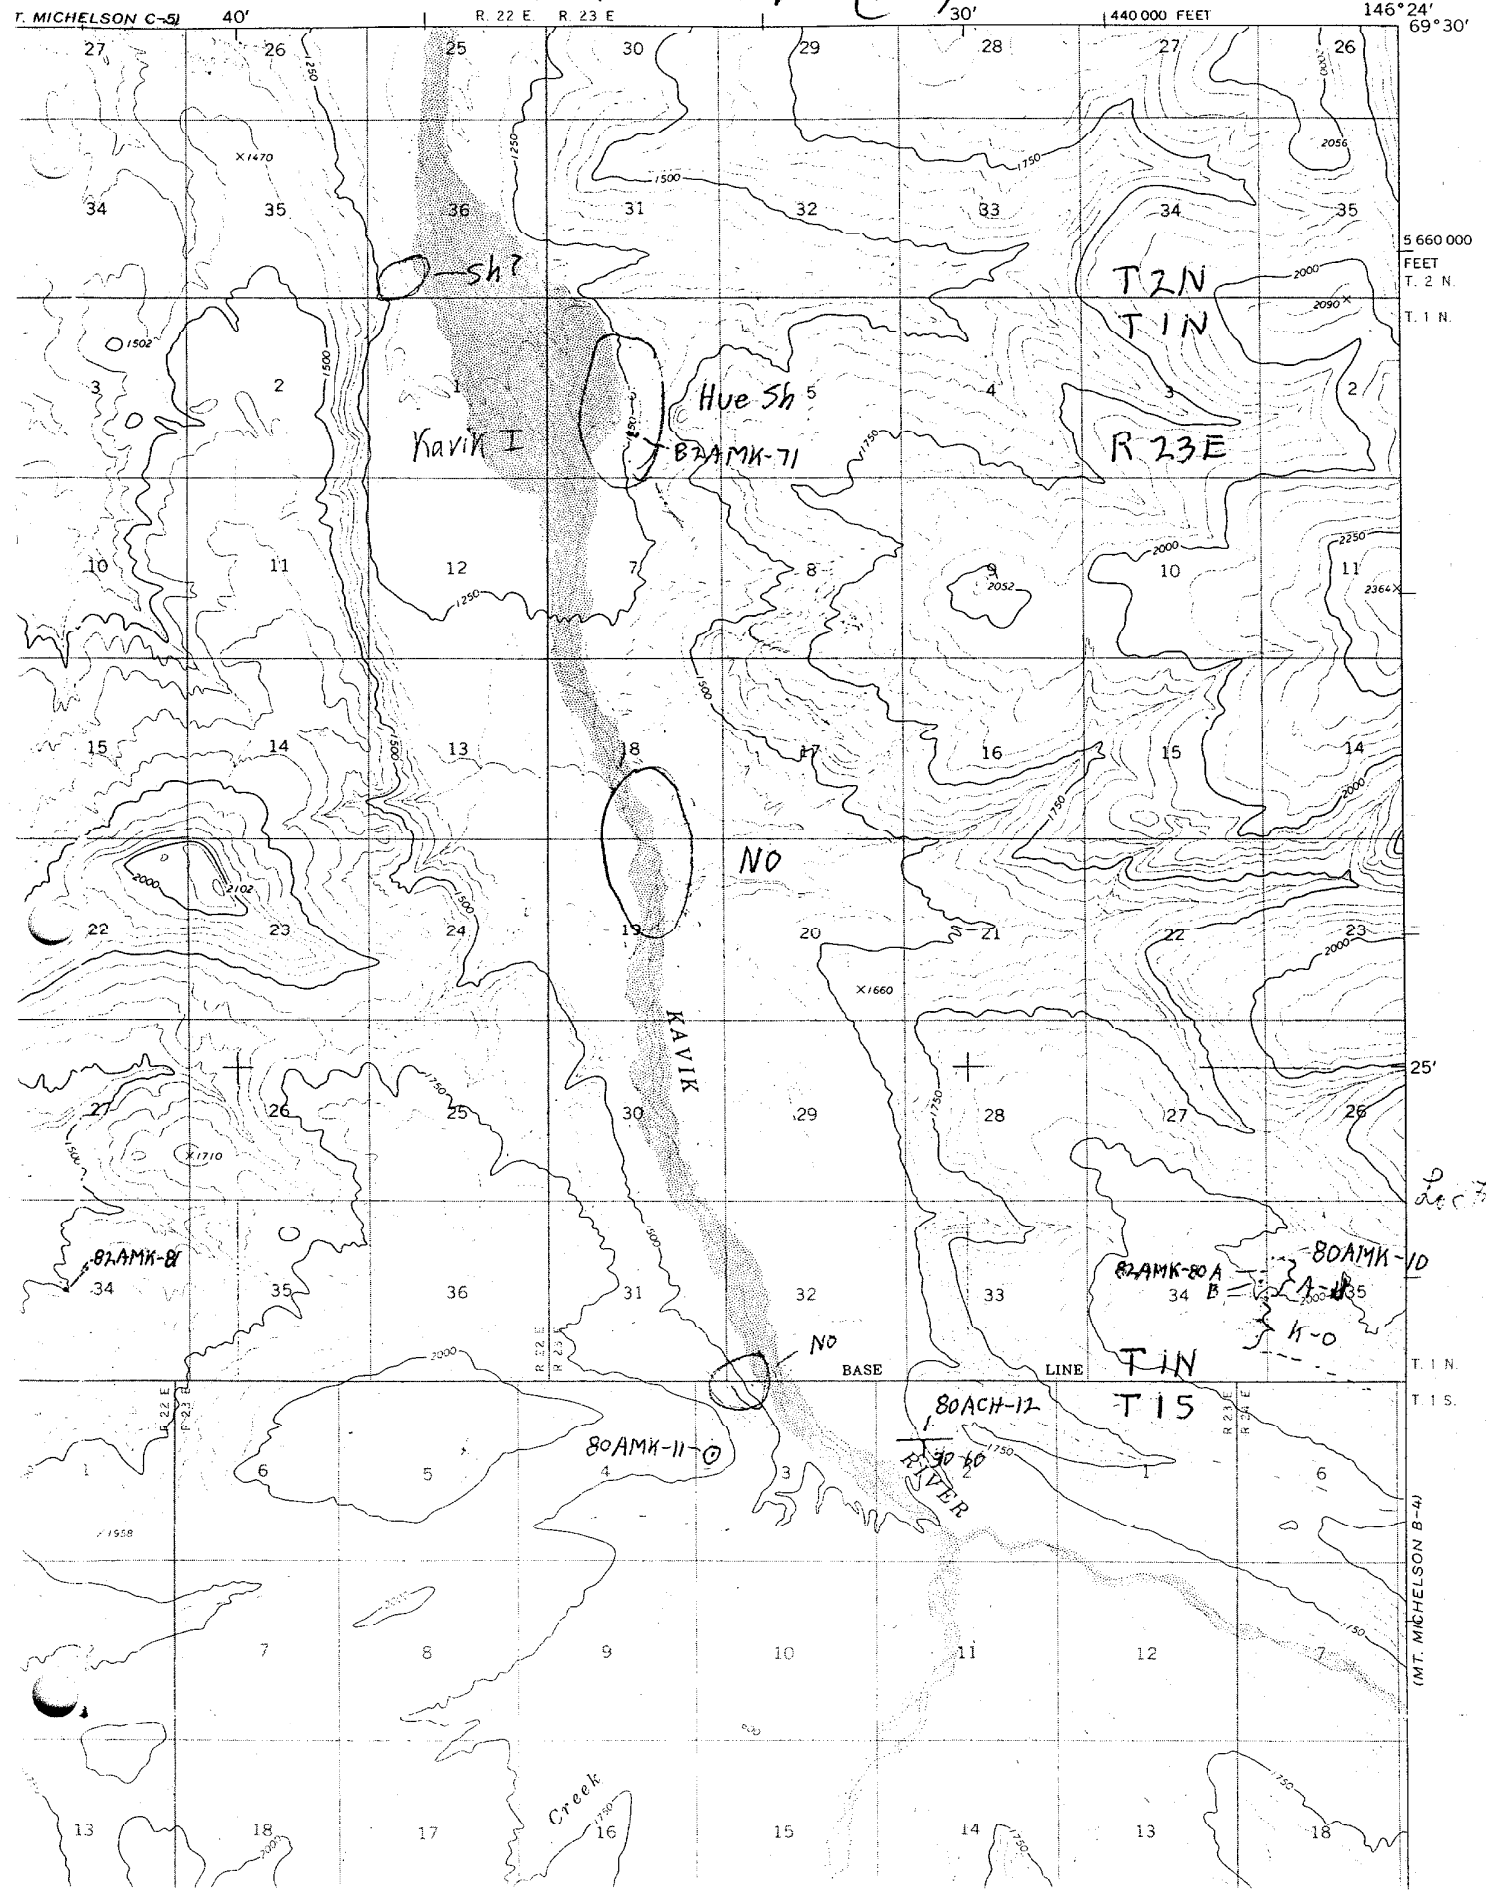

5 660 000  
FEET  
T. 2 N  
T. 1 N.

D  
dec 7

(INT. MICHELSON B-4)

UNITED STATES  
DEPARTMENT OF THE INTERIOR  
GEOLOGICAL SURVEY

C-1 Mt Michelson  
NW/4

144°36' 69°45' 594000m.E. R. 30.E. 30' R. 31.E. 20' (MT. MICHELSON)

7739000m.N

T. 5 N  
T. 4 N

18

19

30

40

31

T. 4 N  
T. 3 N

6


7

18

X = Landing site

INT. MICHELSON C-21

18

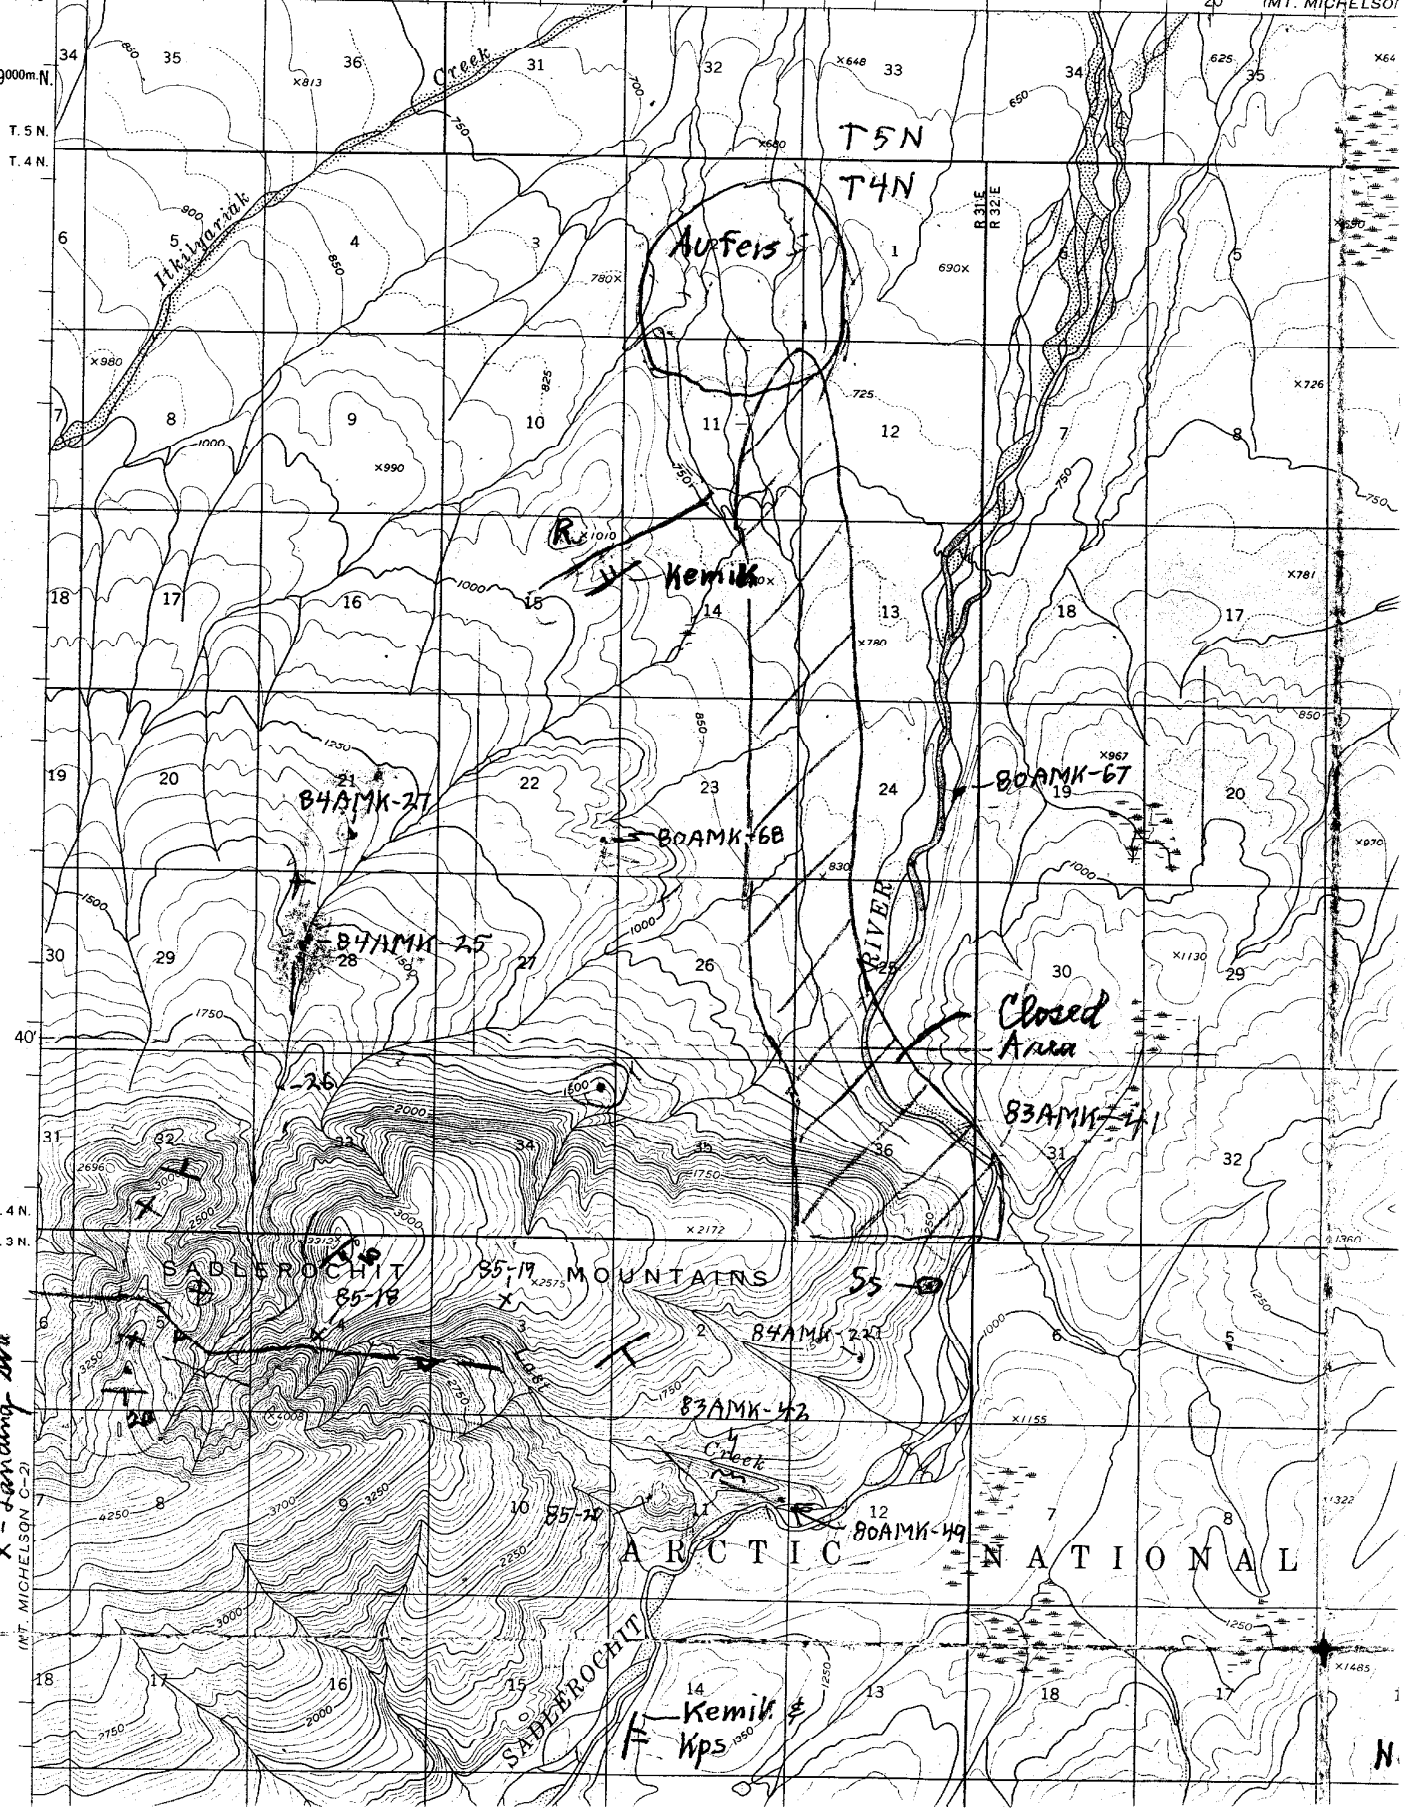

N


Mt Michelson C-1 NE/4

MT. MICHELSON (C-1) QUADRANGLE


ALASKA

1:63 360 SERIES (TOPOGRAPHIC)

10' 750 000 FEET 144°00' 69°45'

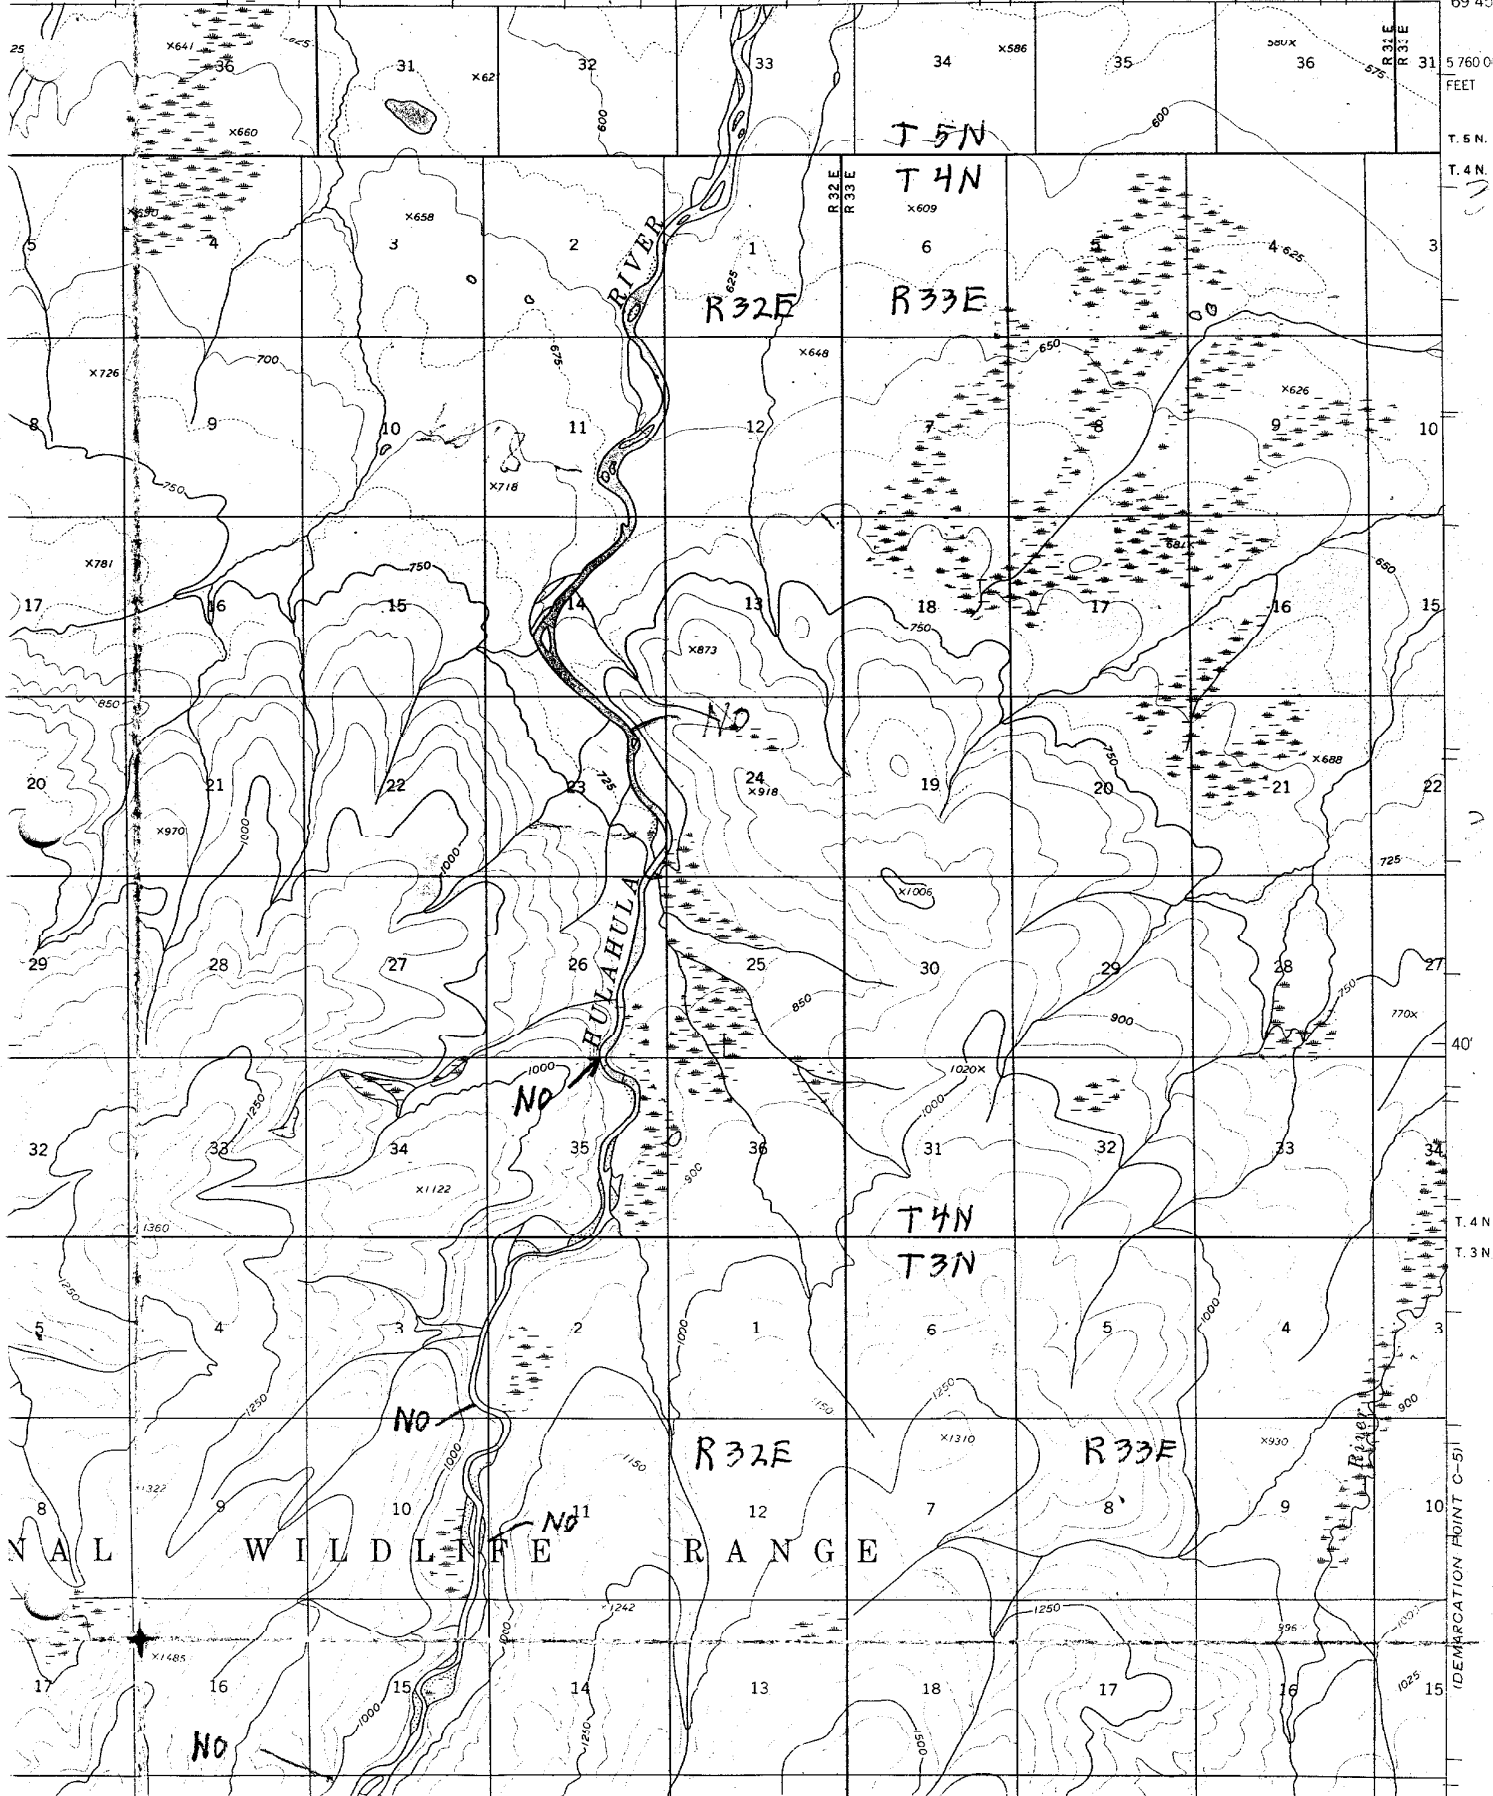

X = Landing Site

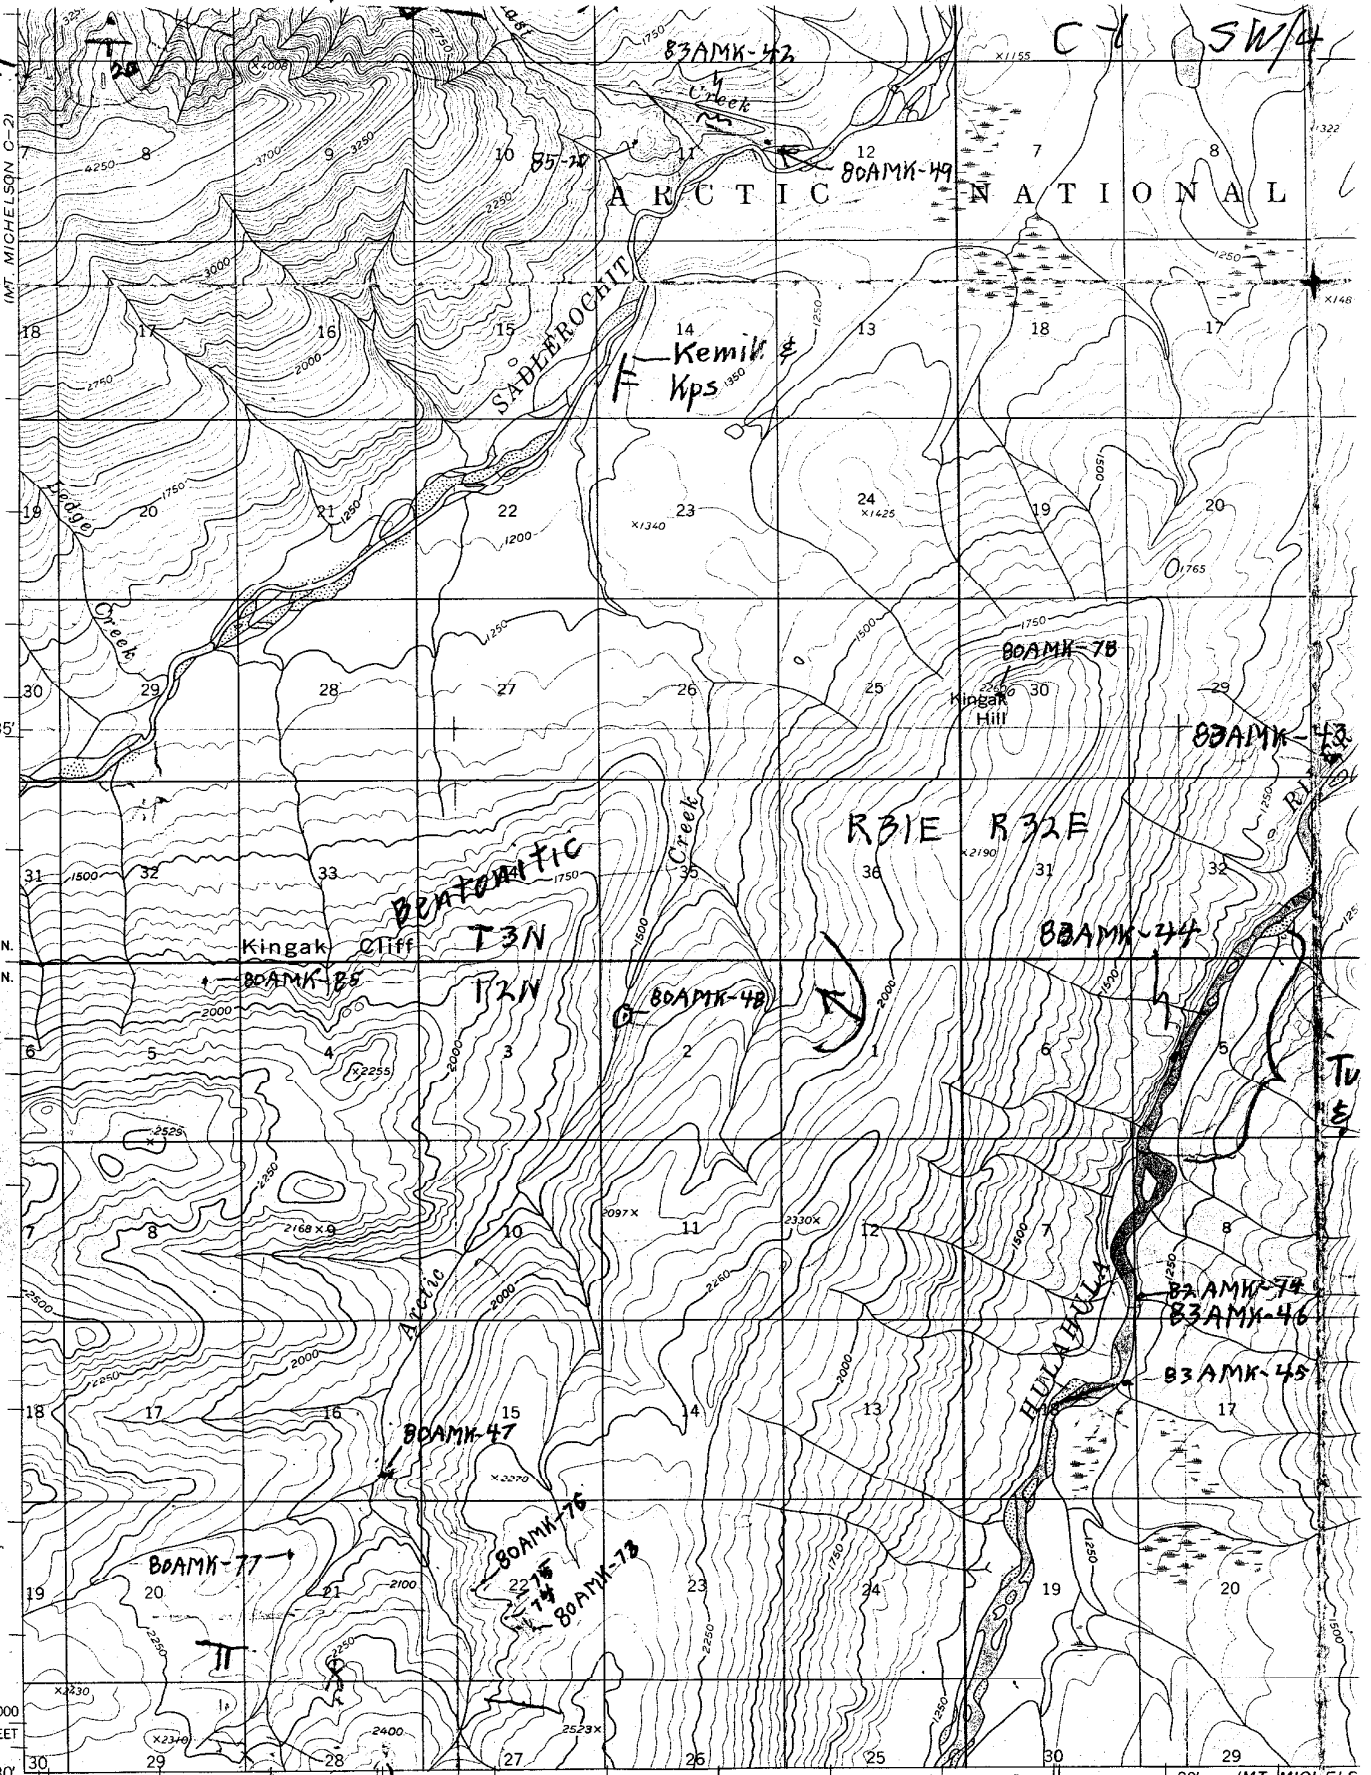


5670 000  
FEET  
R9°30' 144°36'


Map by the Army Map Service  
Edited and published by the Geological Survey  
Control by USC&GS and USCE  
Topography by photogrammetric methods from aerial photographs  
taken 1955, field annotated 1955. Map not field checked  
Universal Transverse Mercator projection. 1927 North American datum

Mt. Michelson C1 SW/4

C-1

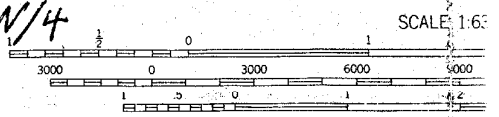


MICHELSON B-2

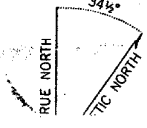


CONTOUR INTERVAL.  
DOTTED LINES REPRESENT



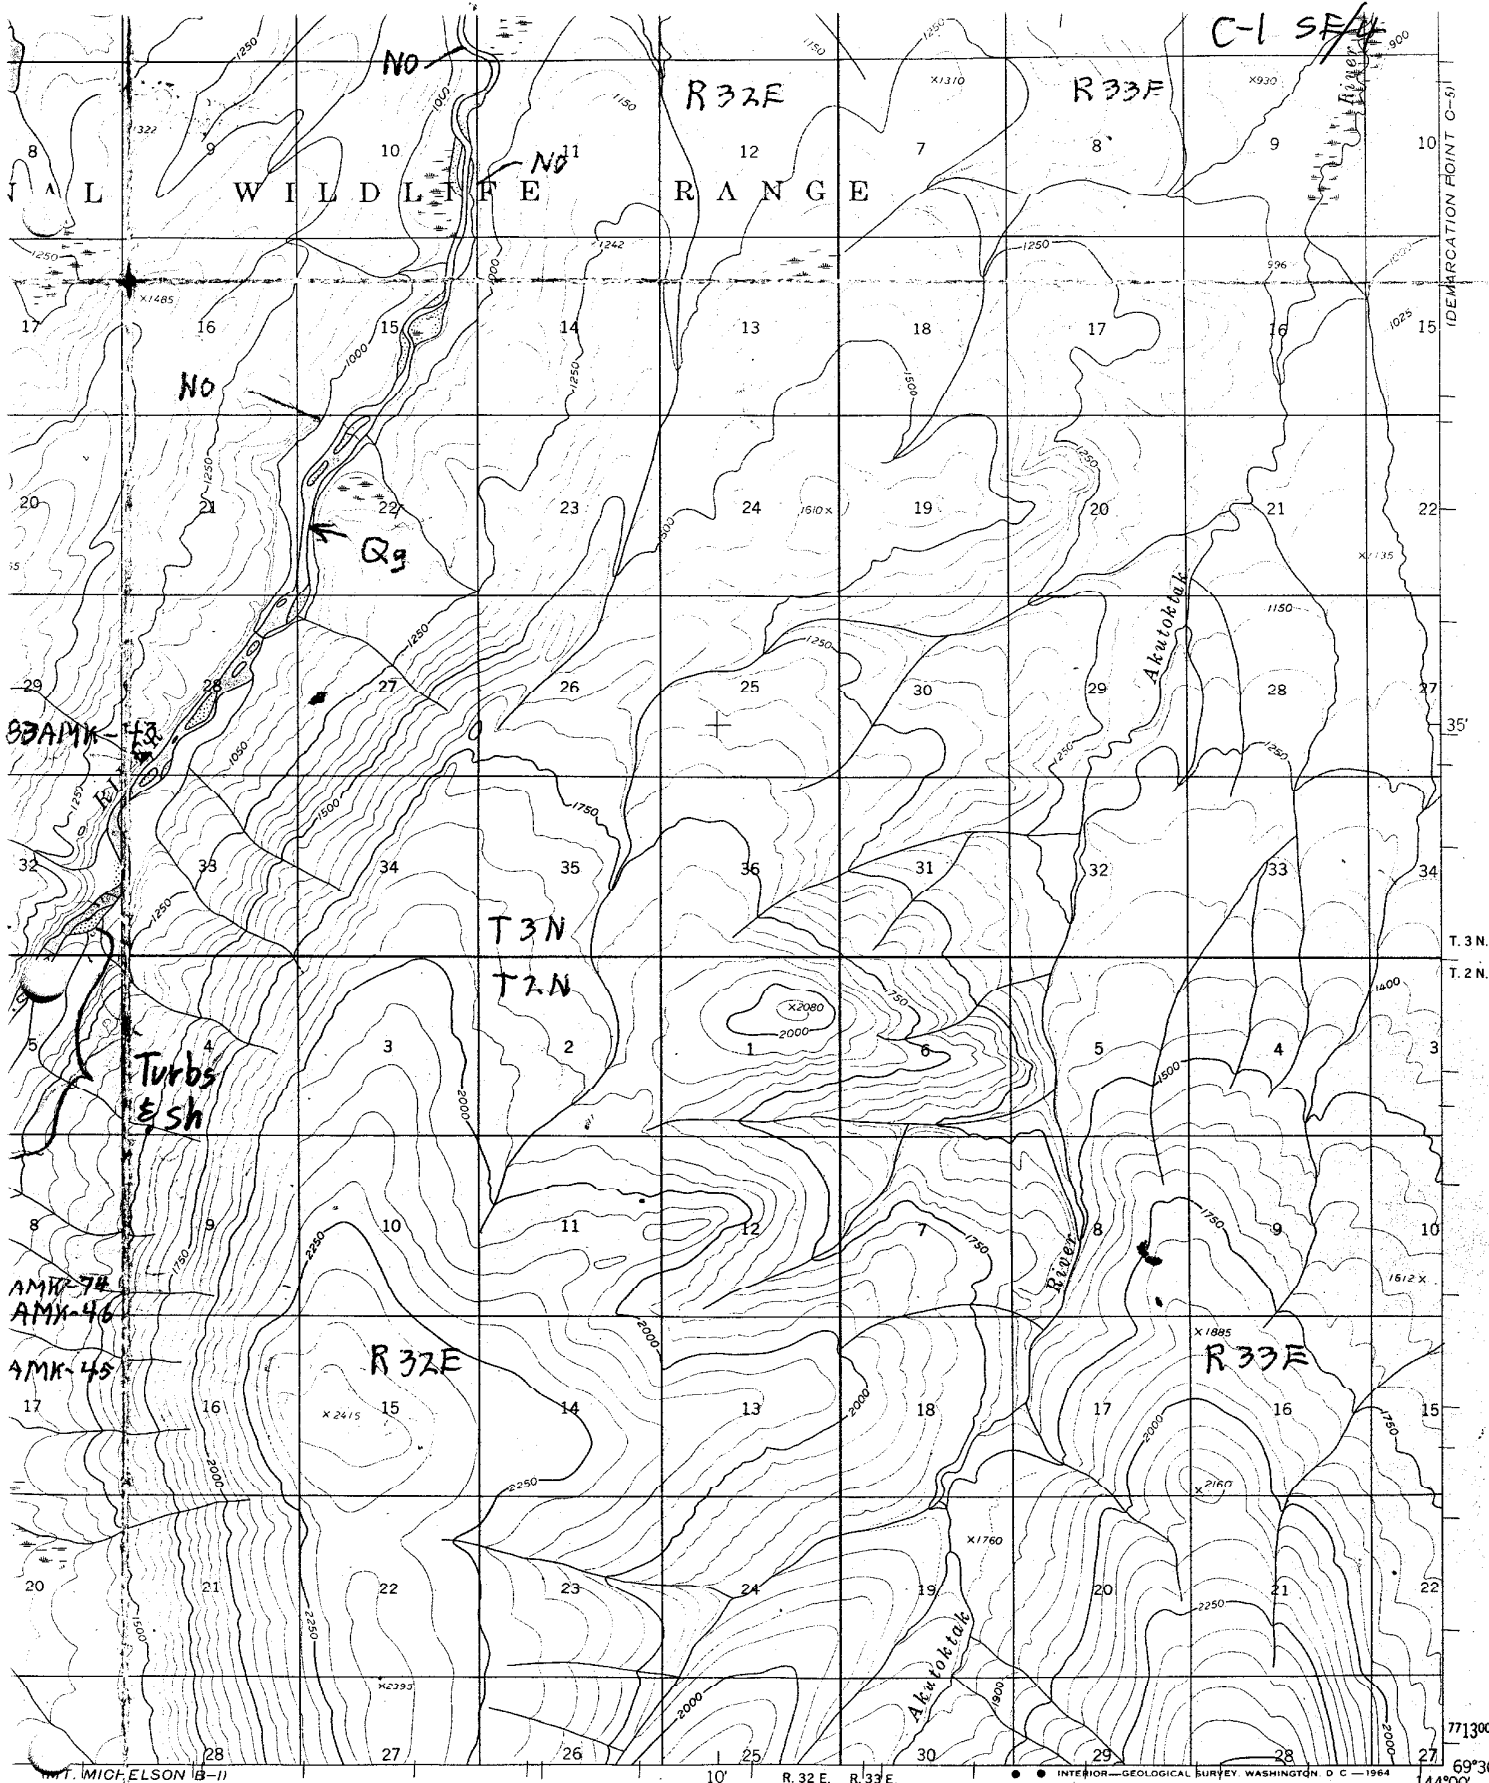


C-1 SE/4

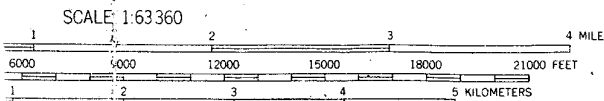

Mt Michelson  
 SE/4 C-1

CONTOUR INTERVAL 50 FEET  
 THICK LINES REPRESENT 25-FOOT CONTOURS  
 DATUM IS MEAN SEA LEVEL

ROAD CLASSIFICATION  
 No roads or trails in this area

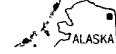

INTERIOR GEOLOGICAL SURVEY WASHINGTON D.C. 1984  
 1:63,360

771300  
 69°30'  
 144°00'

UNITED STATES  
DEPARTMENT OF THE INTERIOR  
GEOLOGICAL SURVEY

C-2  
MT. MICHELSON C-2 NW/4

R = Red weathering tuff  
of Hue Shale

145°12' 570000m E. 10'  
69°45'

7738000m N.

T. 5 N.


T. 4 N.

40'

T. 4 N.

T. 3 N.

MT. MICHELSON C-3

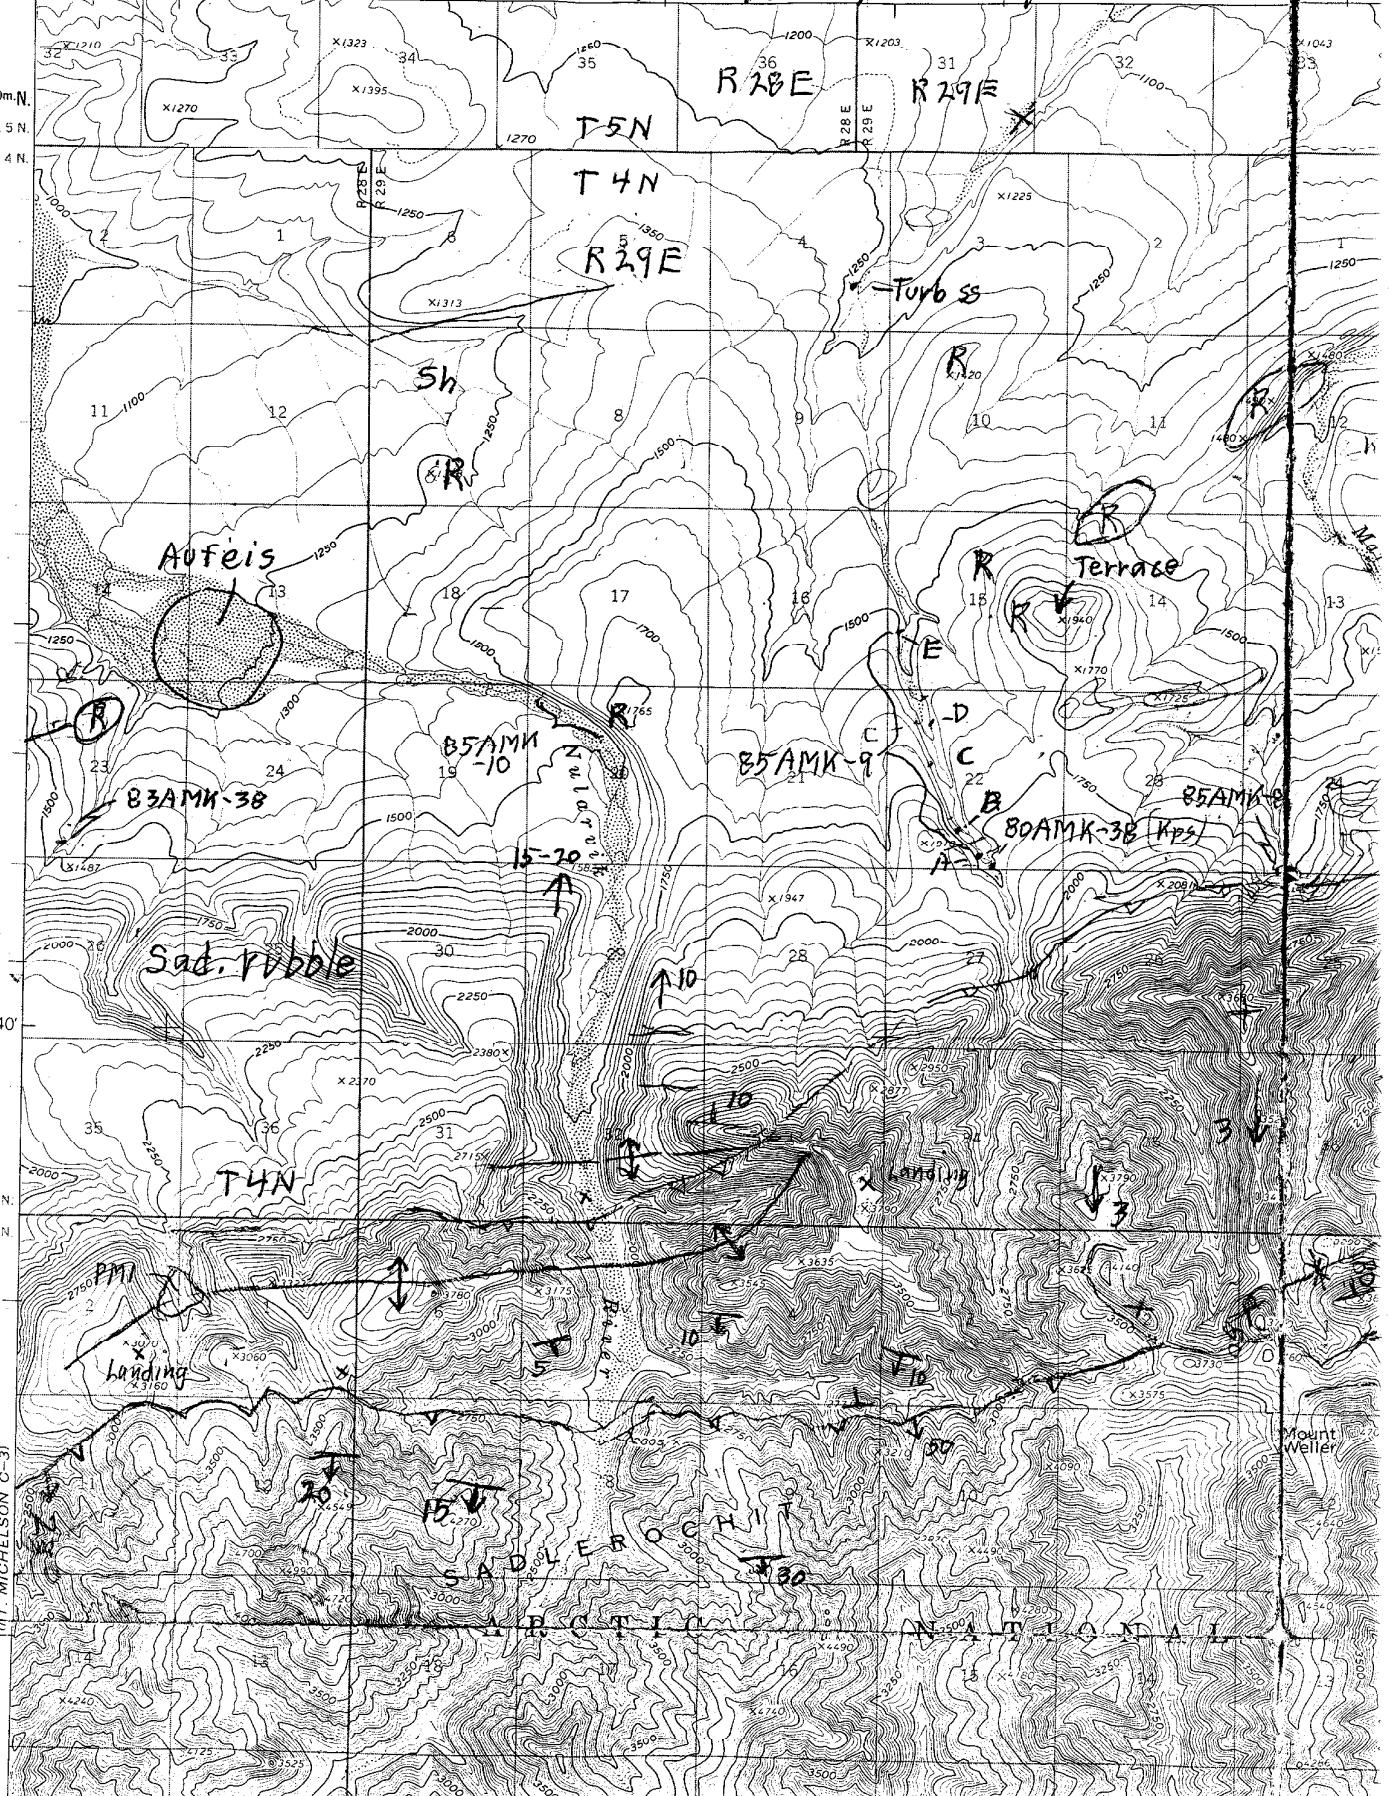

MT. MICHELSON (C-2) QUADRANGLE


ALASKA

1:63 360 SERIES (TOPOGRAPHIC)


144°36' 69"45"

C-2  
MT. Michelson NE/4


1  
2  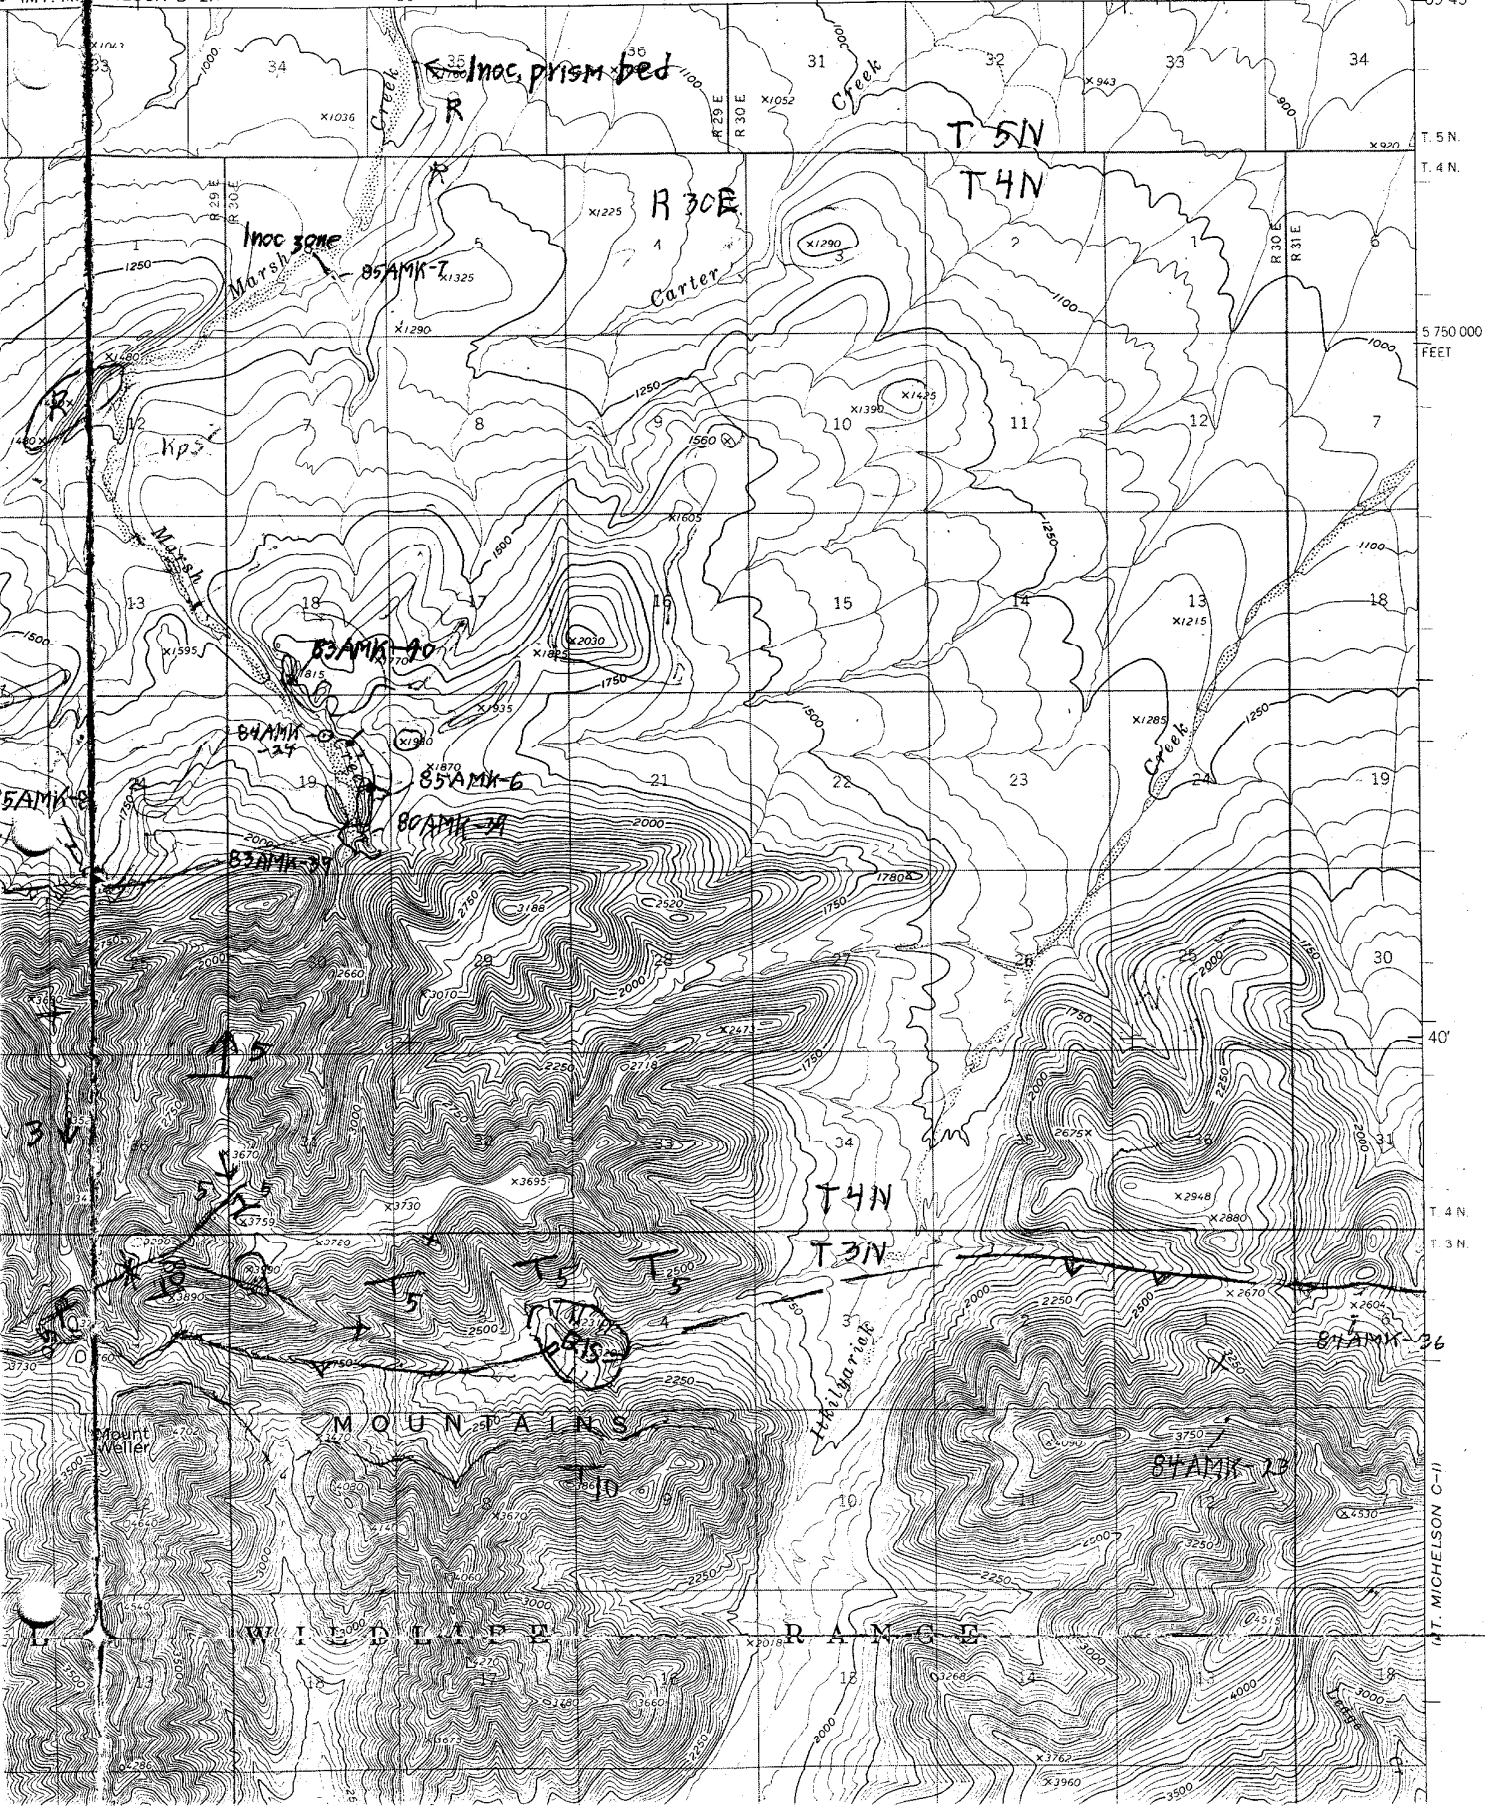
MOUNTAINS  
WILDFLEET RANGE

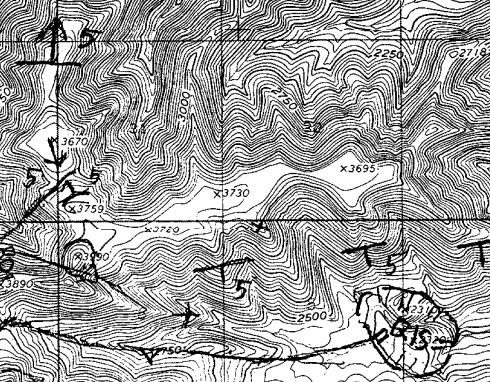


1  
2  
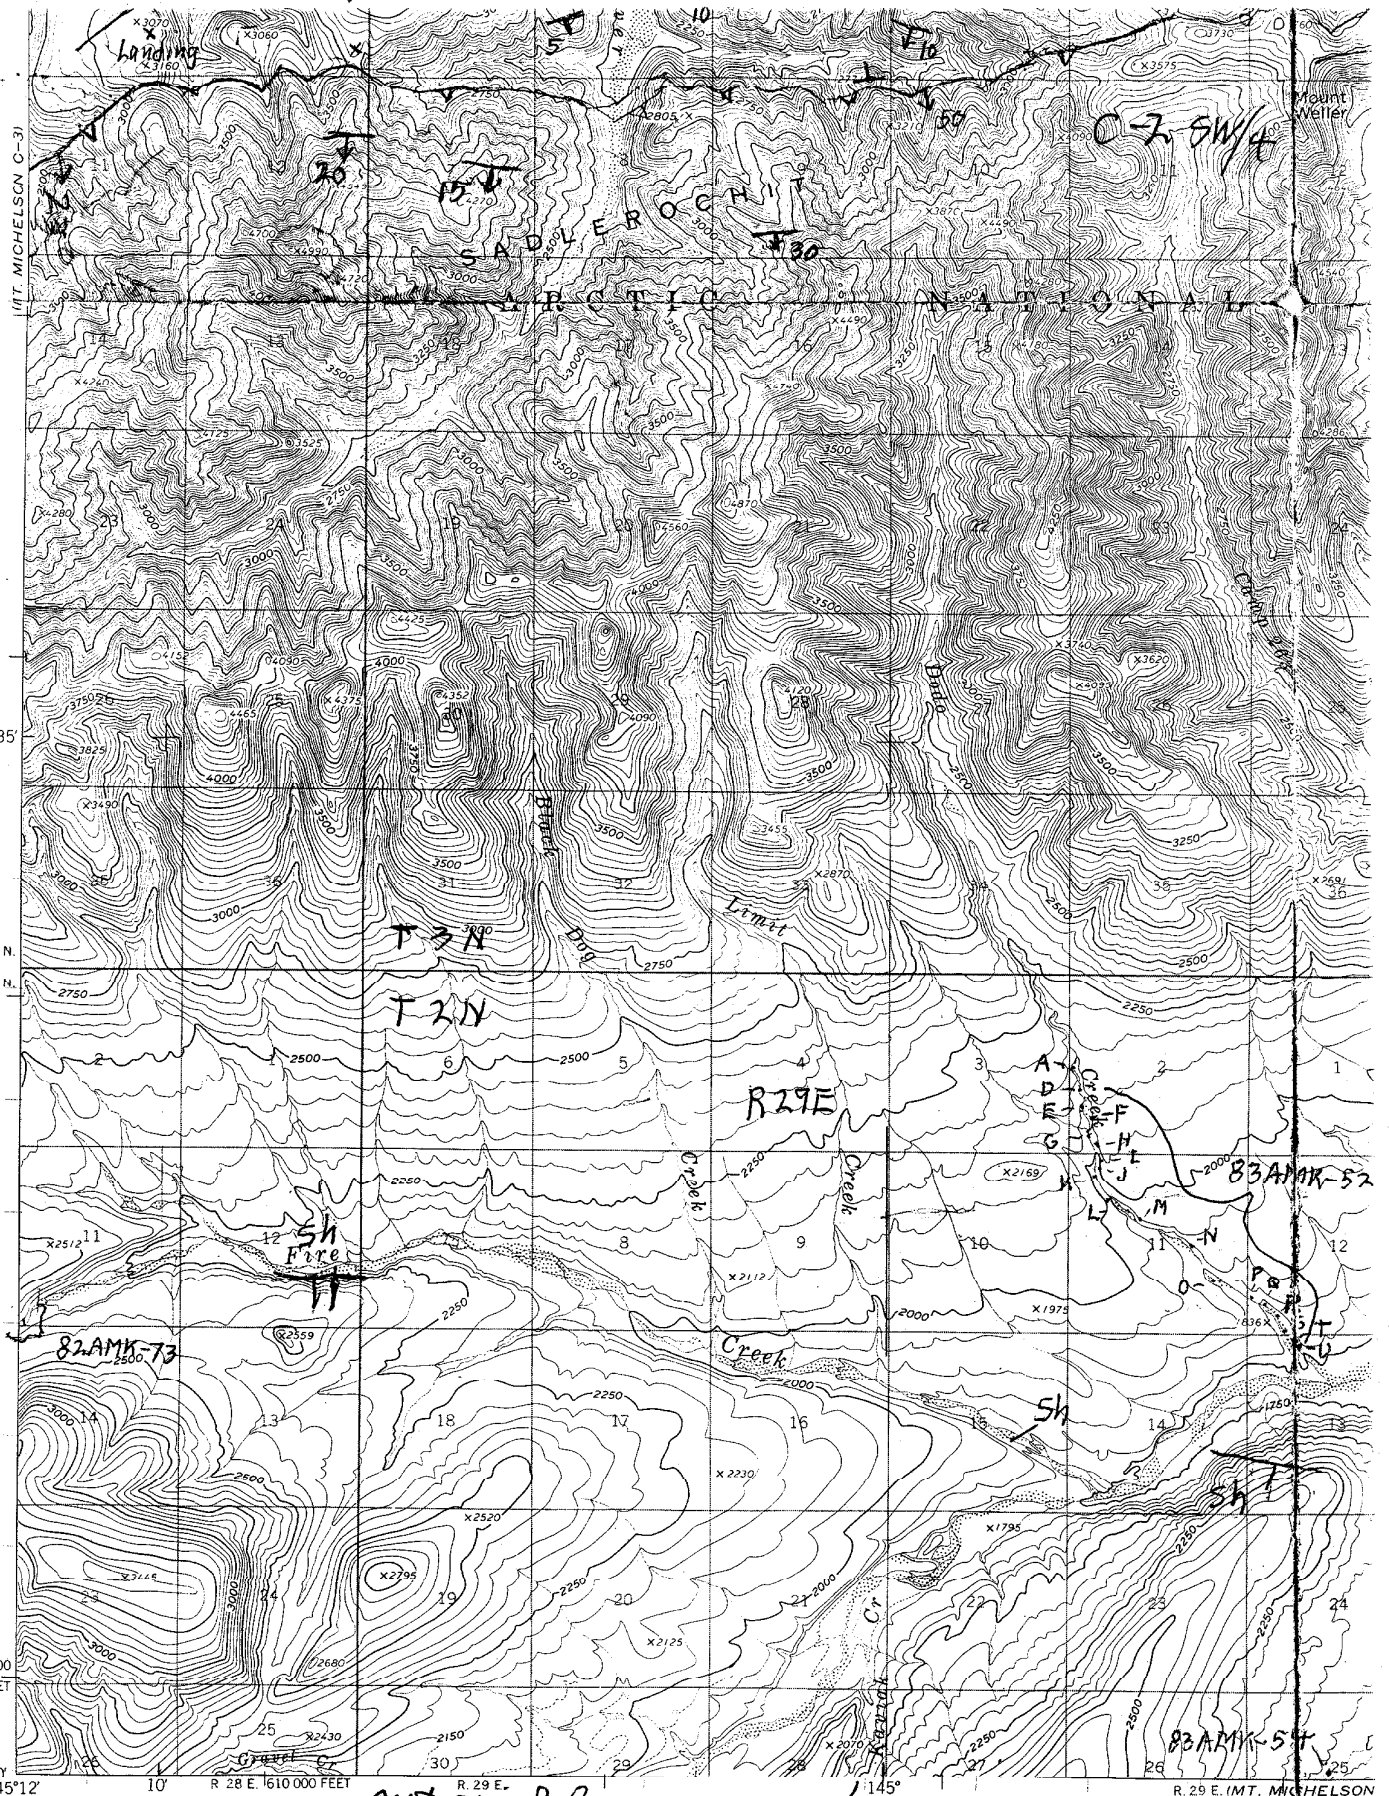


Mapped by the Army Map Service  
 Edited and published by the Geological Survey  
 Control by USC&GS and USCE  
 Topography by photogrammetric methods from aerial photographs  
 taken 1955, field annotated 1955. Map not field checked  
 Universal Transverse Mercator projection. 1927 North American datum

*Mt Michelson C-2 SW/4*

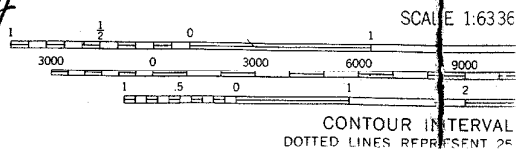

MICHELSON B-3)

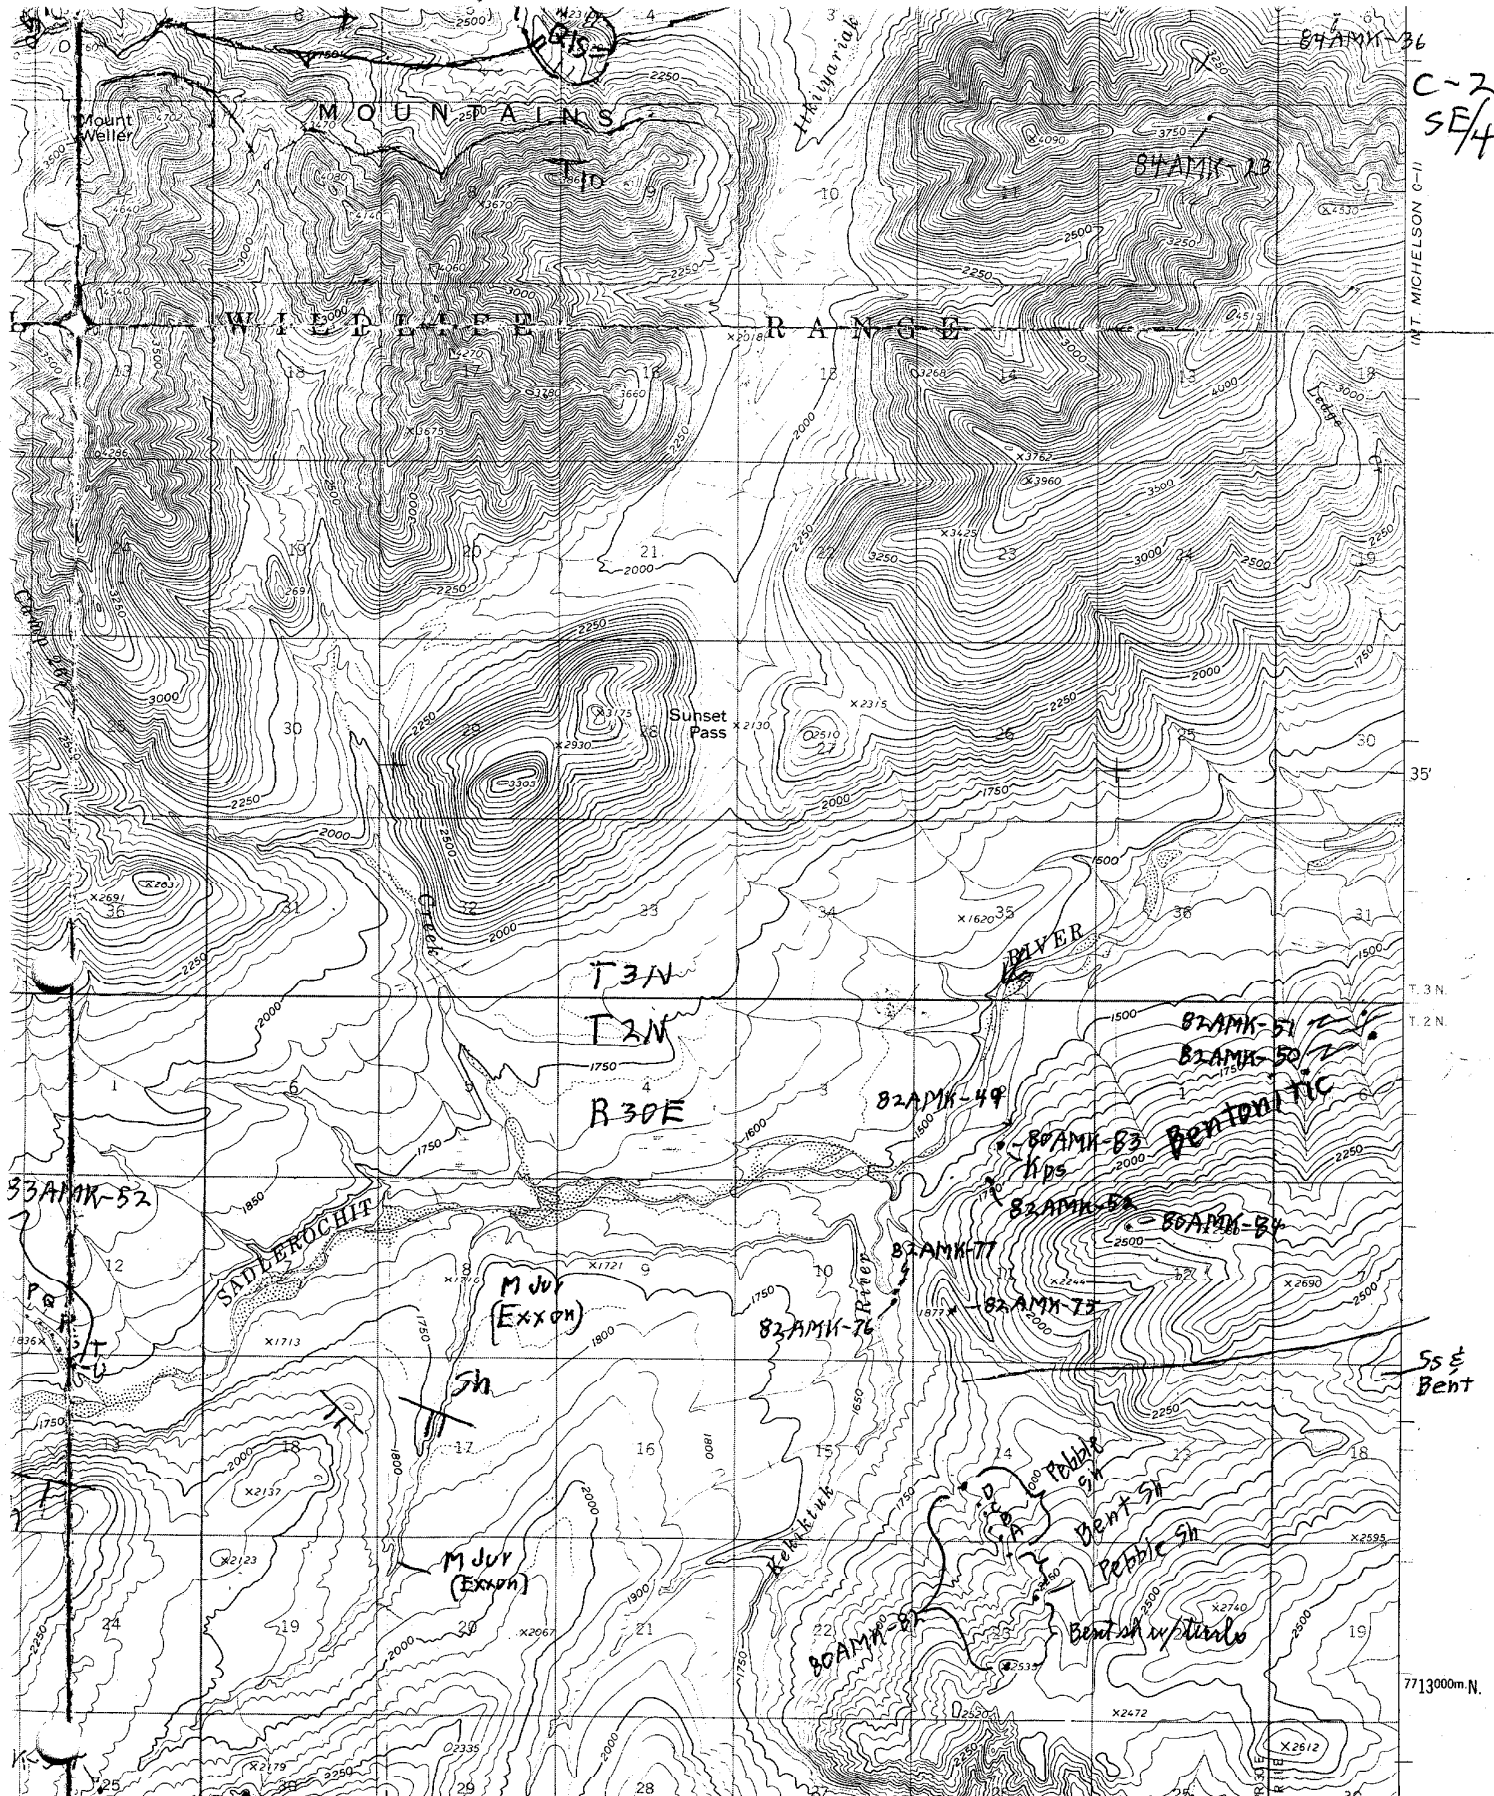

87AMK-36  
C-2  
SE/4

MT. MICHELSON C-1

35'

T.3N  
T.2N

SS & Bent

77°30'00m N

69°30'

144°36'  
145°36'


1T. MICHELSON B-21

80AMK-43

MT Michelson C-2 SE/4

INTERIOR- GEOLOGICAL SURVEY, RESTON, VIRGINIA-1975

893000m E.

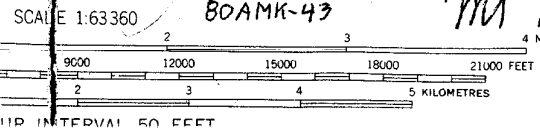

ROAD CLASSIFICATION

No roads or trails in this area


MT. MICH.

C-2

mt michelson C-3  
NW/4

UNITED STATES  
DEPARTMENT OF THE INTERIOR  
GEOLOGICAL SURVEY

MICHELSON D-4

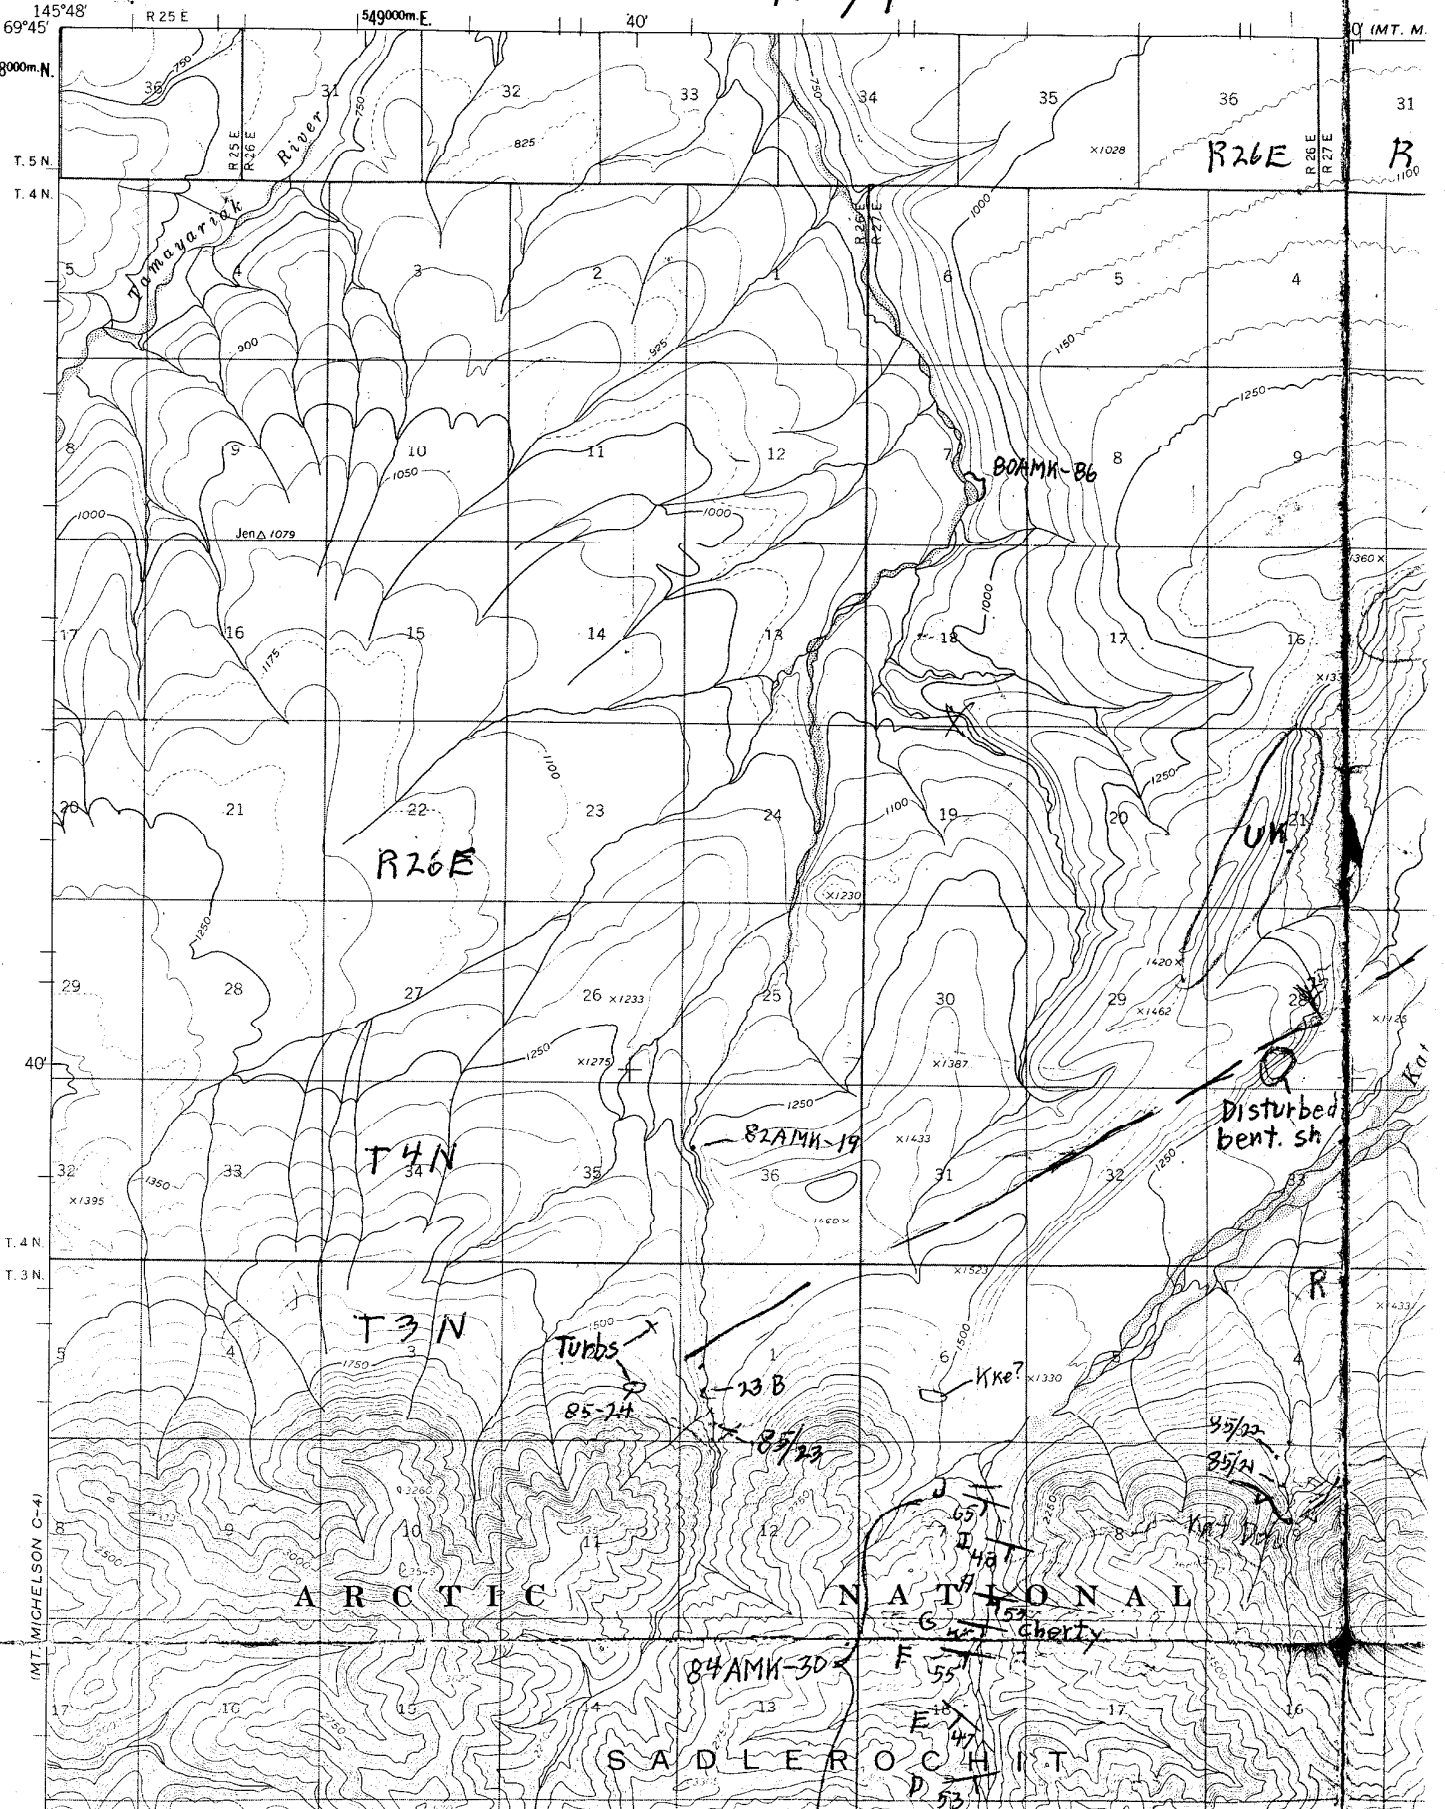

Q (MT. M)

(MT. MICHELSON C-4)

MT. MICHELSON (C-3) QUADRANGLE  
ALASKA - NORTH SLOPE BOROUGH


1:63,360 SERIES (TOPOGRAPHIC)

R. 28 E. 600,000 FEET

145°12' 69"45"

MT Michelson NE/4 C-3


R - Revisited Hill Sh

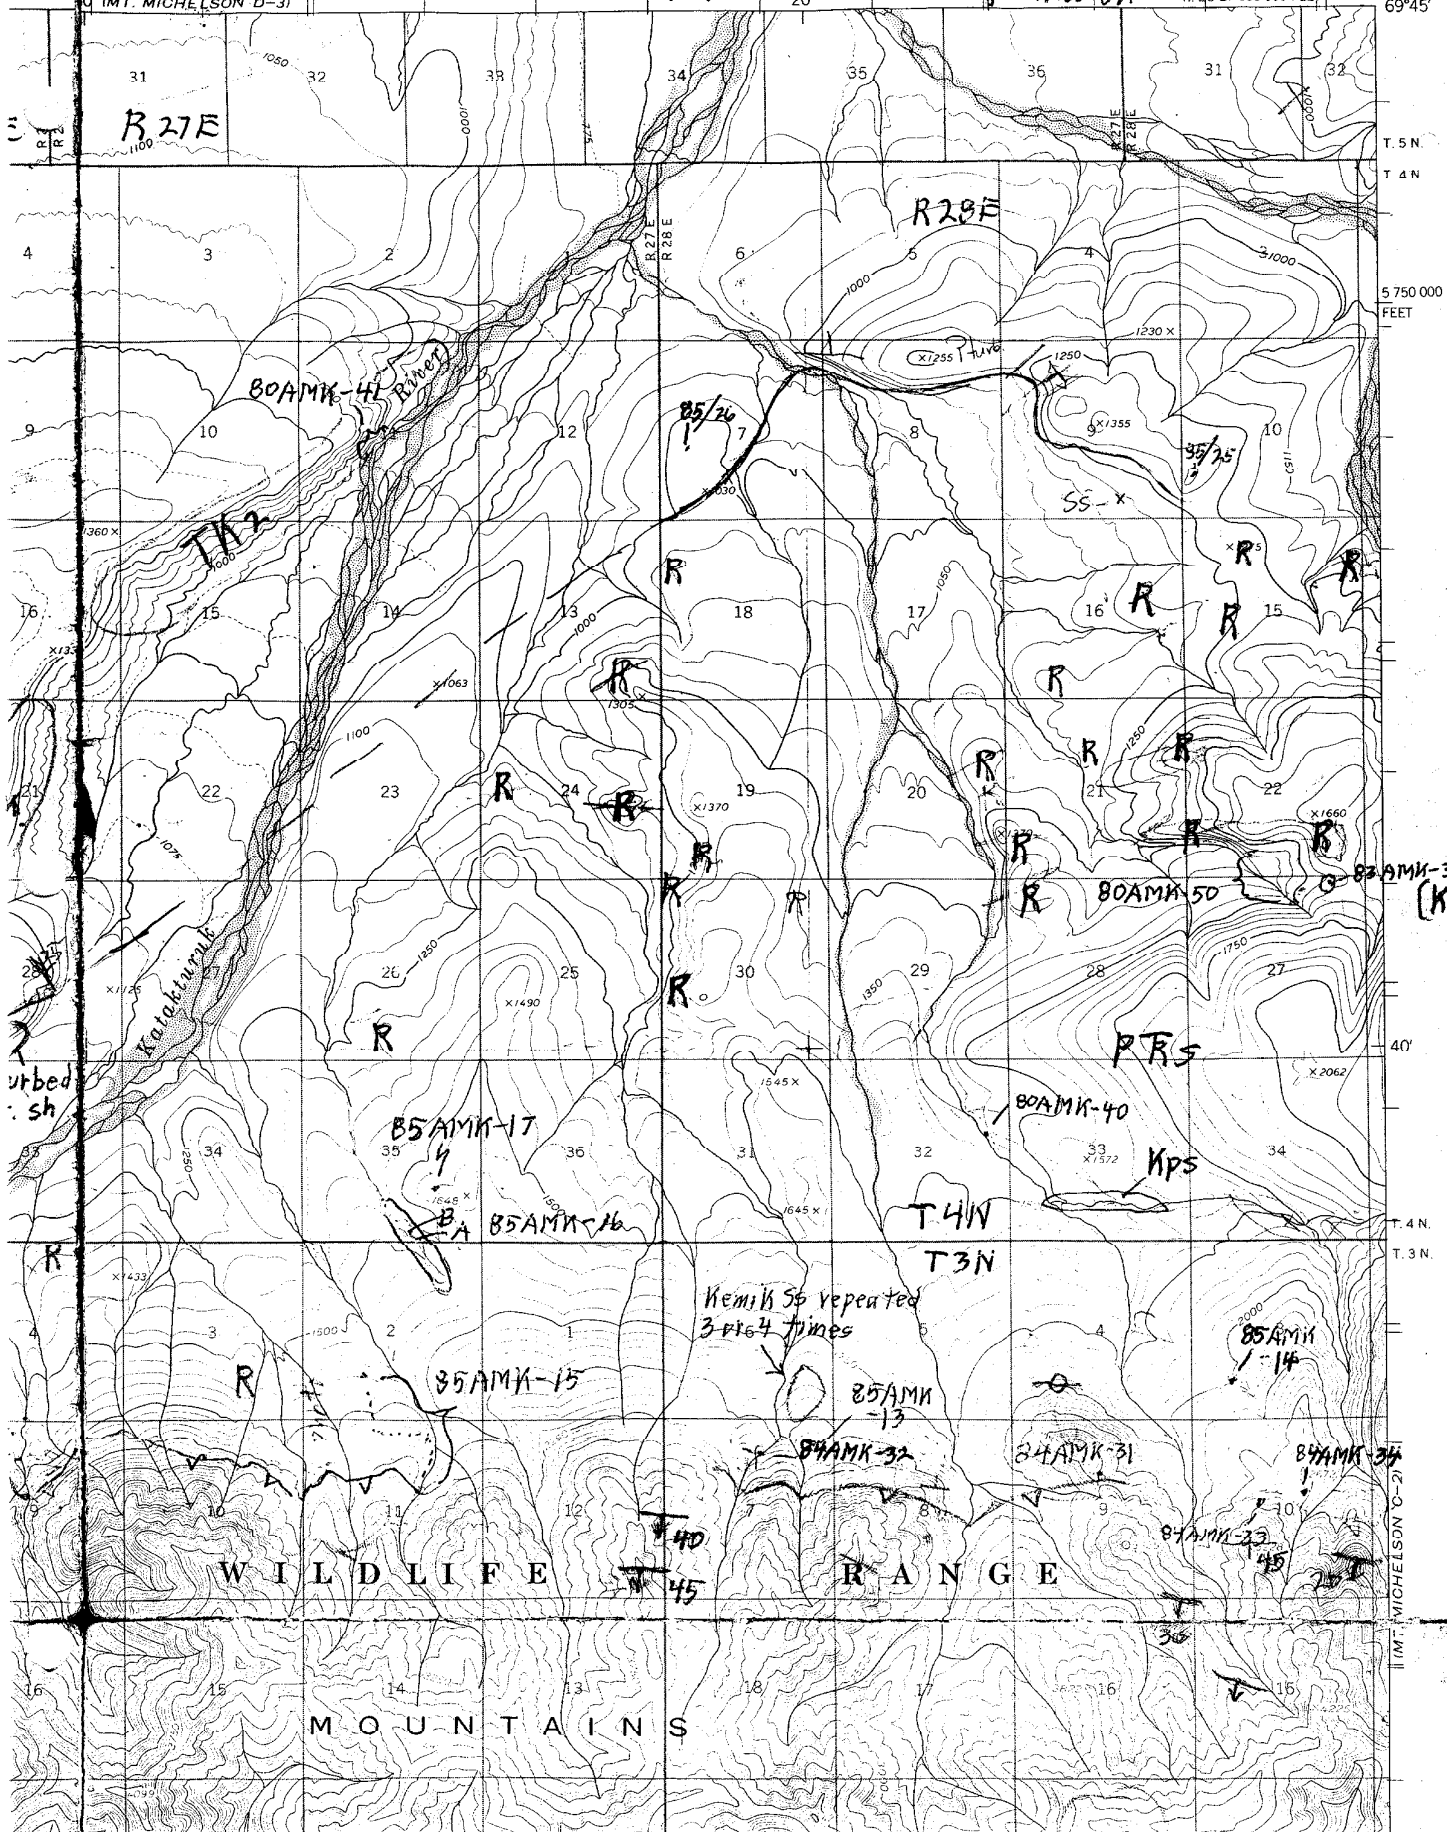

Remix 56 repeated  
3-16-4 times

WILDLIFE RANGE MOUNTAINS

MT. MICHELSON C-3

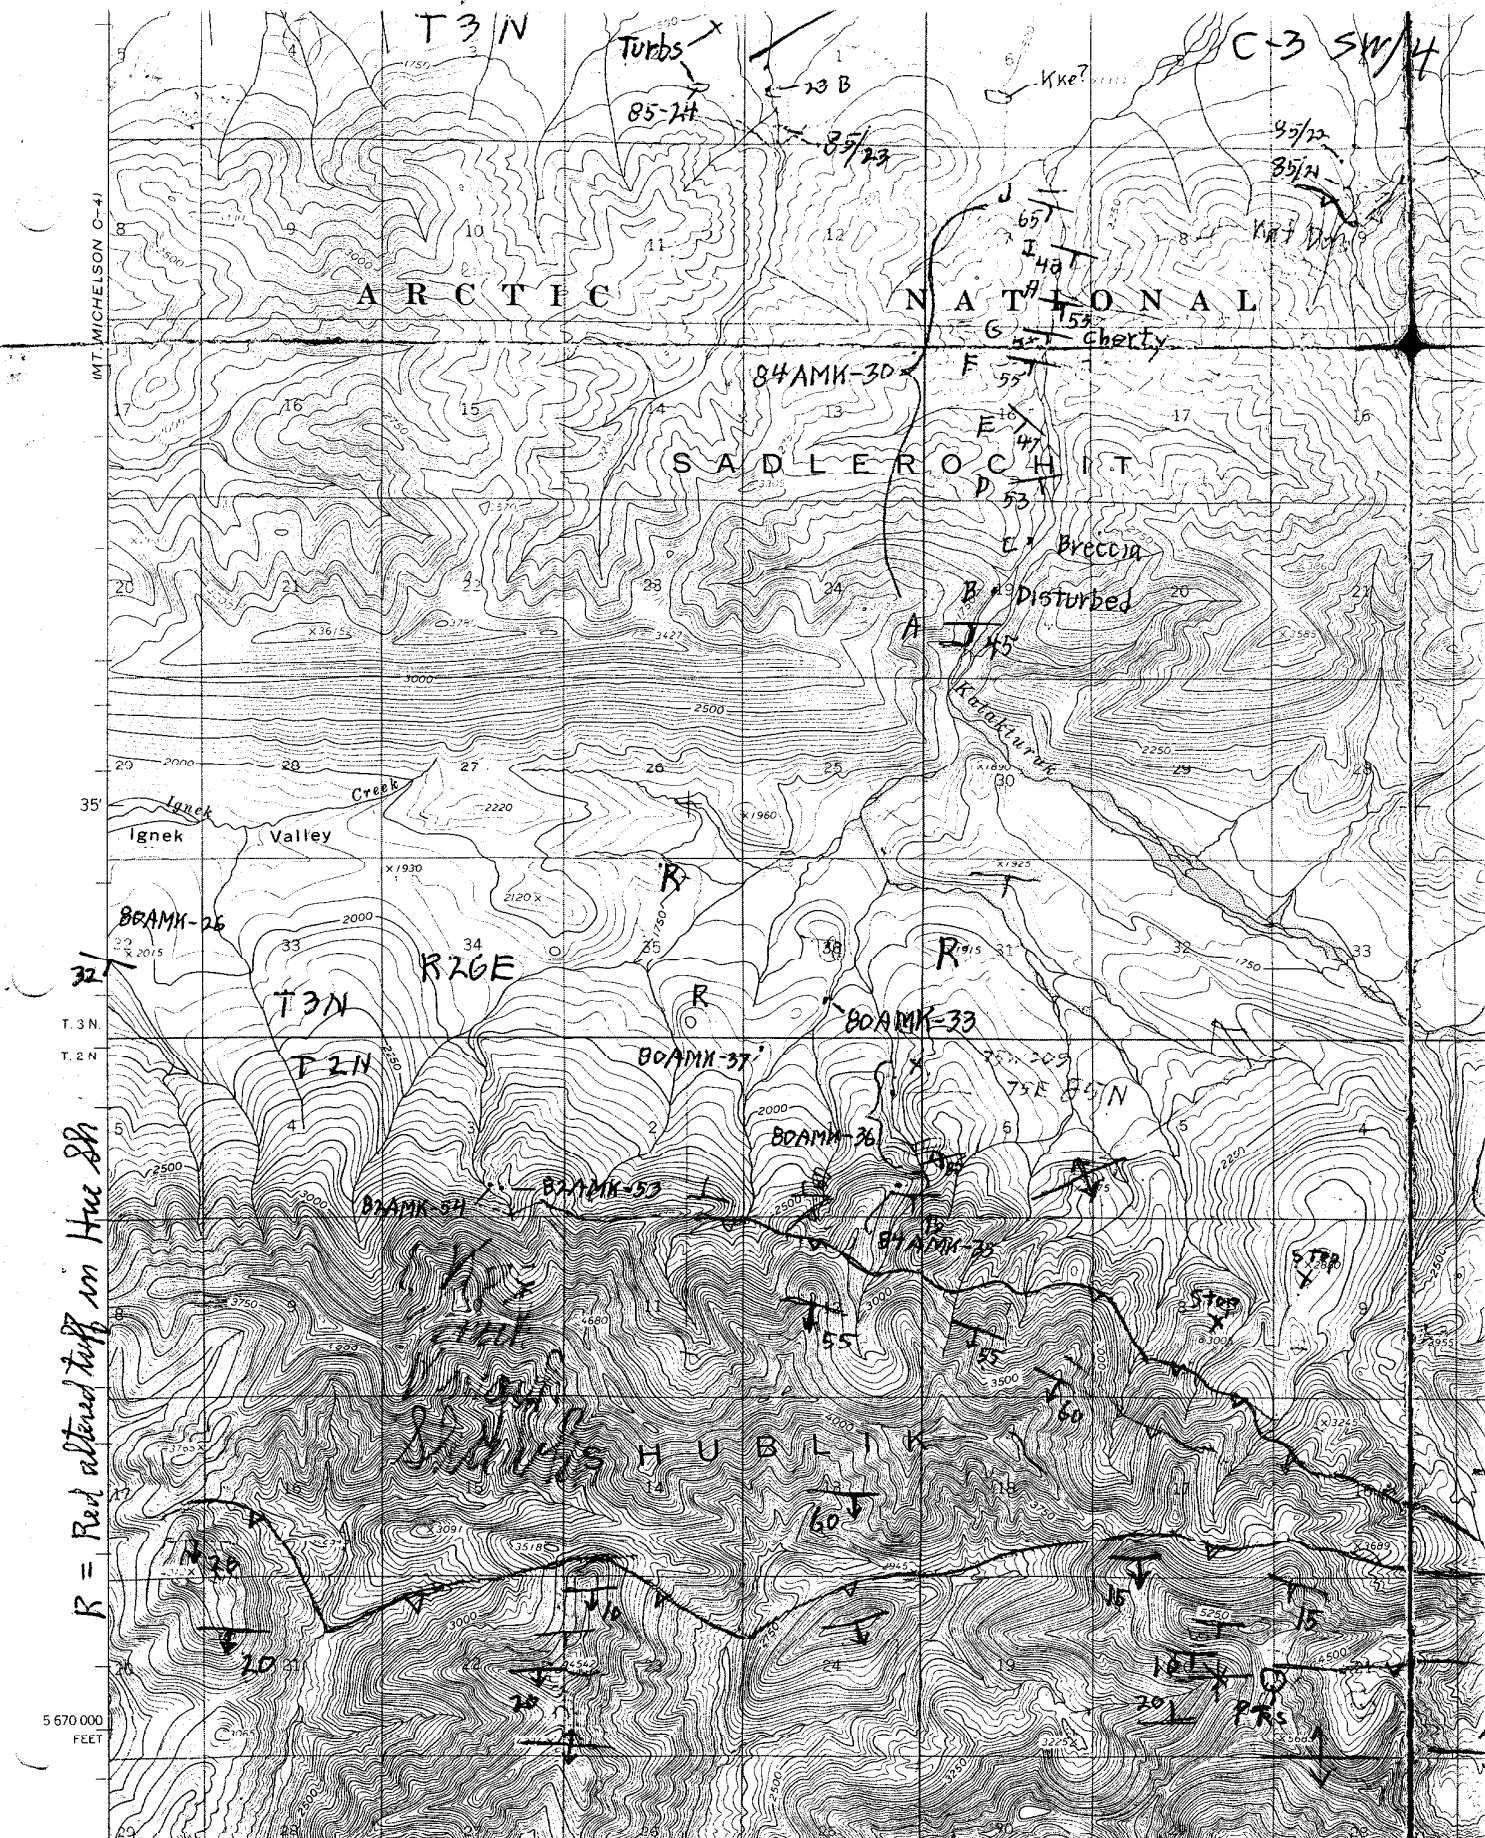

R = Red altered tuff in Hue Sh

69°30'  
145°48'

Mapped by the Army Map Service  
 Edited and published by the Geological Survey

*Mt Michelson SW/4*


R. 26 E. R. 27 E. 30 - IMT. A

SCALE 1:63360



2 34



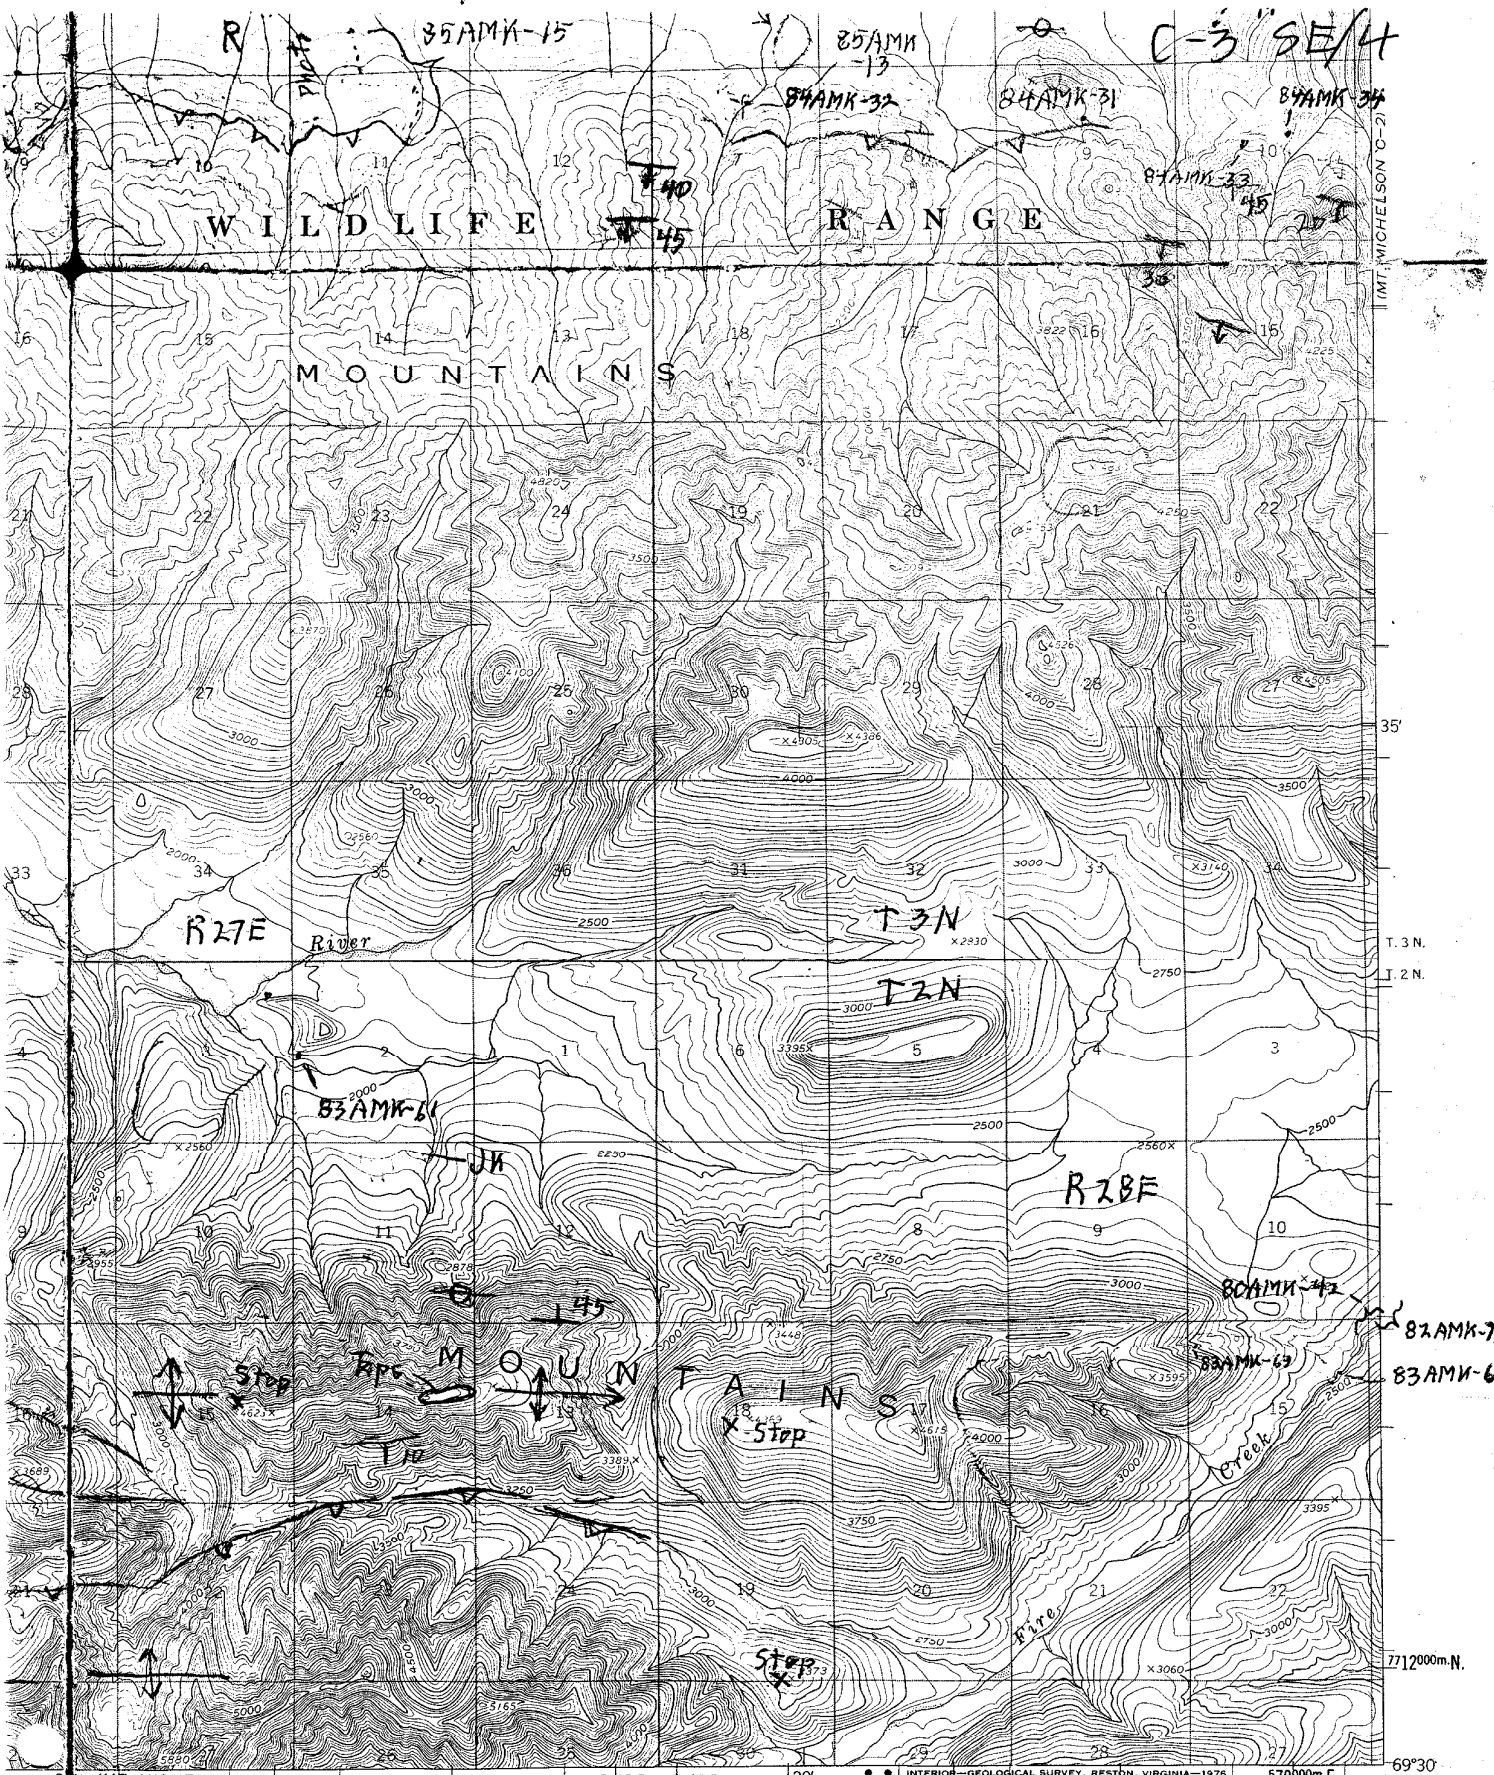

C-3 SE/4

WILDLIFE RANGE

MOUNTAINS

R27E River


T3N

T2N

R28E

MOUNTAINS

SCALE 1:63360

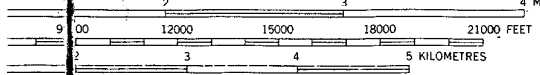

VERT. INTERVAL 50 FEET

Mt Michelson SE/4  
C-3

ROAD CLASSIFICATION  
No roads or trails in this area

MT. MICHELSON

GEOLOGICAL SURVEY

11th. Michelson C-7 11W/4

MT. MICHELSON C-4

NW

MT. MICHELSON D

146°24' 69°45'

524000m.E 20'

10'

7737000m.N  
T. 5 N.

T 5 W

T 4 N

R 24 E

83 AMK-4

81

89

80 AMK-31

80 AMK-30

83 AMK-37

80 AMK-29

83 AMK-3

34 x 670

81

81

81

ARCTIC NATI

live Sh

R

Red Hill

Δ 1870

85 AMK-7  
Burned Sh

R

f. 4 N.

1

2

3


38

39

40

41

42

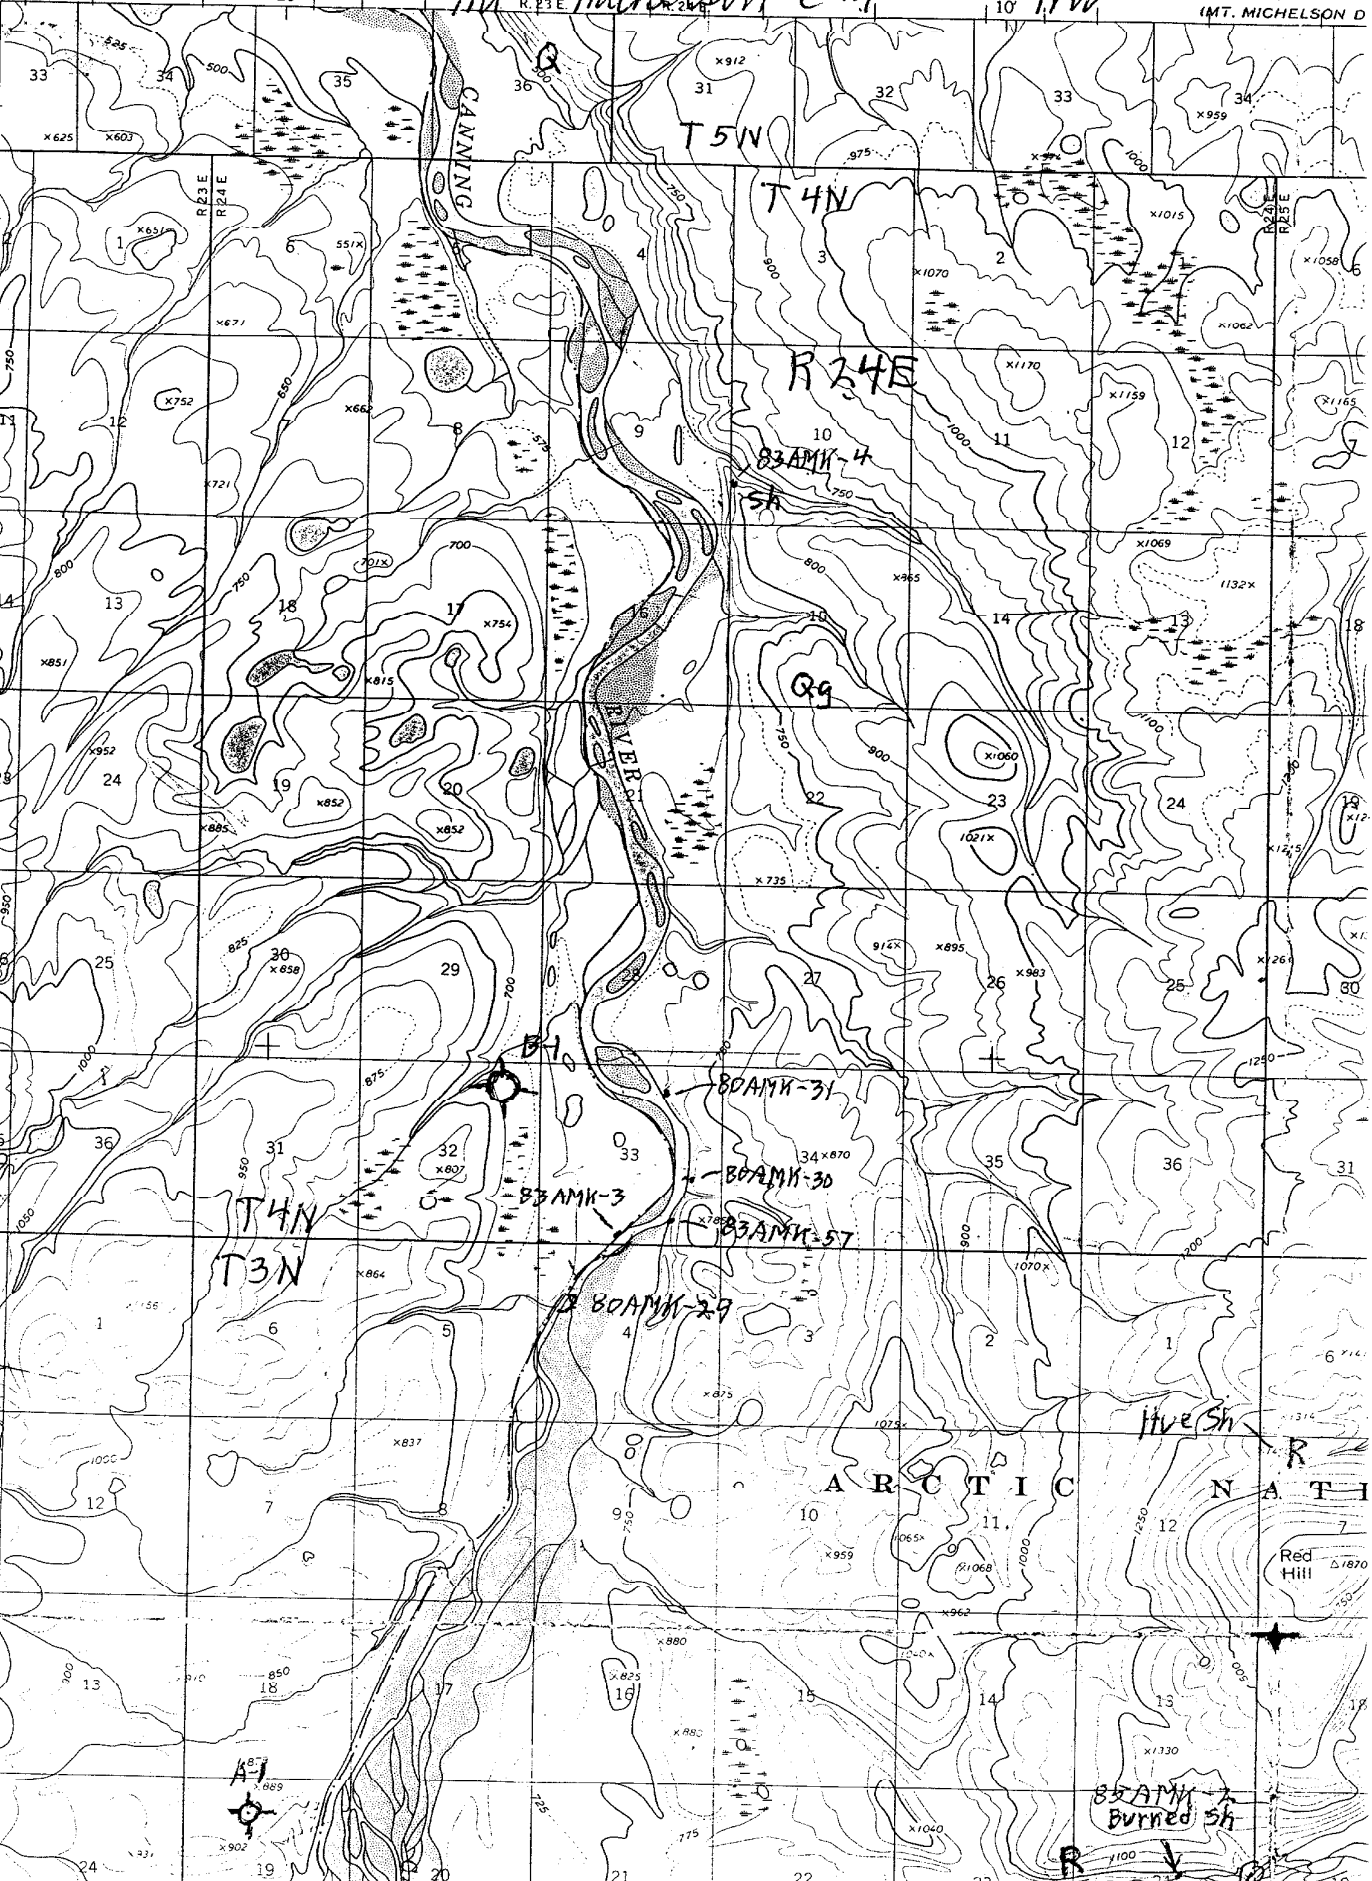

C-4

MT. MICHELSON (C-4) QUADRANGLE  
ALASKA

NE

1:63 360 SERIES (TOPOGRAPHIC)

MT. MICHELSON


MICHELSON C-4

R. 24 E R. 25 E  
146°

500 000 FEET

50'

145°48'  
69°45'

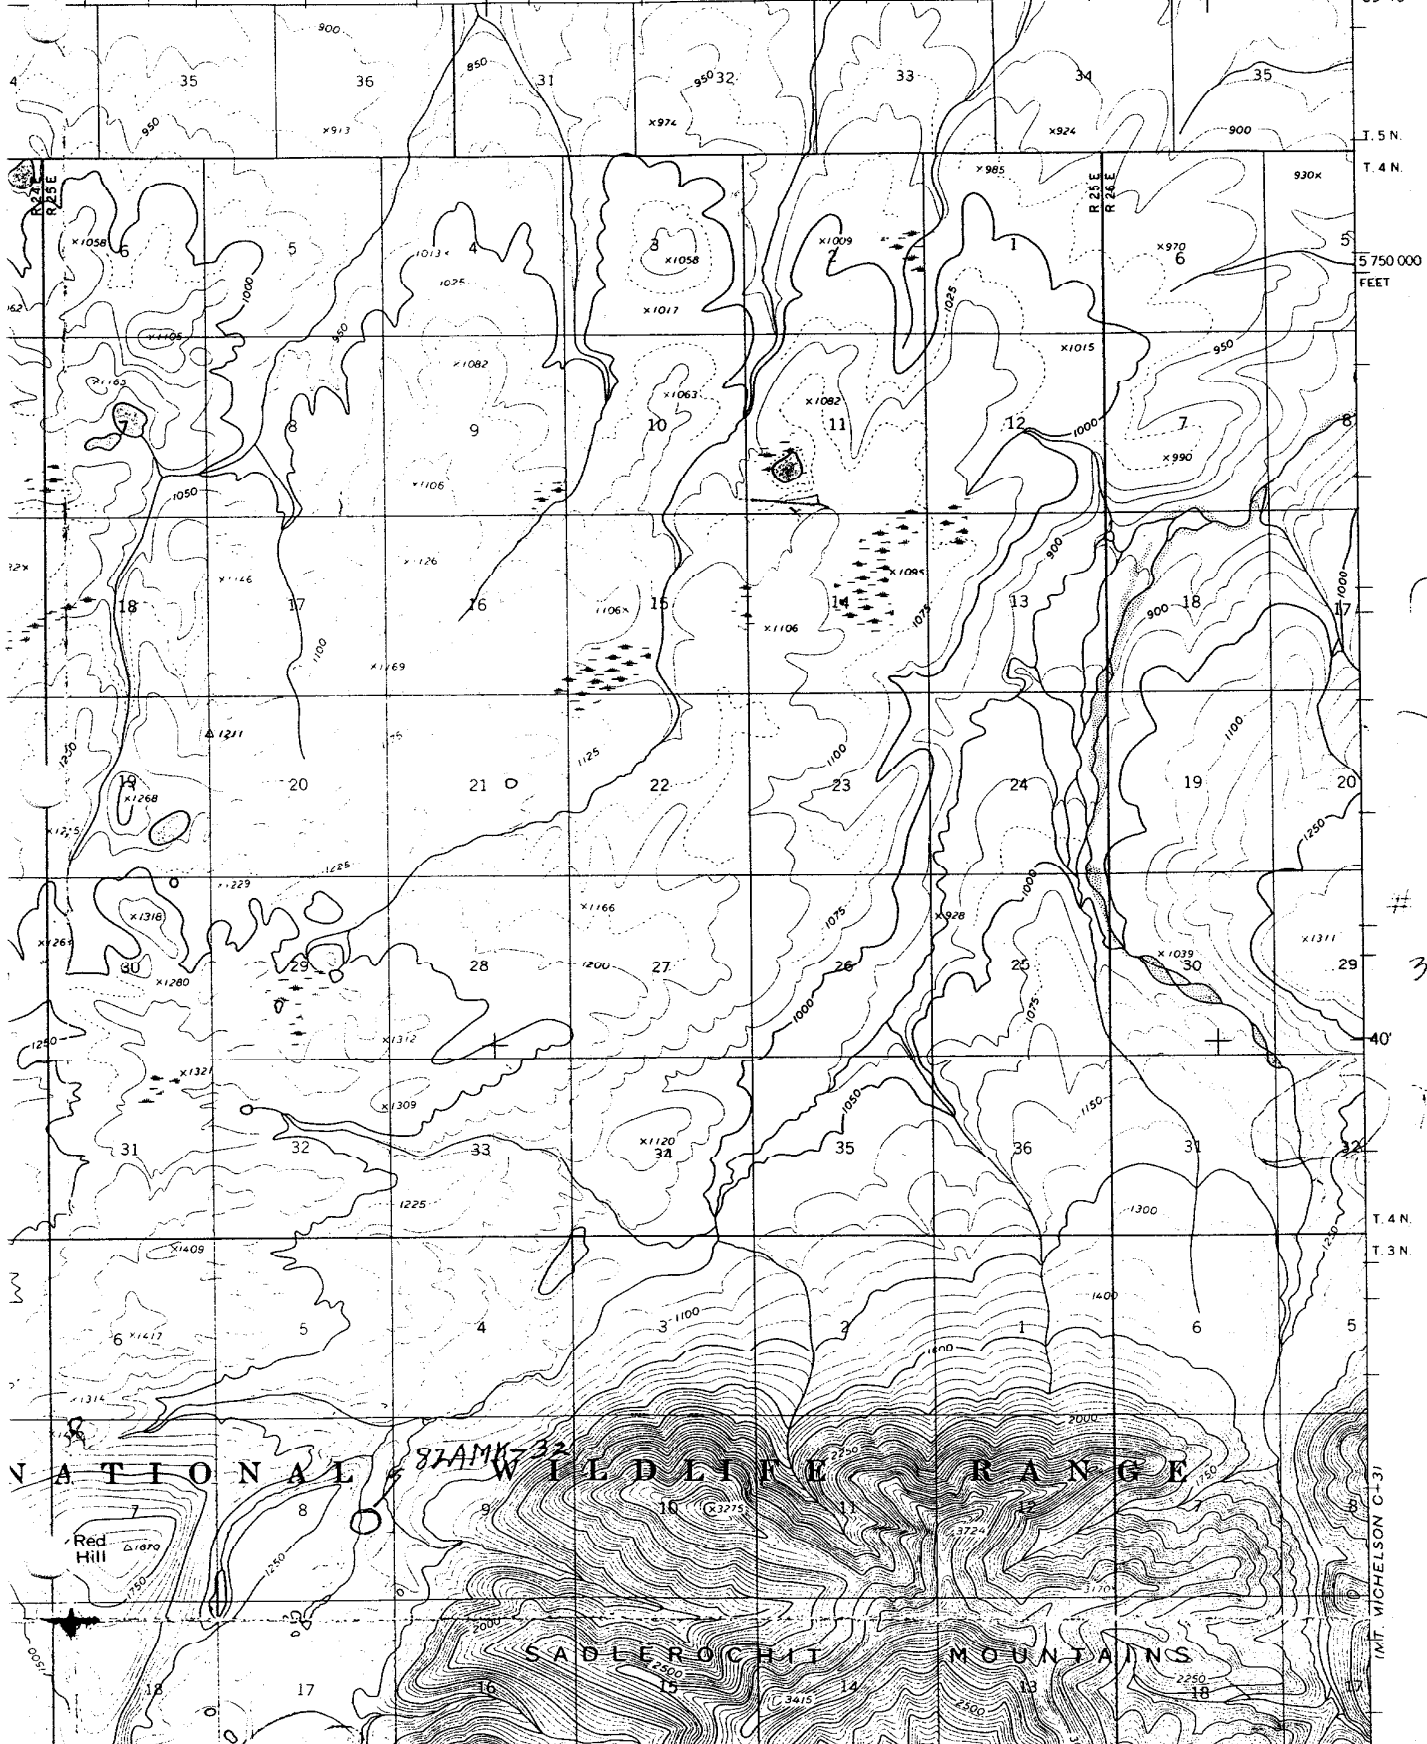


7

# 8  
367

71



MT. MICHELSON C-4

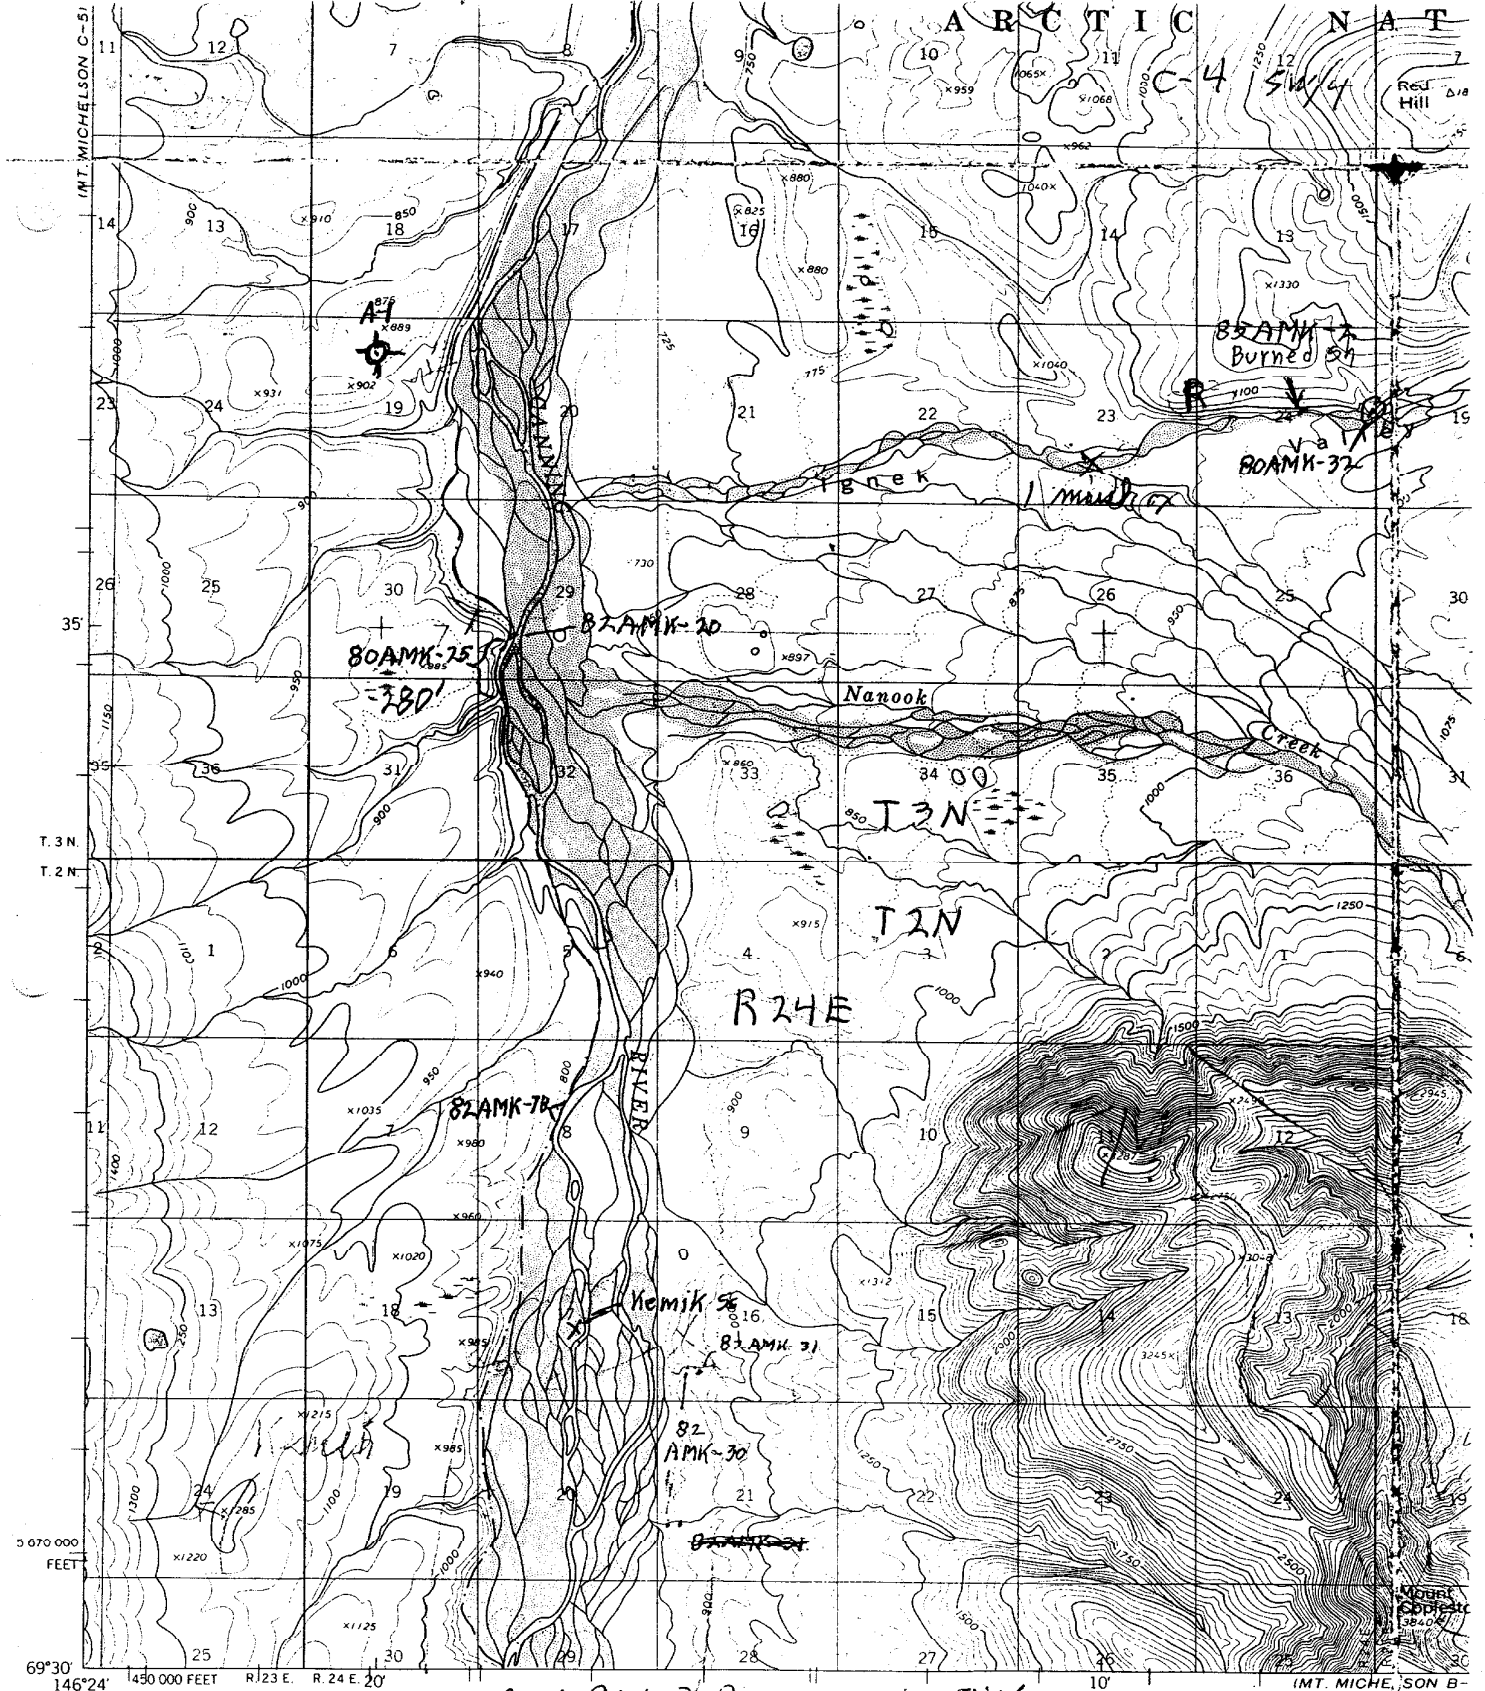


69°30' 146°24' 1450 000 FEET R. 23 E. R. 24 E. 20  
 69°36' 146°30' 1450 000 FEET  
 Mapped by the Army Map Service  
 Edited and published by the Geological Survey  
 Control by USC&GS and USCE  
 Topography by photogrammetric methods from aerial photographs  
 taken 1955, field annotated 1955. Map not field checked  
 Universal Transverse Mercator projection. 1927 North American datum  
 10,000-foot grid based on Alaska coordinate system, zone 3  
 1000-meter Universal Transverse Mercator grid ticks,  
 zone 6, shown in blue  
 Land lines represent unsurveyed and unmarked locations

Mt. Michelson C-4 SW

C-4

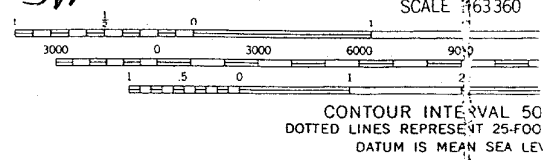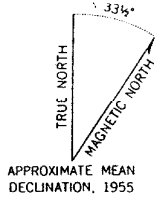

Handwritten notes and signatures at the bottom right of the map.

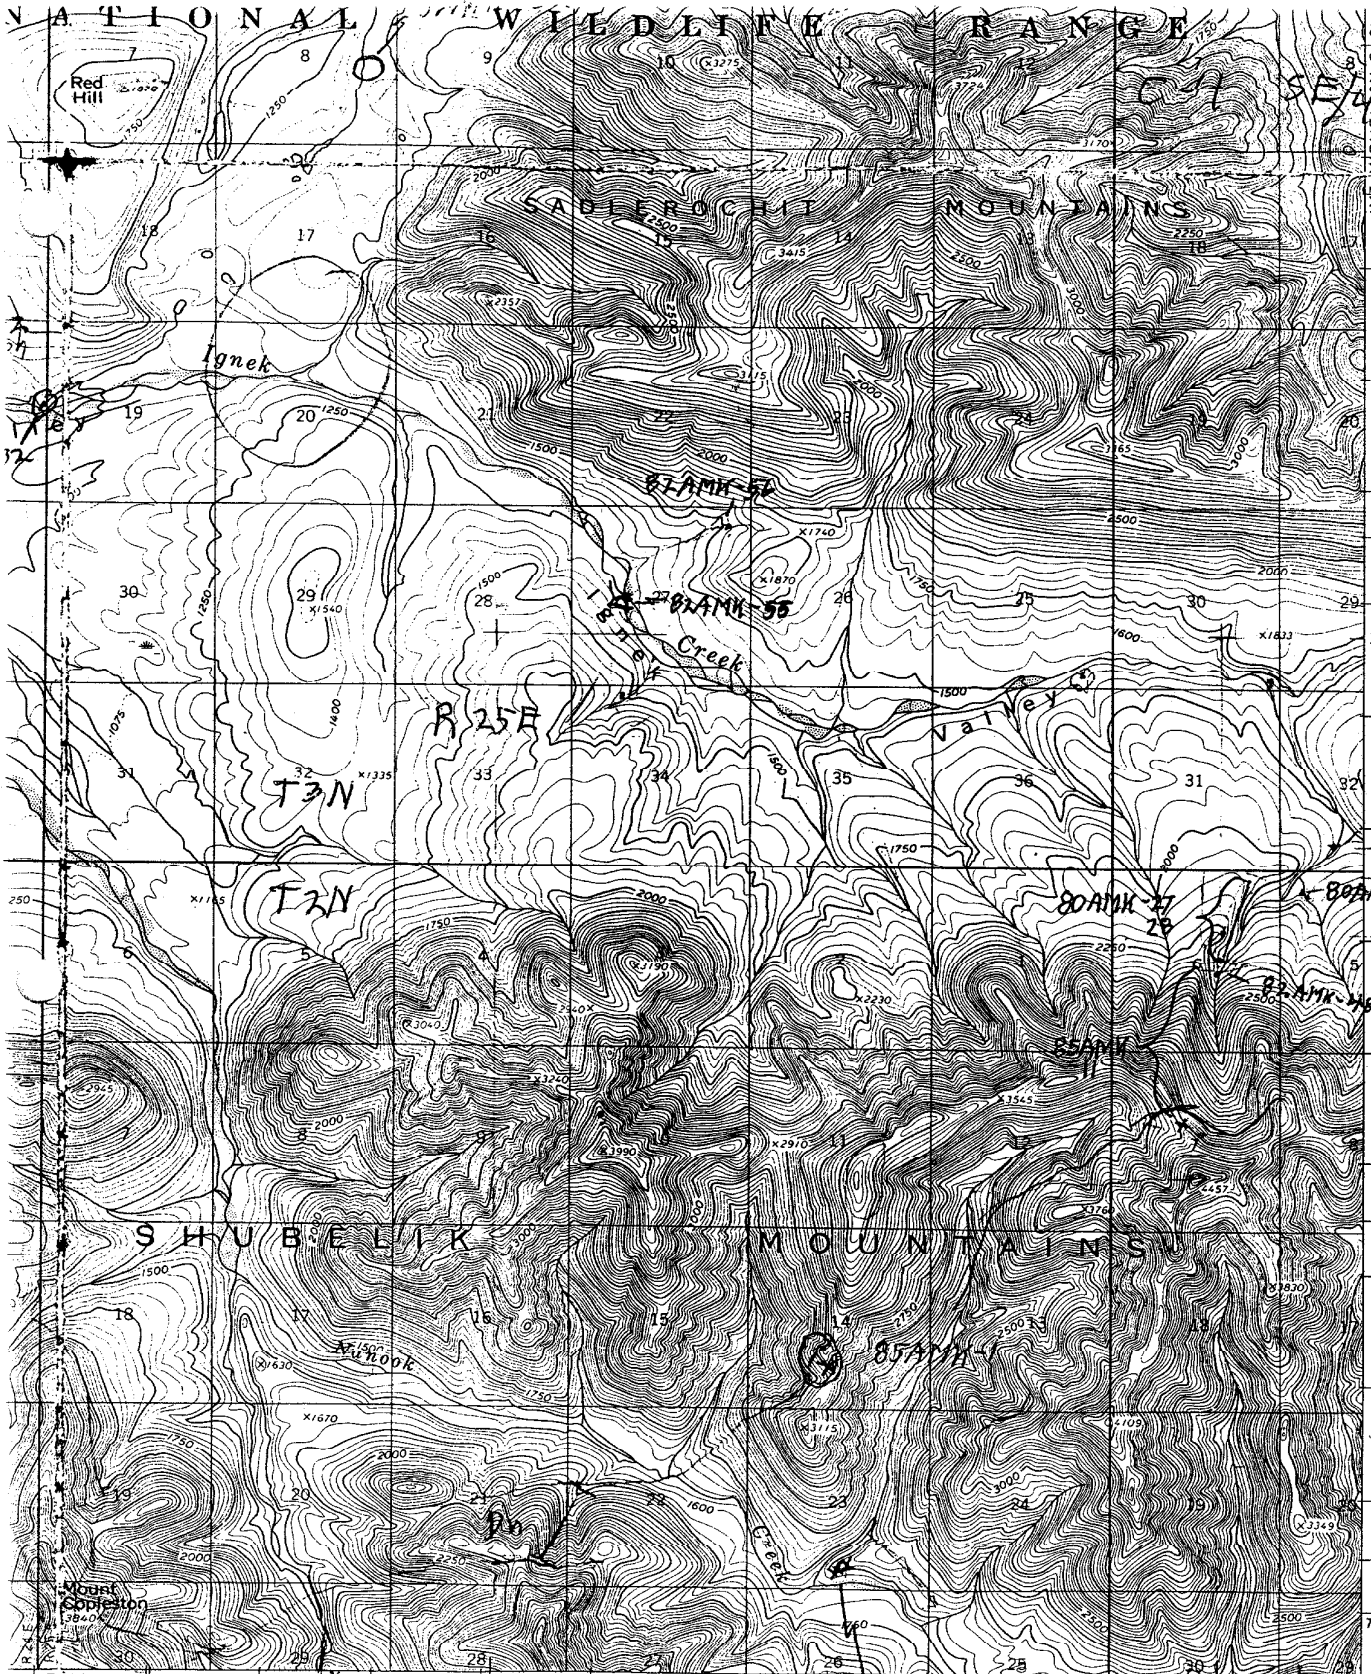

SCALE 1:63360

0 2 3 4 MILES

0 3 4 5 KILOMETERS

INTERVAL 50 FEET  
PRESENT 25-FOOT CONTOURS  
S MEAN SEA LEVEL

U.S. GEOLOGICAL SURVEY

*Talobuk loc*

MT Michelson C-4

SE

ALASKA

QUADRANGLE LOCATION

ROAD CLASSIFICATION

No roads or trails in this area

MT. MICHELSON (C-4), ALASKA SE

147°00'  
69°45'

501000m E.

50'

7737000m N.

T 5 N


T 4 N

40'

T 4 N

T 3 N

ISAGAVANIRKTOK C-II

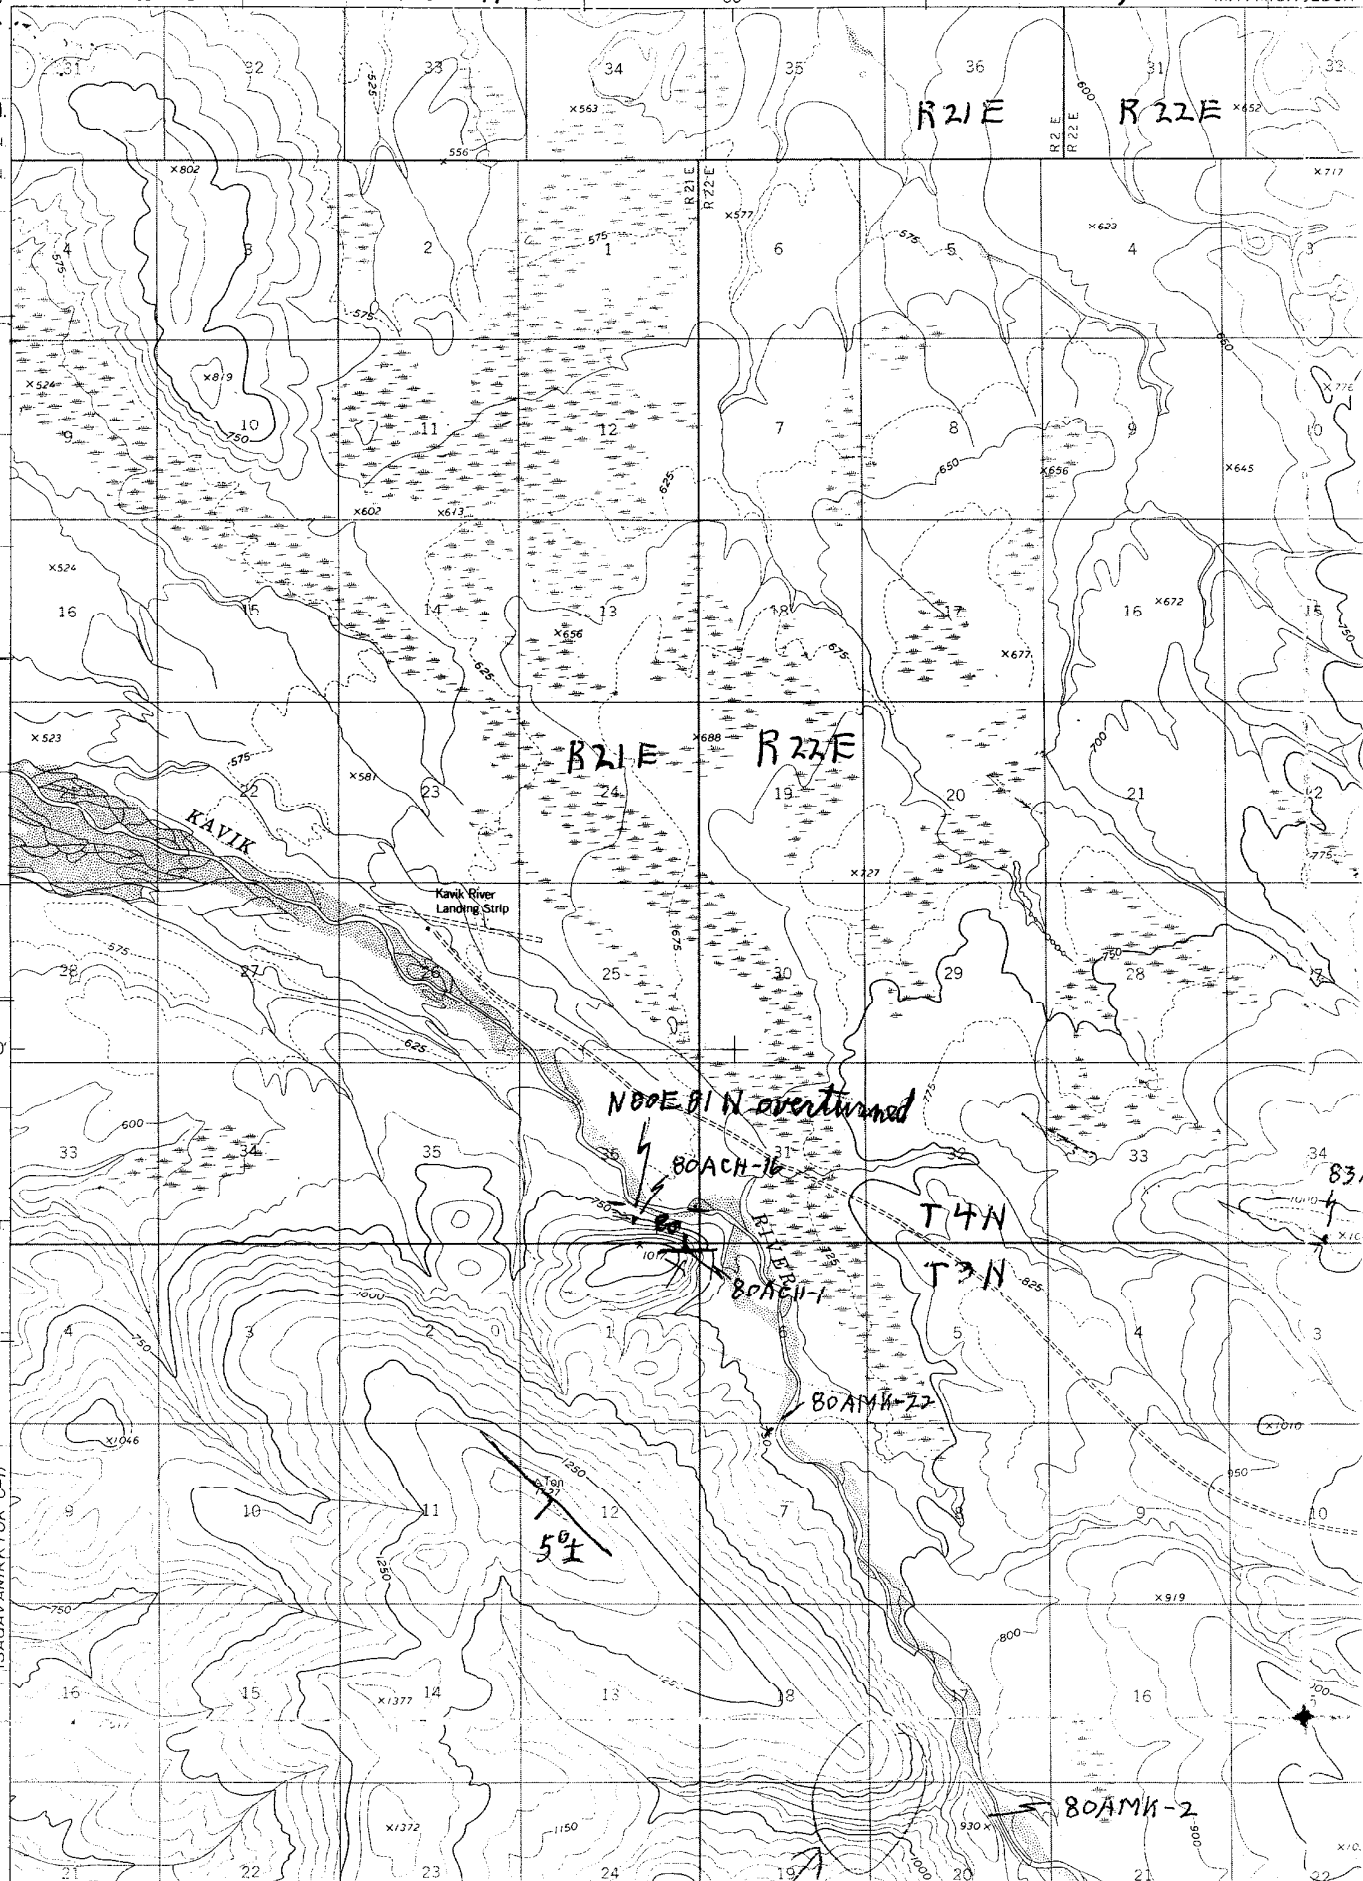


NE/4 MT Michelson B-5 C-5 1:63 360 SERIES (TOPOGRAPHIC)


(MT. MICHELSON D-5) 40'

440 000 FEET

NE/4

146°24' 69°45'

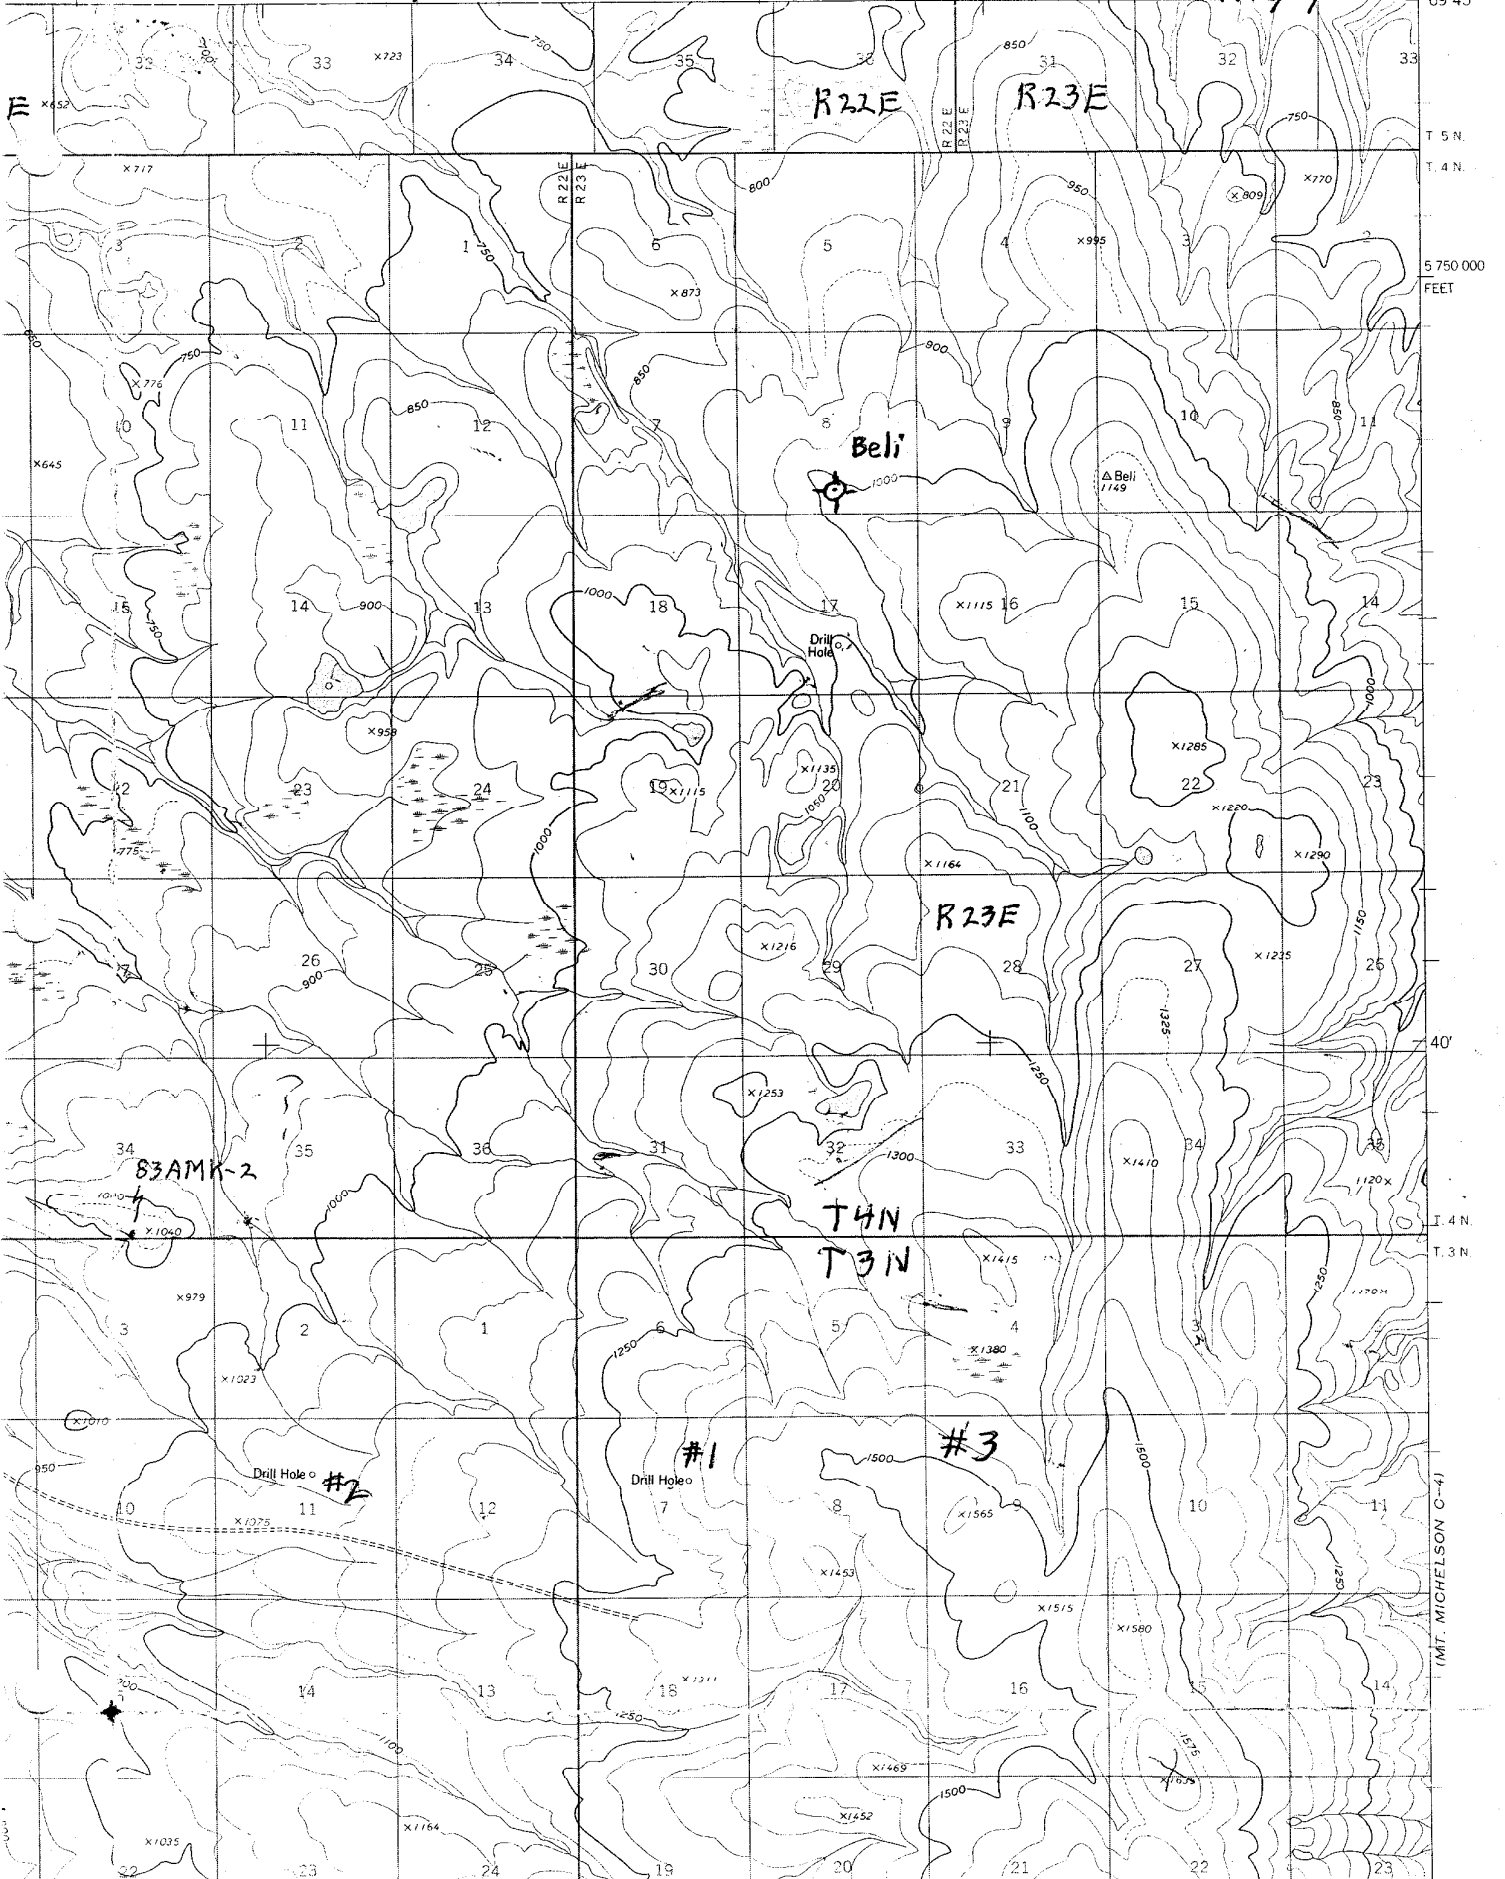

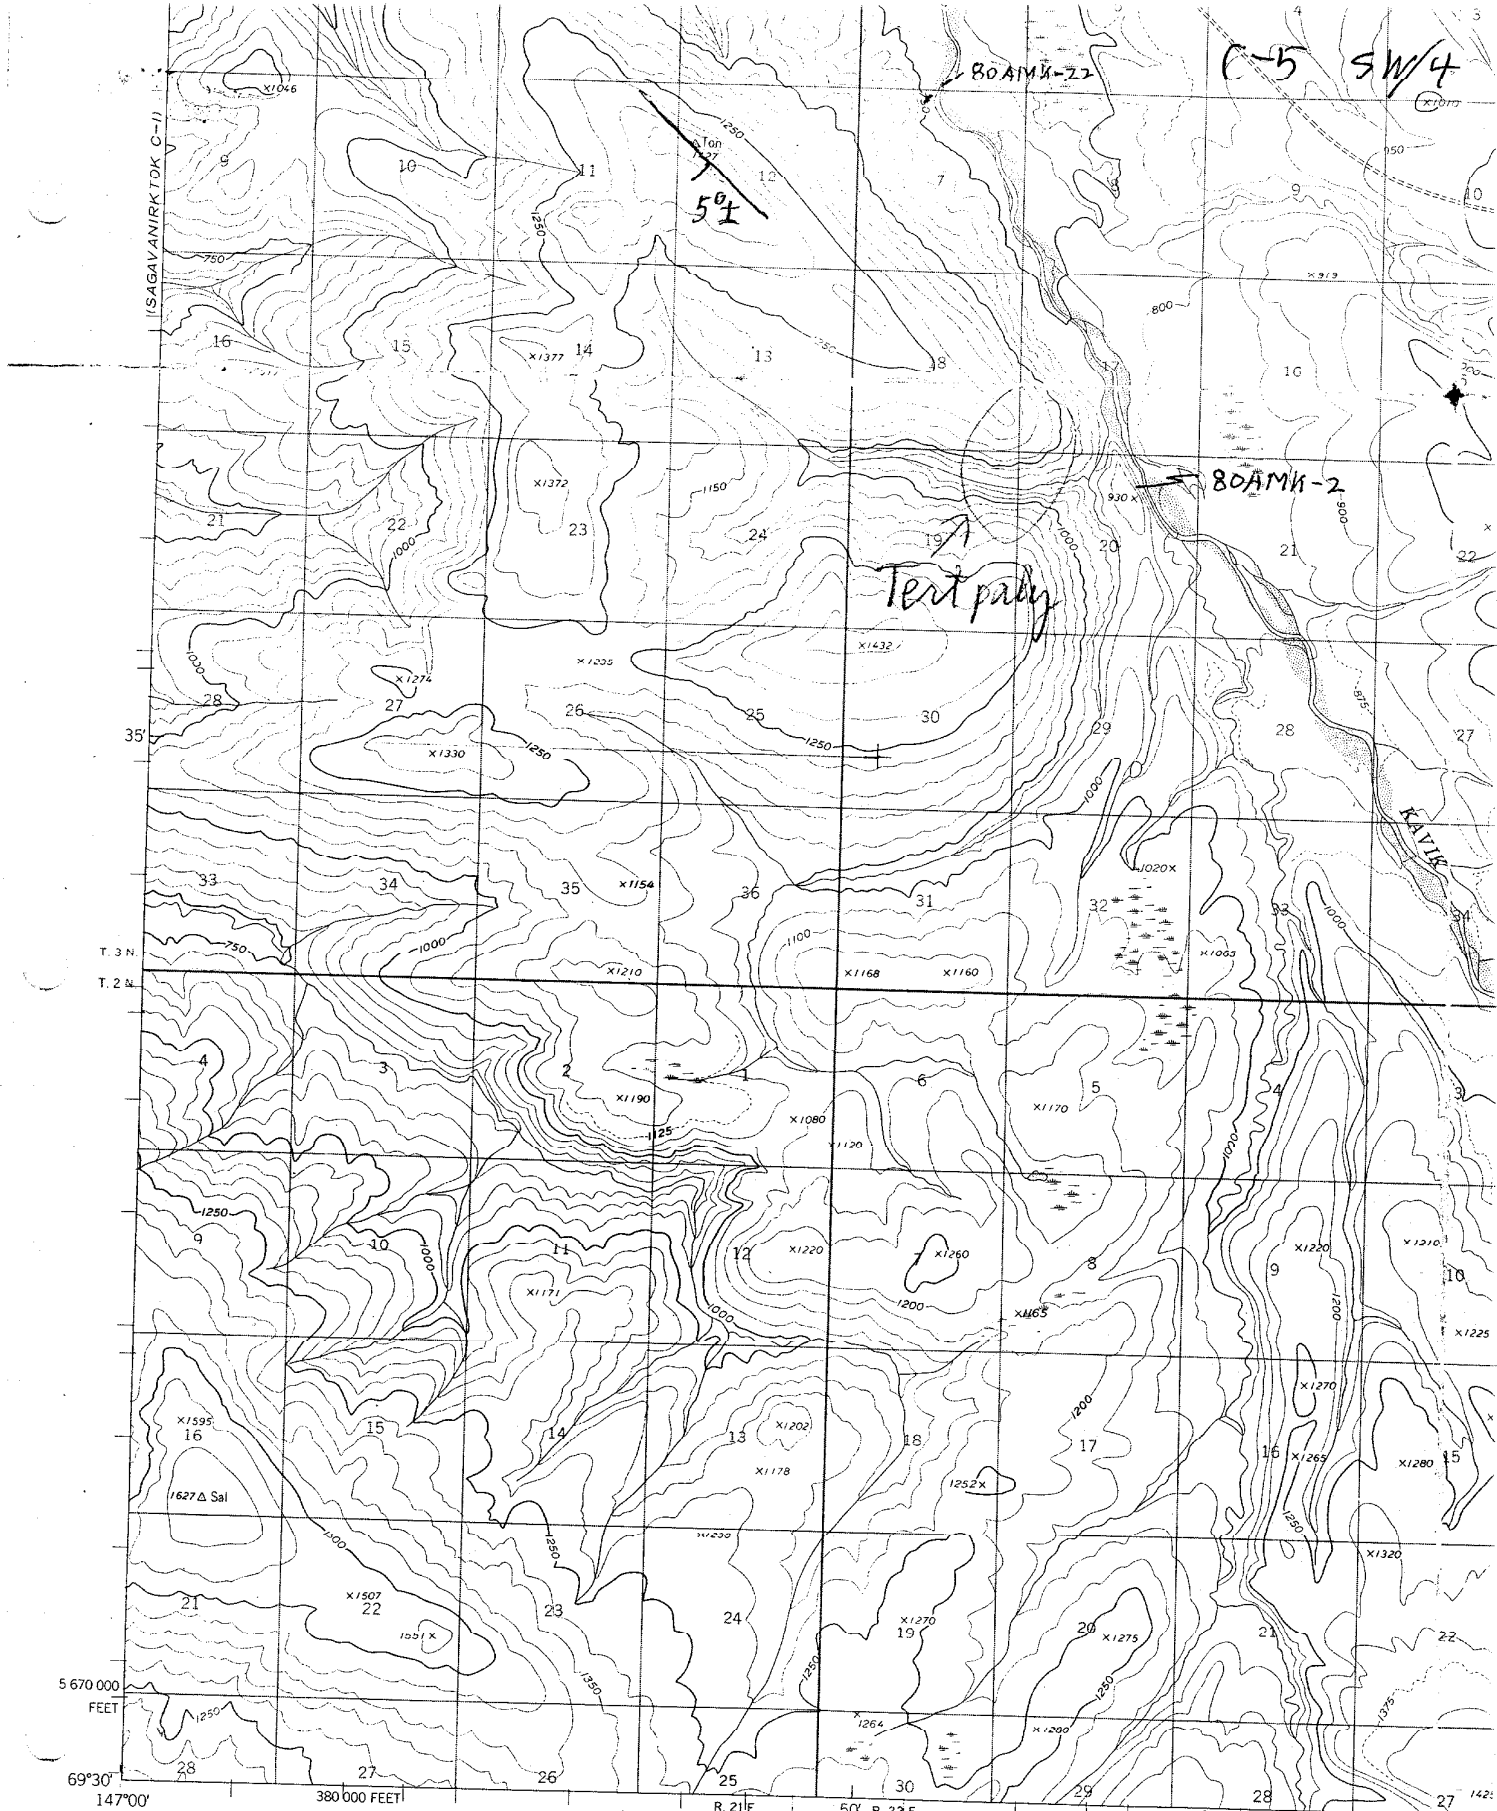


Mapped by the Army Map Service  
 Edited and published by the Geological Survey  
 Control by NOS/NOAA and USCE

Mt. Michelson C-5 SW/4


IMT. MICHELSON E  
 SCALE 1:63360

Topography by photogrammetric methods from aerial photographs  
 taken 1955, field annotated 1956. Map not field checked.

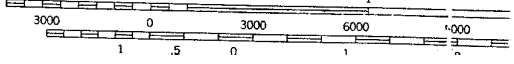

2KTOK B-11



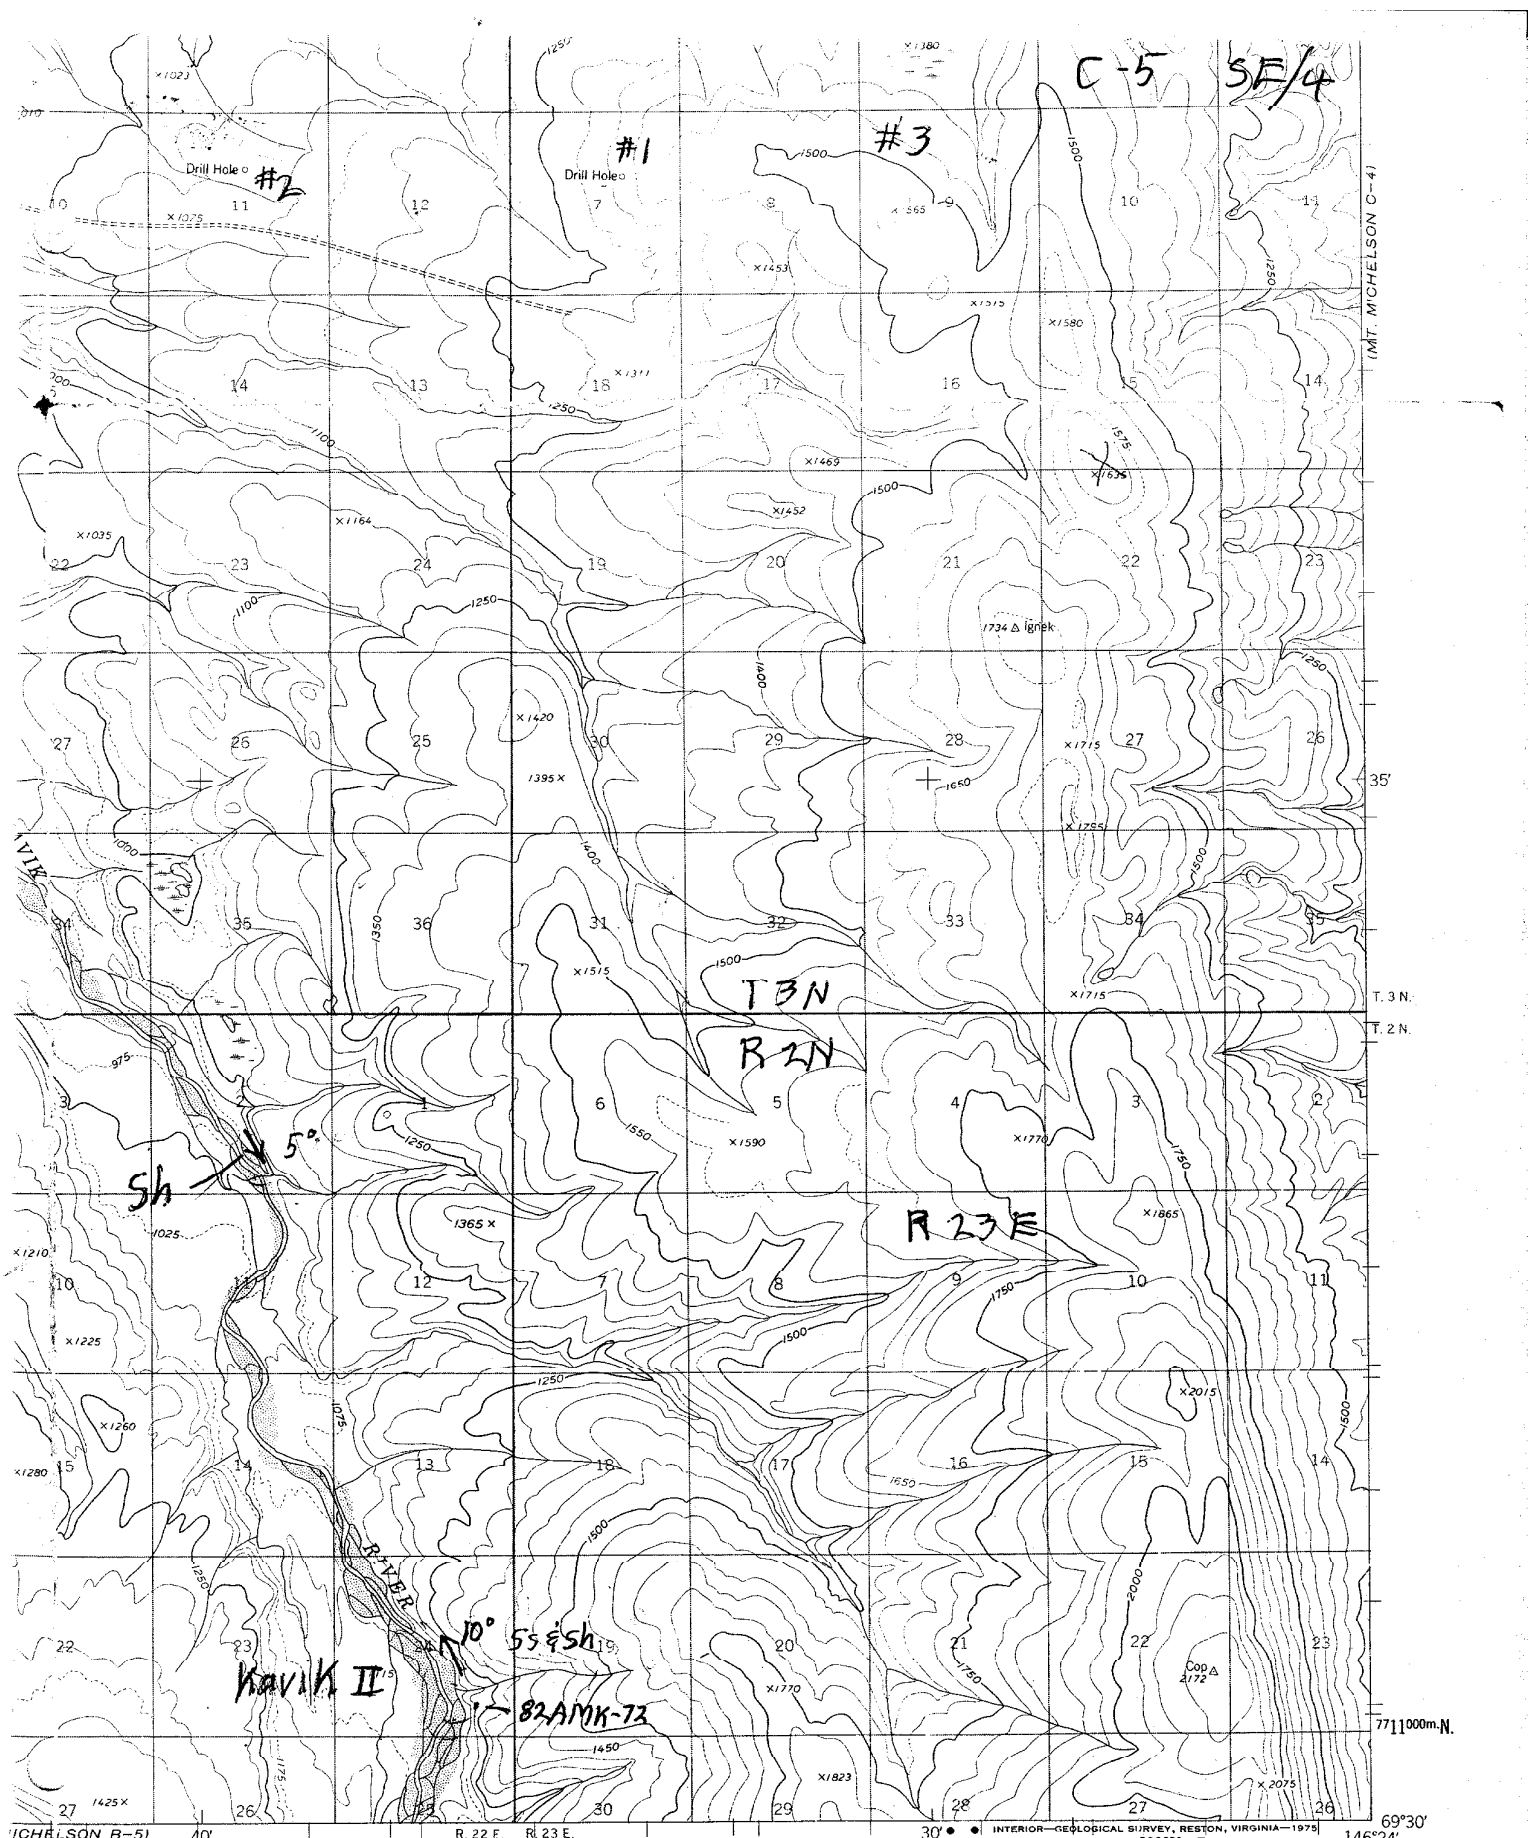

MT MICHELSON B-5) 40' R. 22 E. R. 23 E. 30' ● ● INTERIOR—GEOLOGICAL SURVEY, RESTON, VIRGINIA—1975 522000m.E. 69°30' 146°24'

SCALE 1:63360

0 2 3 4 MILES

0 12000 15000 18000 21000 FEET

0 2 3 4 5 KILOMETRES

MT Michelson C-5 SE/4

ROAD CLASSIFICATION


Unimproved dirt .....

(MT. MICHELSON)

AND A-3)

UNITED STATES  
DEPARTMENT OF THE INTERIOR  
GEOLOGICAL SURVEY

D-2 Mt. Michelson NW/4

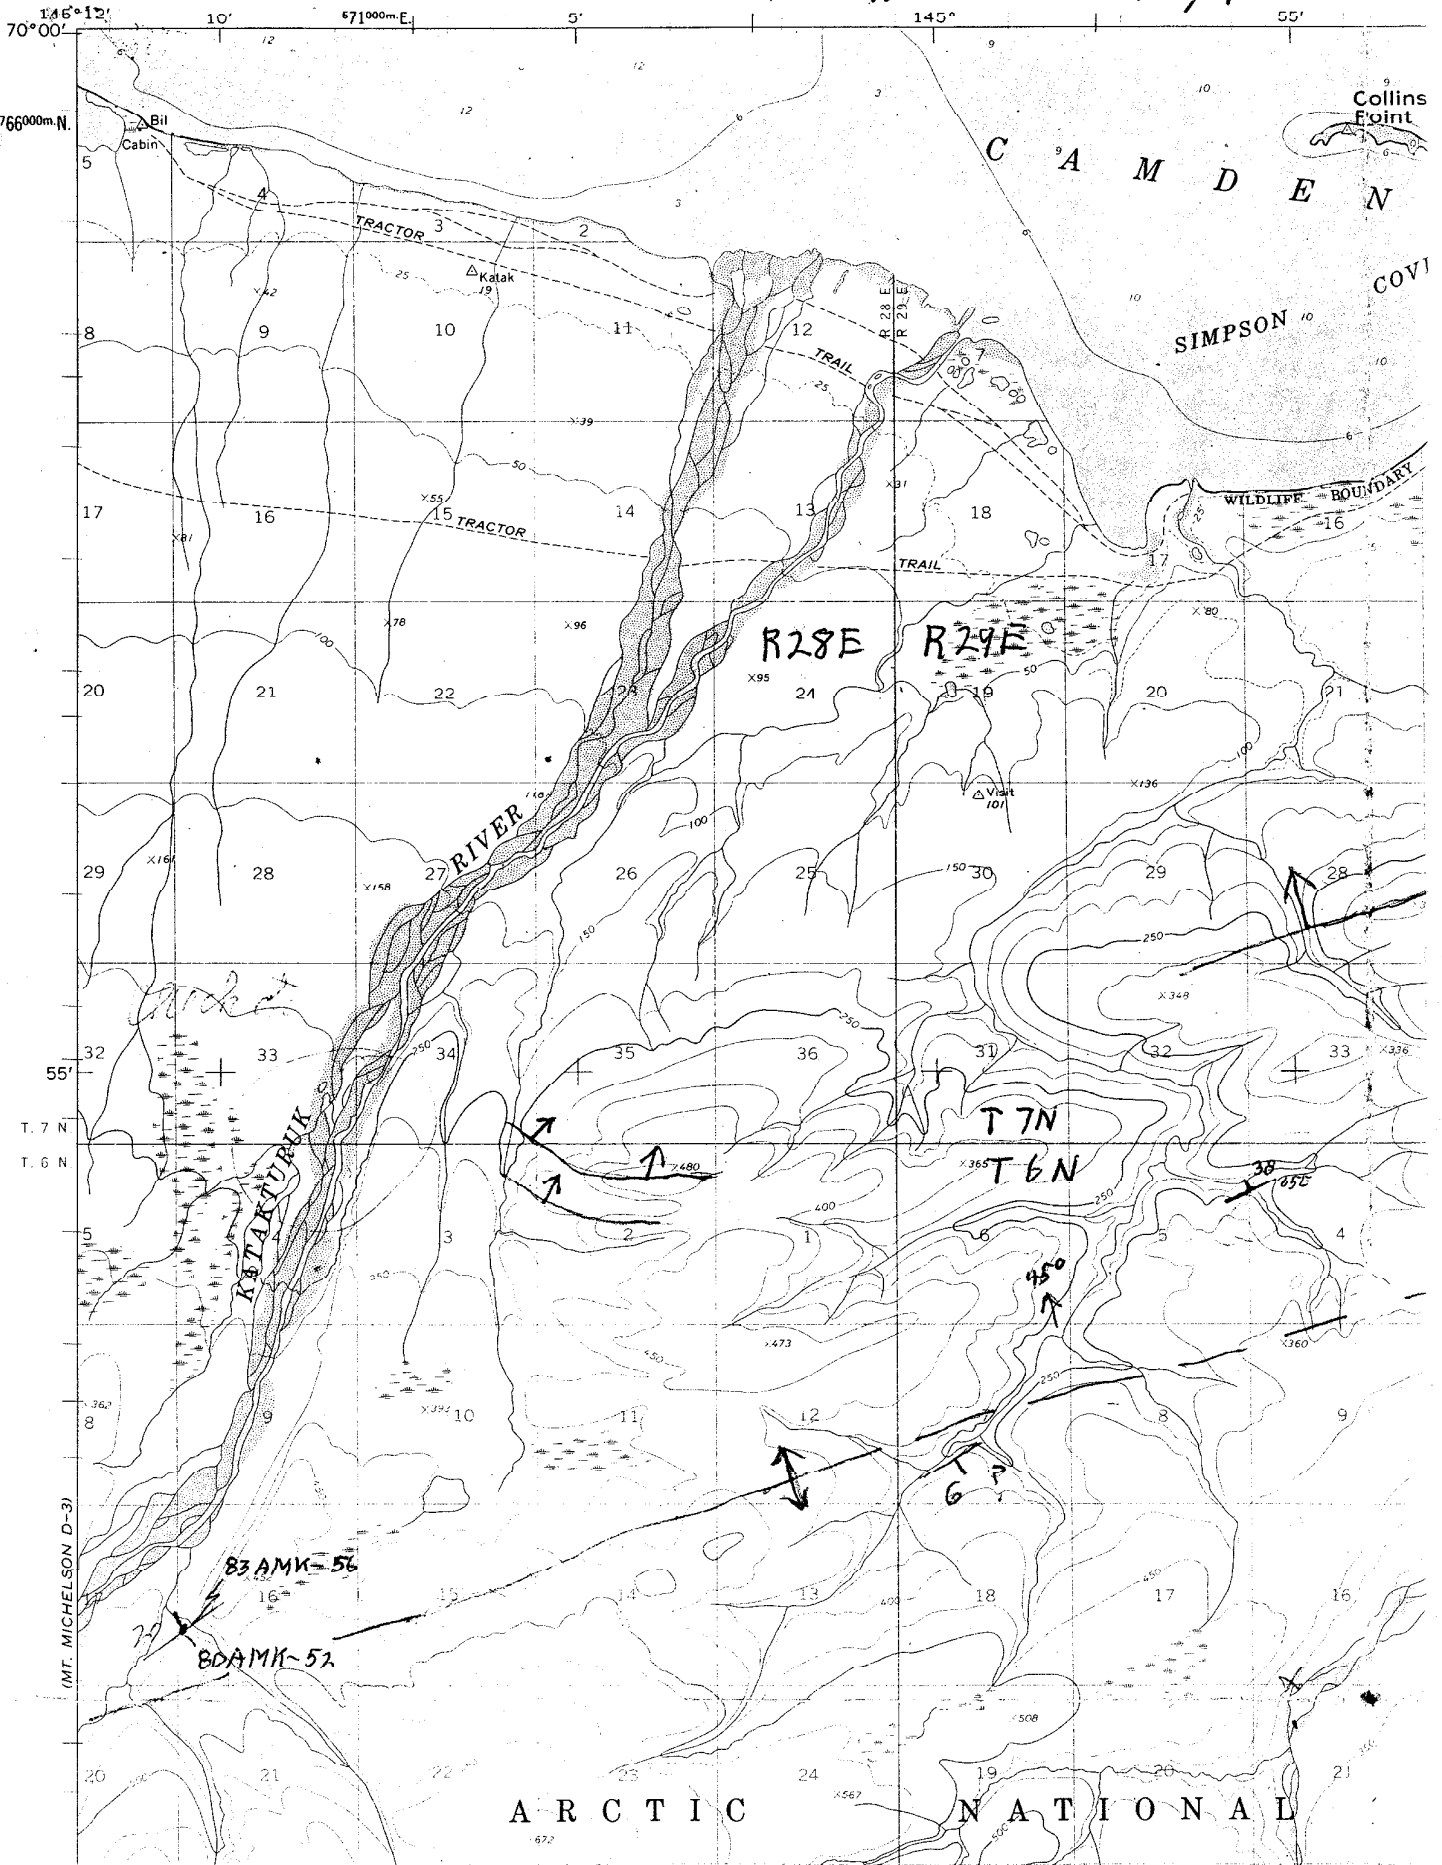


ARCTIC NATIONAL

Mt. Michelson

D-2 NE/4


MT. MICHELSON (D-2) QUADRANGLE  
ALASKA  
1:63 360 SERIES (TOPOGRAPHIC)

(FLAXMAN)

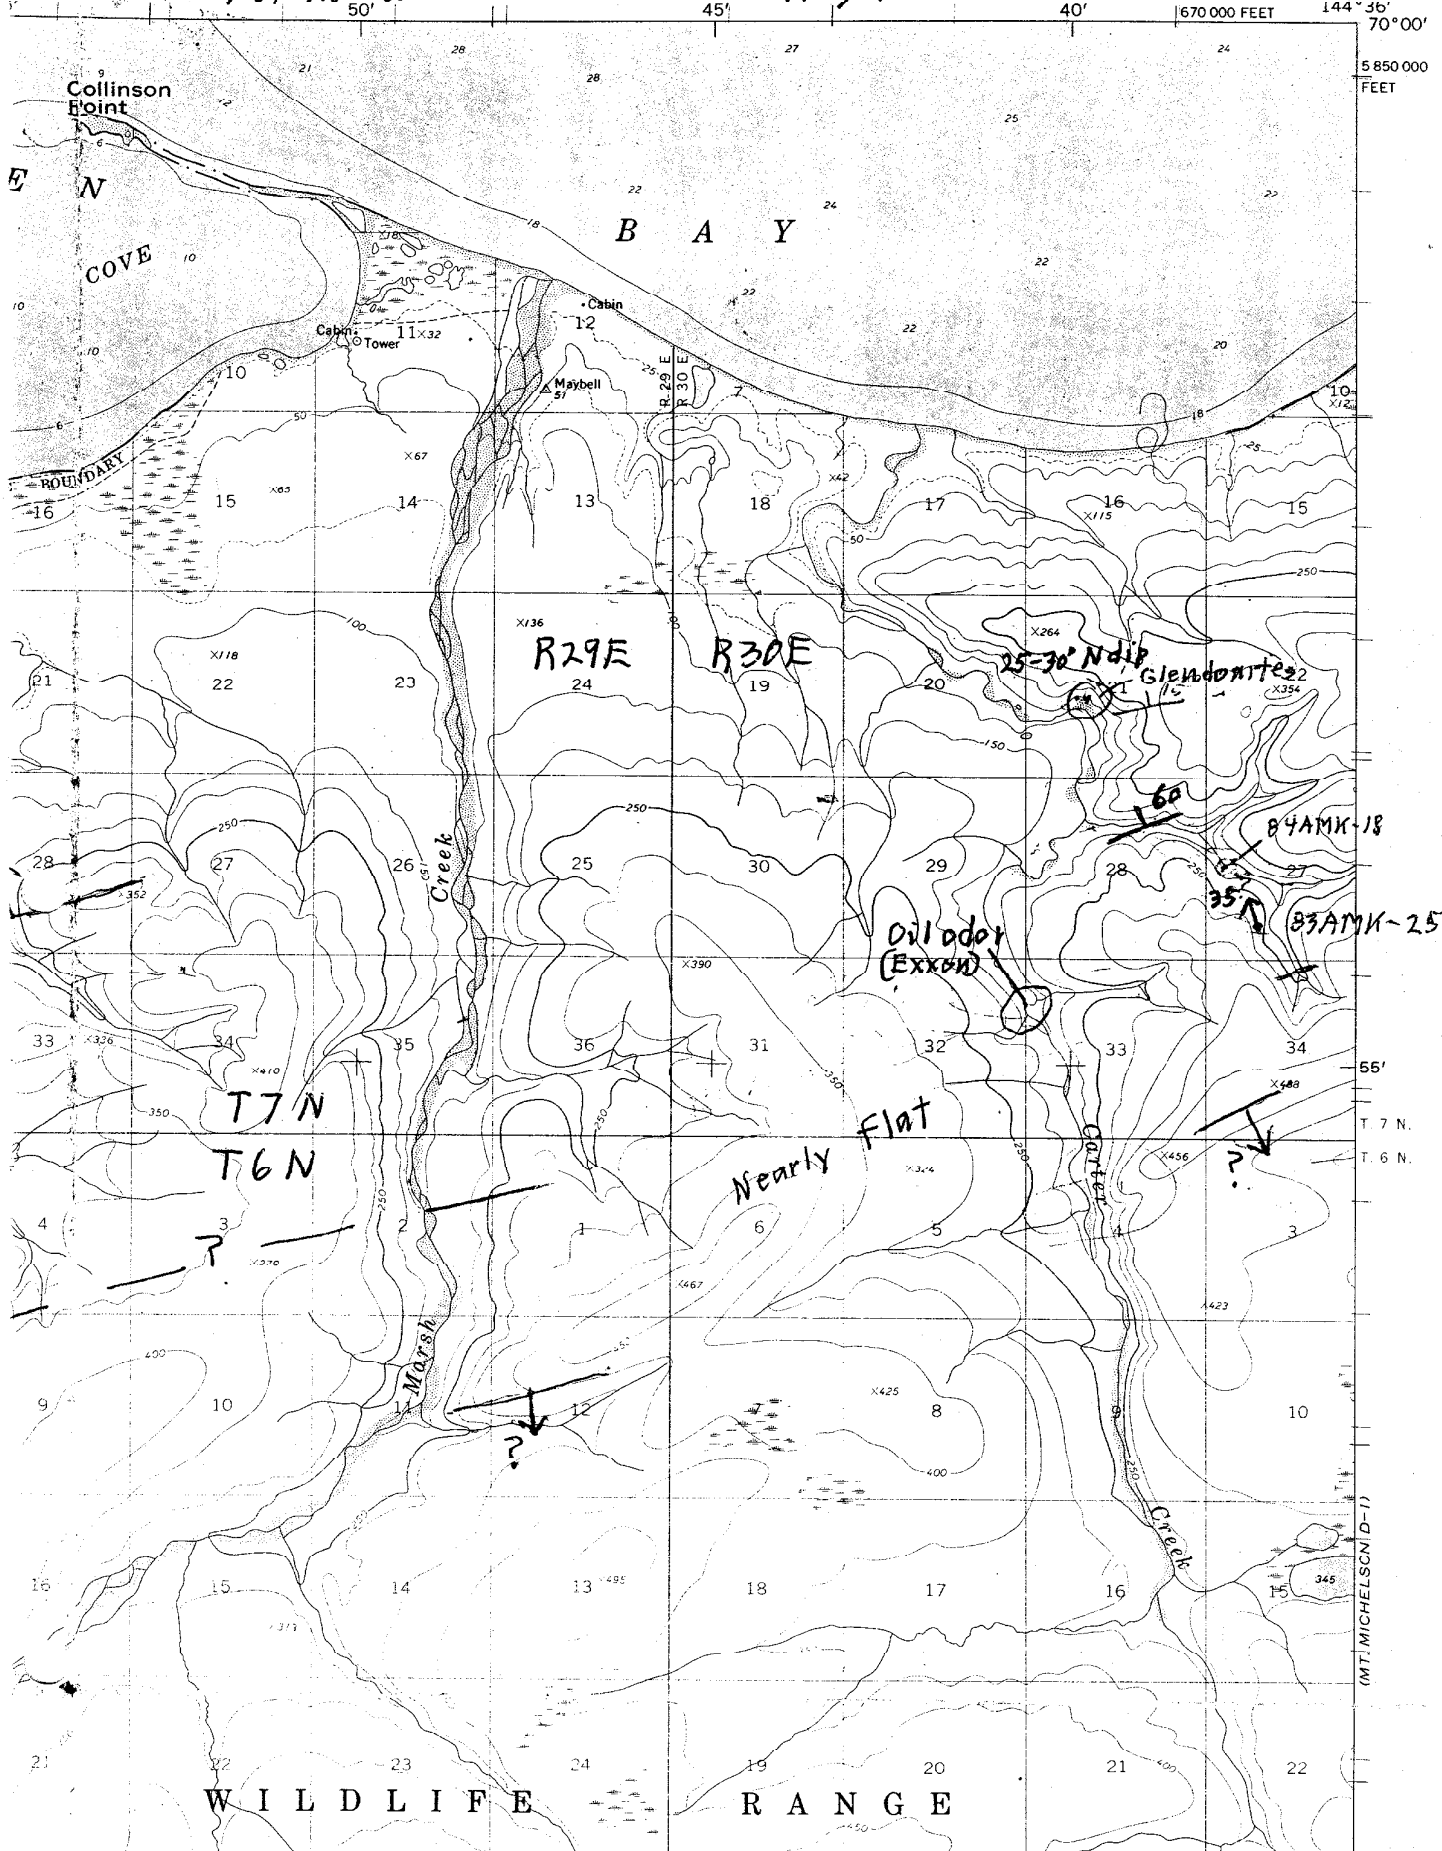

WILDLIFE RANGE

(MT. MICHELSON D-1)

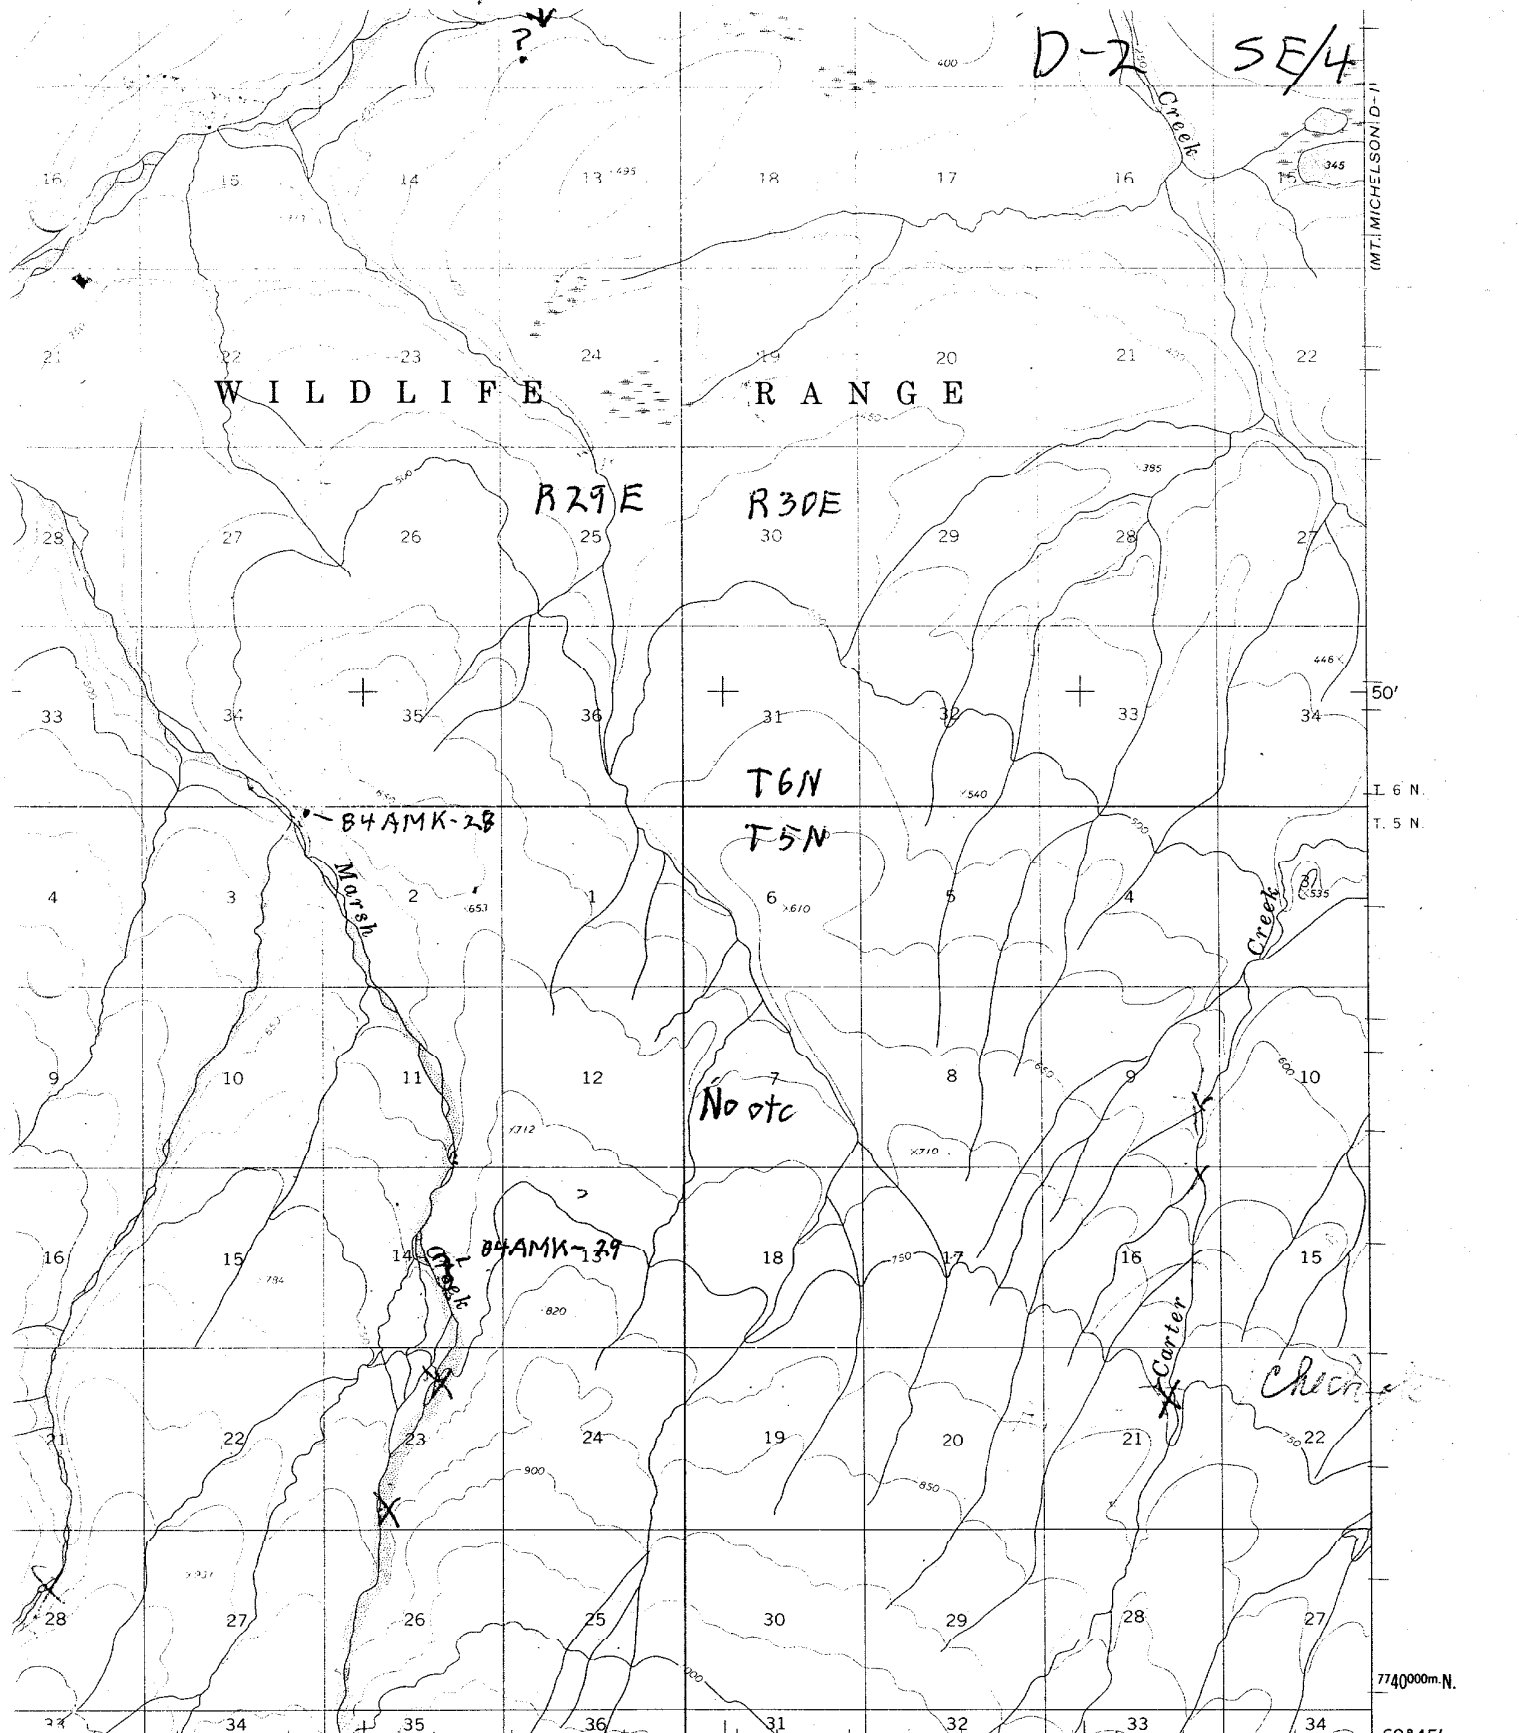

MICHELSON C-2

SCALE 1:63360

4 MILES

9000 12000 15000 18000 21000 FEET

2 3 4 5 KILOMETERS

JR INTERVAL 50 FEET  
 REPRESENT 25-FOOT CONTOURS  
 M IS MEAN SEA LEVEL

mt michelson

D-2 SE/4

INTERIOR-GEOLOGICAL SURVEY, WASHINGTON, D. C. - 1968

591000m. E.

ROAD CLASSIFICATION


Trails

7740000m. N.

69° 45'

144° 36'


(MT. MICHELSON)

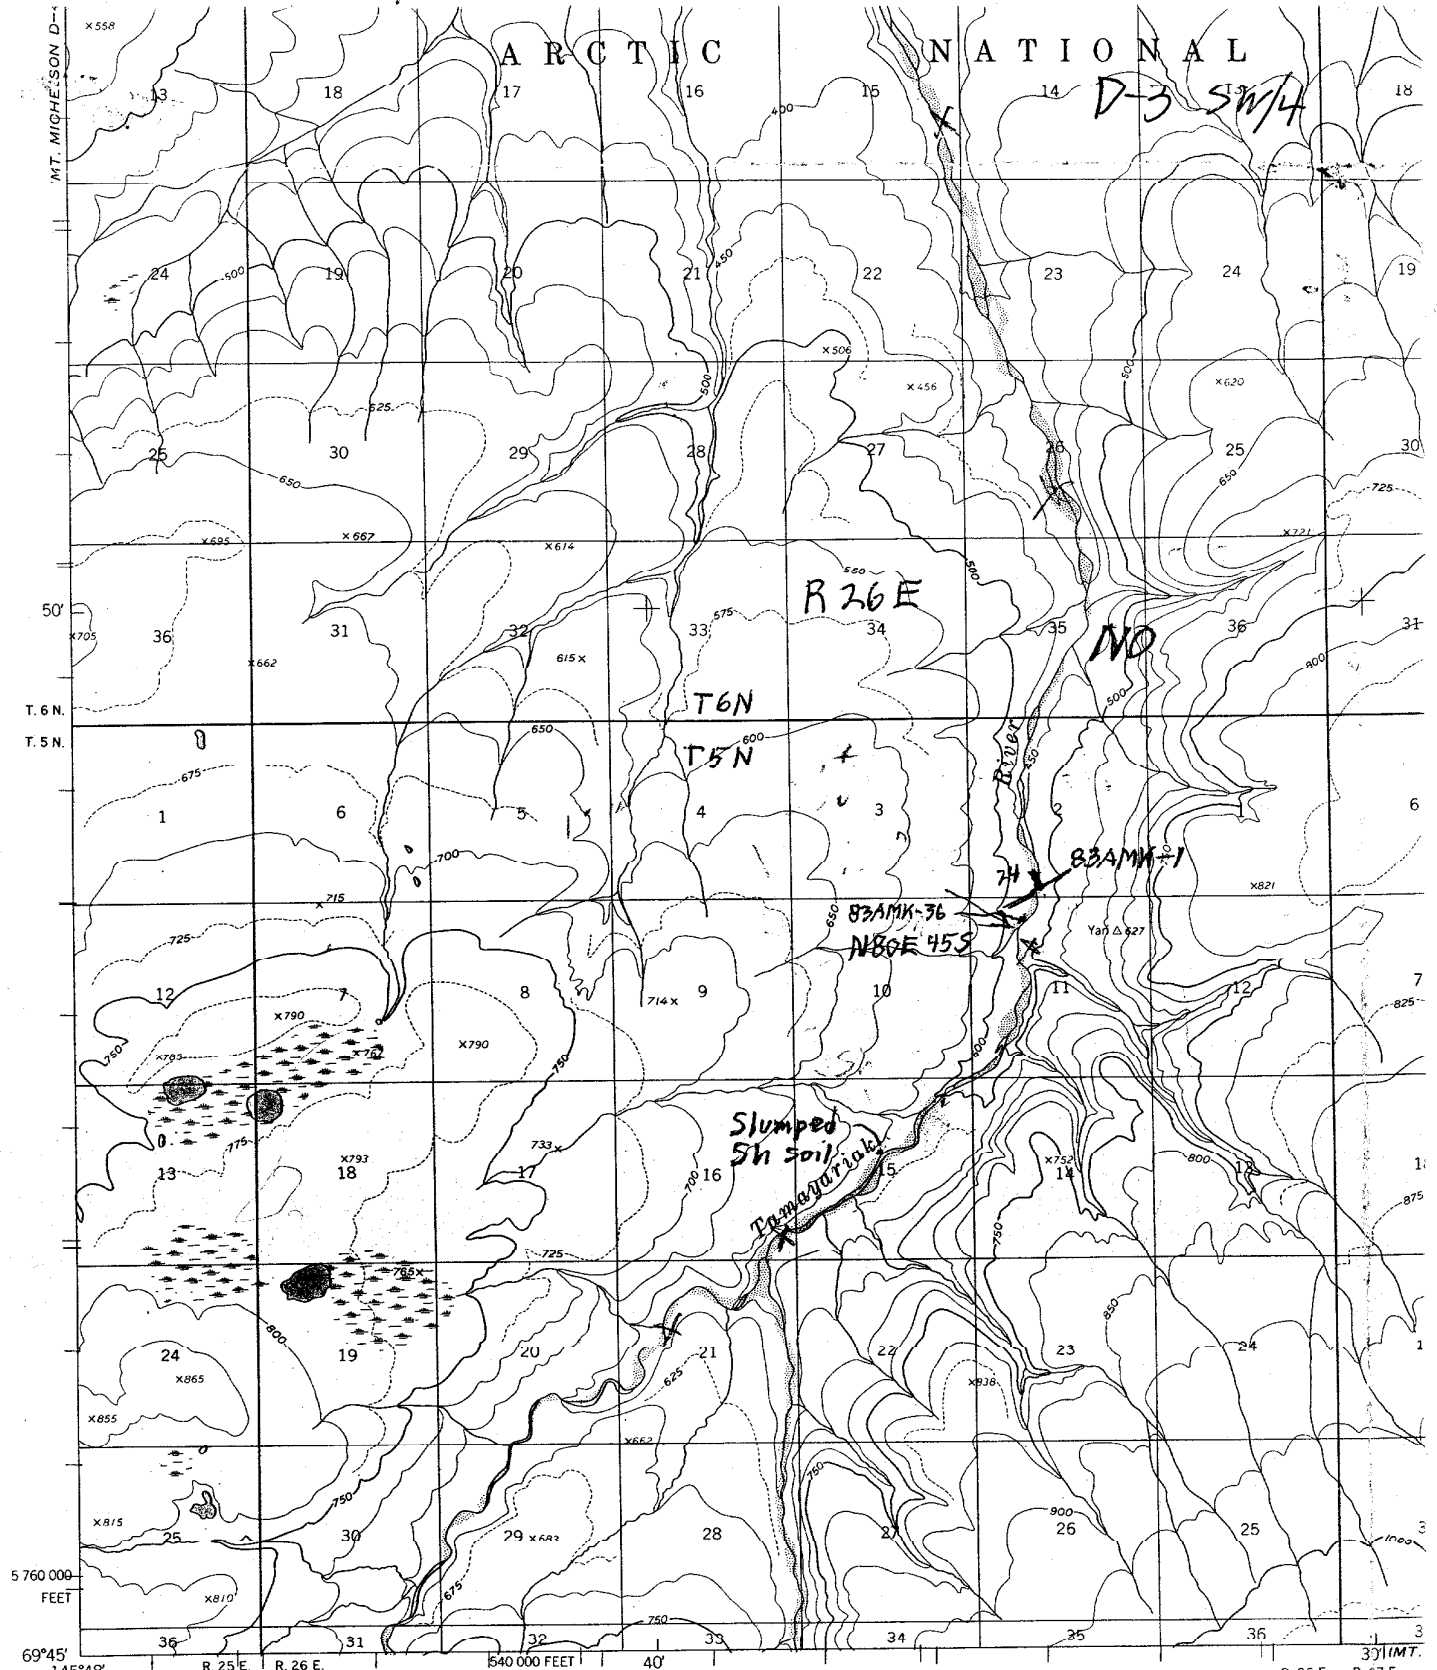

Mapped by the Army Map Service  
 Edited and published by the Geological Survey  
 Control by USC&GS and USCE  
 Topography by photogrammetric methods from aerial photographs  
 taken 1955, field annotated 1955. Map not field checked  
 Selected hydrographic data compiled from USC&GS  
 Chart 9475 (1956). This information is not intended  
 for navigational purposes  
 Universal Transverse Mercator projection. 1927 North American datum  
 10,000-foot grid based on Alaska coordinate system, zone 3  
 1000-meter Universal Transverse Mercator grid ticks,

*Mt Michelson*  
 D-3  
 SW/4


APPROXIMATE MEAN  
 DECLINATION, 1955

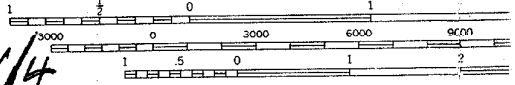

CONTOUR INTERVAL  
 DOTTED LINES REPRESENT 25  
 DATUM IS MEAN SEA  
 SOUNDINGS IN FEET-DATUM IS MEAN  
 SHORELINE SHOWN REPRESENTS THE APPROXIMA  
 THE MEAN RANGE OF TIDE IS APPR


FOR SALE BY U.S. GEOLOGICAL SURVEY  
 FAIRBANKS ALASKA DENVER 25 COLORADO

MICH SW C-4

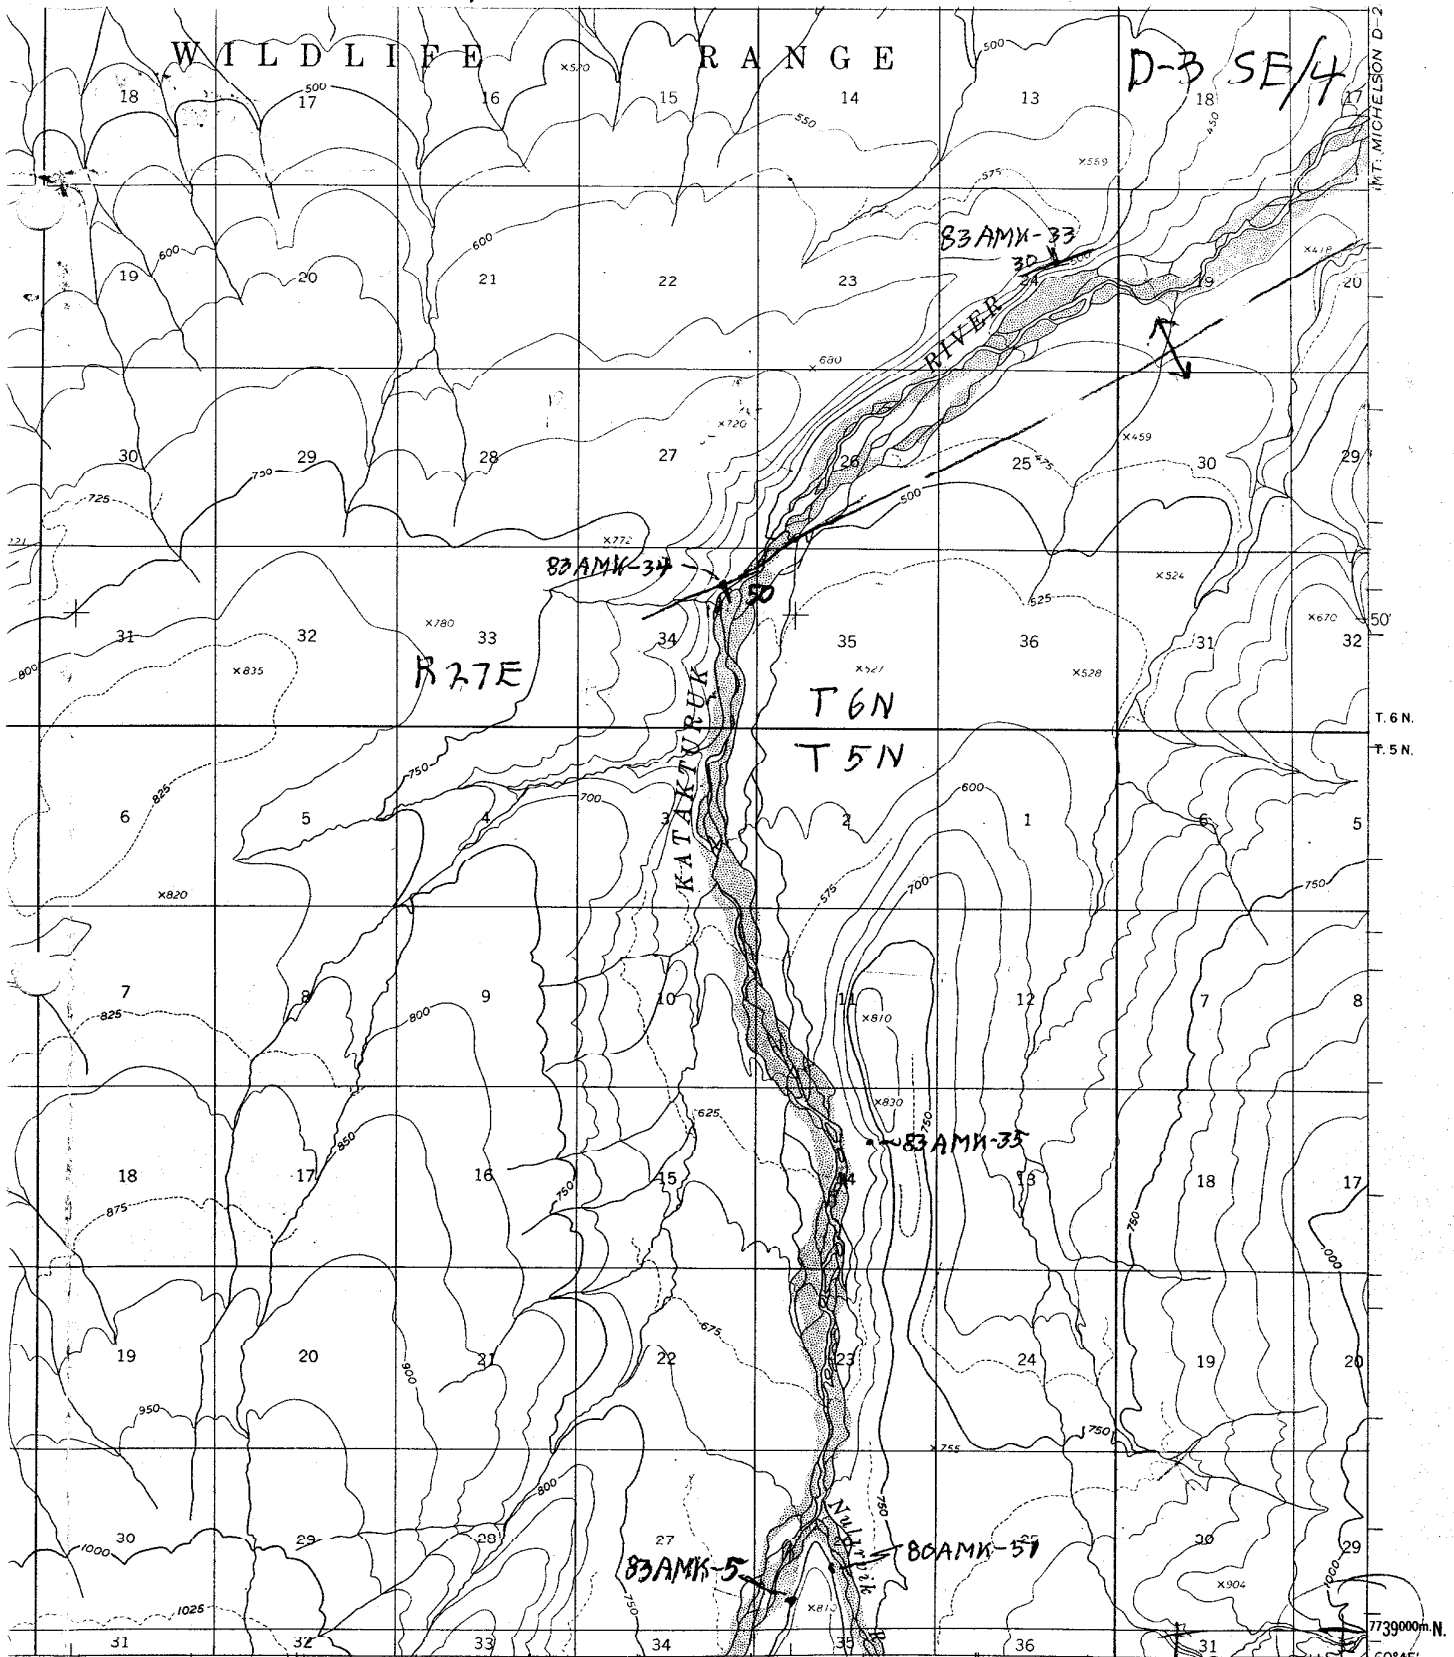

31 | MT. MICHELSON C-31  
 E. R. 27 E.  
 SCALE 1:63360

*Mt Michelson*

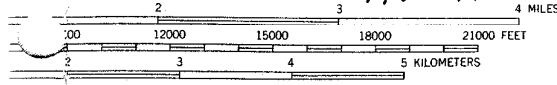

R INTERVAL 50 FEET  
 REPRESENT 25-FOOT CONTOURS  
 1 IS MEAN SEA LEVEL  
 DATUM IS MEAN LOWER LOW WATER  
 VIS THE APPROXIMATE LINE OF MEAN HIGH WATER  
 IE OF TIDE IS APPROXIMATELY 5 FEET

U. S. GEOLOGICAL SURVEY



QUADRANGLE LOCATION


INTERIOR GEOLOGICAL SURVEY, WASHINGTON, D. C. 20515  
 R. 27 E. R. 28 E. 569000m E. 69°45' 145°12'

*D-3 SE/4*

ROAD CLASSIFICATION  
 Trails .....


MT. MICHELSON (D-3), ALASKA  
 N6945-W14512/15X36

MT. MICHELSON D-2  
 T. 6 N.  
 T. 5 N.  
 7739000m N.  
 69°45'  
 145°12'  
 MT. MICHELSON

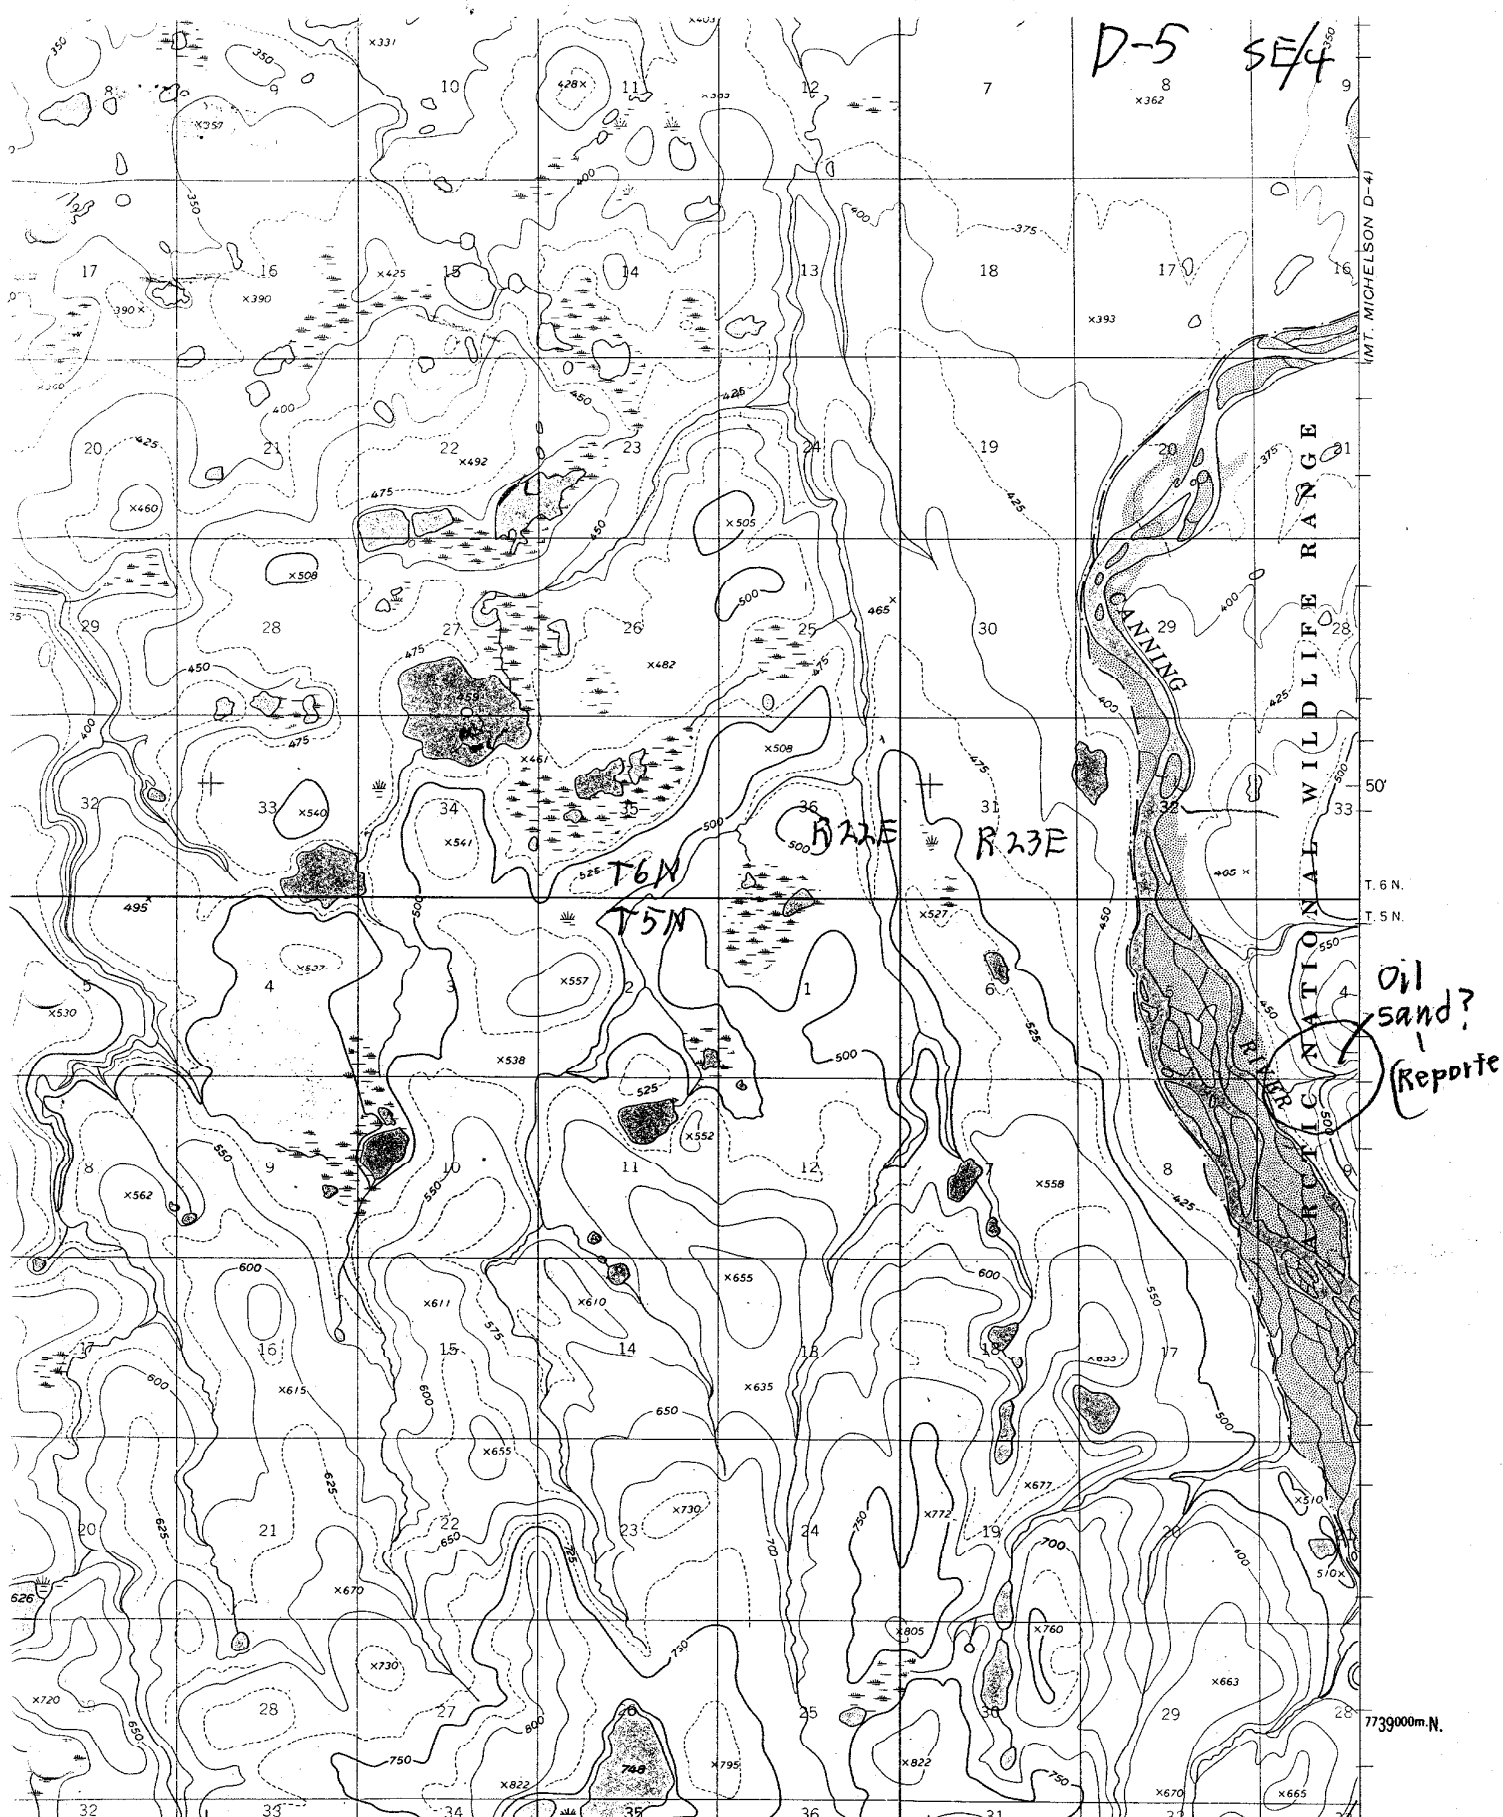


MICHELSON C-5) 40' R. 22 E. 30' R. 23 E. INTERIOR—GEOLOGICAL SURVEY, WASHINGTON, D. C. 1964  
 SCALE 1:63360 4 MILES MT Michelson D-5 SE/4 527000m.E. 146°24' 69°45'  
 ROAD CLASSIFICATION INT. MICHEL

A-4  
SE/4

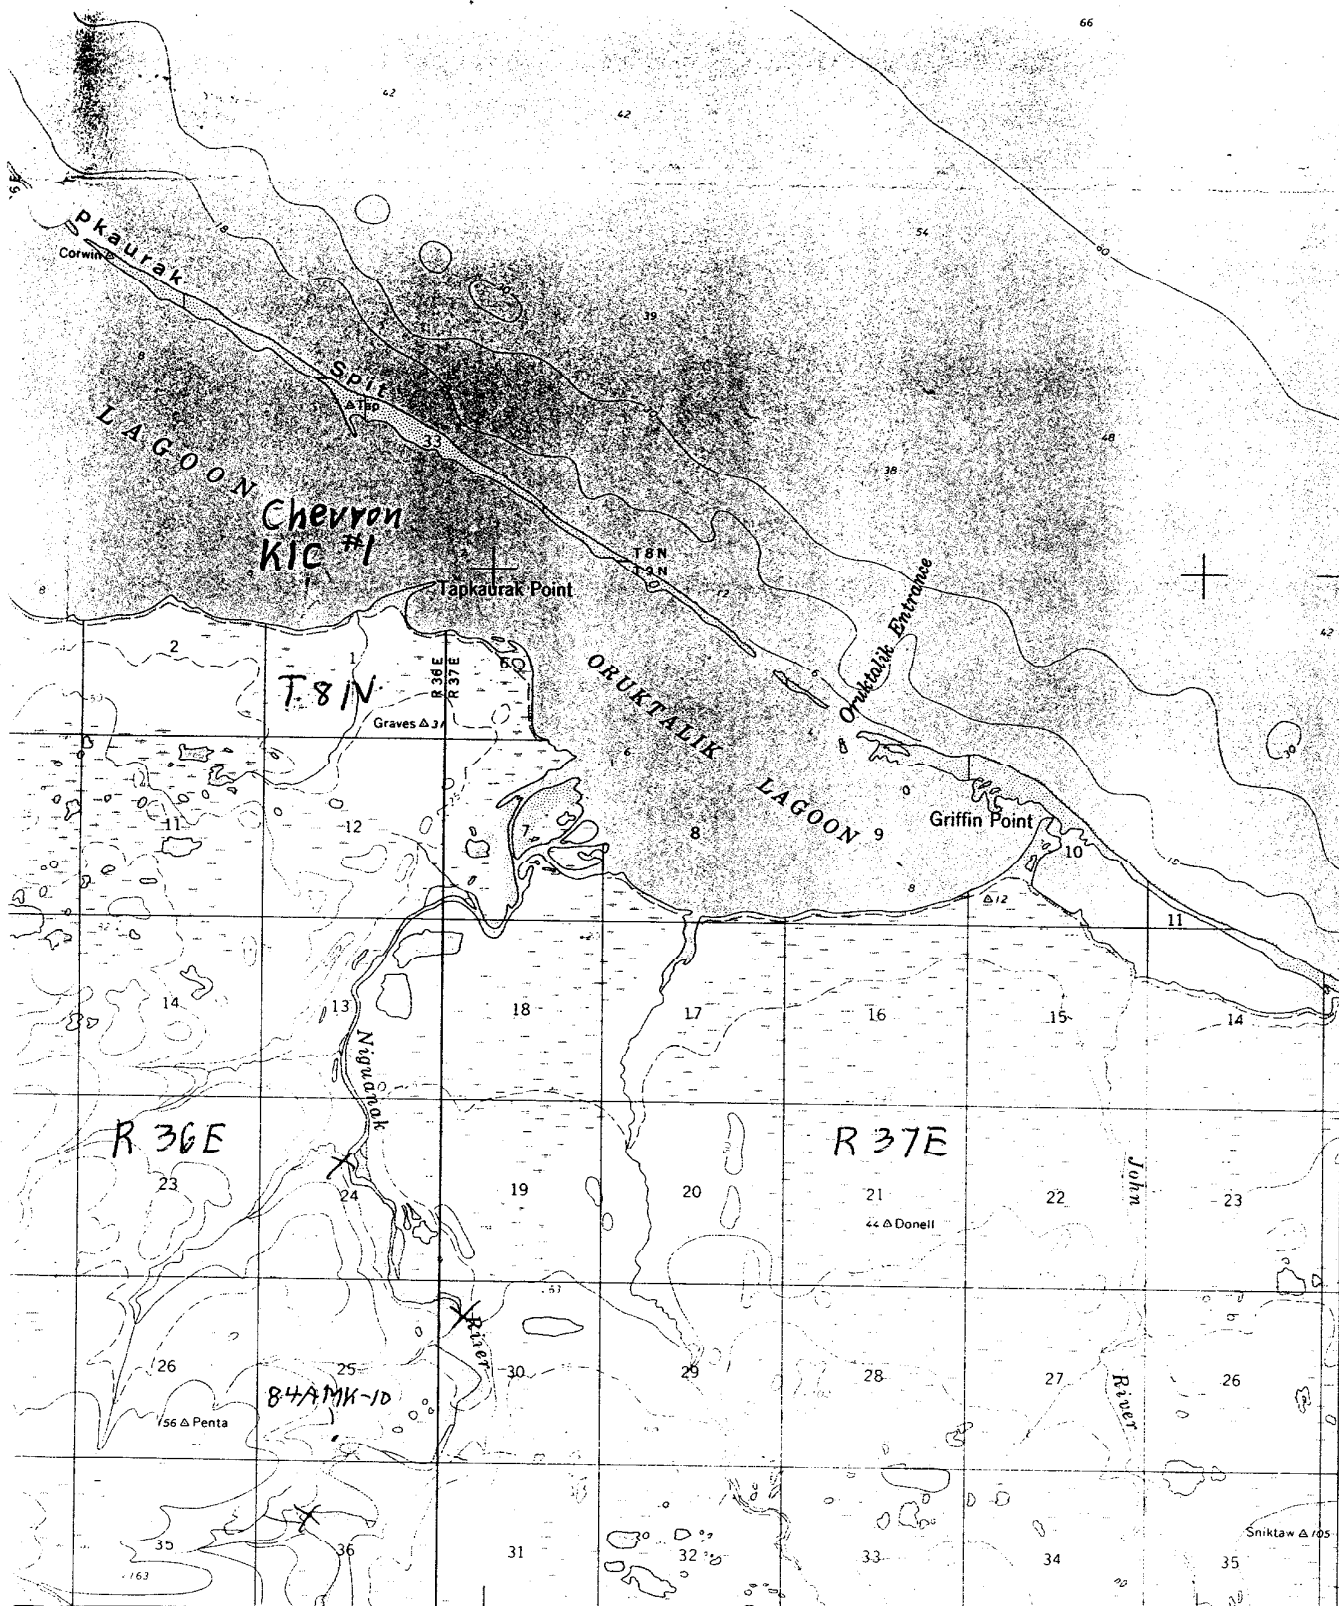

LOCATION POINT D-4) R 36 E. 143° R. 37 E. INTERIOR—GEOLOGICAL SURVEY WASHINGTON D C—1949 50' 431000m F 142° 48' 70° 00'

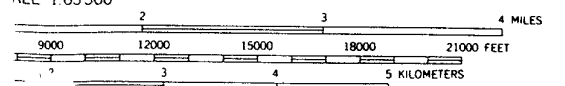

AL 50 FEET  
 REPRESENT 25-FOOT CONTOURS  
 MEAN SEA LEVEL  
 S IN FEET—DATUM IS MEAN LOW WATER  
 THE APPROXIMATE LINE OF MEAN HIGH WATER  
 DE IS APPROXIMATELY 0.5 OF A FOOT

U.S. GEOLOGICAL SURVEY  
 COLORADO 80225, OR WASHINGTON, D.C. 20242  
 MAPS AND SYMBOLS IS AVAILABLE ON REQUEST



QUADRANGLE LOCATION

Barter Island A-4 SE/4

ROAD CLASSIFICATION  
 No roads or trails in this area

BARTER ISLAND (A-4), ALASKA  
 N7000—W14248/15 X 36

1955


BARTER ISLAND

7768000m N.

DEMARCATION P.



A-5 SE/4

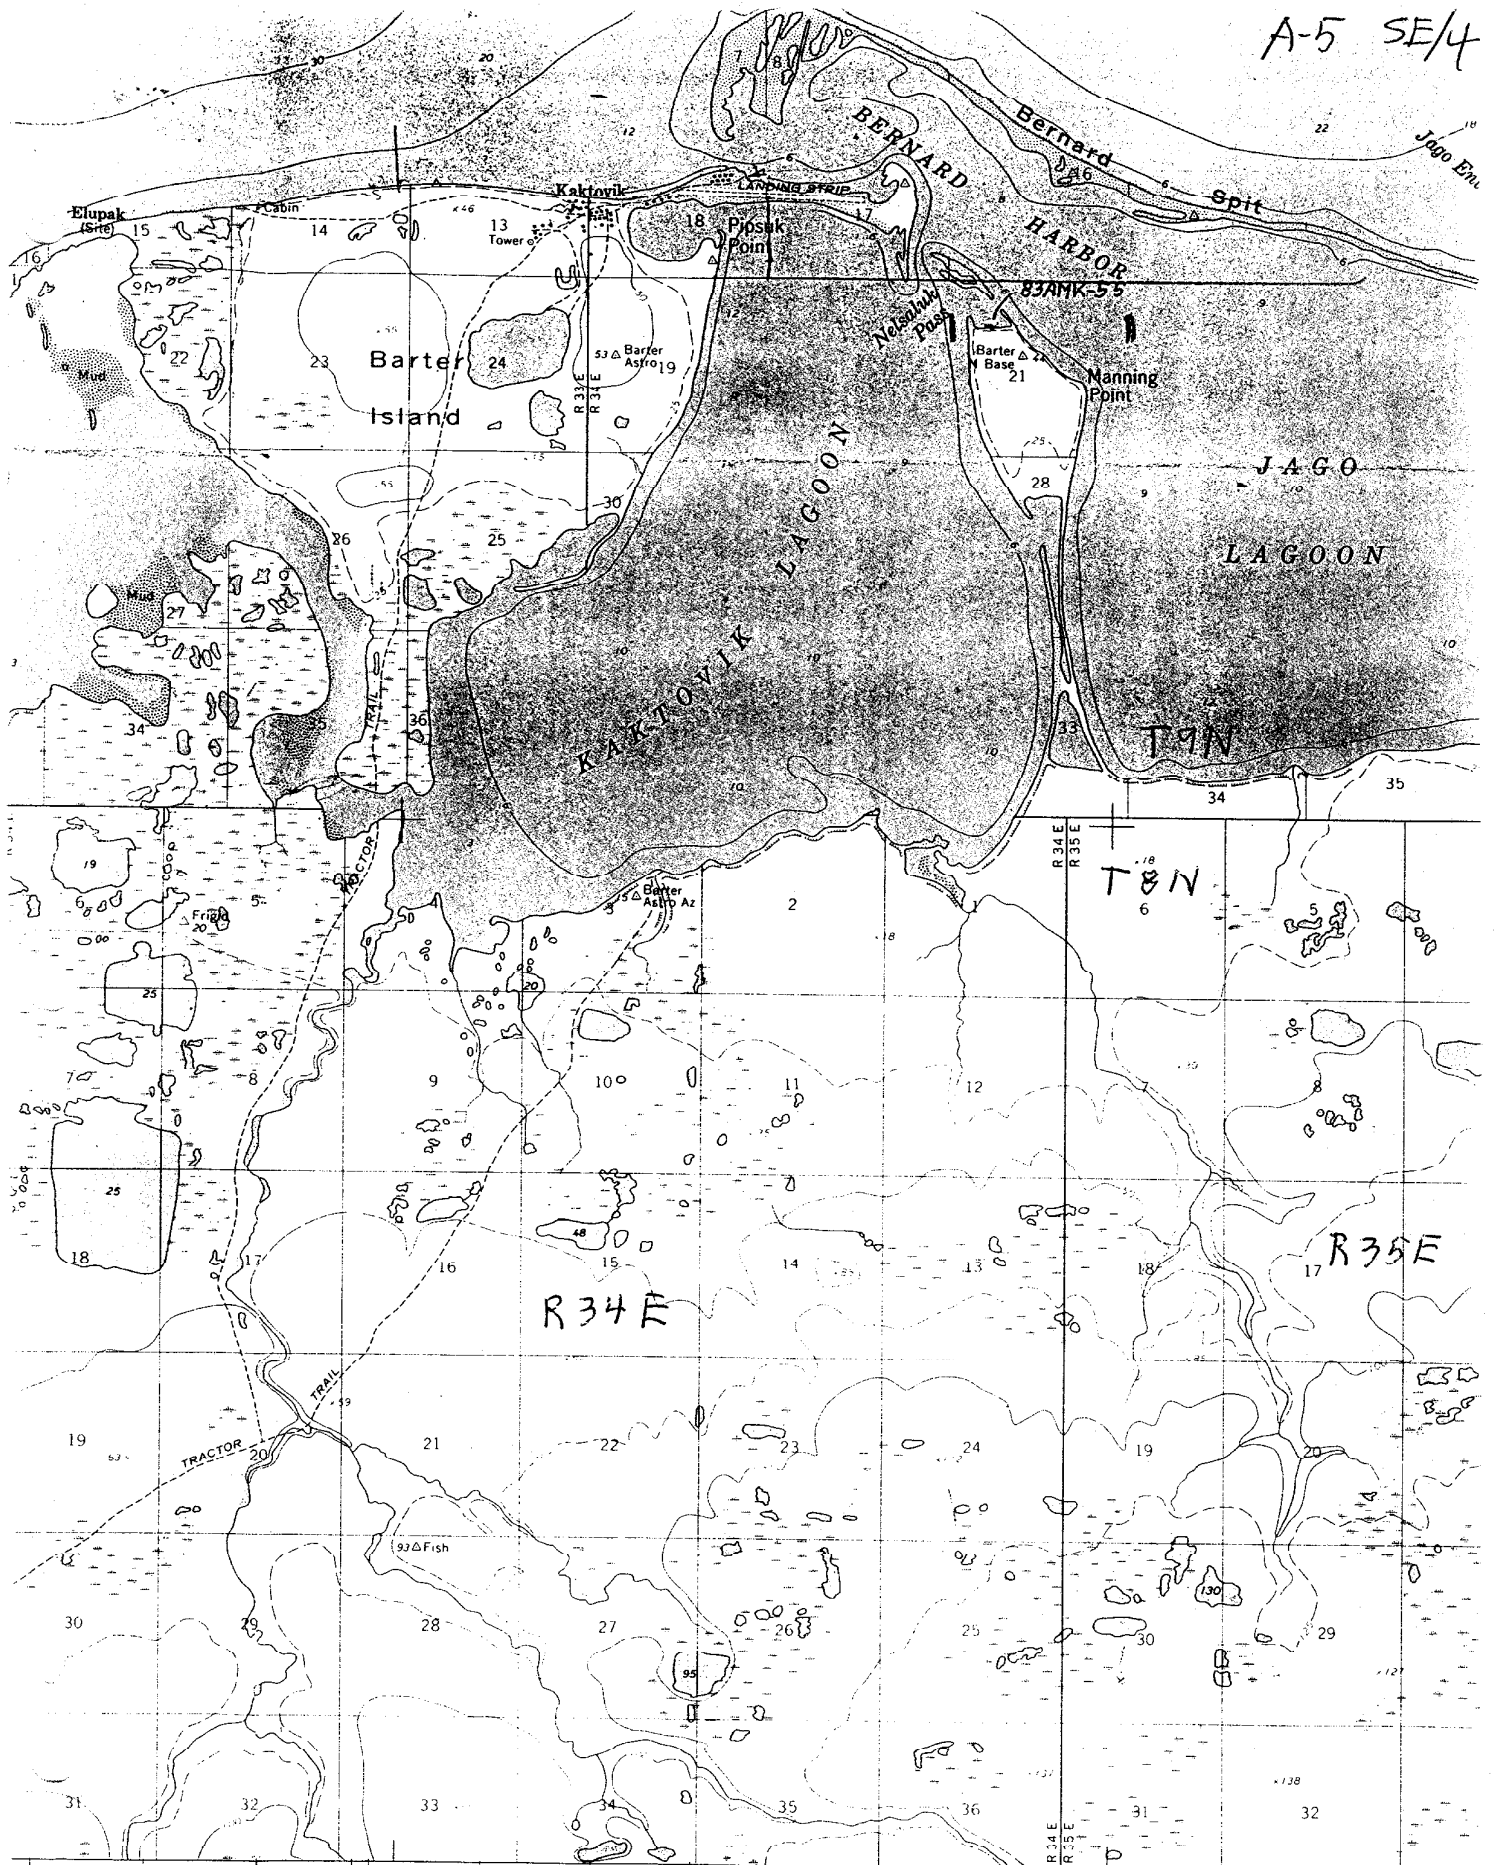

34 E. (DEMARCATIION POINT D-5) 40'

SCALE 1:63360

INTERIOR-GEOLOGICAL SURVEY, WASHINGTON, D.C. - 1969 30'

408000m.E.




4 MILES

Barter Is A-5 SE/4

Sagavanirktok A-2 NW/4

148° 12' 453000m.E. 10' 740 000 FEET (ZONE 4) 148° (SAGAVANIRKTOK B)

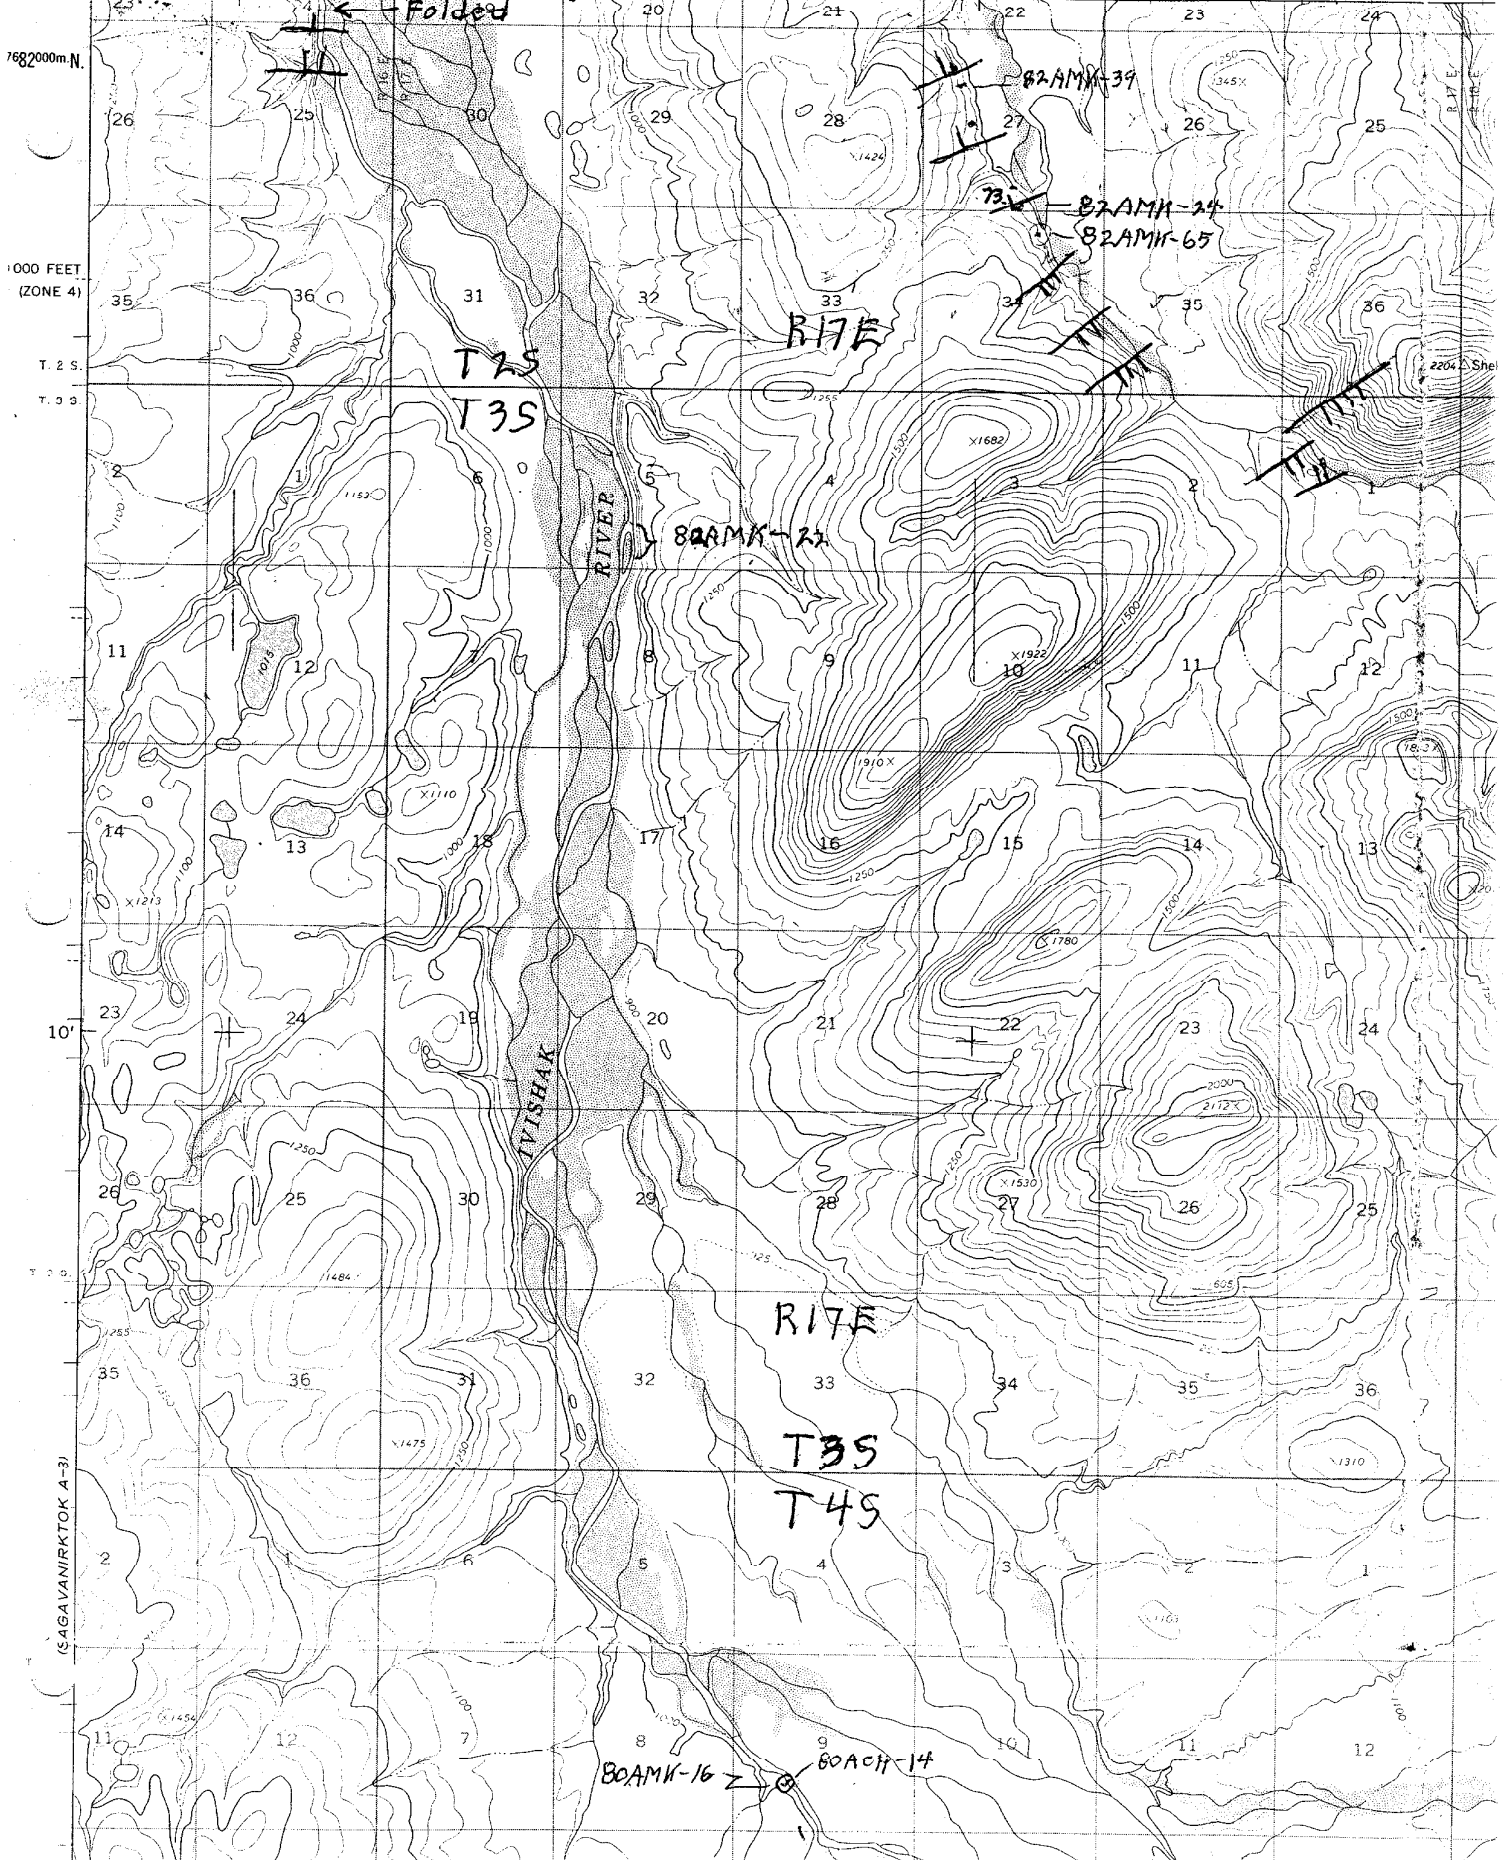

SAGAVANIRKTOK (A-2) QUADRANGLE


ALASKA

1:63 360 SERIES (TOPOGRAPHIC)

Sagavanirktok A-2 NE/4

SAGAVANIRKTOK B-2

(SAGAVANIRKTOK A-1)

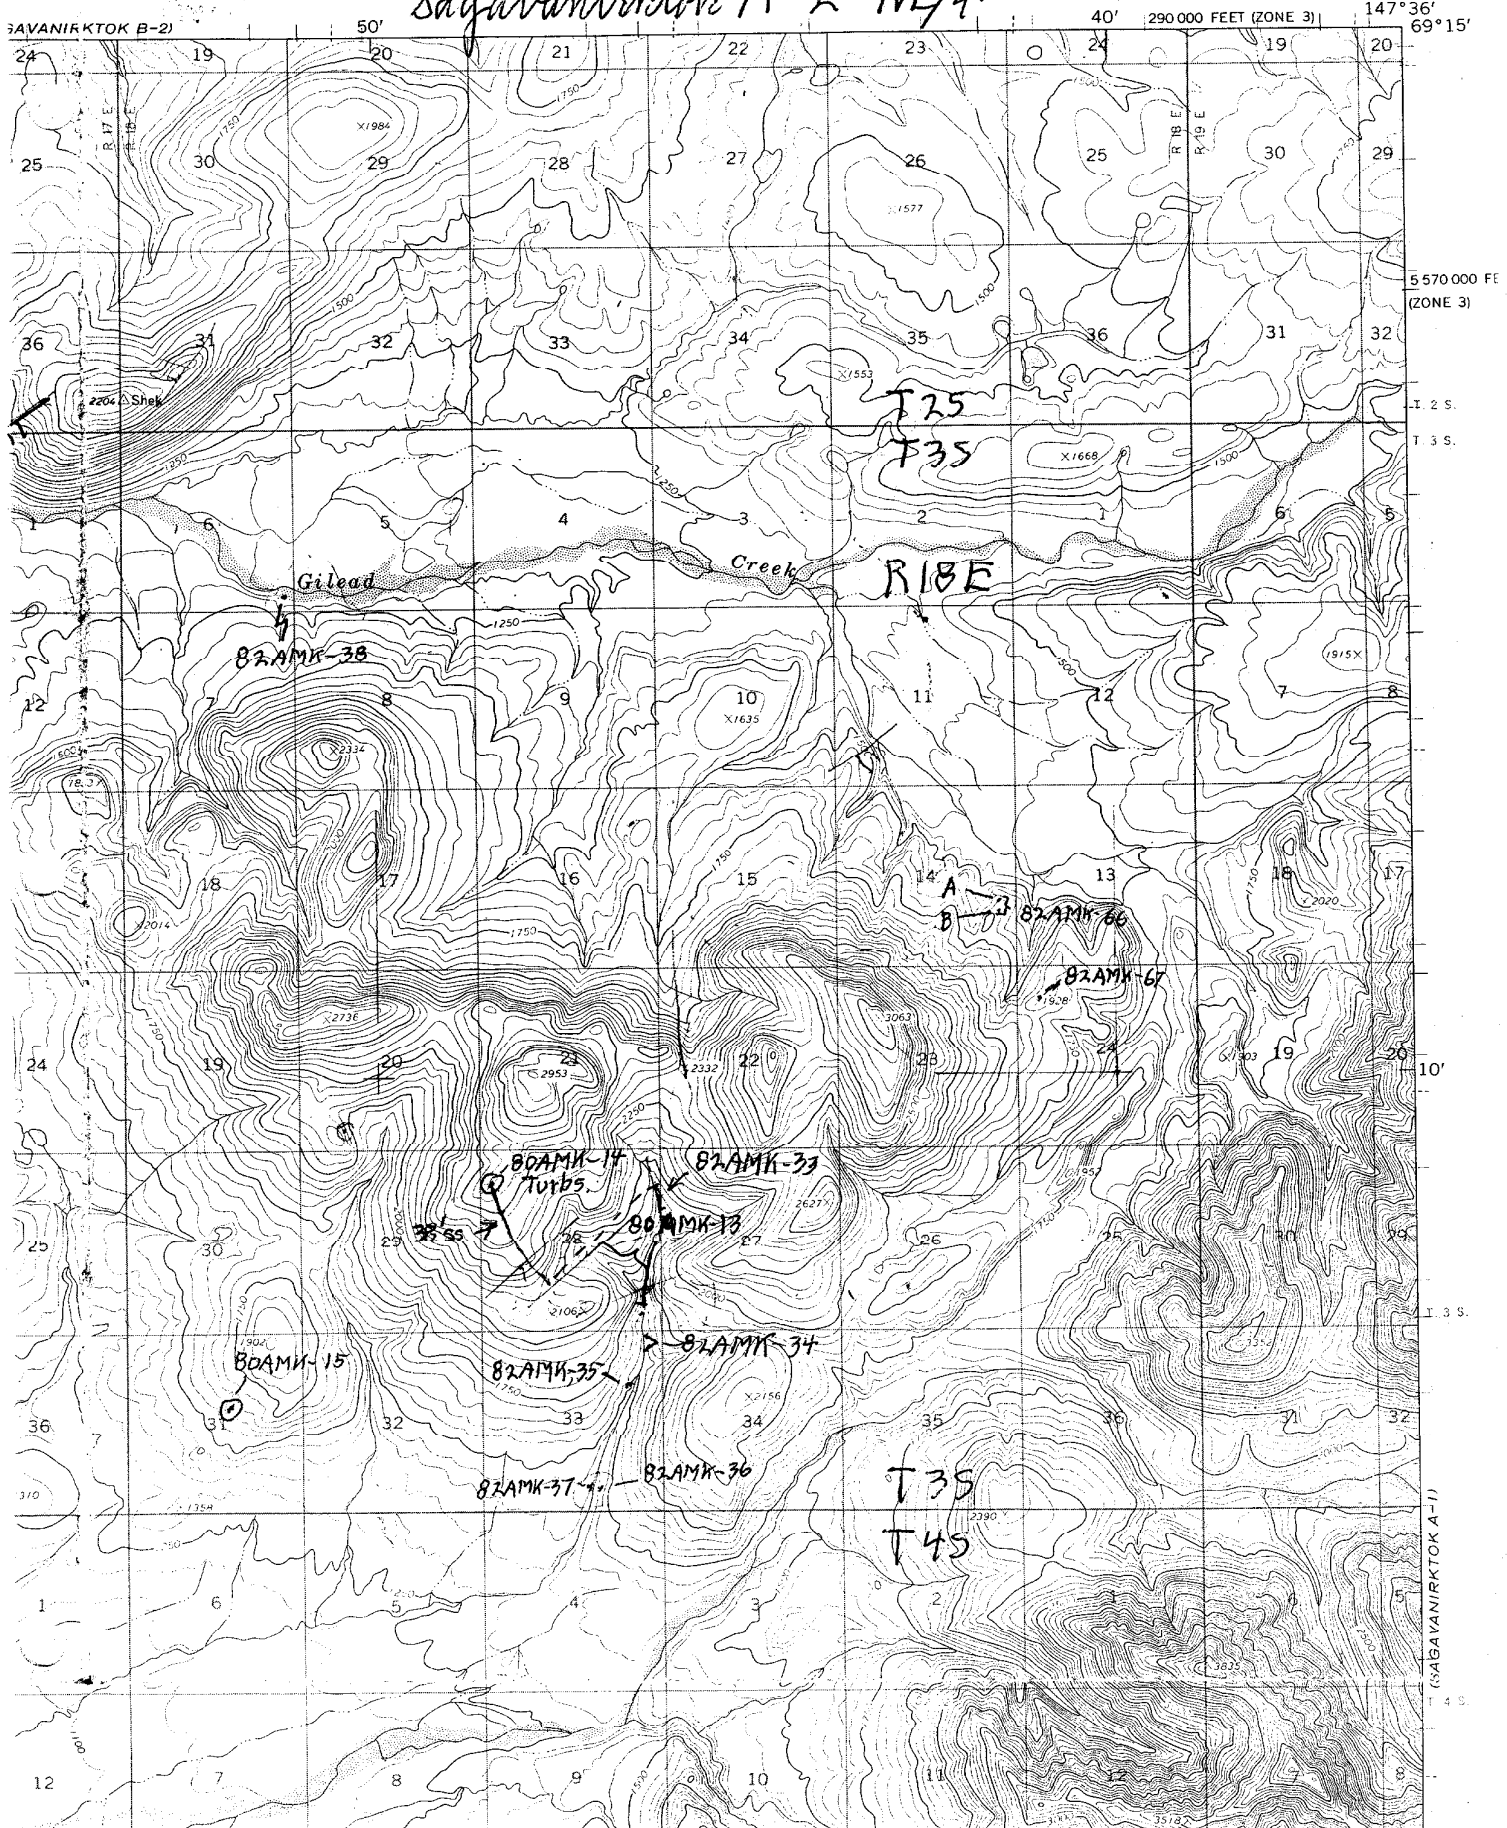

5 570 000 FE (ZONE 3)

I 2 S.  
I 3 S.

10'

I 3 S.

I 3 S.

I 4 S.


(SAGAVANIRKTOK A-1)

K. B-4

DEPARTMENT OF THE INTERIOR  
GEOLOGICAL SURVEY

Sagavanirktok A-3 NW/4

148°48' 430000m E.  
69°15'  
1683000m N.

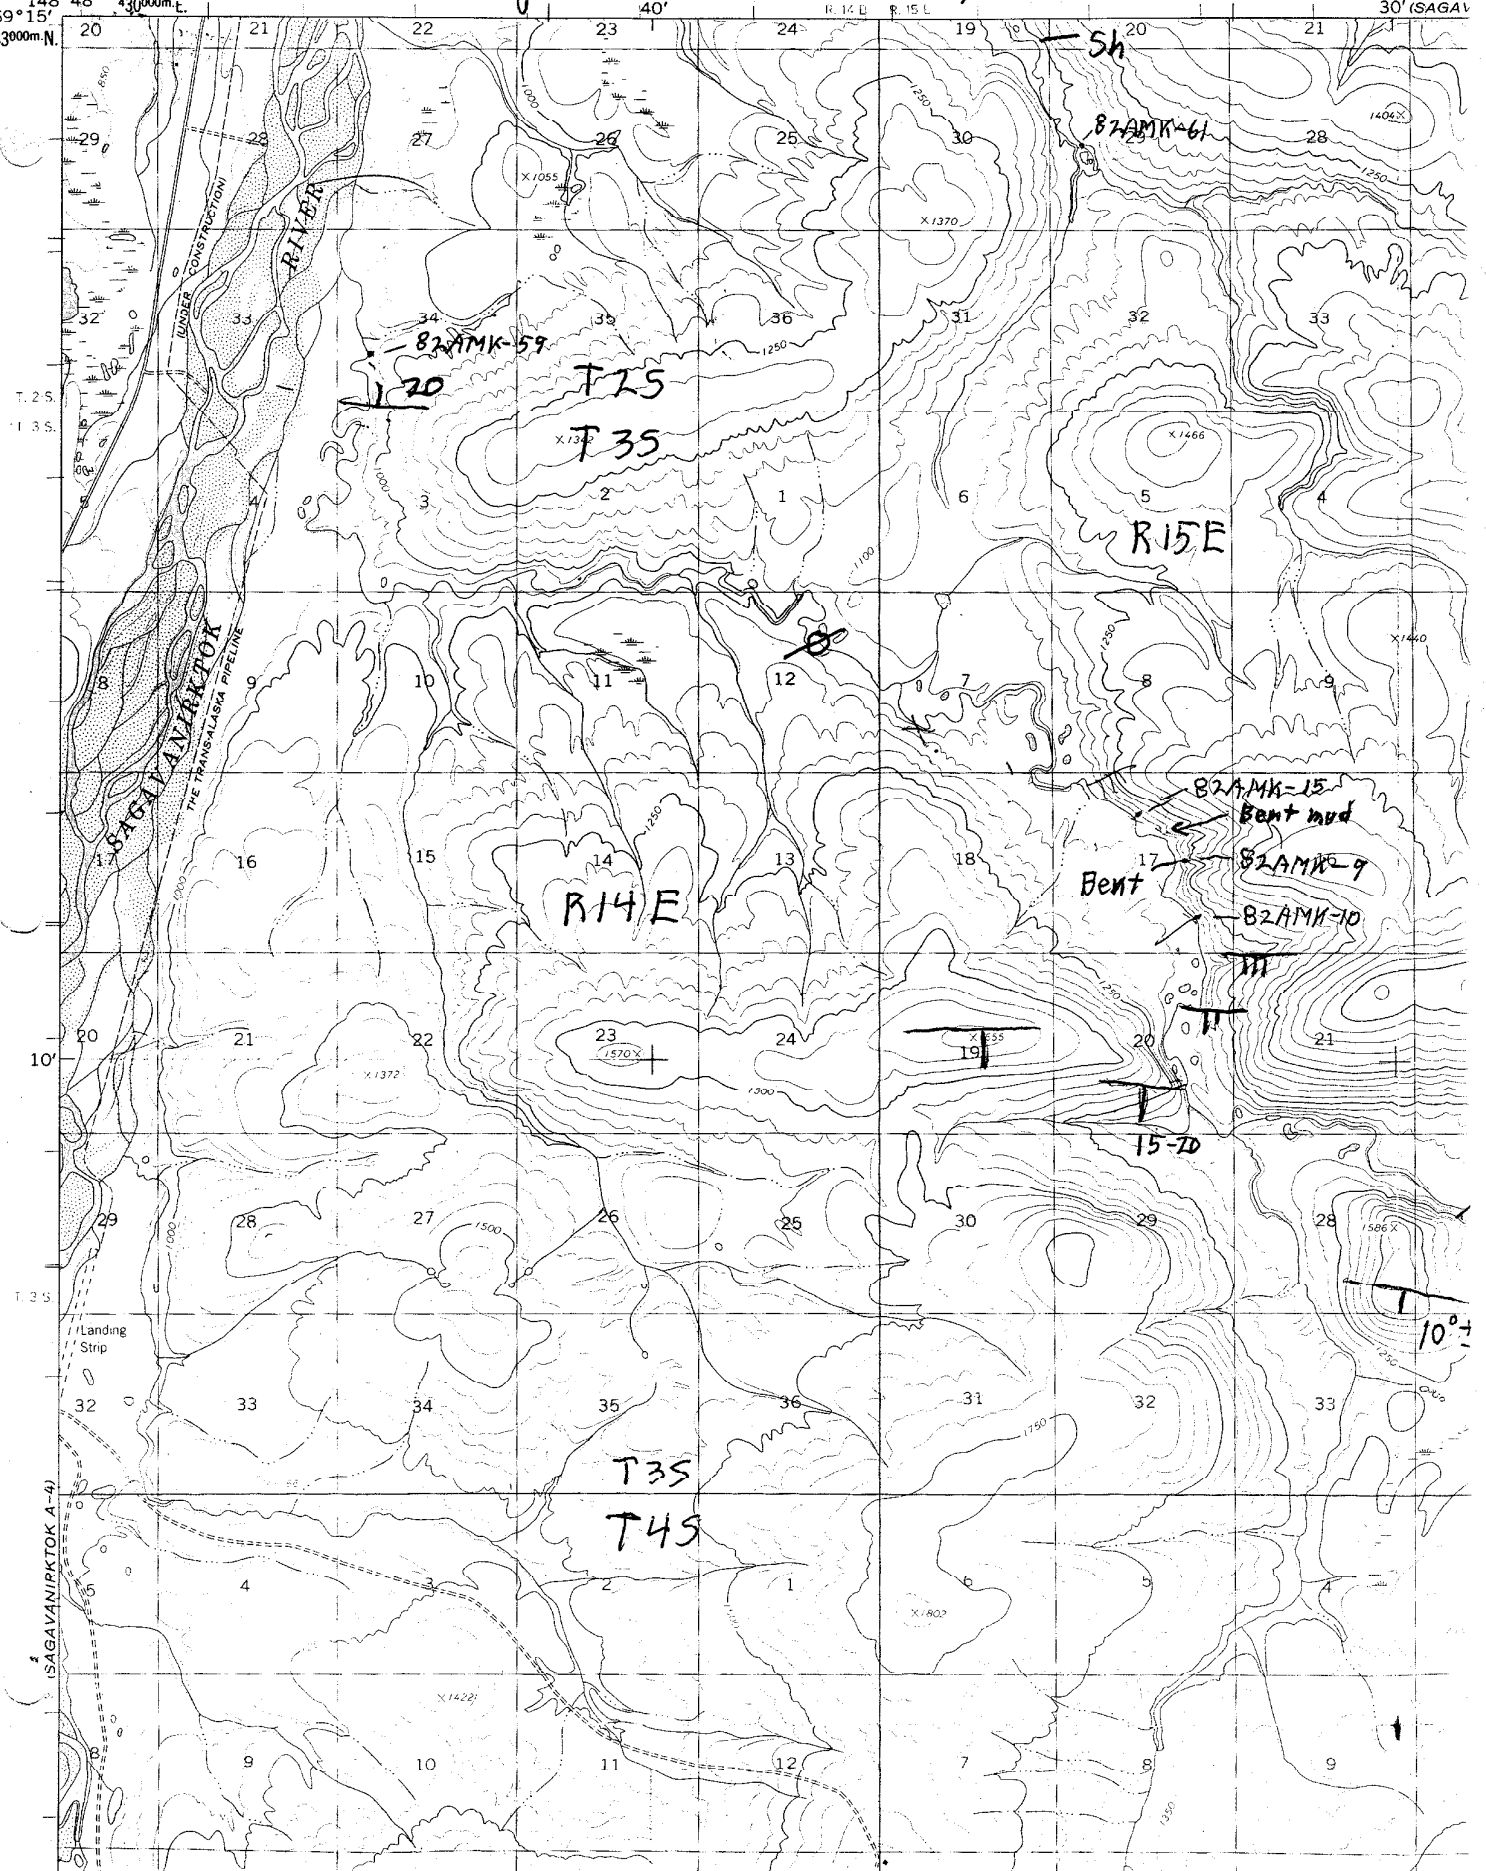

Sh

B2AMK-61

B2AMK-59

T35

T35

R15E

R14E

B2AMK-15

Bent mud

B2AMK-9

B2AMK-10

Bent

15-10

T35

T45


10'


Sagavanirktok A-3 NE/4

30' (SAGAVANIRKTOK B-3)

730 000 FEET

148°12'  
69°15'

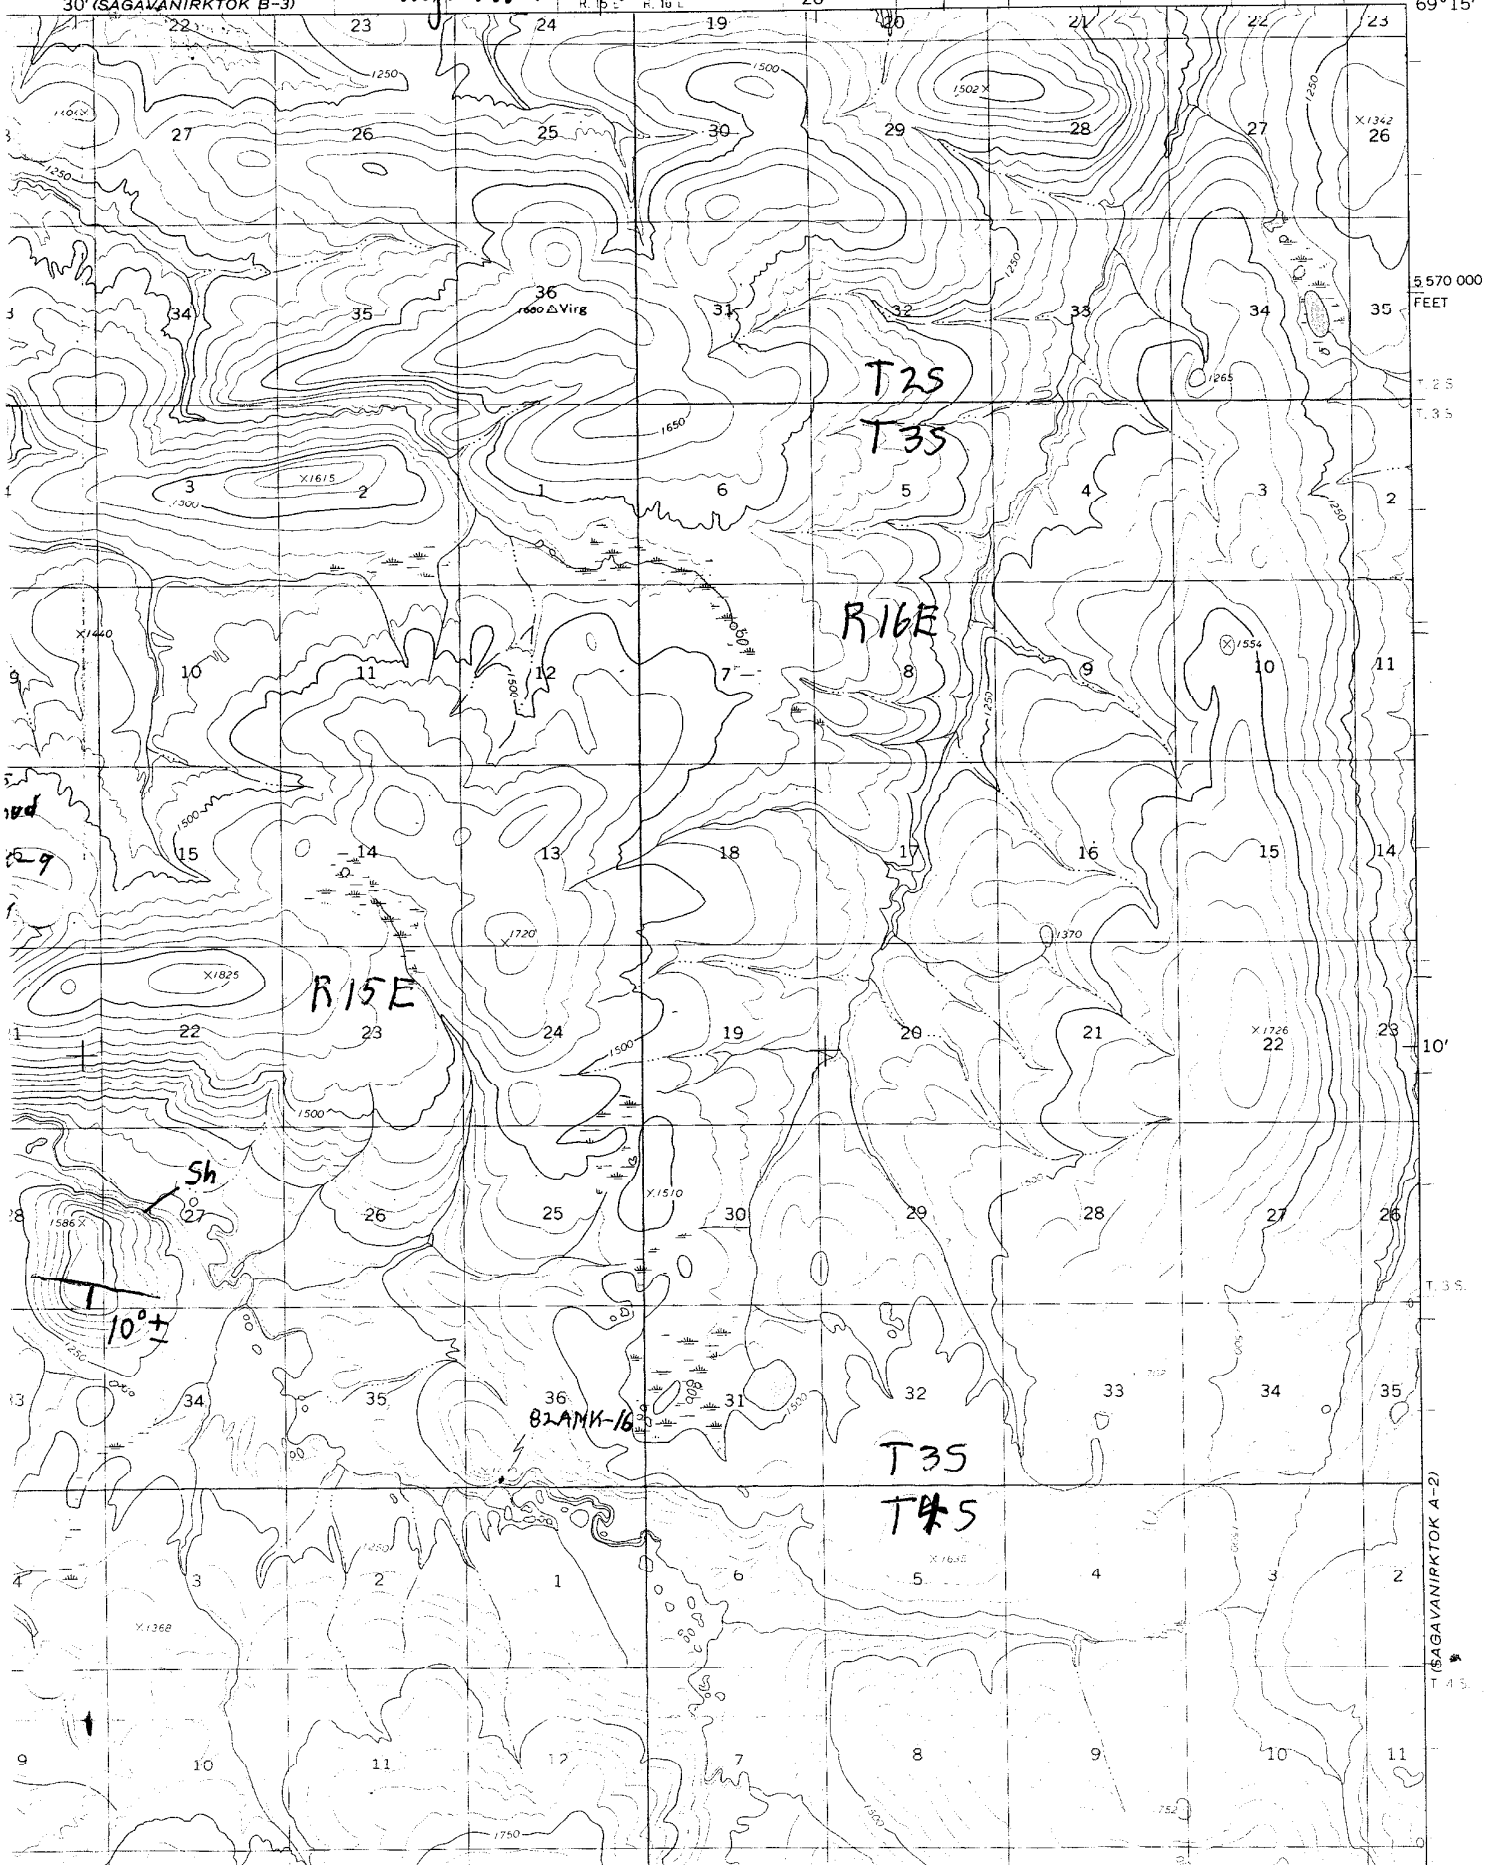

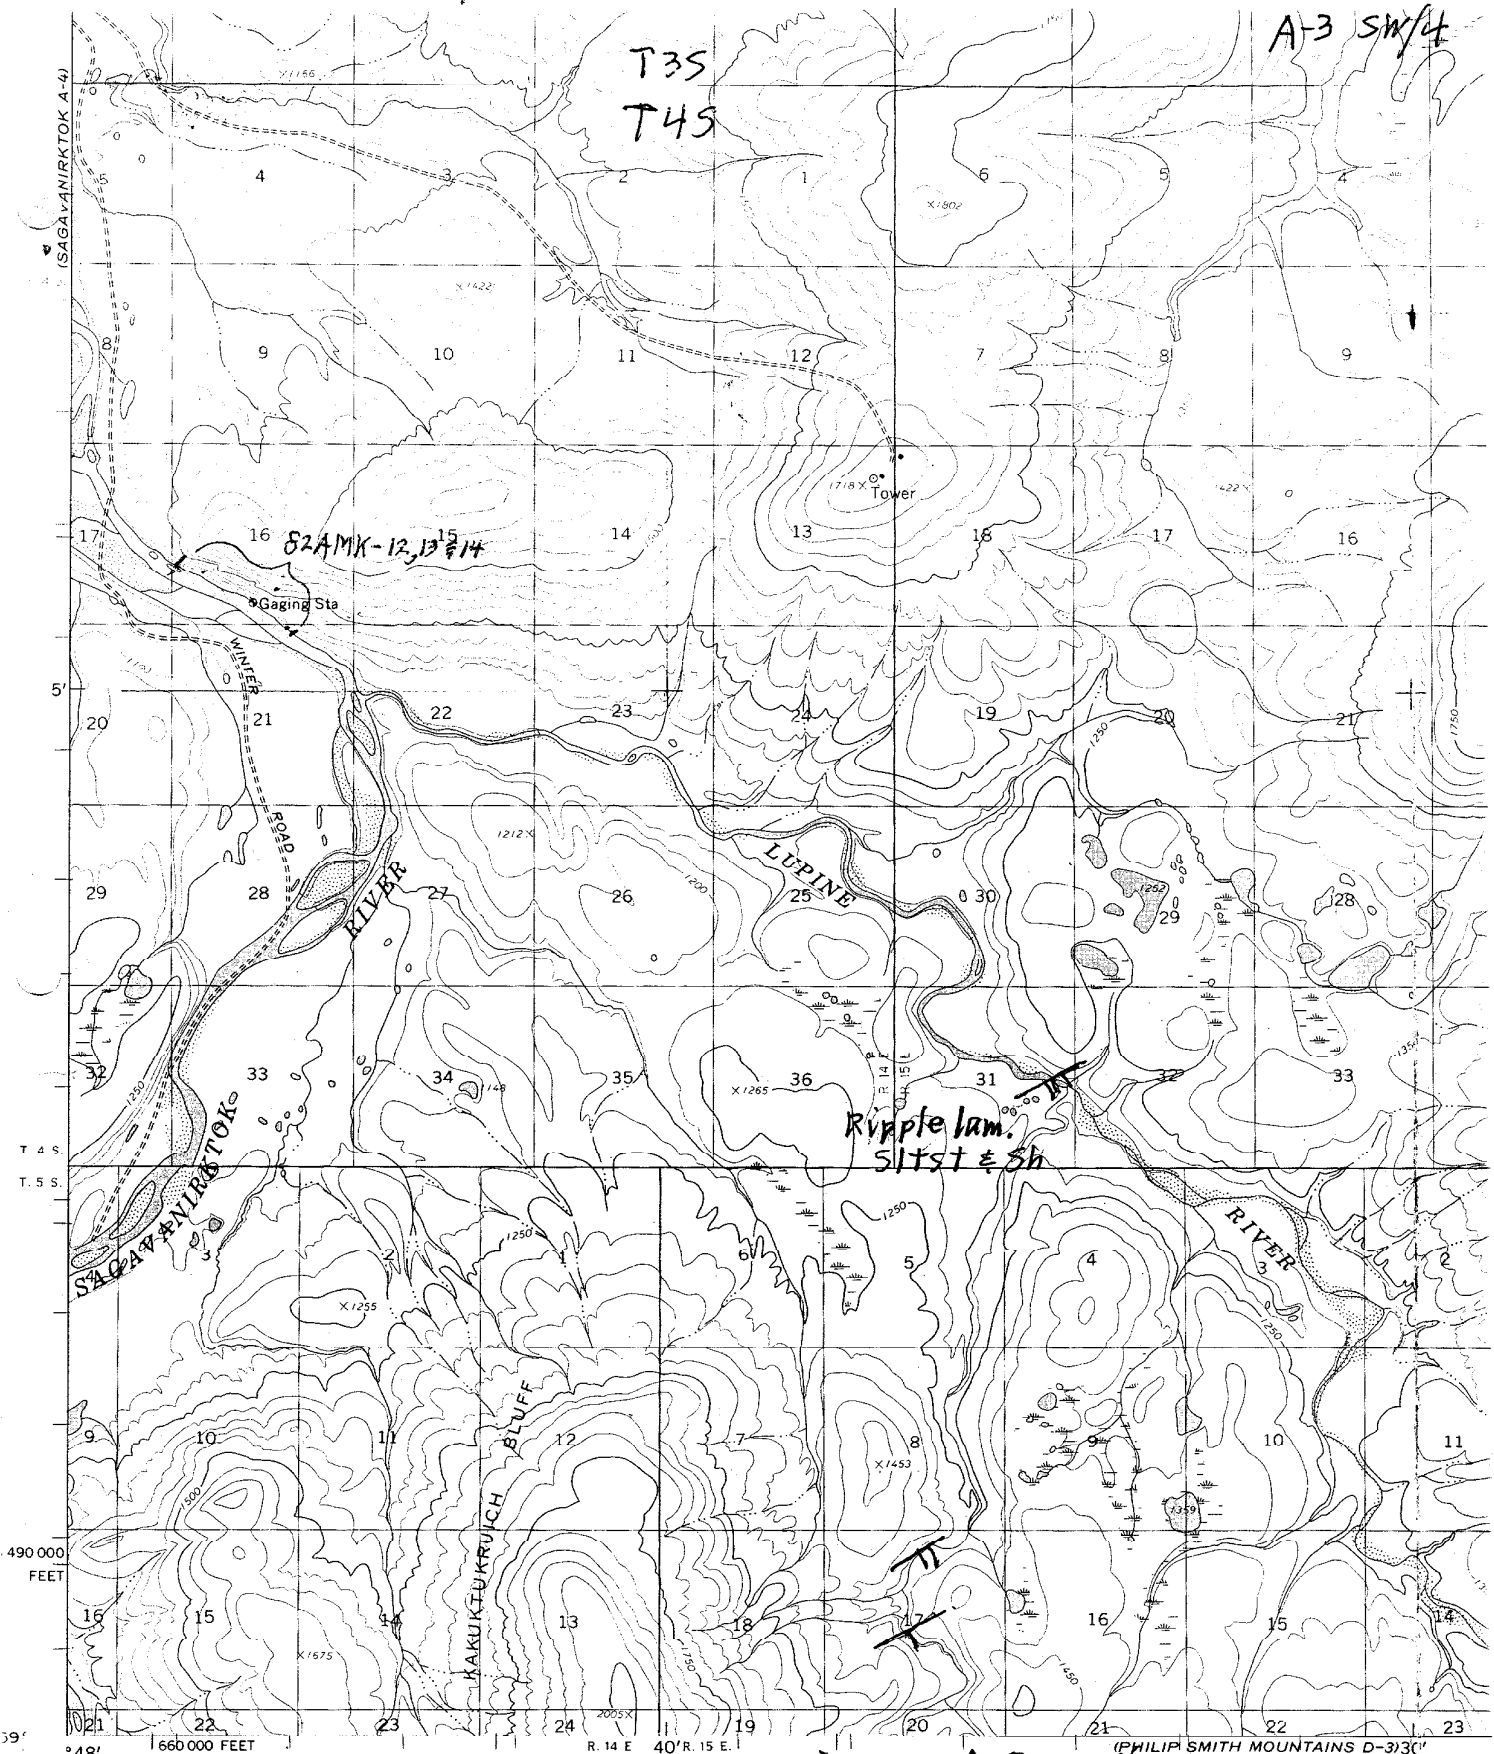

A-3 SW/4

T35  
T45

S2AMK-12, 13, 14

Ripple lam.  
siltst & sh

KAKUIKRUICH  
BLUFF



Mapped, edited, and published by the Geological Survey  
Control by USGS and USC&GS

Sagavanirktok A-3 SW/4


SCALE 1:63360

Topography by photogrammetric methods from aerial photographs  
taken 1970, field annotated 1971. Map not field checked


Universal Transverse Mercator projection. 1927 North American datum  
10,000-foot grid based on Alaska coordinate system, zone 4  
1000-meter Universal Transverse Mercator grid ticks.

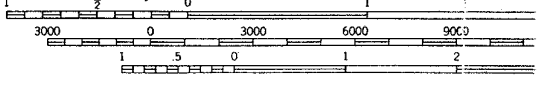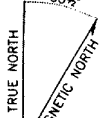

CONTOUR INTERVAL 50  
NATIONAL GEODETIC VERTICAL DATUM

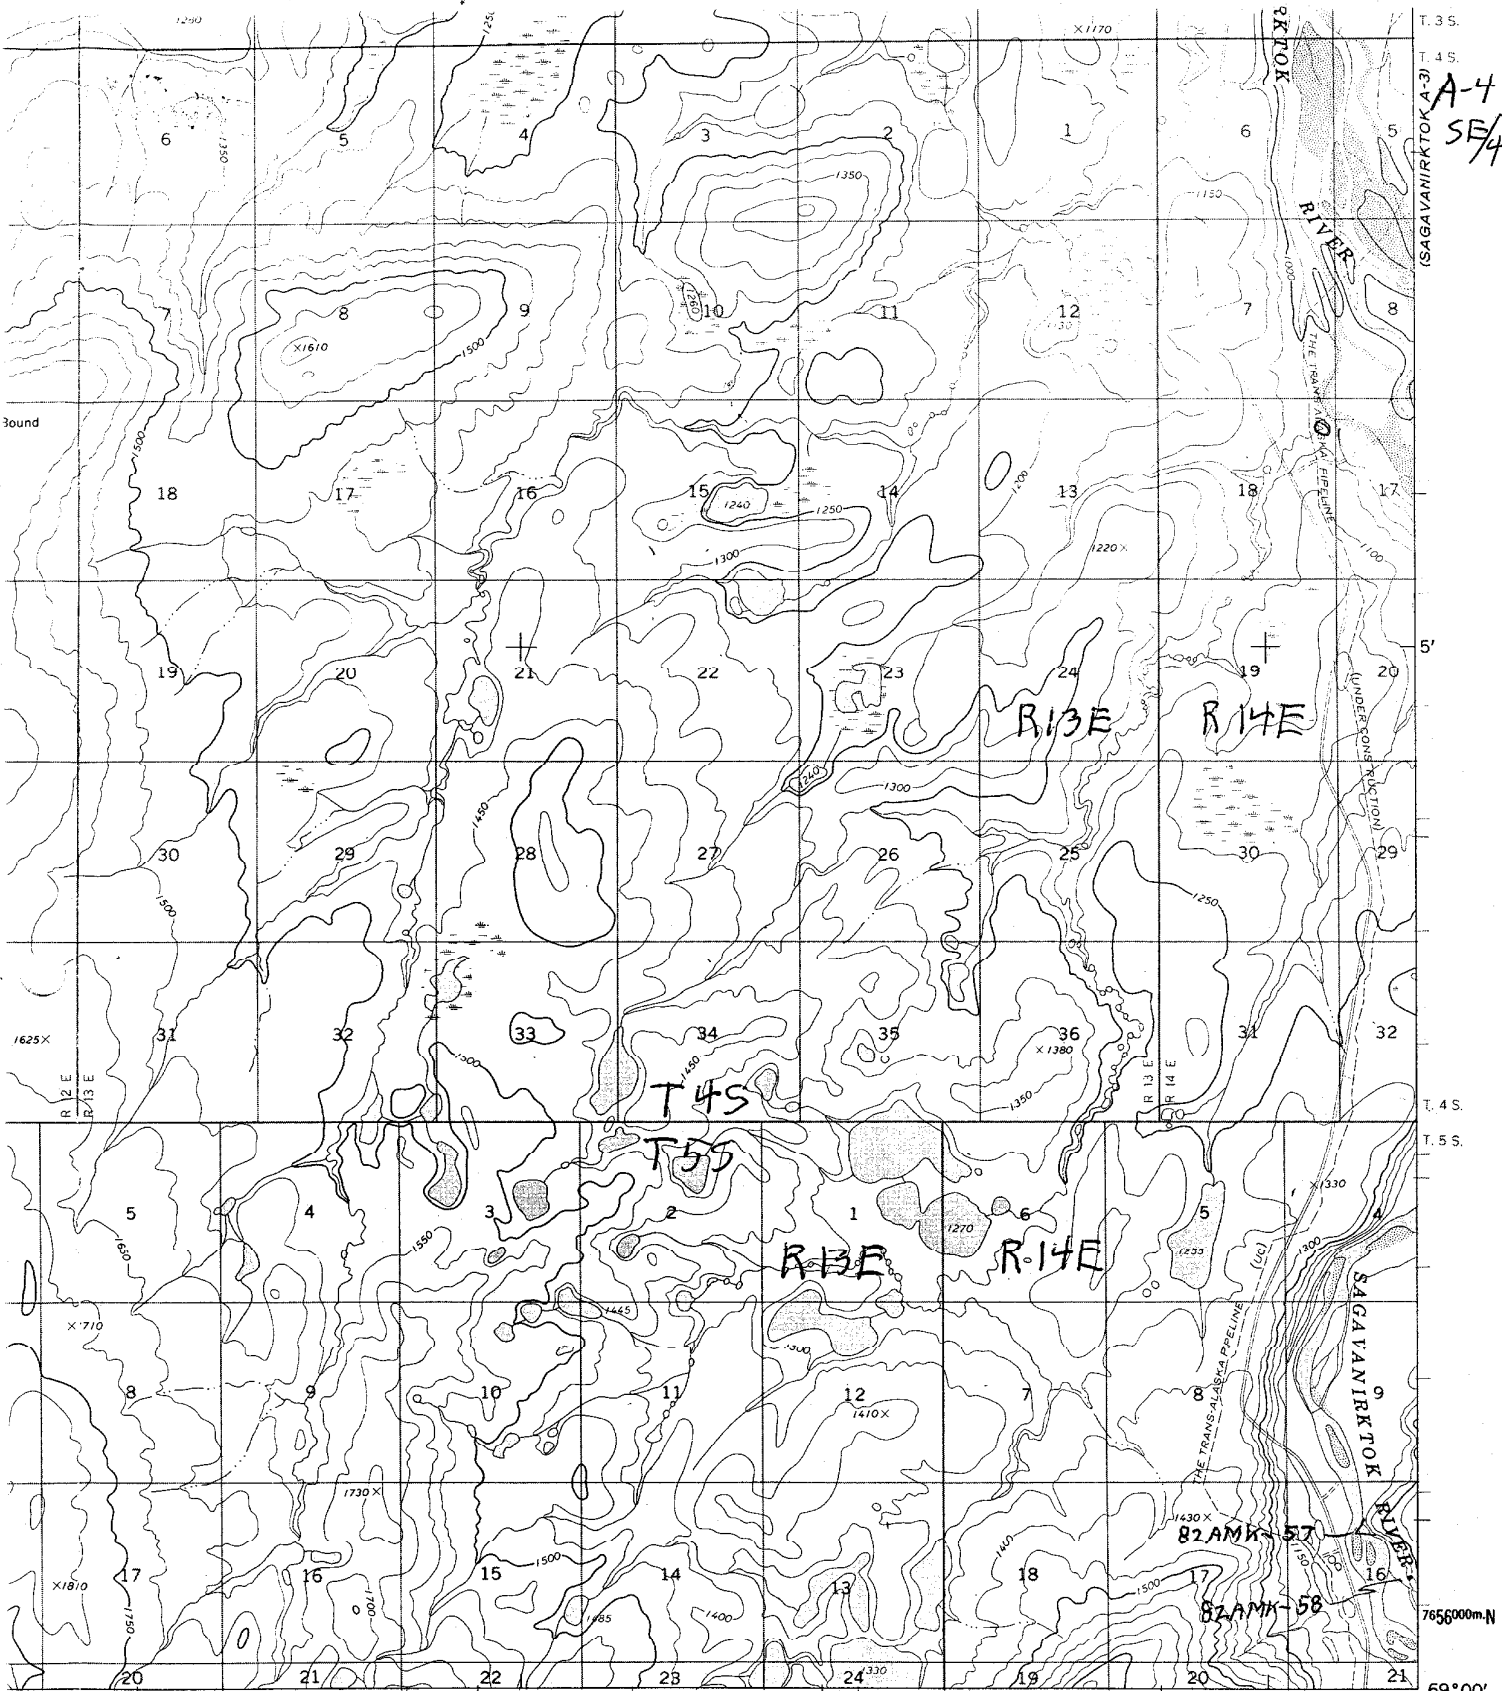

T. 3.5.  
T. 4.5.  
**A-4**  
**SE/4**

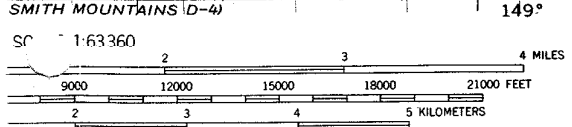

*Sagavanirktok A-4 SE/4*

ROAD CLASSIFICATION

Light-duty \_\_\_\_\_ Unimproved dirt -----

SMITH MOUNTAINS (D-4) 149° 148° 48' 69° 00'




SAGAVANIRKTOK (A-4) BLOCK

SAGAVANIRKTOK (B-1) QUADRANGLE  
ALASKA


Sagavanirktok B-1 NE/4

1:63 360 SERIES (TOPOGRAPHIC)

(MT)  
147° 00'  
69° 30'

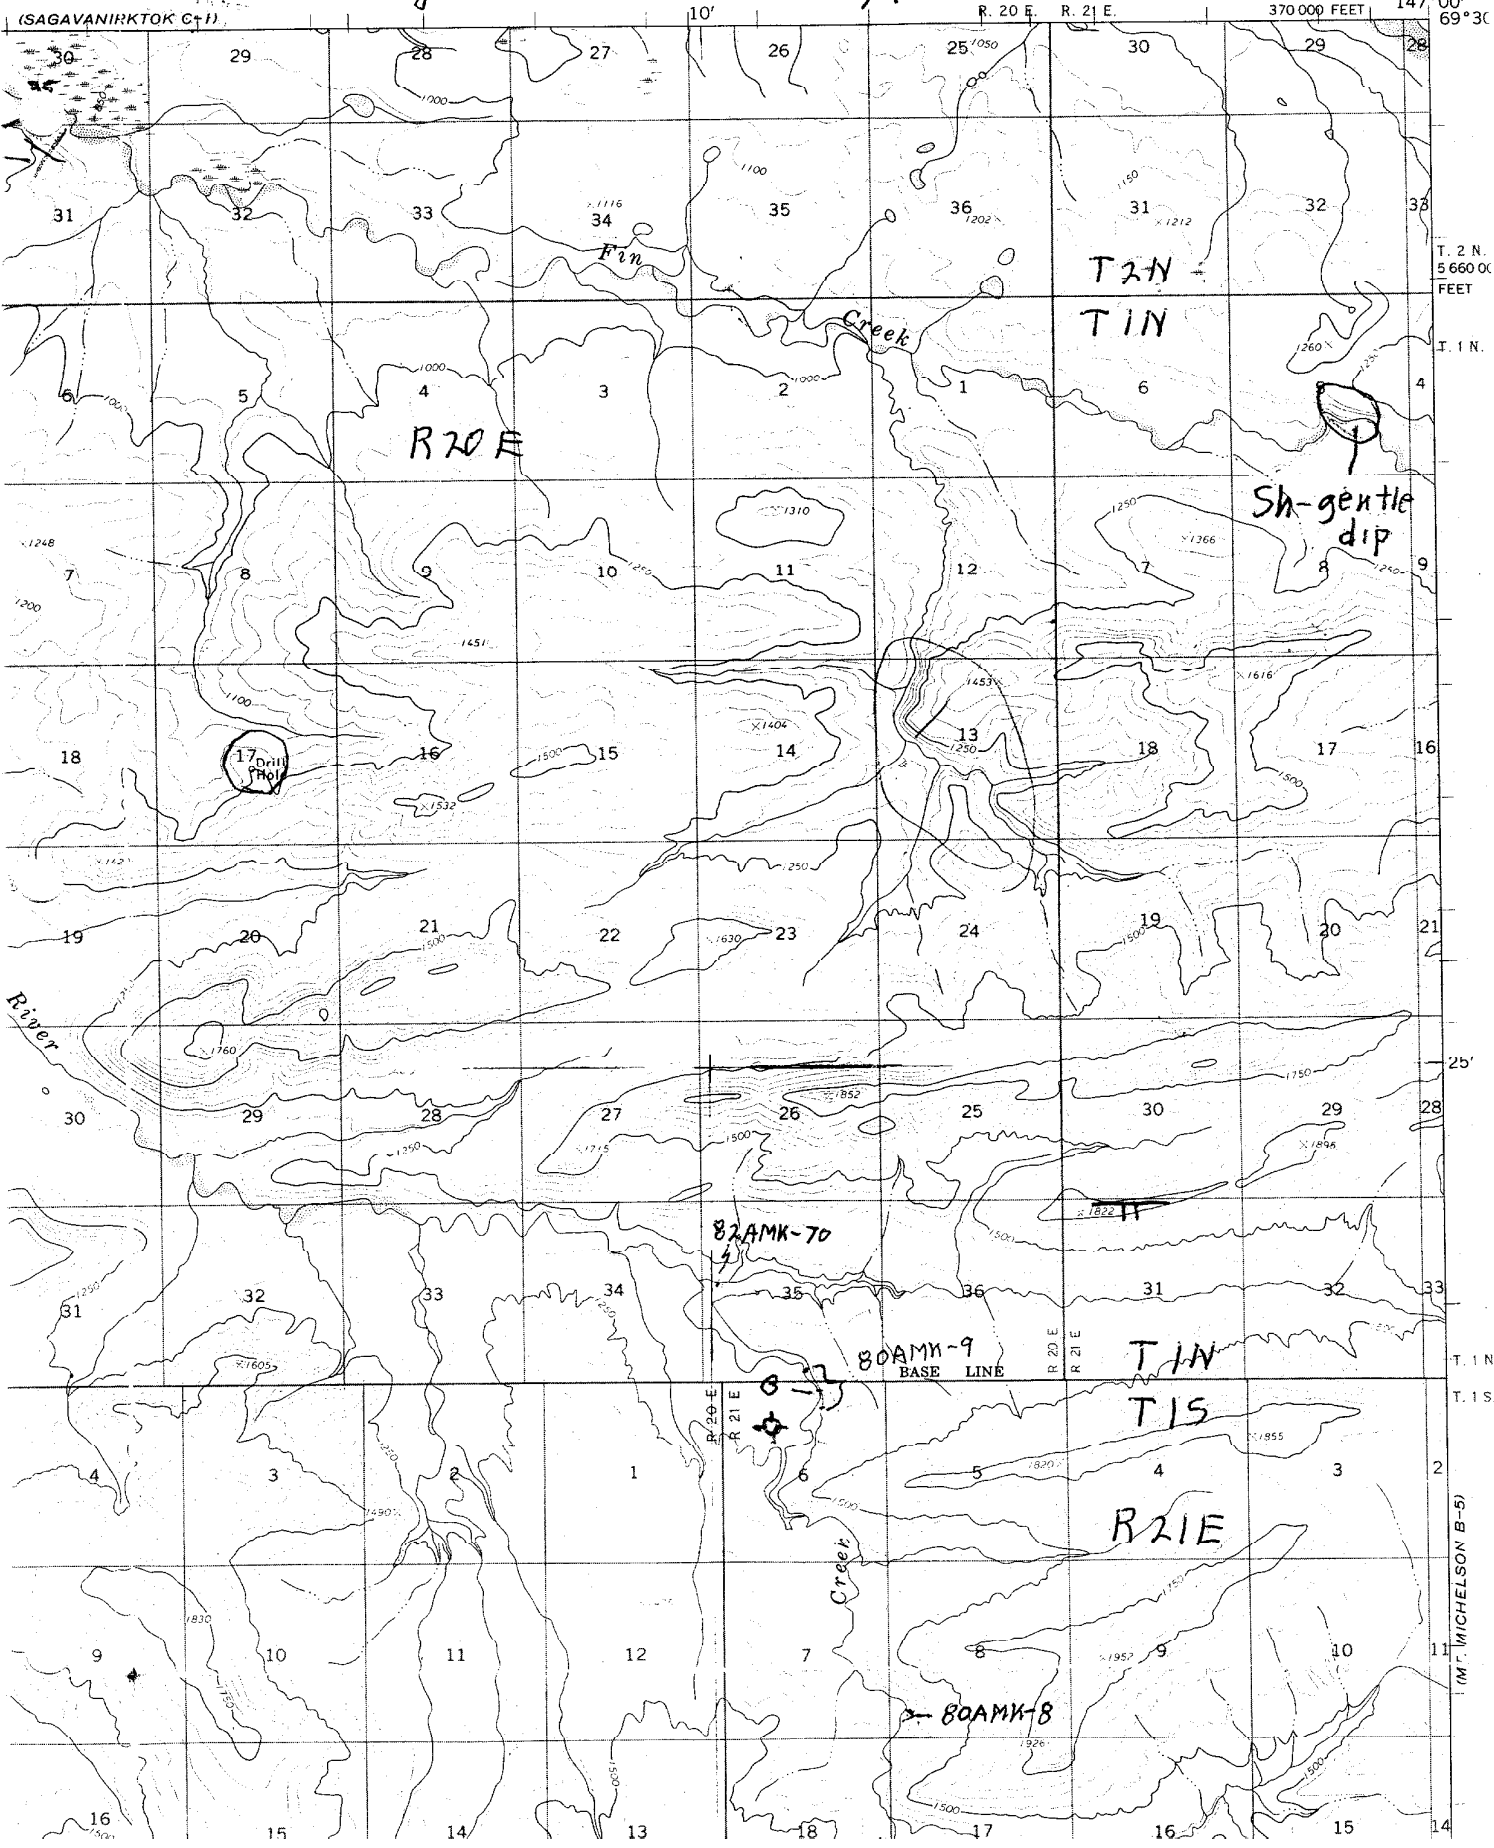



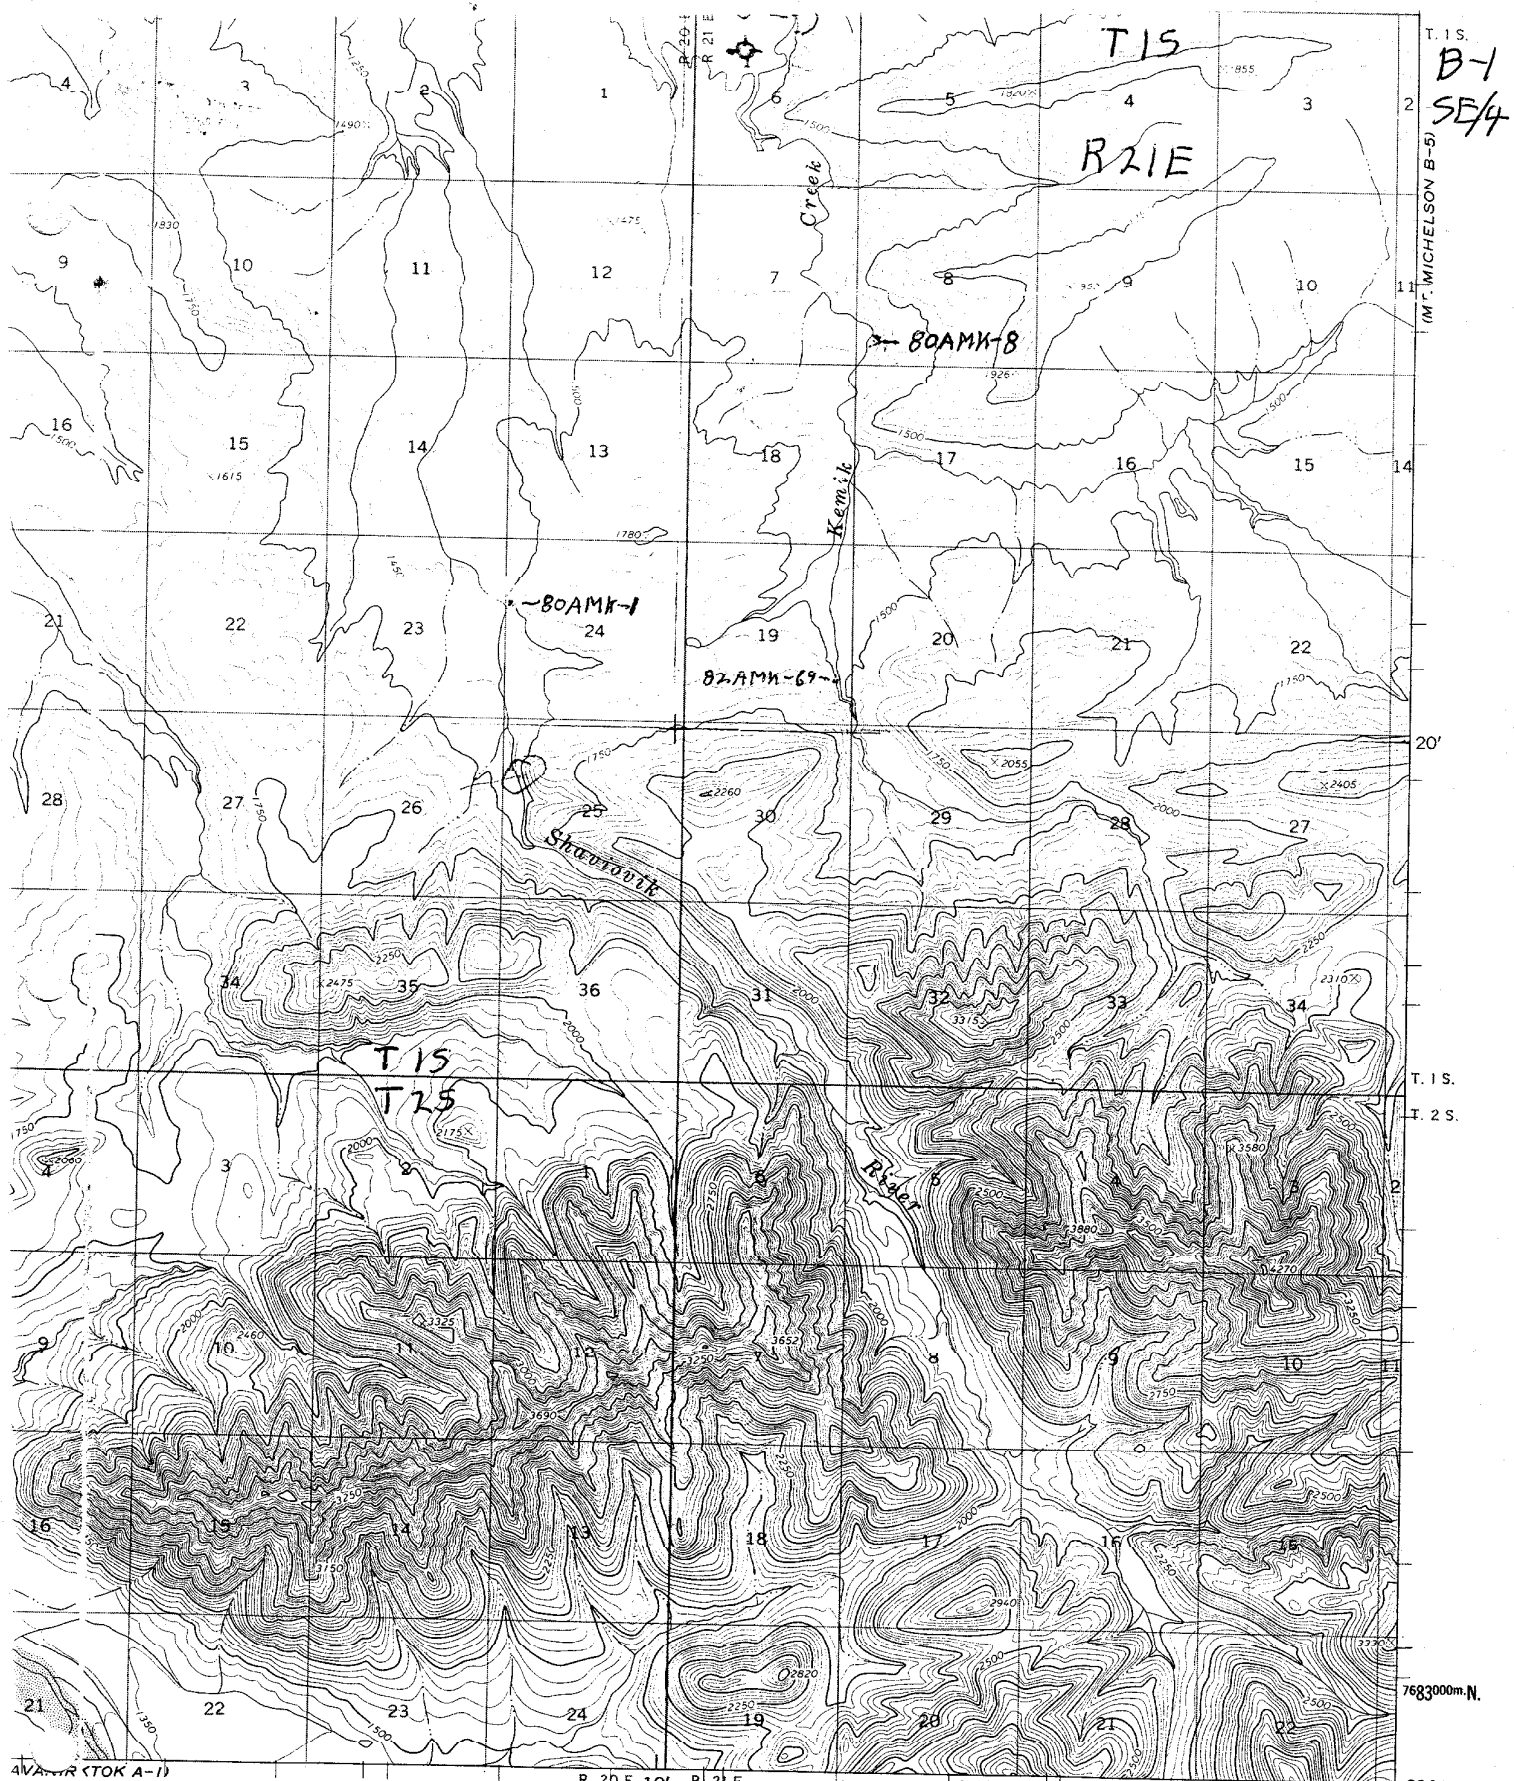

T. 15.  
B-1  
SE/4

(MT. MICHELSON B-5)

T. 1 S.  
T. 2 S.


7683000m. N.

4VAAMR (TOK A-1)

R. 20 E. 10' R1 21 E.

INTERIOR GEOLOGICAL SURVEY, WASHINGTON, D. C. - 1973  
499000m. E.

69°15'  
147°00'

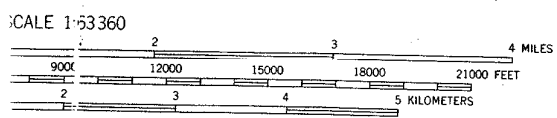


*Sagavanirktok* B-1 SE/4

ROAD CLASSIFICATION  
No roads or trails in this area

(MT. MICHELSON B-5)

UNITED STATES  
DEPARTMENT OF THE INTERIOR  
GEOLOGICAL SURVEY

*Sagavanirktok B-2 NW/4*

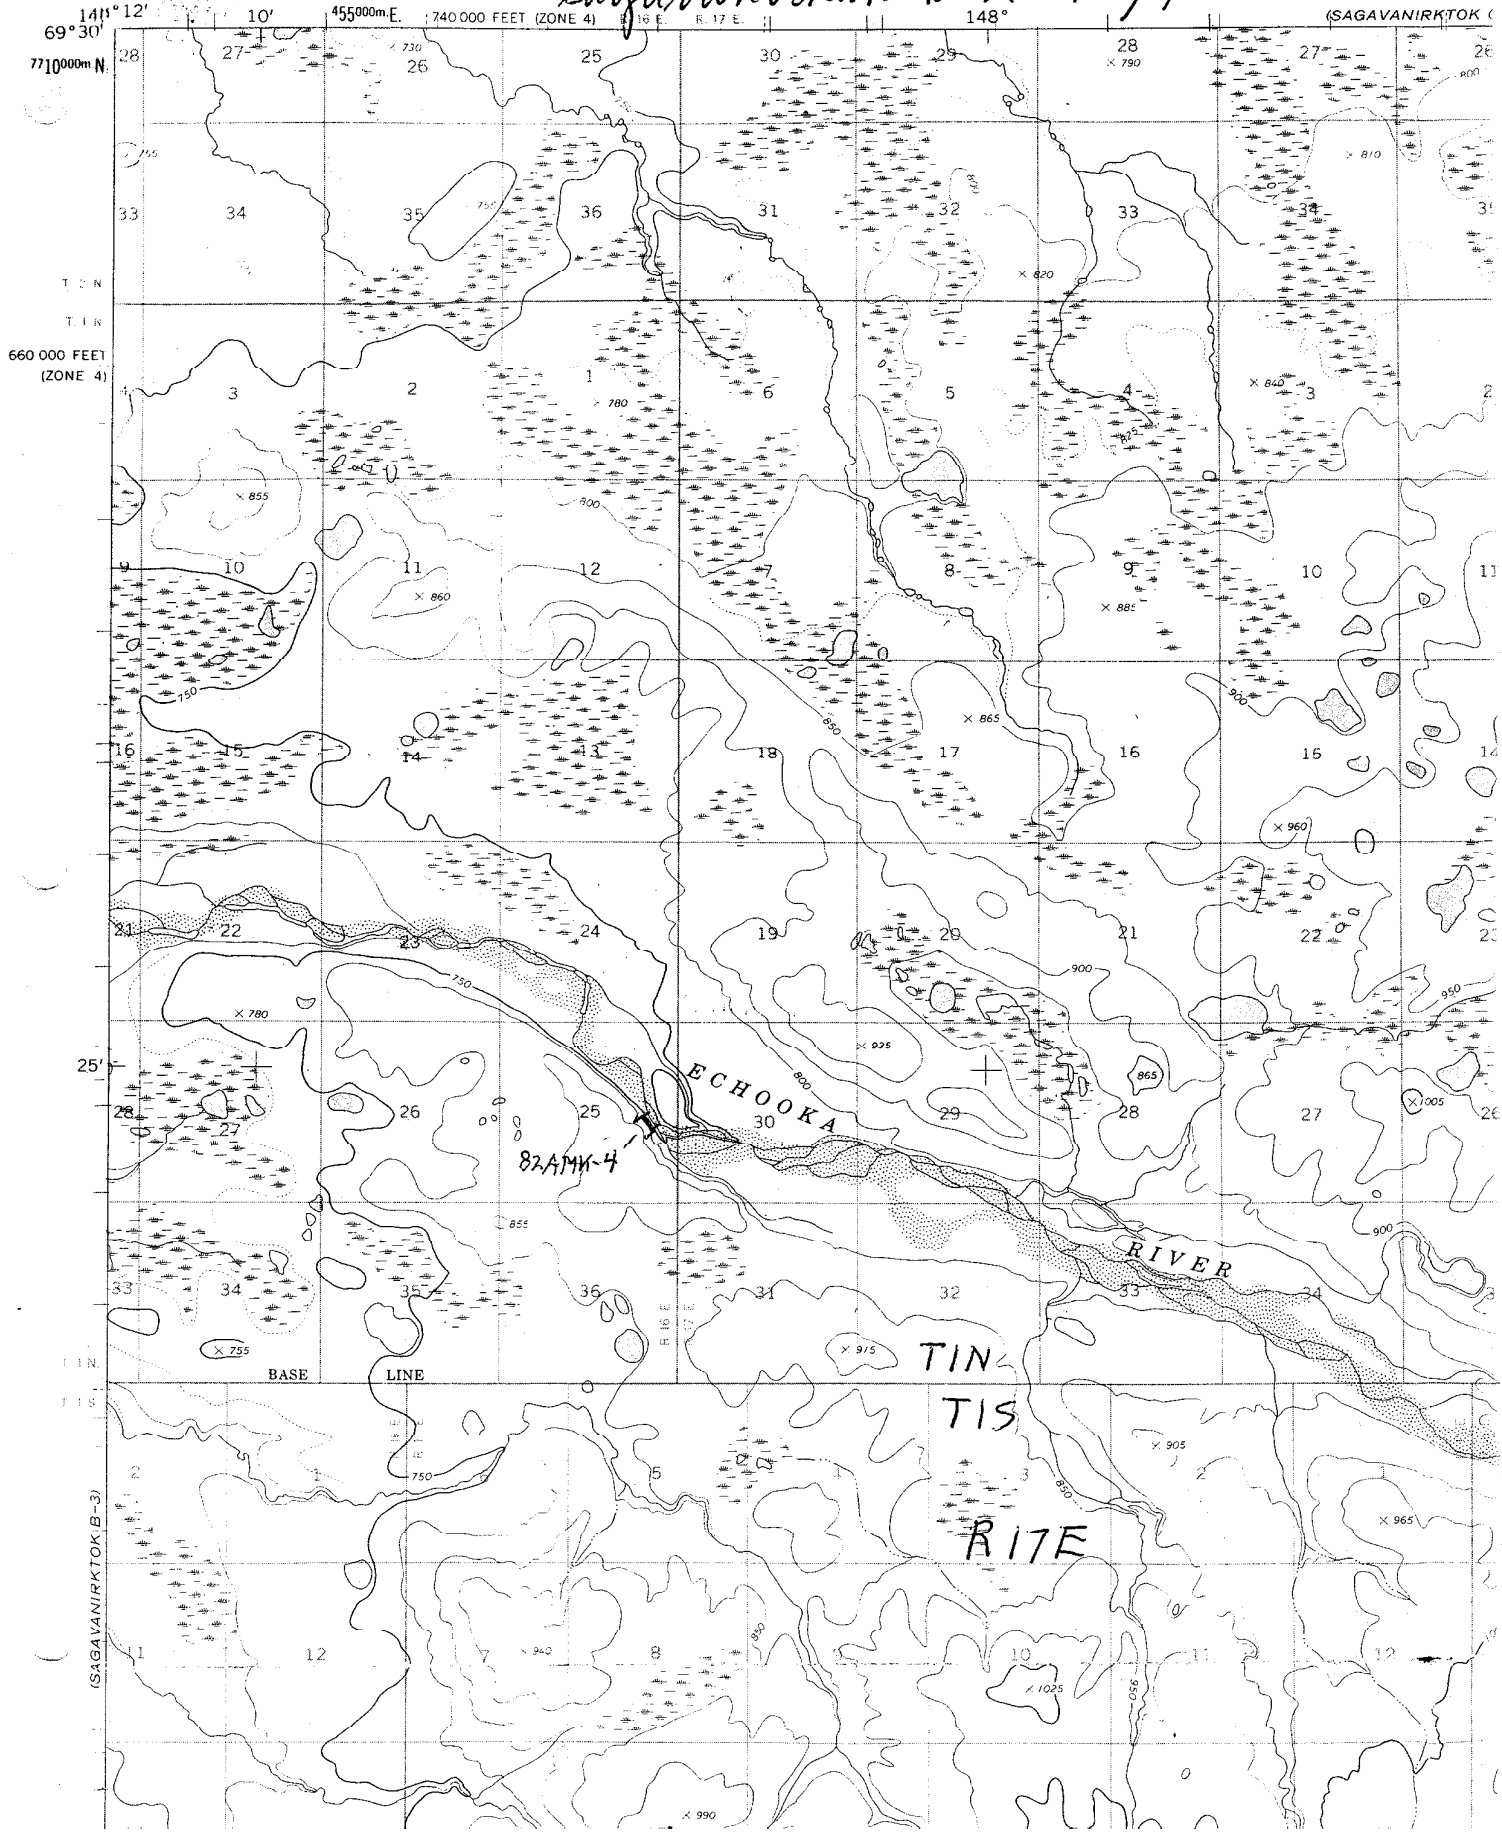

771000m N

660 000 FEET  
(ZONE 4)

(SAGAVANIRKTOK C)

(SAGAVANIRKTOK B-3)

SAGAVANIRKTOK (B-2) QUADRANGLE

ALASKA

1:63 360 SERIES (TOPOGRAPHIC)

Sagavanirktok B-2 NE/4

(SAGAVANIRKTOK C-2)


R. 17 E 50'

R. 18 E


280 000 FEET (ZONE 3)

40'

147° 36' 69"

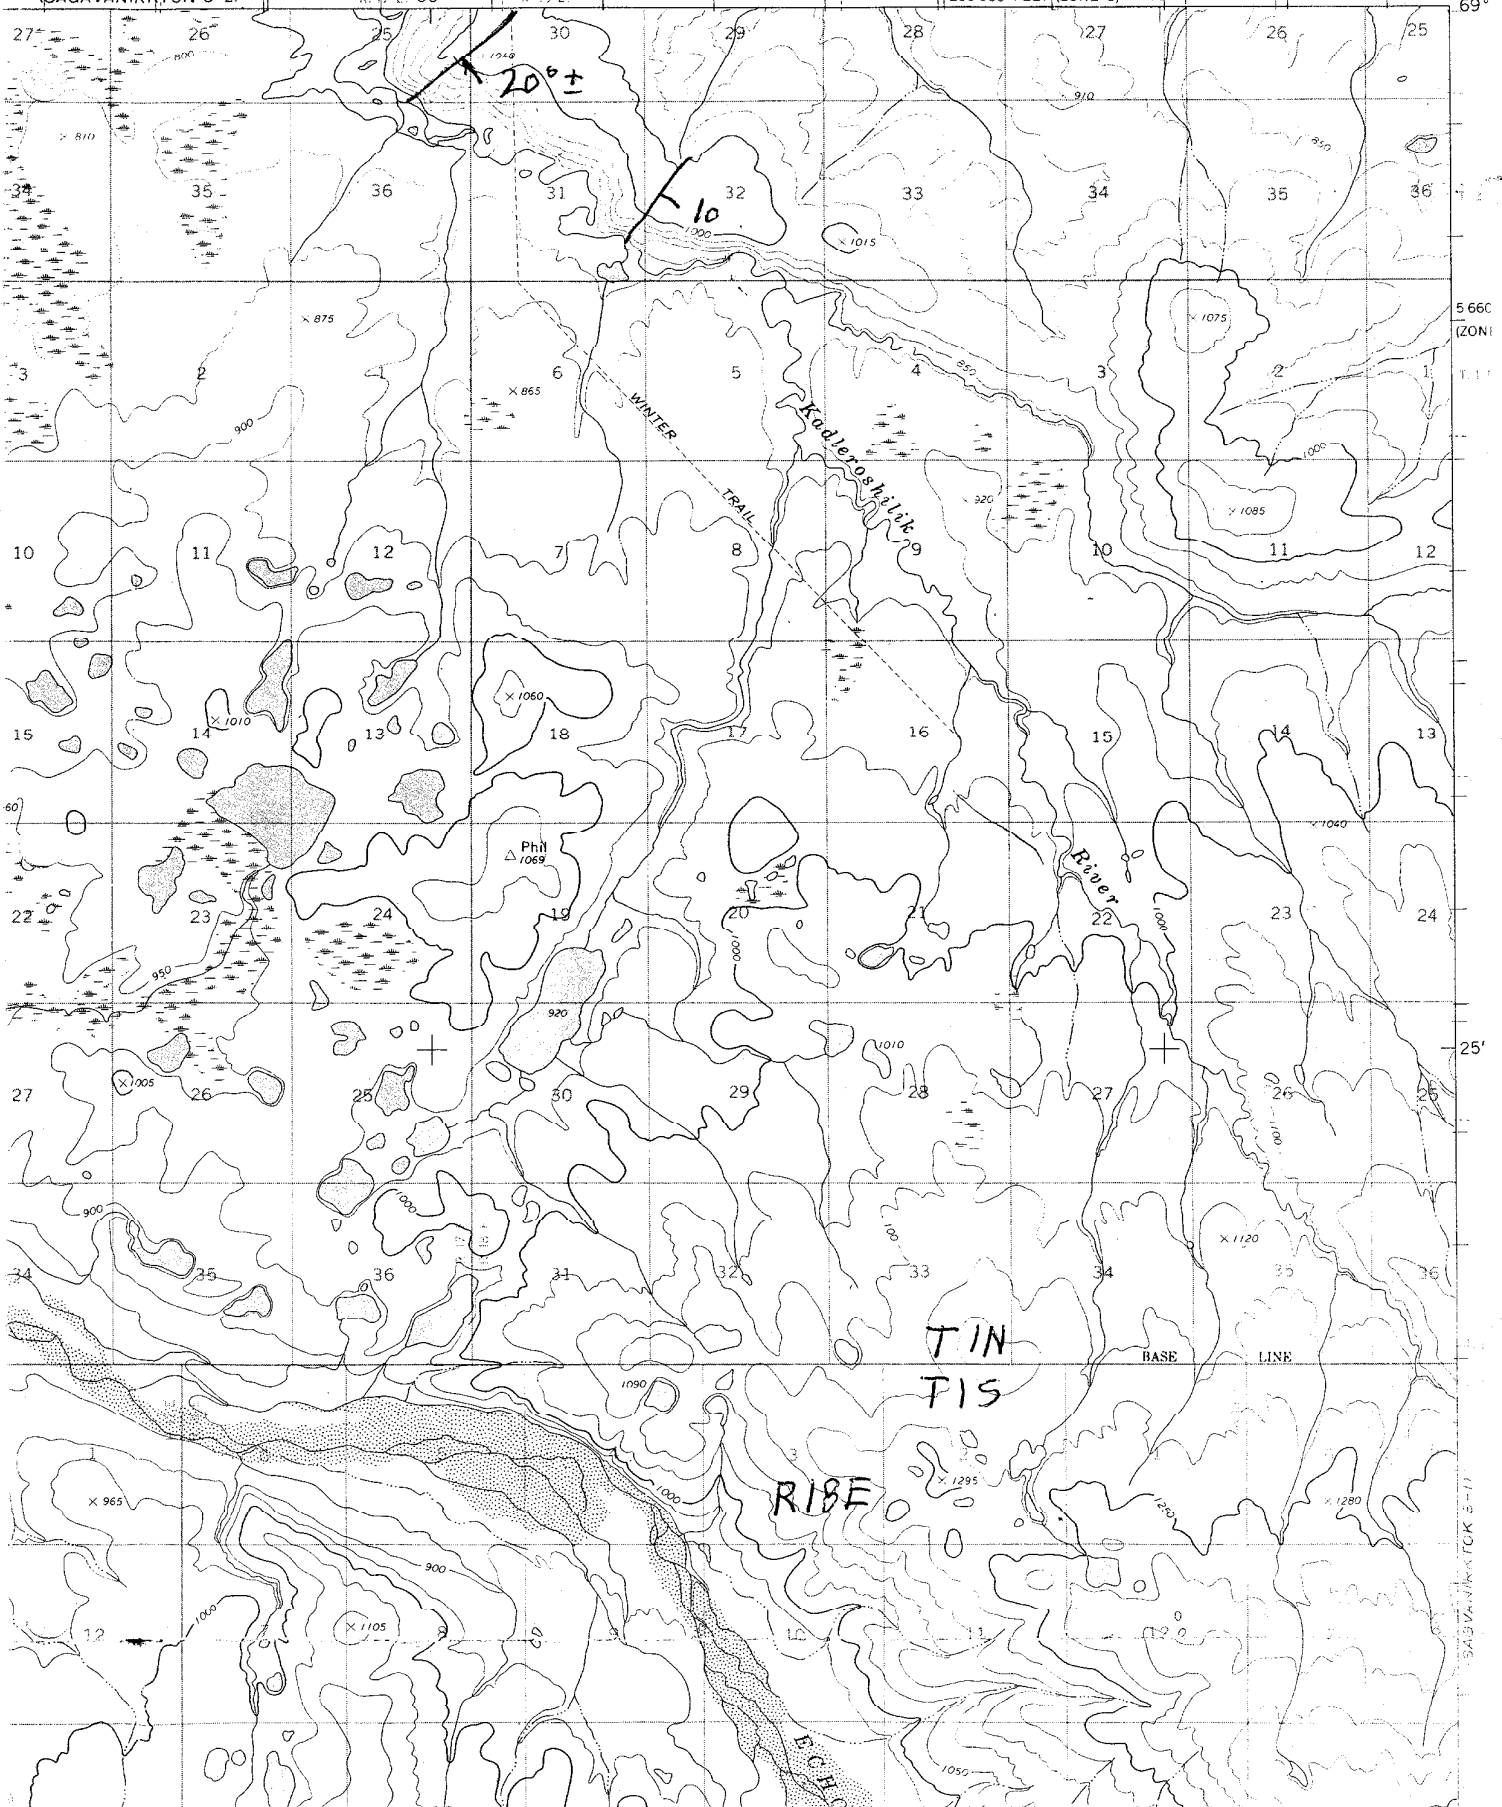

543 VA-114-K TOK 3-11

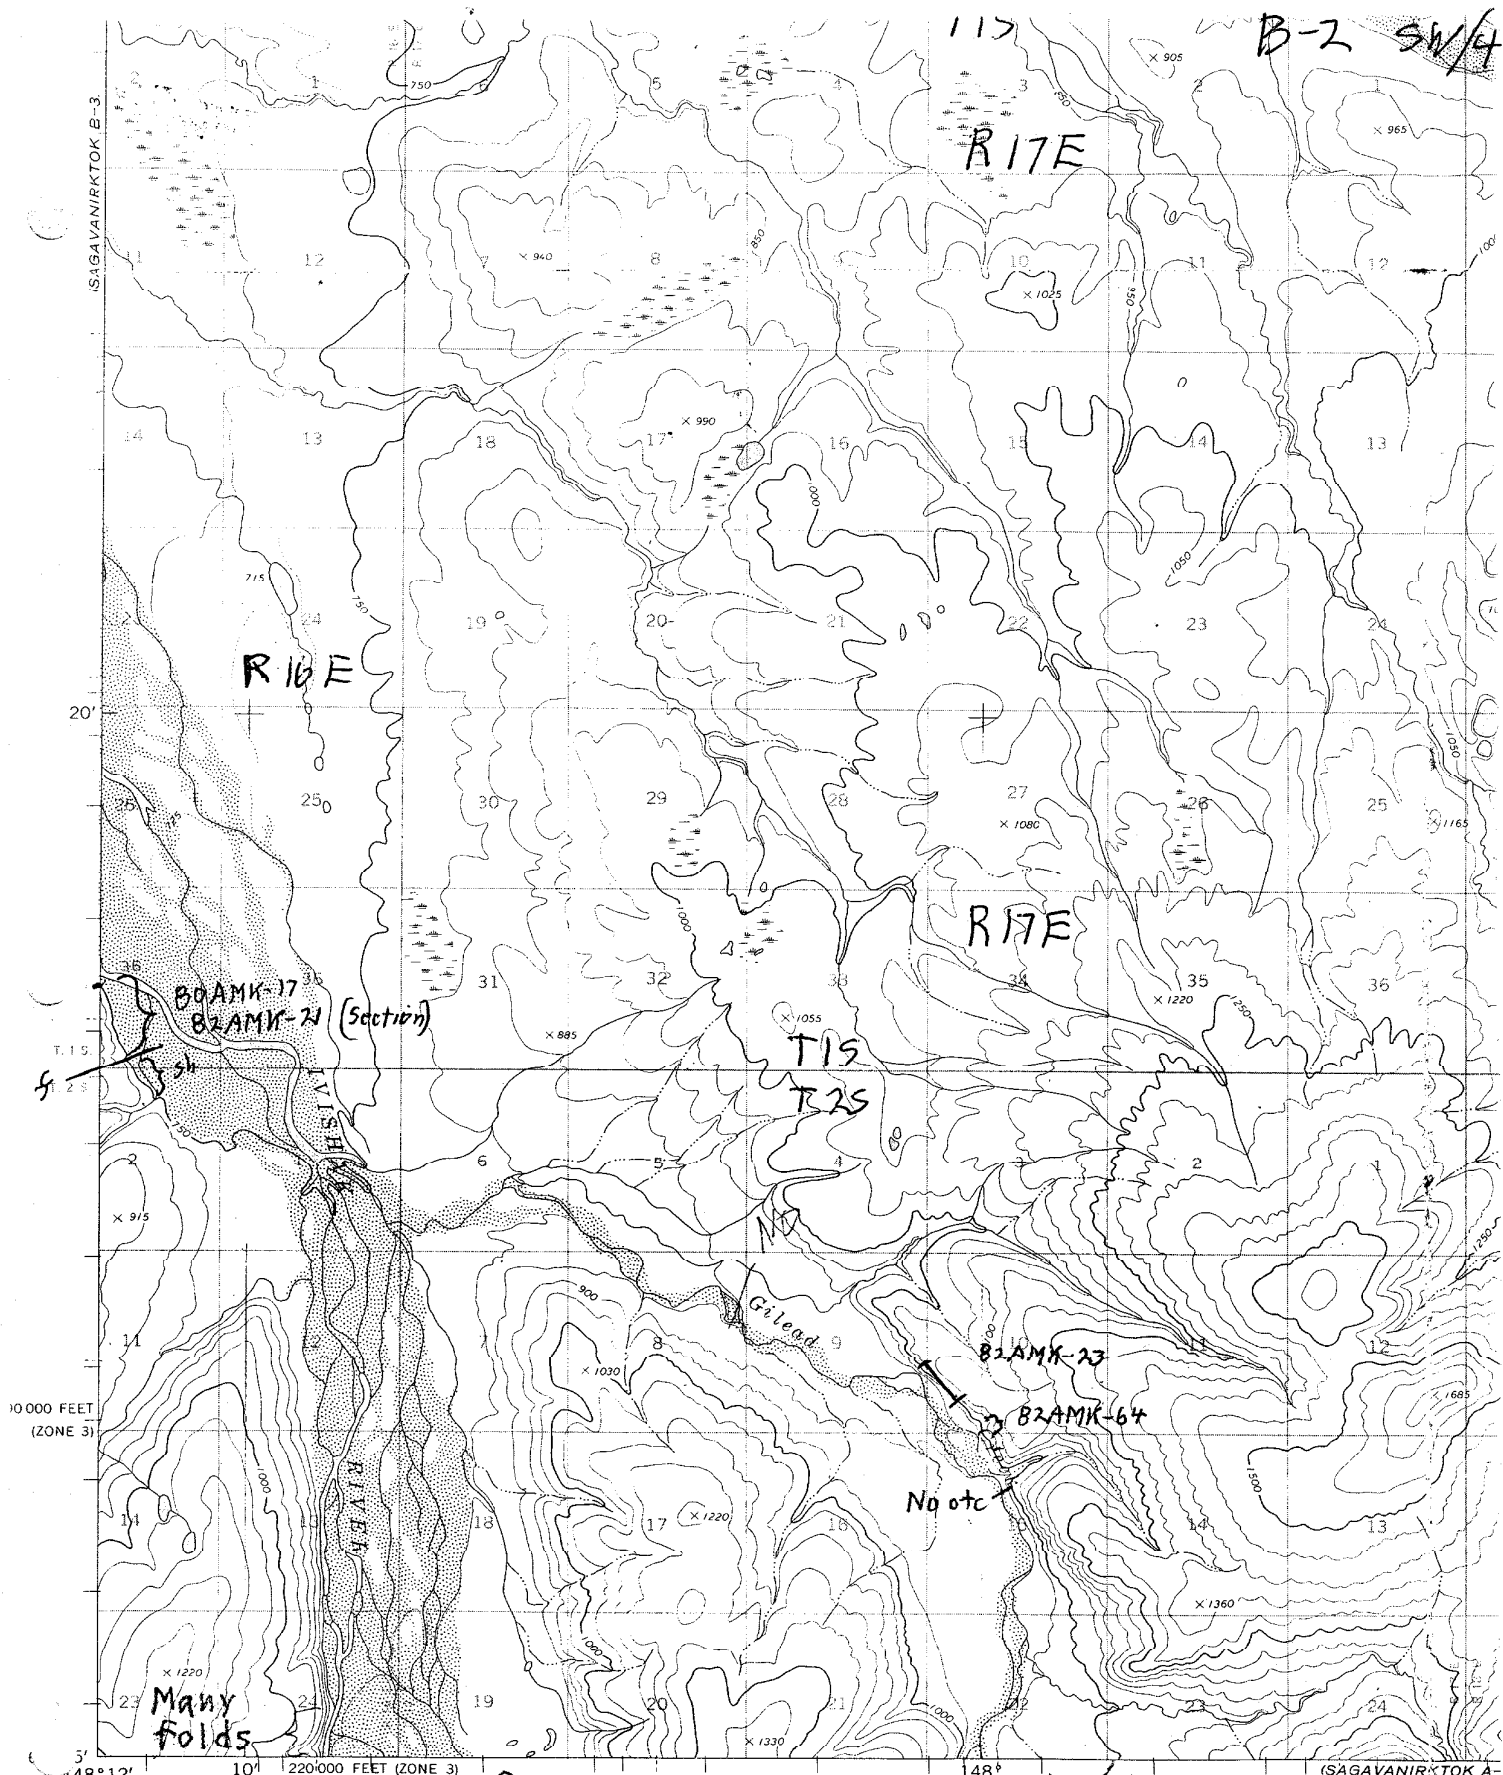

Mapped, edited, and published by the Geological Survey  
 Control by USGS and USC&GS  
 Topography by photogrammetric methods from aerial photographs  
 taken 1970, field annotated 1971. Map not field checked  
 Projection and 1000-meter grid ticks: Universal  
 Transverse Mercator, zone 6

**Sagavanirktok B-2 SW/4**

SCALE 1:63360

CONTOUR INTERVAL 50  
 DOTTED LINES REPRESENT 25-FOOT

**R-7**

B-2 SE/4

TIN  
TIS

RIBE

RIBE

T15  
T25

Bentonitic

82AMK-3

82AMK-6B

82AMK-5

82AMK-6


82AMK-4

82AMK-7

82AMK-9


82AMK-10

Soil Smp<sup>l</sup> 71

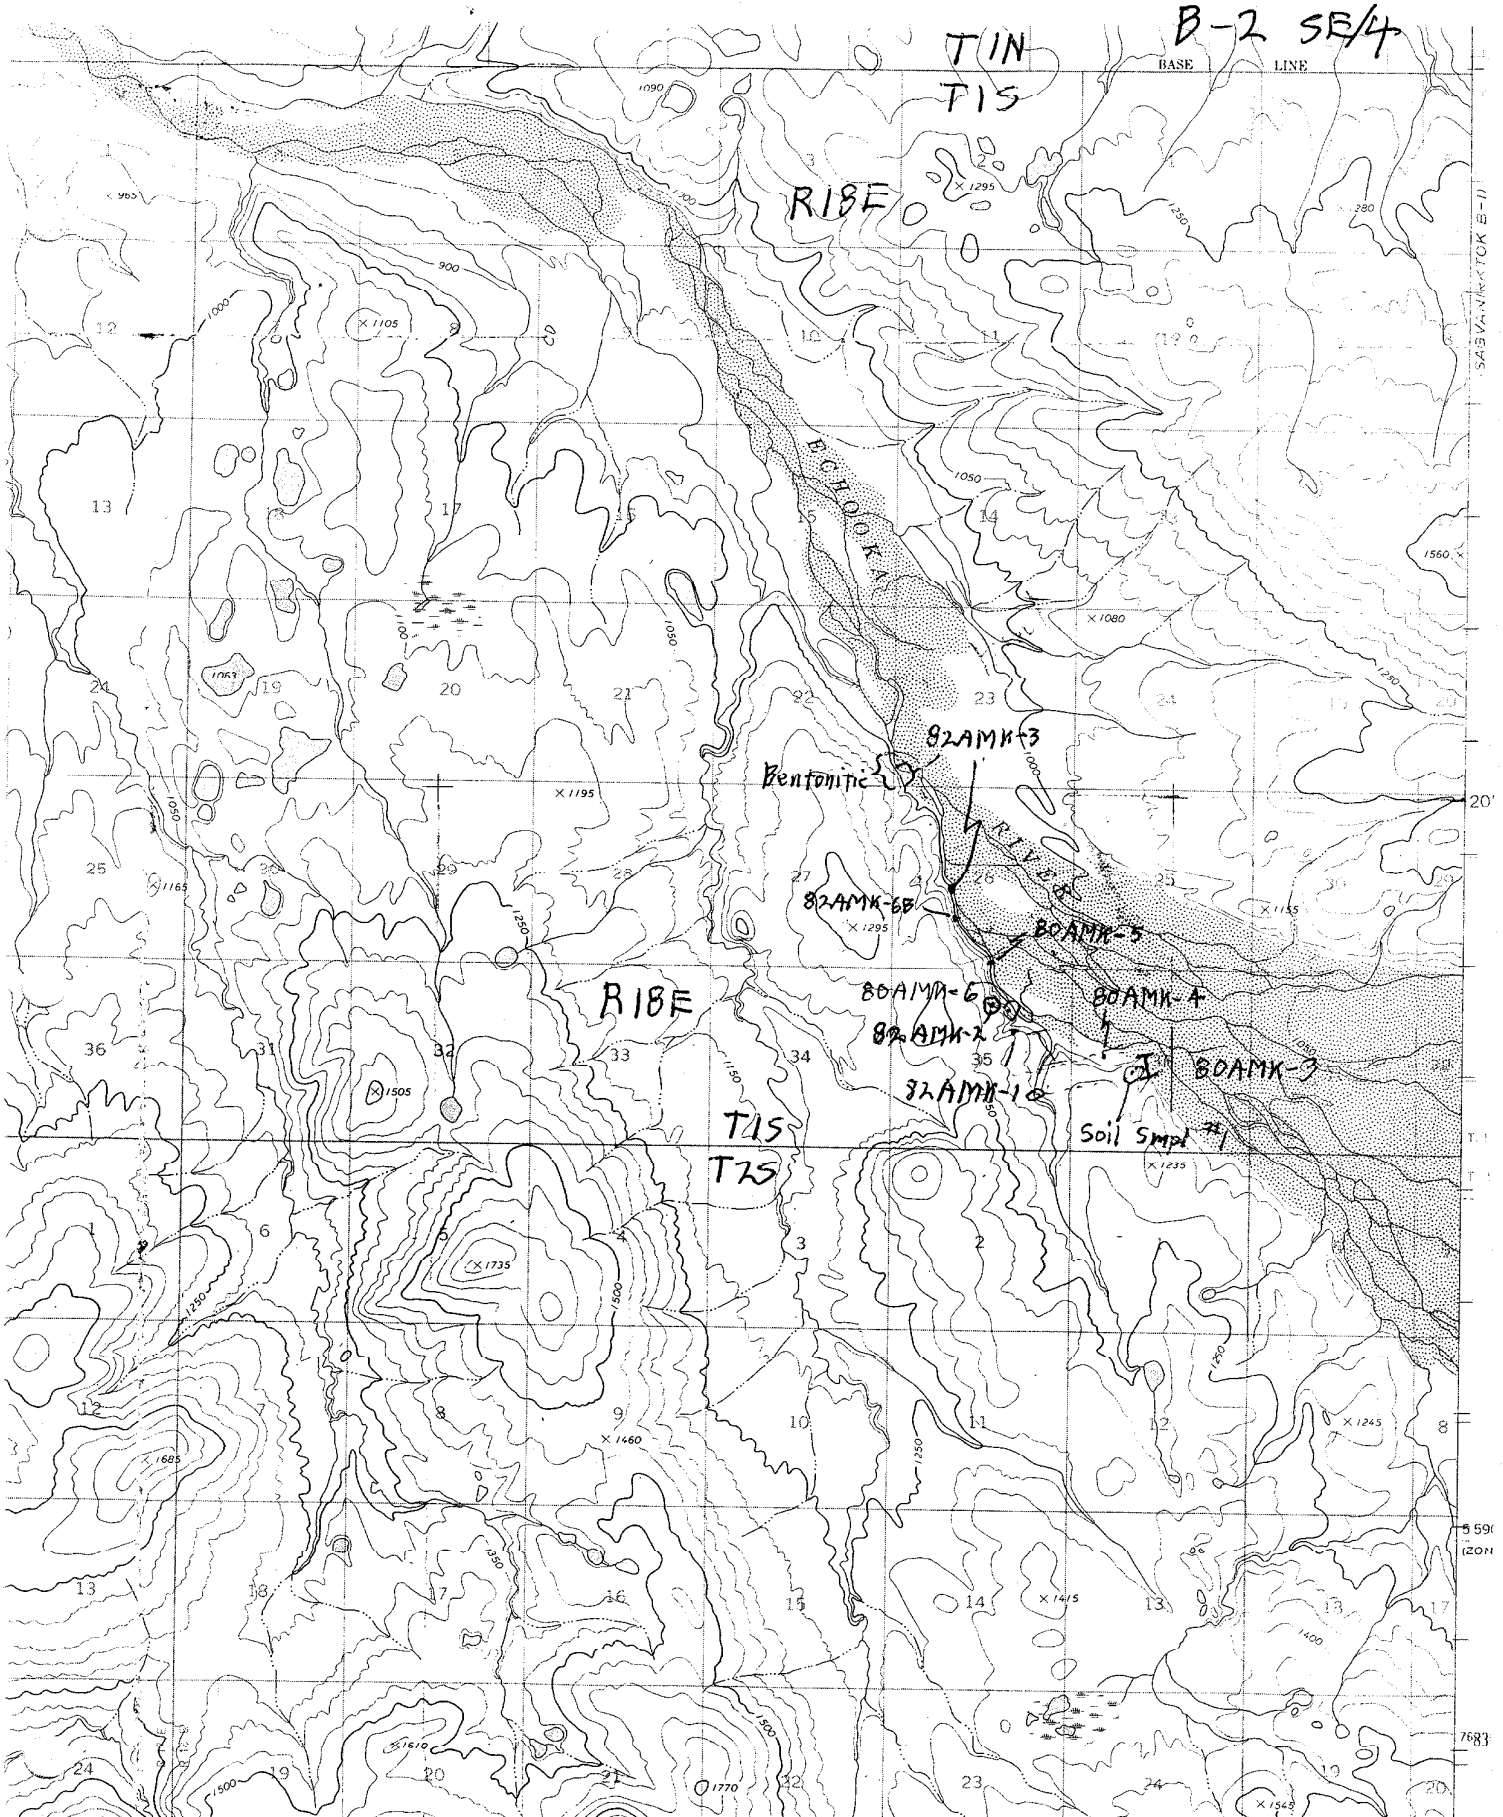

(SAGAVANIRKOTOK A-2)

SCALE 1:63360

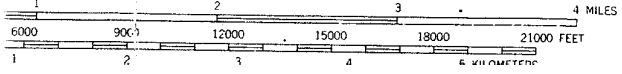

Sagavanirktok B-2 SE/4


INTERIOR GEOLOGICAL SURVEY WASHINGTON, D.C. 20515 1974 40' R.L.B.E. 475000m.E. 147°36'

ROAD CLASSIFICATION

UNITED STATES  
DEPARTMENT OF THE INTERIOR  
GEOLOGICAL SURVEY

Sag B-3

NW/4

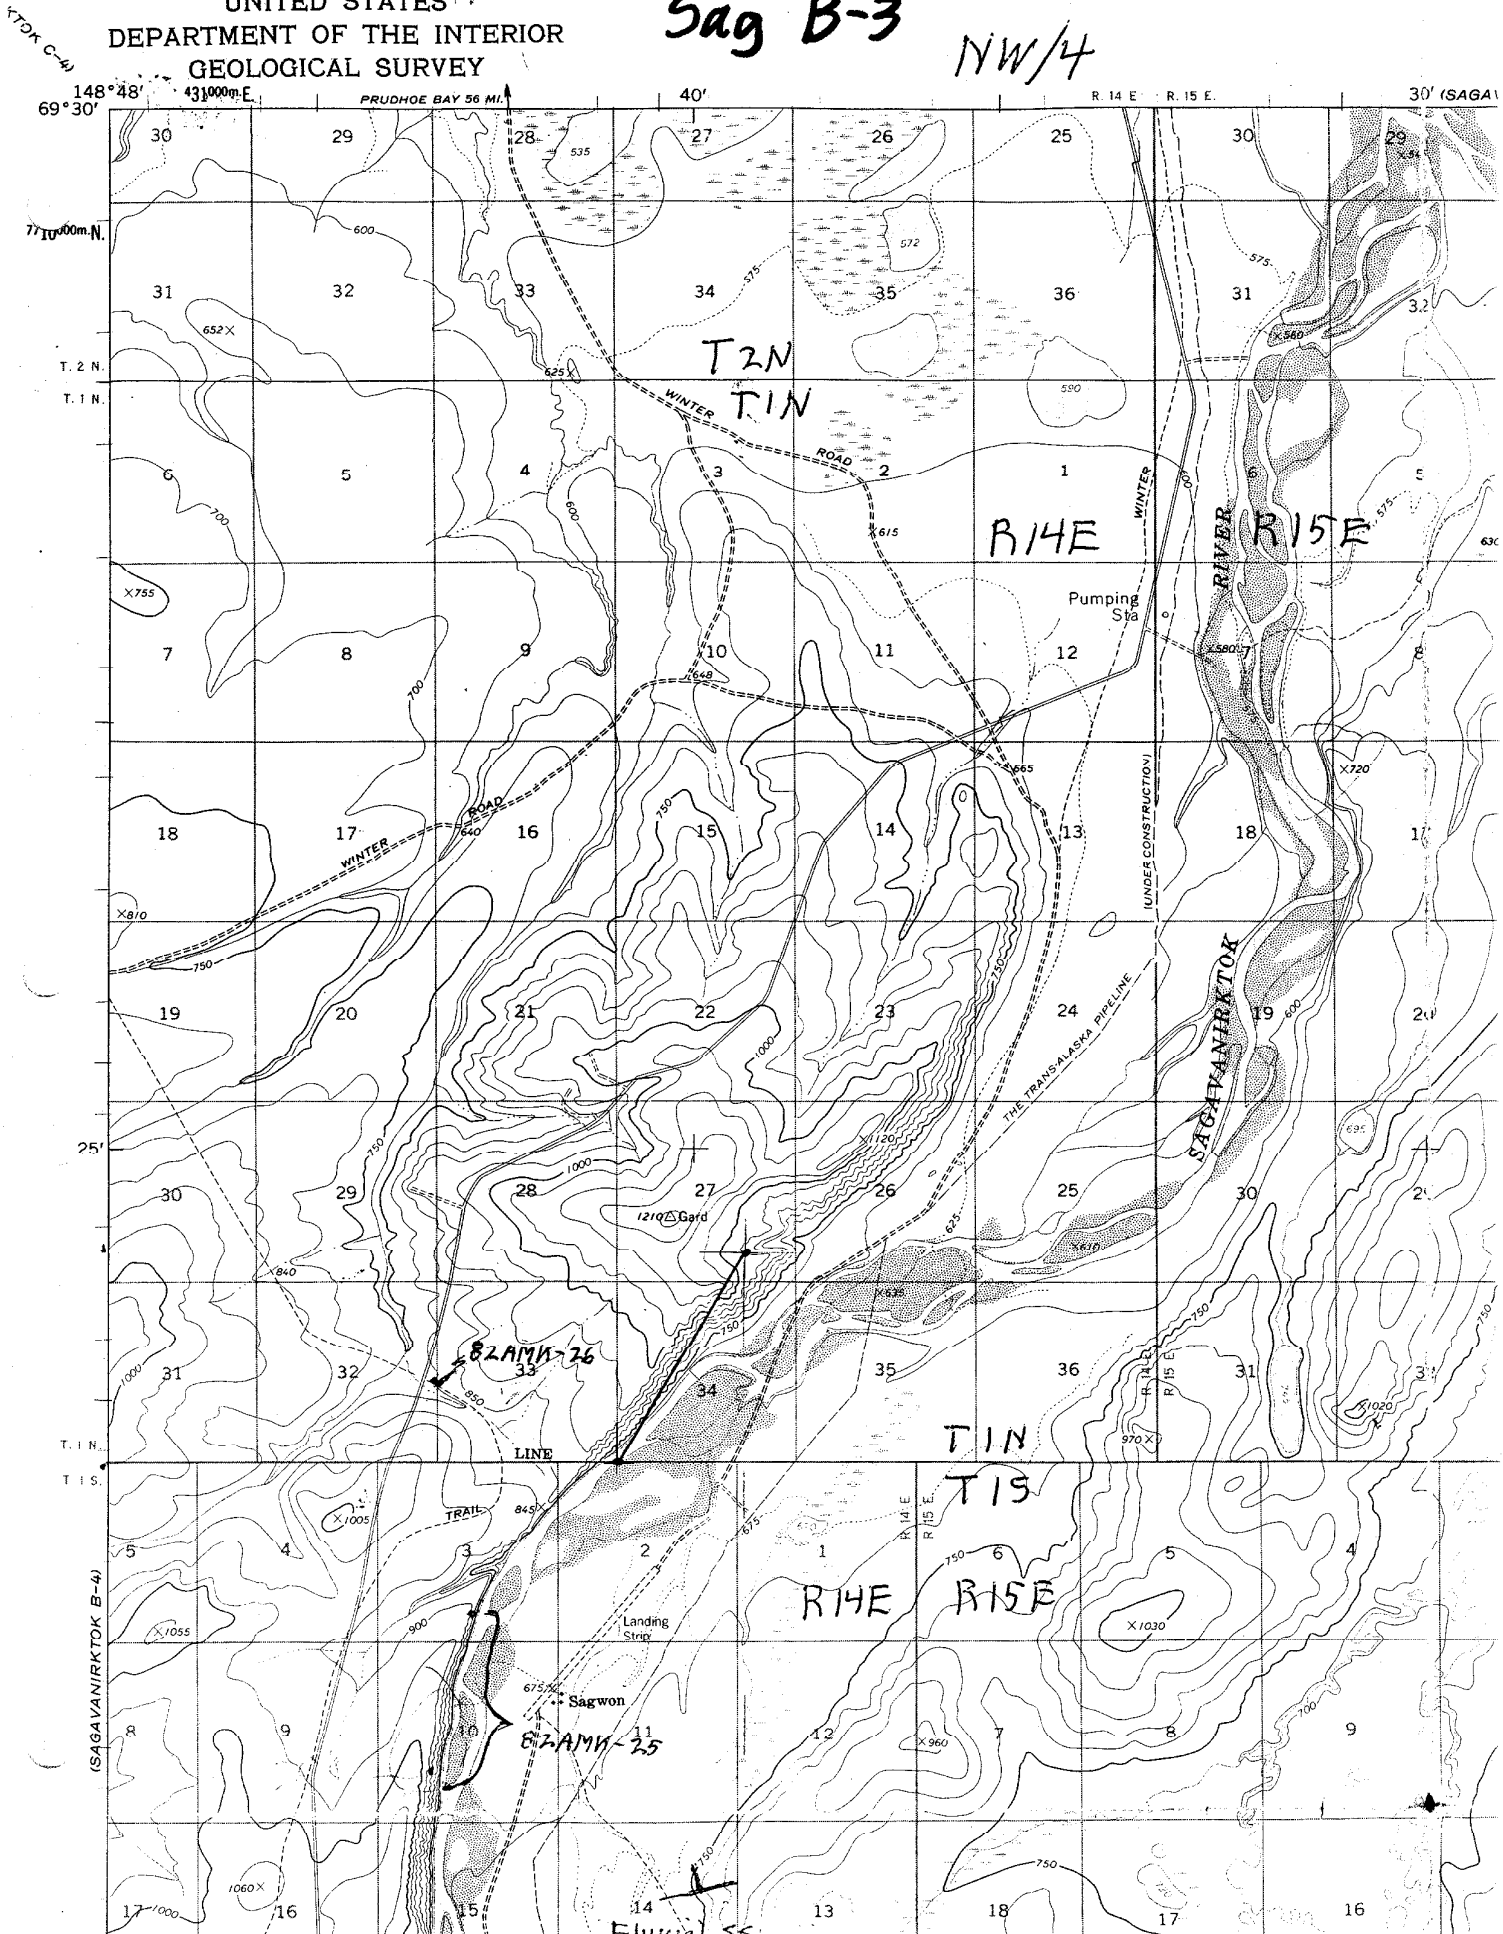

SAGAVANIRKTOK (B-3) QUADRANGLE

ALASKA NORTH SLOPE BOROUGH

1:63 360 SERIES (TOPOGRAPHIC)

Sagavanirktok B-3 ~~NE/4~~ NE/4


30' (SAGAVANIRKTOK C-3)


20' R. 15 E. R. 16 E

720 000 FEET

148° 12' 69° 30'


SAGAWA

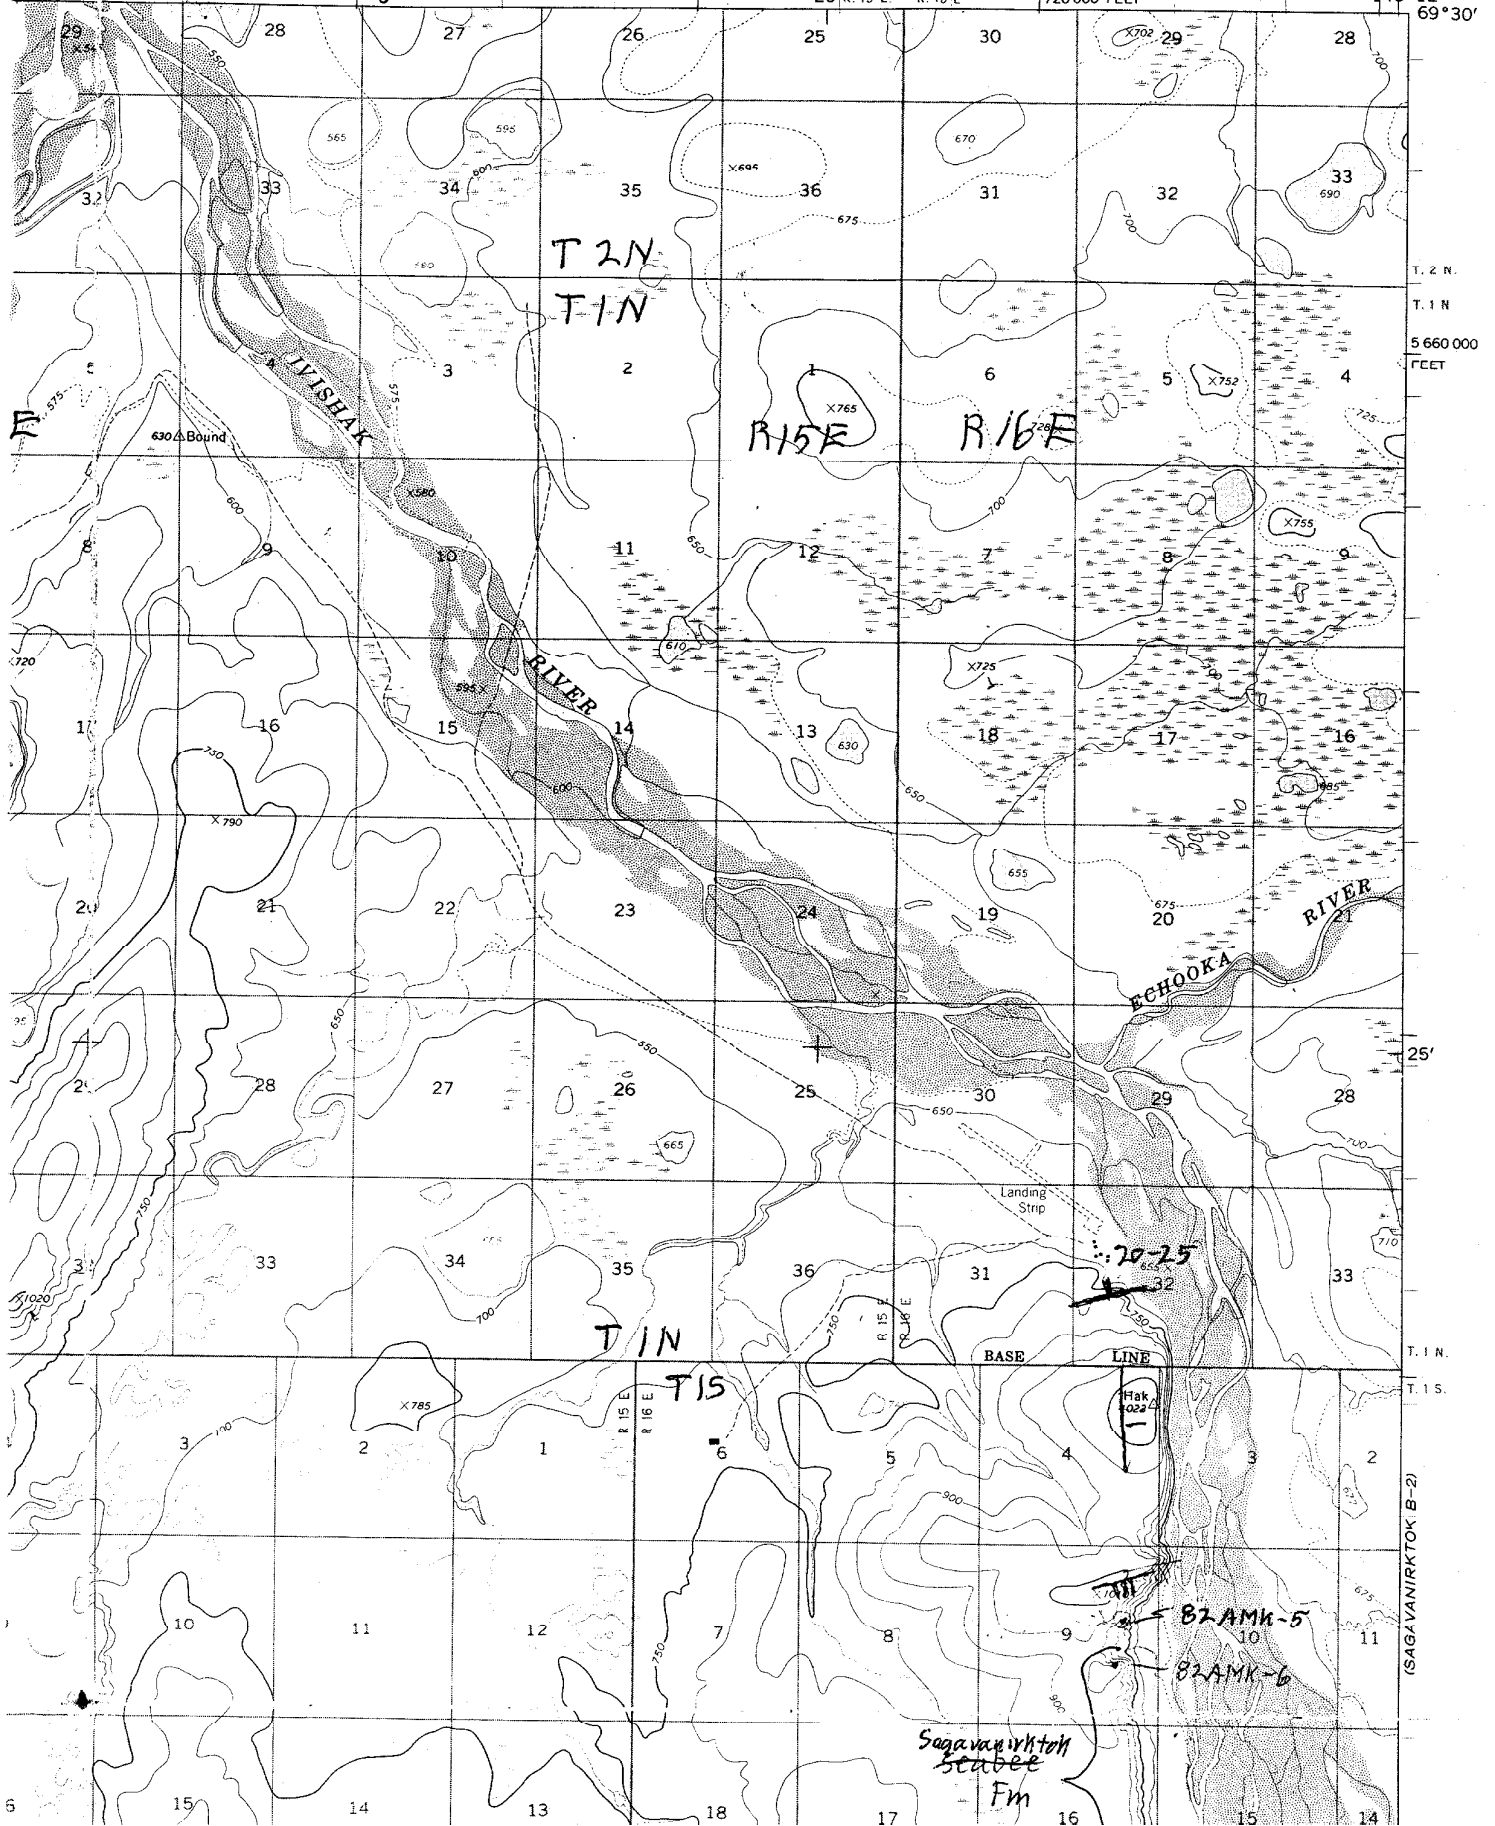

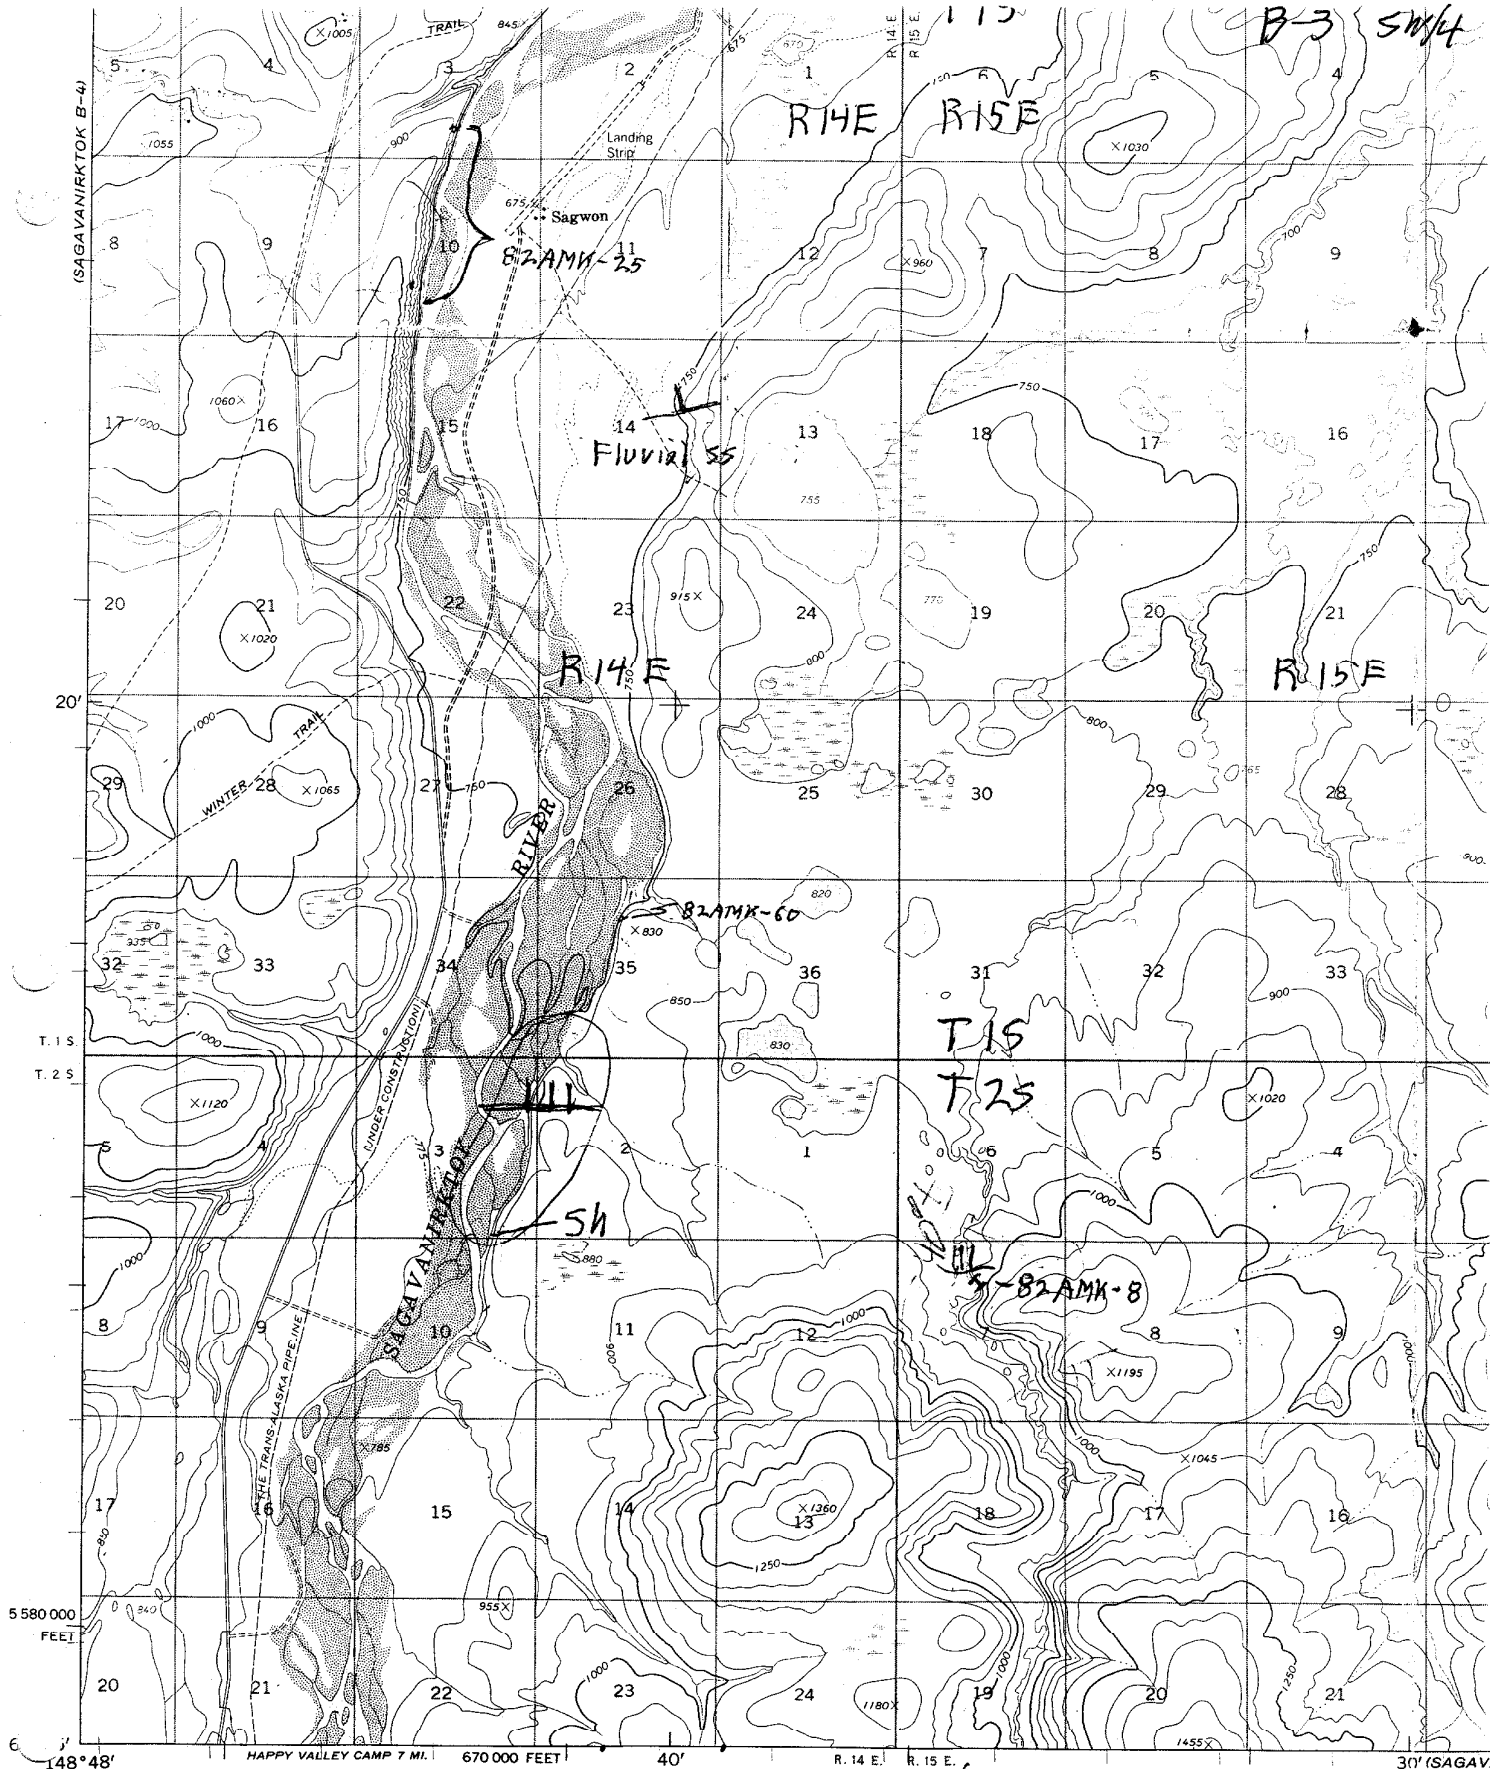

Mapped, edited, and published by the Geological Survey -  
 Control by USGS, USC&GS, and USCE *Sagavanirktok* B-3 SW/4  
 Topography by photogrammetric methods from aerial photographs  
 taken 1970, field annotated 1971. Map not field checked  
 Projection and 1000-meter grid ticks: Universal  
 Transverse Mercator, zone 6  
 SCALE 1:63360  
 CONTOUR INTERVAL 50  
 DOTTED LINES REPRESENT 25-FOOT



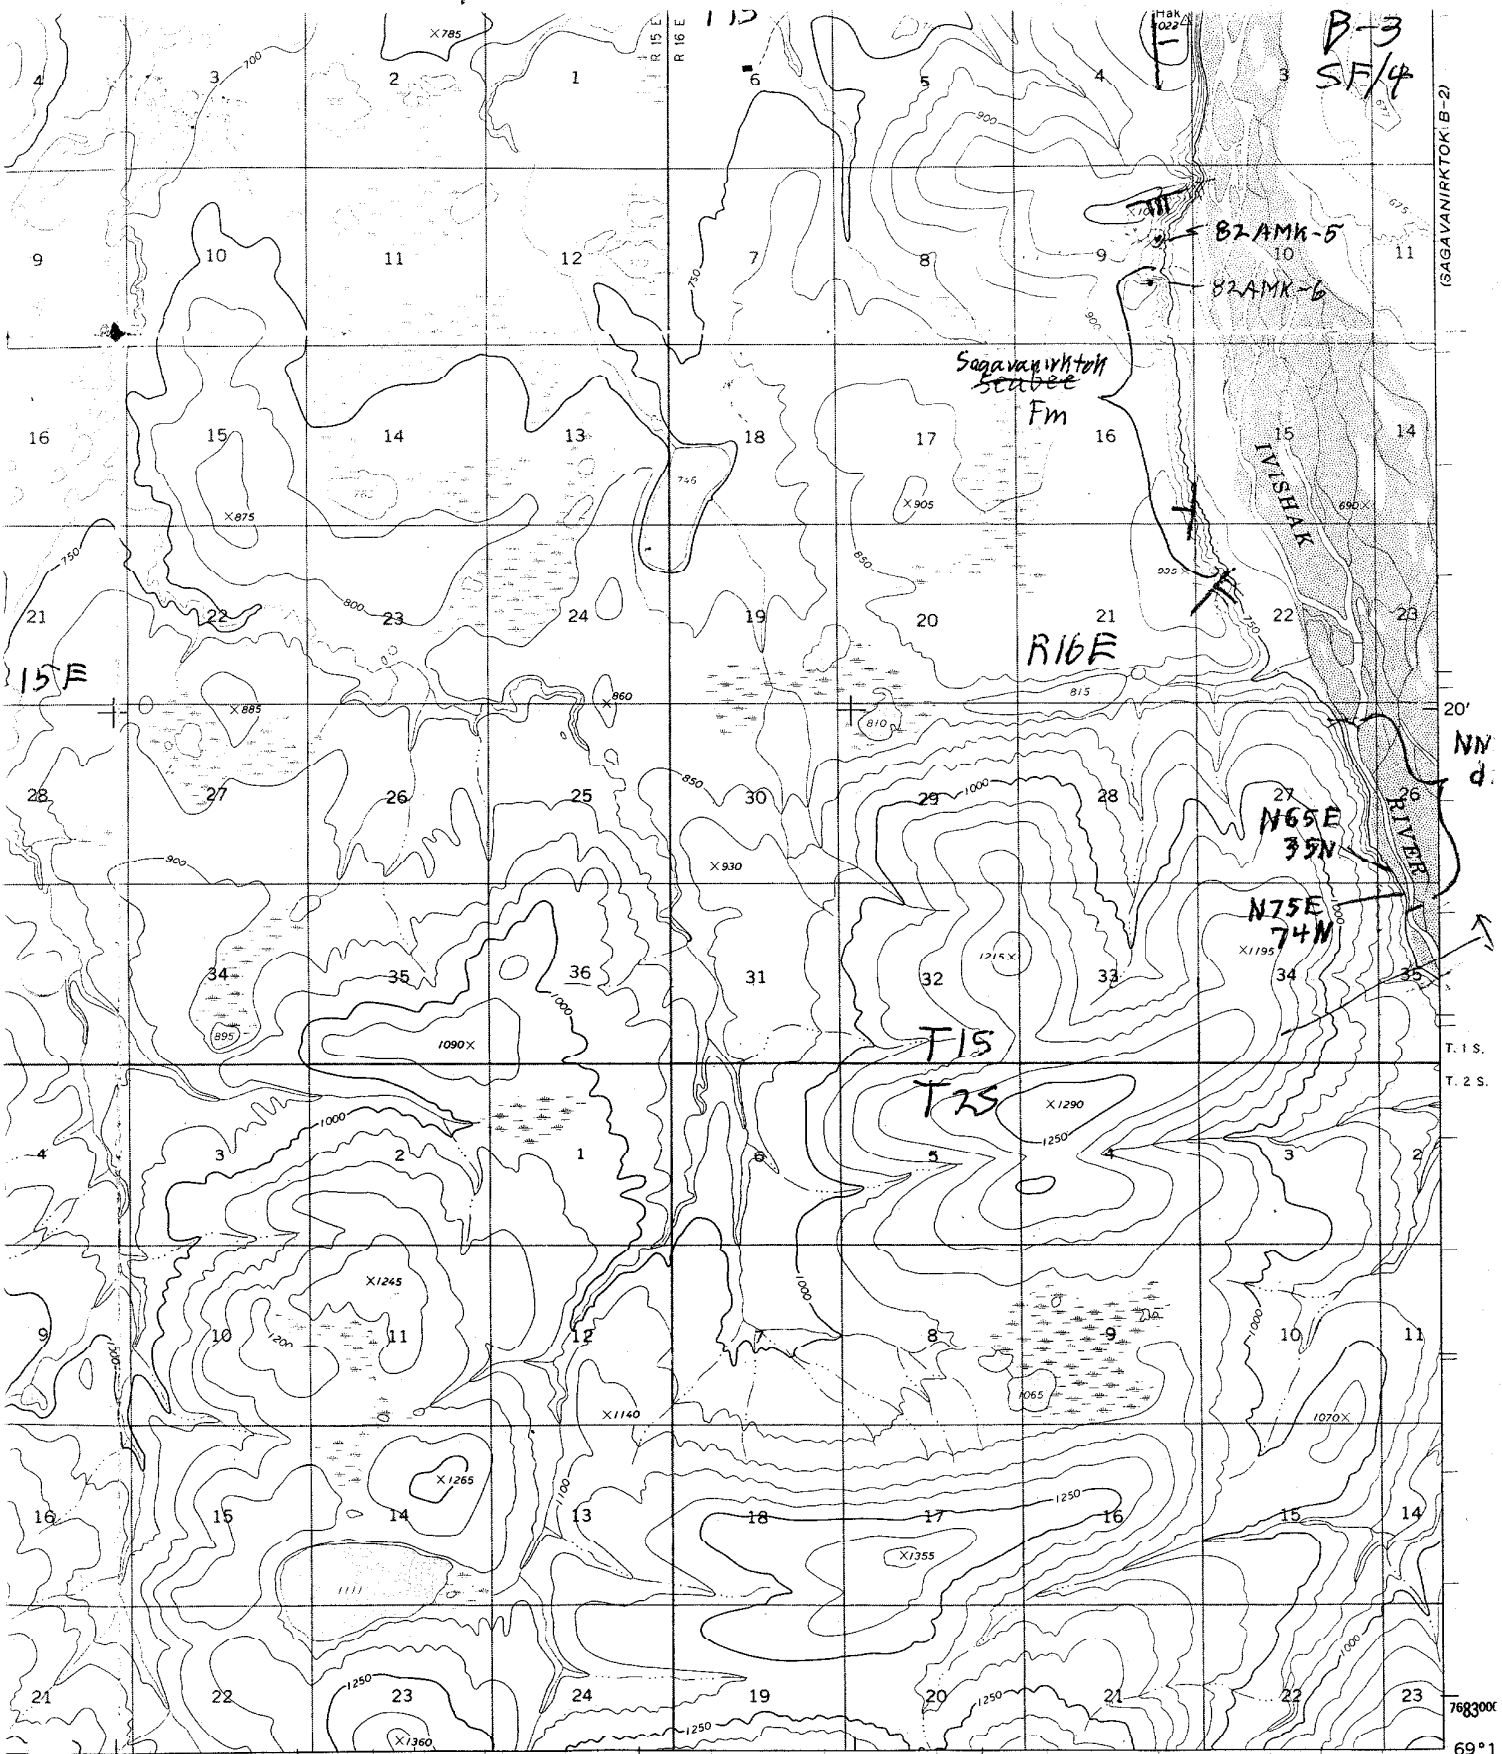

30' (SAGAVANIRKTOK A-3) R. 15 E. R. 16 E. 20' 452000m. E. 148° 12' 69° 1'

SCALE 1:63360

0 1 2 3 4 MILES

000 9000 12000 15000 18000 21000 FEET

2 3 4 5 KILOMETERS


NTOUR INTERVAL 50 FEET  
LINES REPRESENT 25-FOOT CONTOURS

Sagavanirktok B-3 1 SE/4

ROAD CLASSIFICATION  
Light duty ..... Unimproved dirt .....

INTERIOR - GEOLOGICAL SURVEY, RESTON, VIRGINIA - 1977

B-4 SW/4

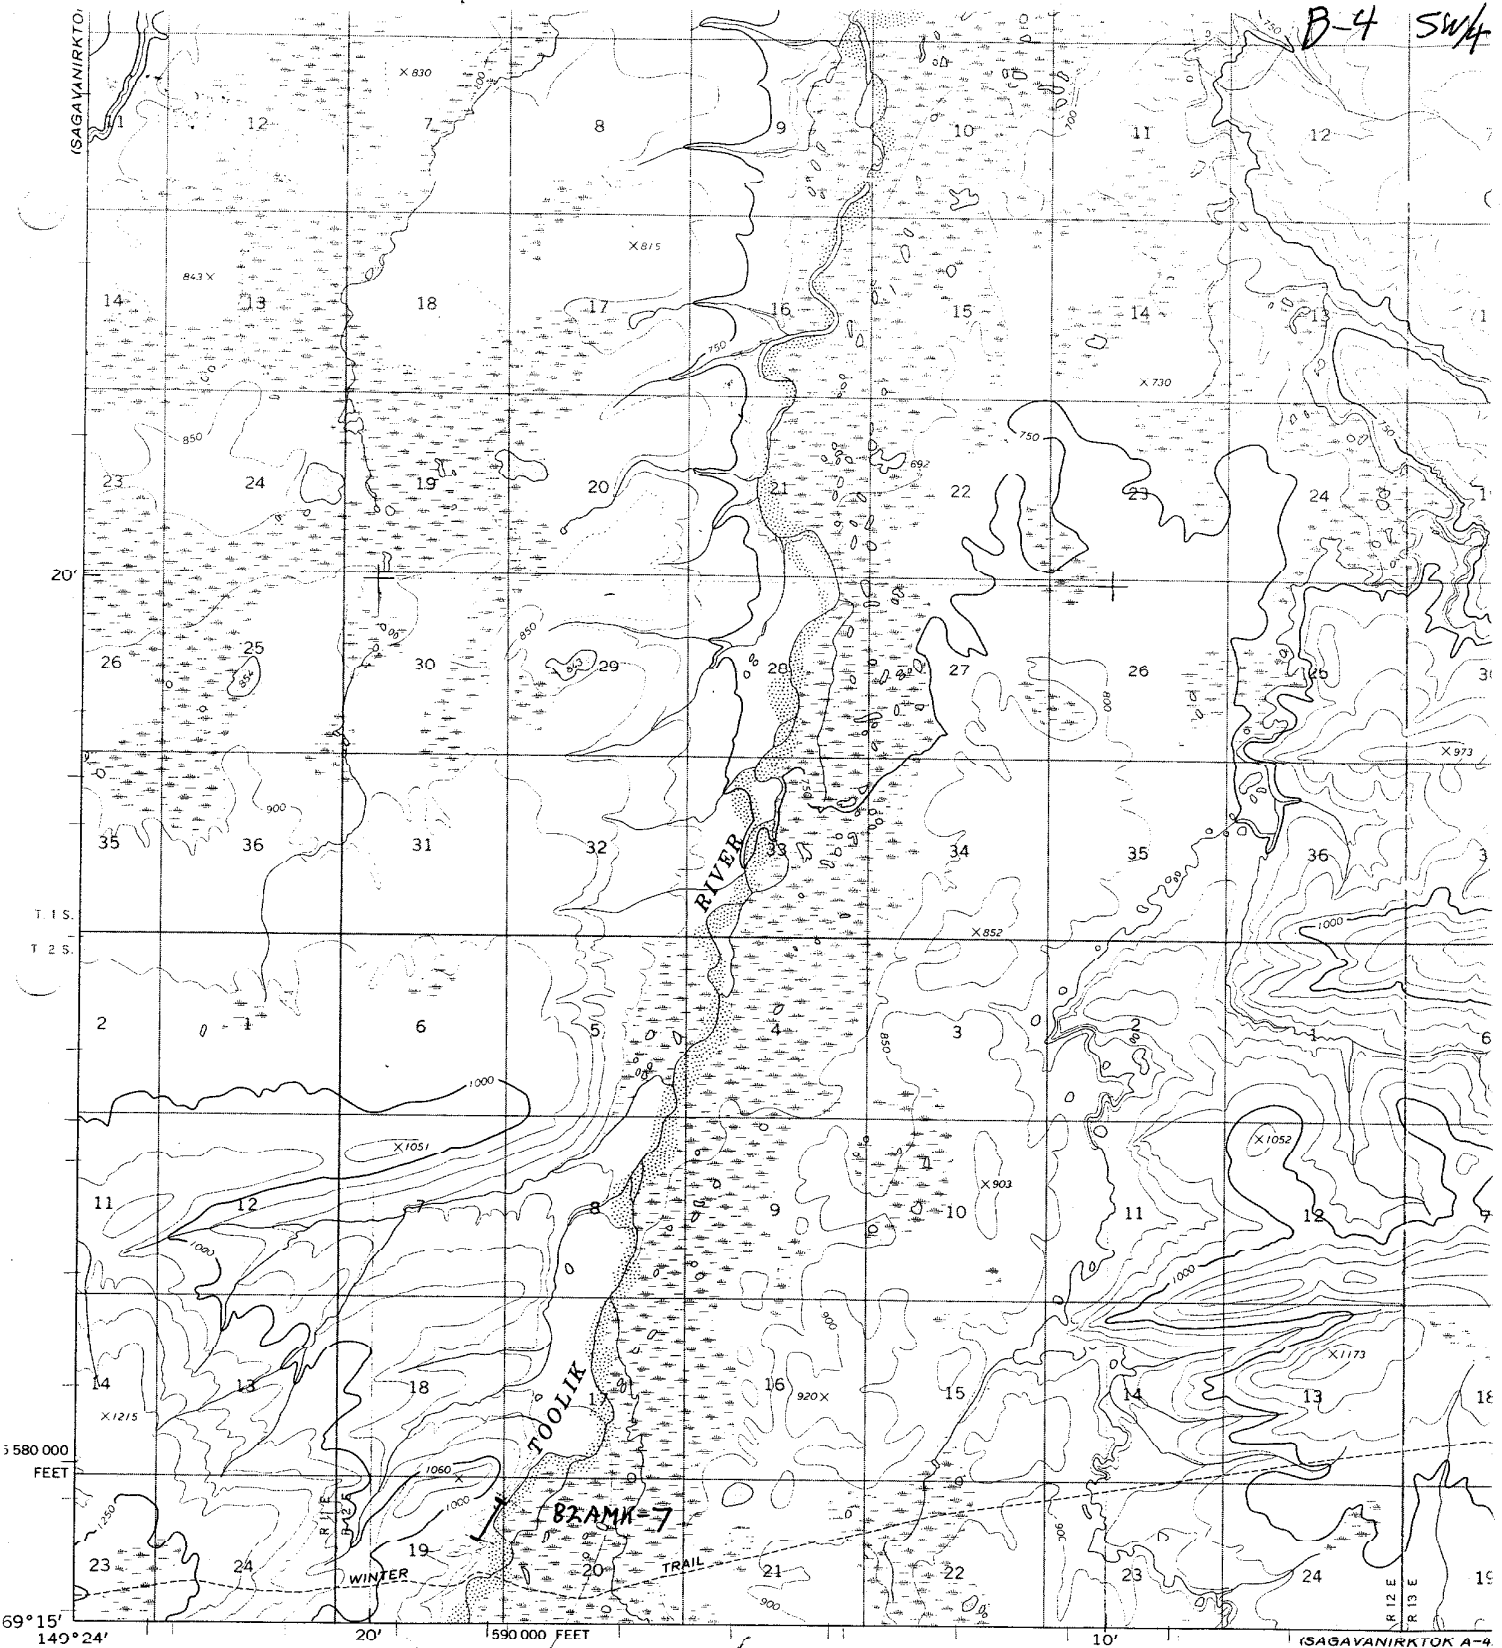

Mapped, edited, and published by the Geological Survey  
 Control by USGS and USC&GS

Topography by photogrammetric methods from aerial photographs  
 taken 1970, field annotated 1971. Map not field checked


Projection and 1,000-meter grid ticks: Universal  
 Transverse Mercator, zone 6  
 10,000-foot grid ticks based on Alaska coordinate  
 system, zone 4. 1927 North American datum

Land lines represent unsurveyed and unmarked locations  
 predetermined by the Bureau of Land Management  
 Folios U-3 and U-11, Umiat Meridian


Swamps as portrayed. indicate only the wetter areas

SW/4

SAG  
B-4

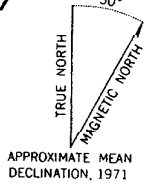


APPROXIMATE MEAN DECLINATION, 1971

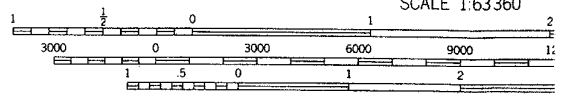

SCALE 1:63360

CONTOUR INTERVAL 50 F  
 DOTTED LINES REPRESENT 25-FOOT  
 DATUM IS MEAN SEA LEVEL

FOR SALE BY U. S. GEOLOGICAL SURVEY  
 FAIRBANKS, ALASKA 99701, DENVER, COLORADO 80221

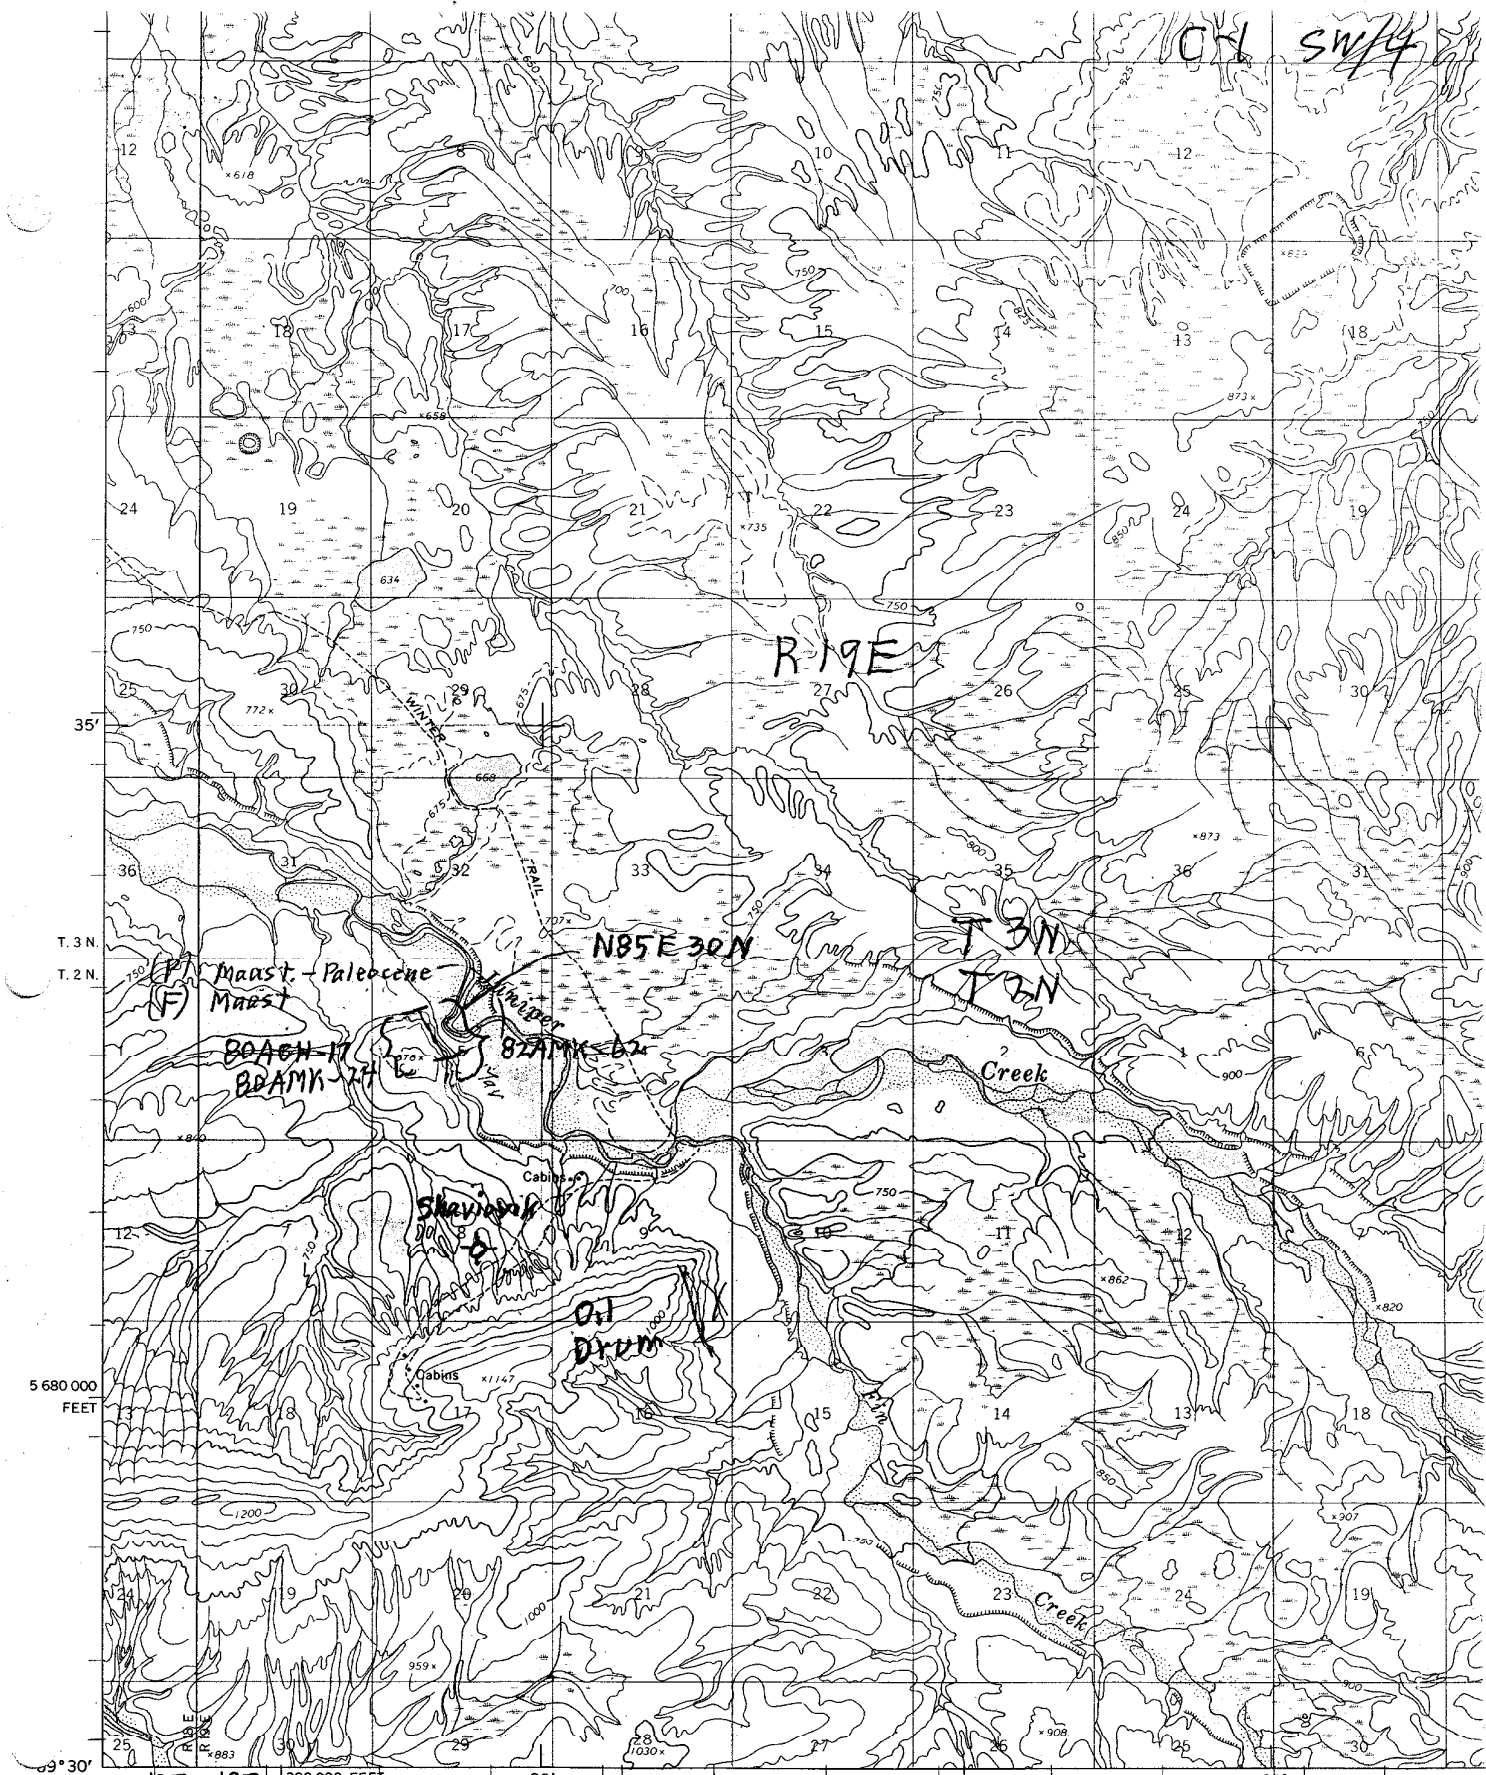


Mapped by the Army Map Service  
 Edited and published by the Geological Survey  
 Control by USC&GS and USCE

Topography by photogrammetric methods from aerial photographs  
 taken 1955, field annotated 1955. Map not field checked

National Topographic Map Series, 1:63,360 North American Datum

Sag P C-1 SW/4

C-2 SE/4

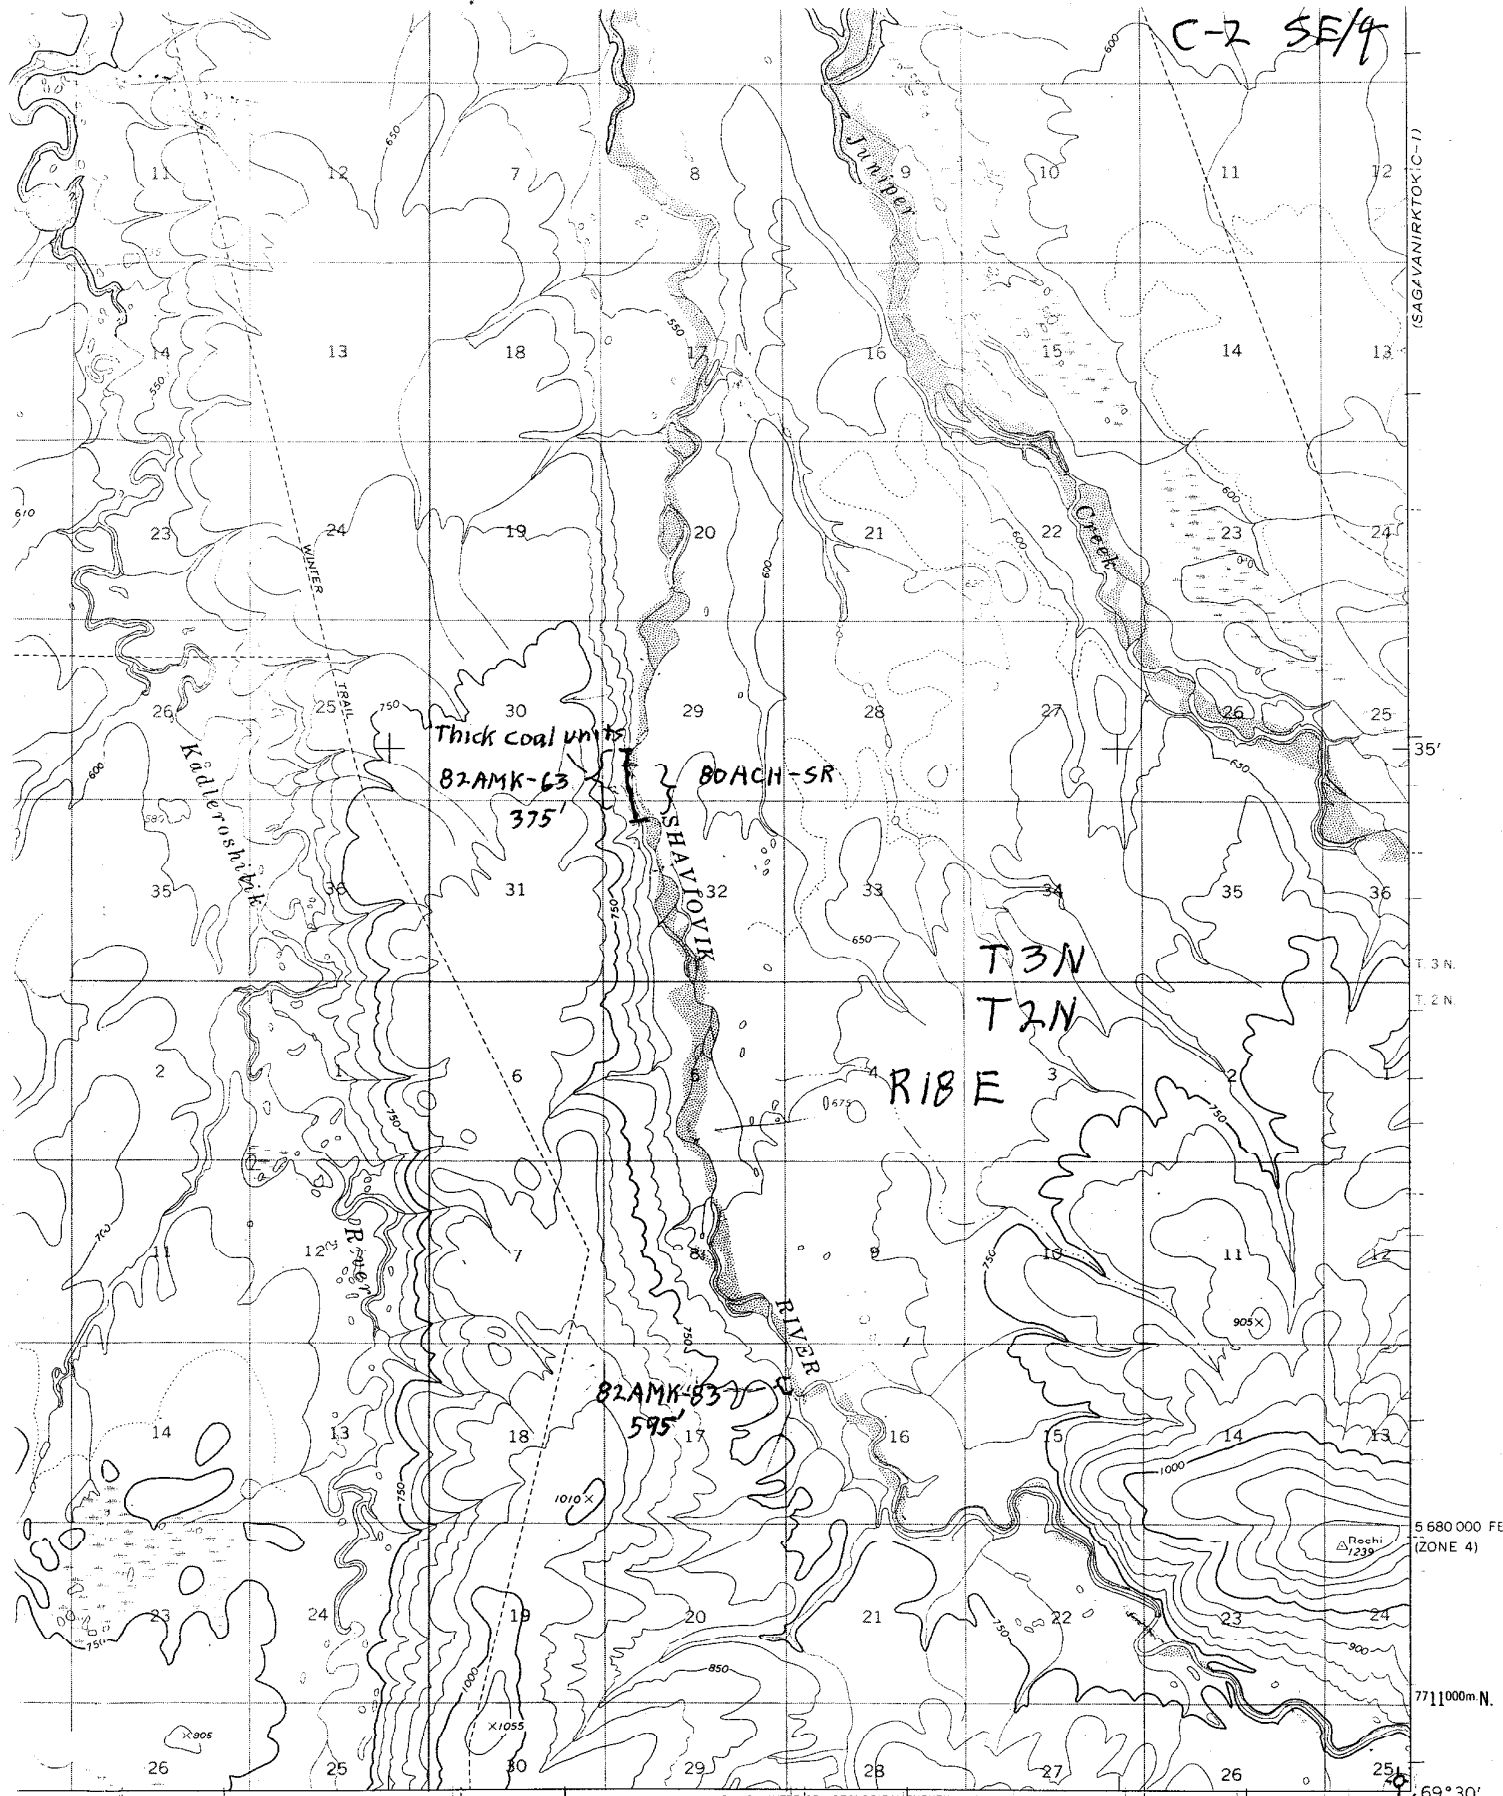


AGAVANIRKTOK B-2)

R. 17 E 50' R. 18 E.

INTERIOR-GEOLOGICAL SURVEY, WASHINGTON, D. C. - 1973 40' 800 000 FEET (ZONE 4) 473000m. E.

5 680 000 FE (ZONE 4) 7711000m. N. 69°30' 147°36'

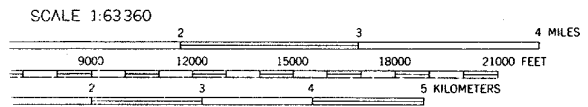


Sagavanirktok C-2 SE/4

ROAD CLASSIFICATION  
Trails

SAGAVAI.

C-4 SE/4

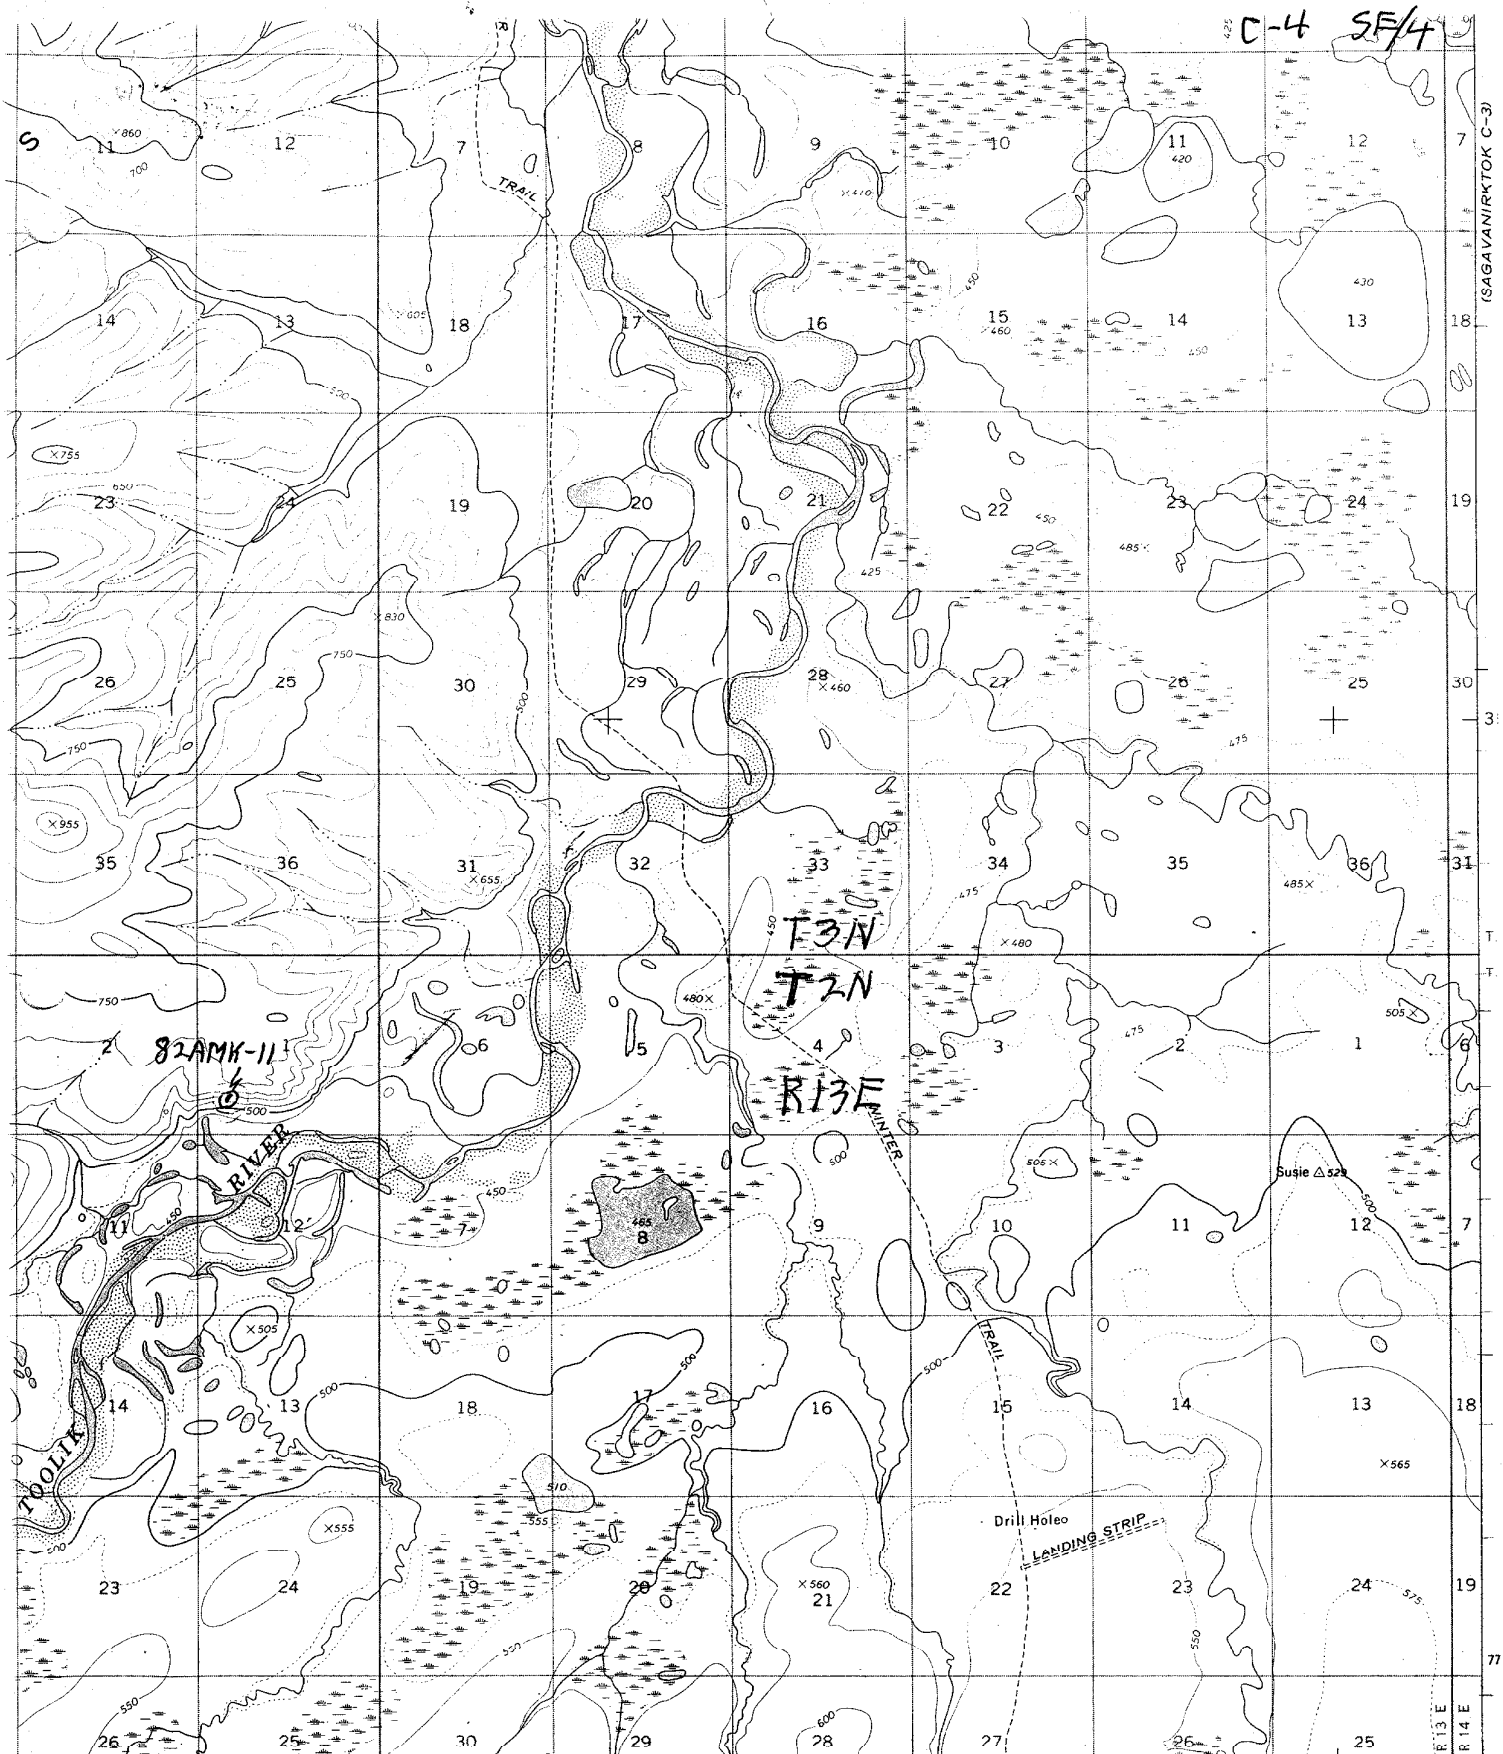

(SAGAVANIRKTOK B-4) R. 12 E. R. 13 E. 149°

SCALE 1:63360

0 1 2 3 4 MILES

0 6000 9000 12000 15000 18000 21000 FEET

0 1 2 3 4 5 KILOMETERS

CONTOUR INTERVAL 50 FEET  
 DOTTED LINES REPRESENT 25-FOOT CONTOURS


INTERIOR—GEOLOGICAL SURVEY, WASHINGTON, D. C.—1974  
 427000m. E. 50' 148° 4'

Sagavanirktok C-4 SE/4

ROAD CLASSIFICATION  
 Trails -----

DEPARTMENT OF THE INTERIOR  
GEOLOGICAL SURVEY


Philip Smith Mtns B-4 NW/4

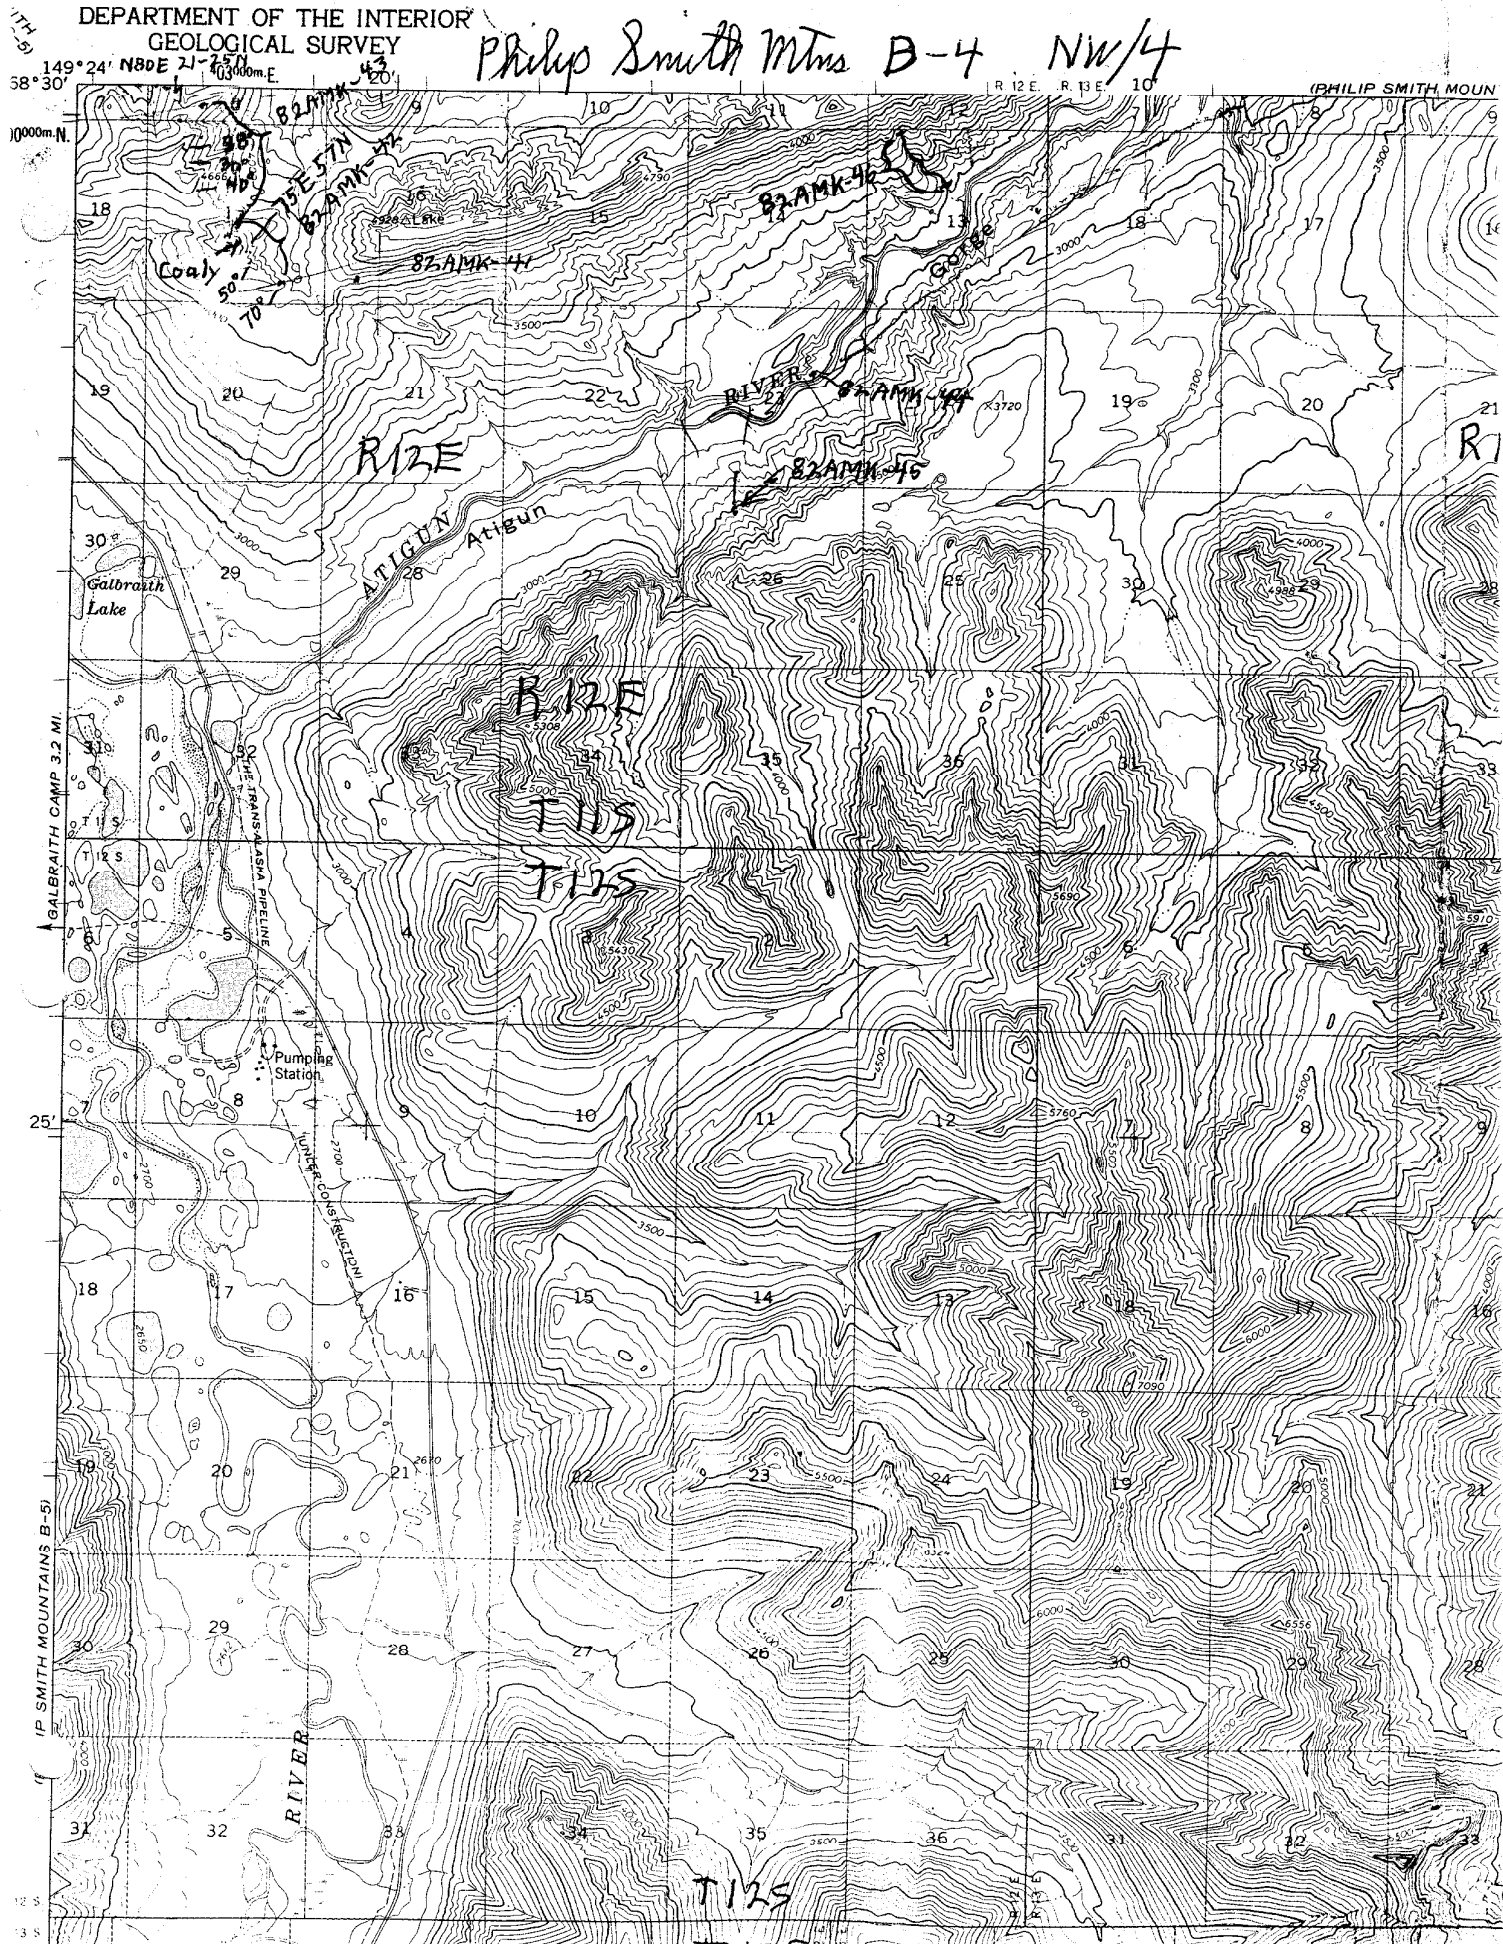

UNITED STATES  
DEPARTMENT OF THE INTERIOR  
GEOLOGICAL SURVEY

Philip Smith Mtns C-3 NW/4

428000m.E R 14 E 40' R 15 E 30' (PHILIP SMITH MOUNTAINS)

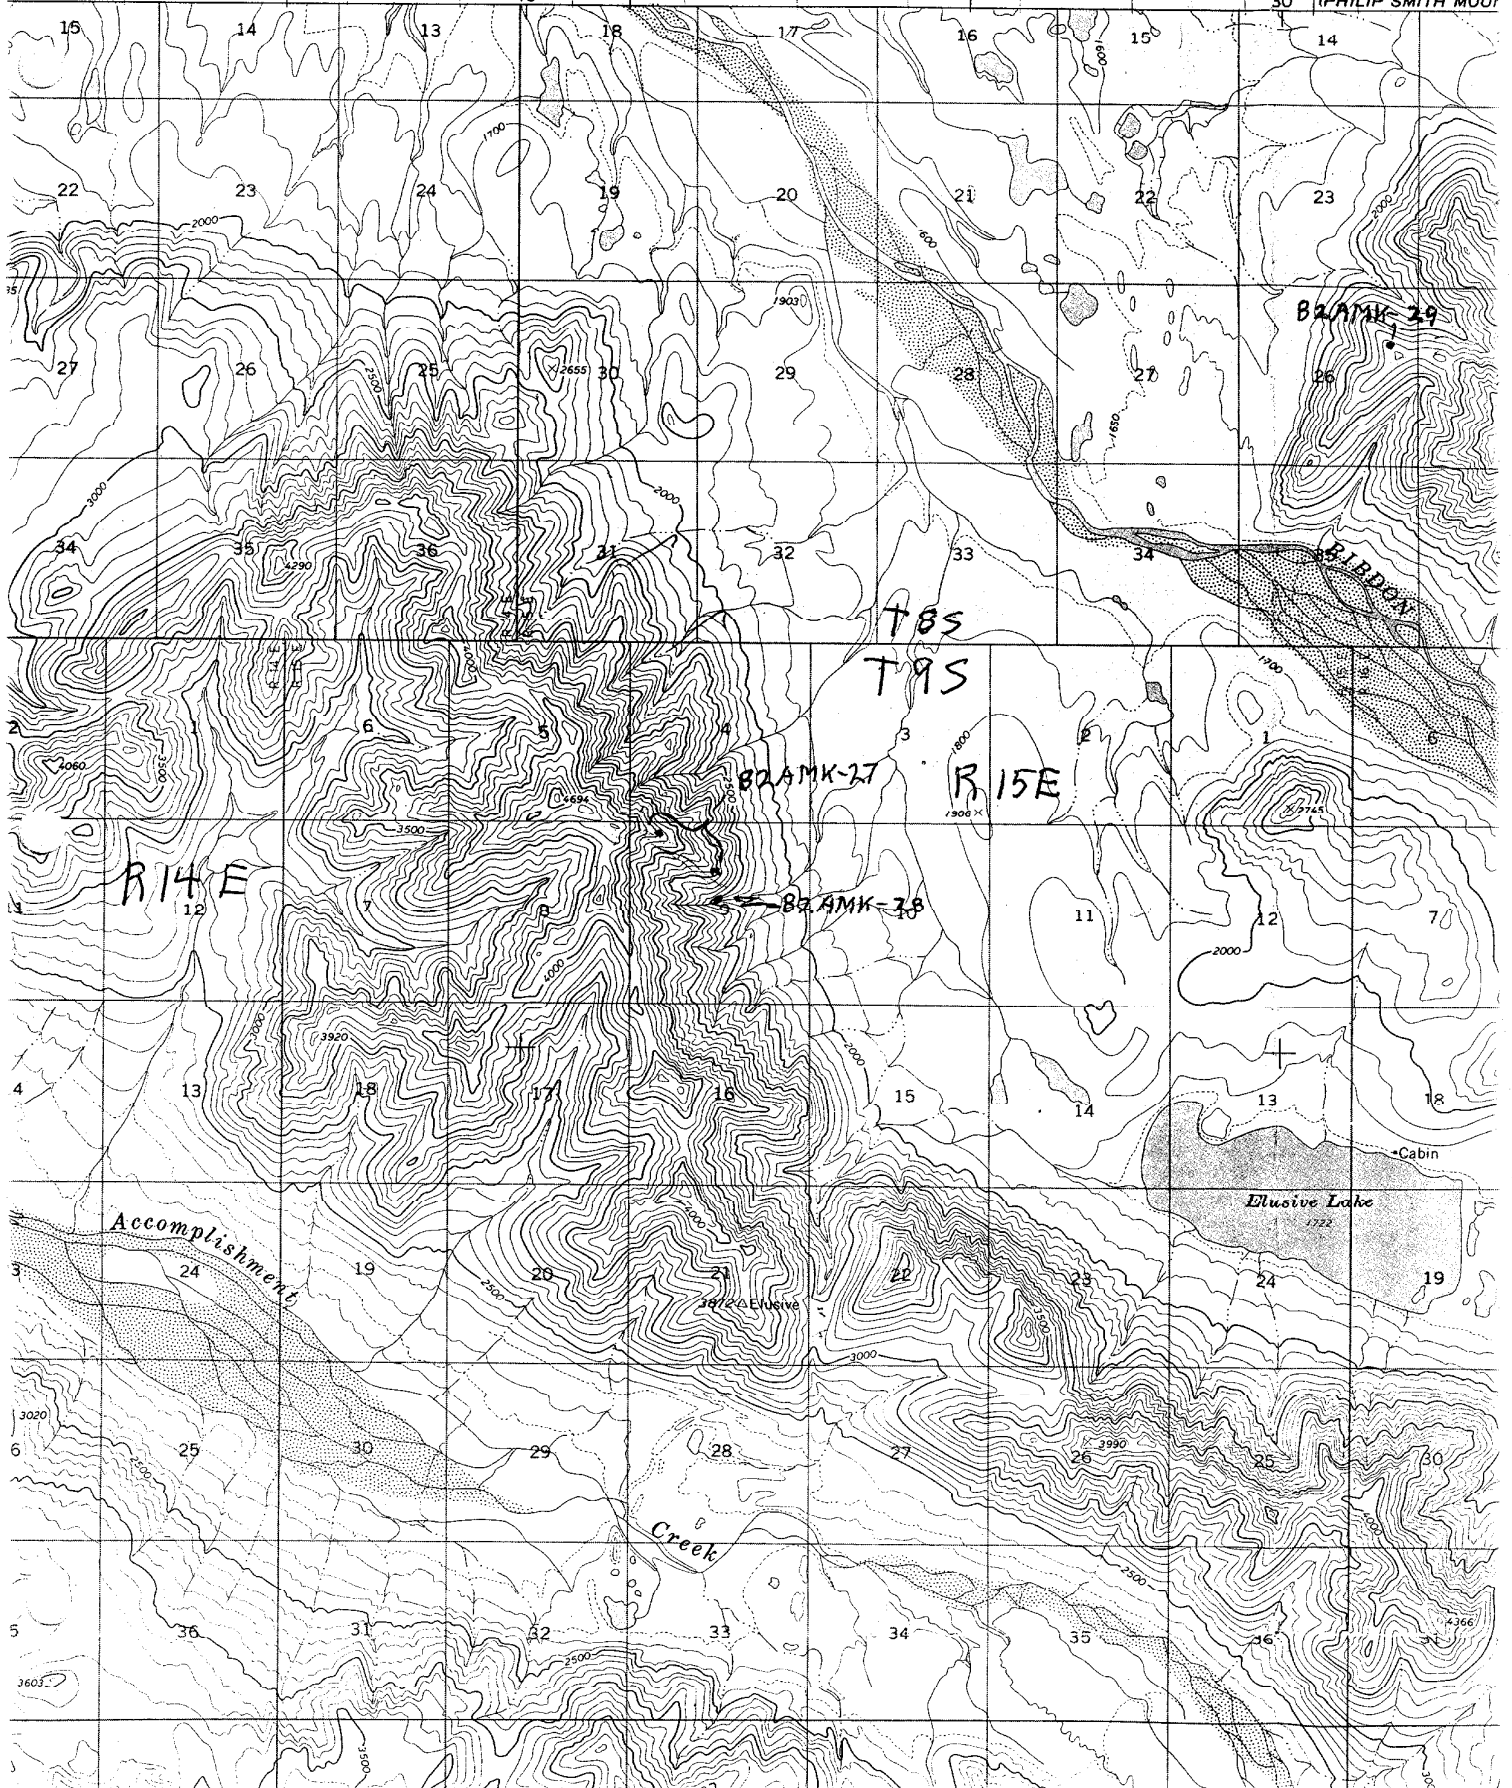

DEPARTMENT OF THE INTERIOR  
GEOLOGICAL SURVEY

Umiat B-4 NW/4





Umiat B-4 NE/4

ALASKA  
1:63 360 SERIES (TOPOGRAPHIC)

(UMI)

(UMIAT C-4)

R.1.W. 152°R.1.E.

770 000 FEET (ZONE 5)

50'

151°48'

69°30'

567000  
(ZONE 5)



T.1.N.  
T.15.

(UMIAT B-3)


UNITED STATES  
DEPARTMENT OF THE INTERIOR  
GEOLOGICAL SURVEY


UMIAT  
26 mi

153°00' 69°00' Chandler Lake 1:250,000 R. 4 W. 510000m. E. R. 3 W. 30' 700,000 FEET (ZONE 5) Umiat 26 mi R. 1 W. 152°

Four-digit numbers are centers of aerial photographs.  
Three-digit numbers are AMK numbers for Molenaar field notes.  
NO = No outcrop


6000 numbers are centers of aerial photos

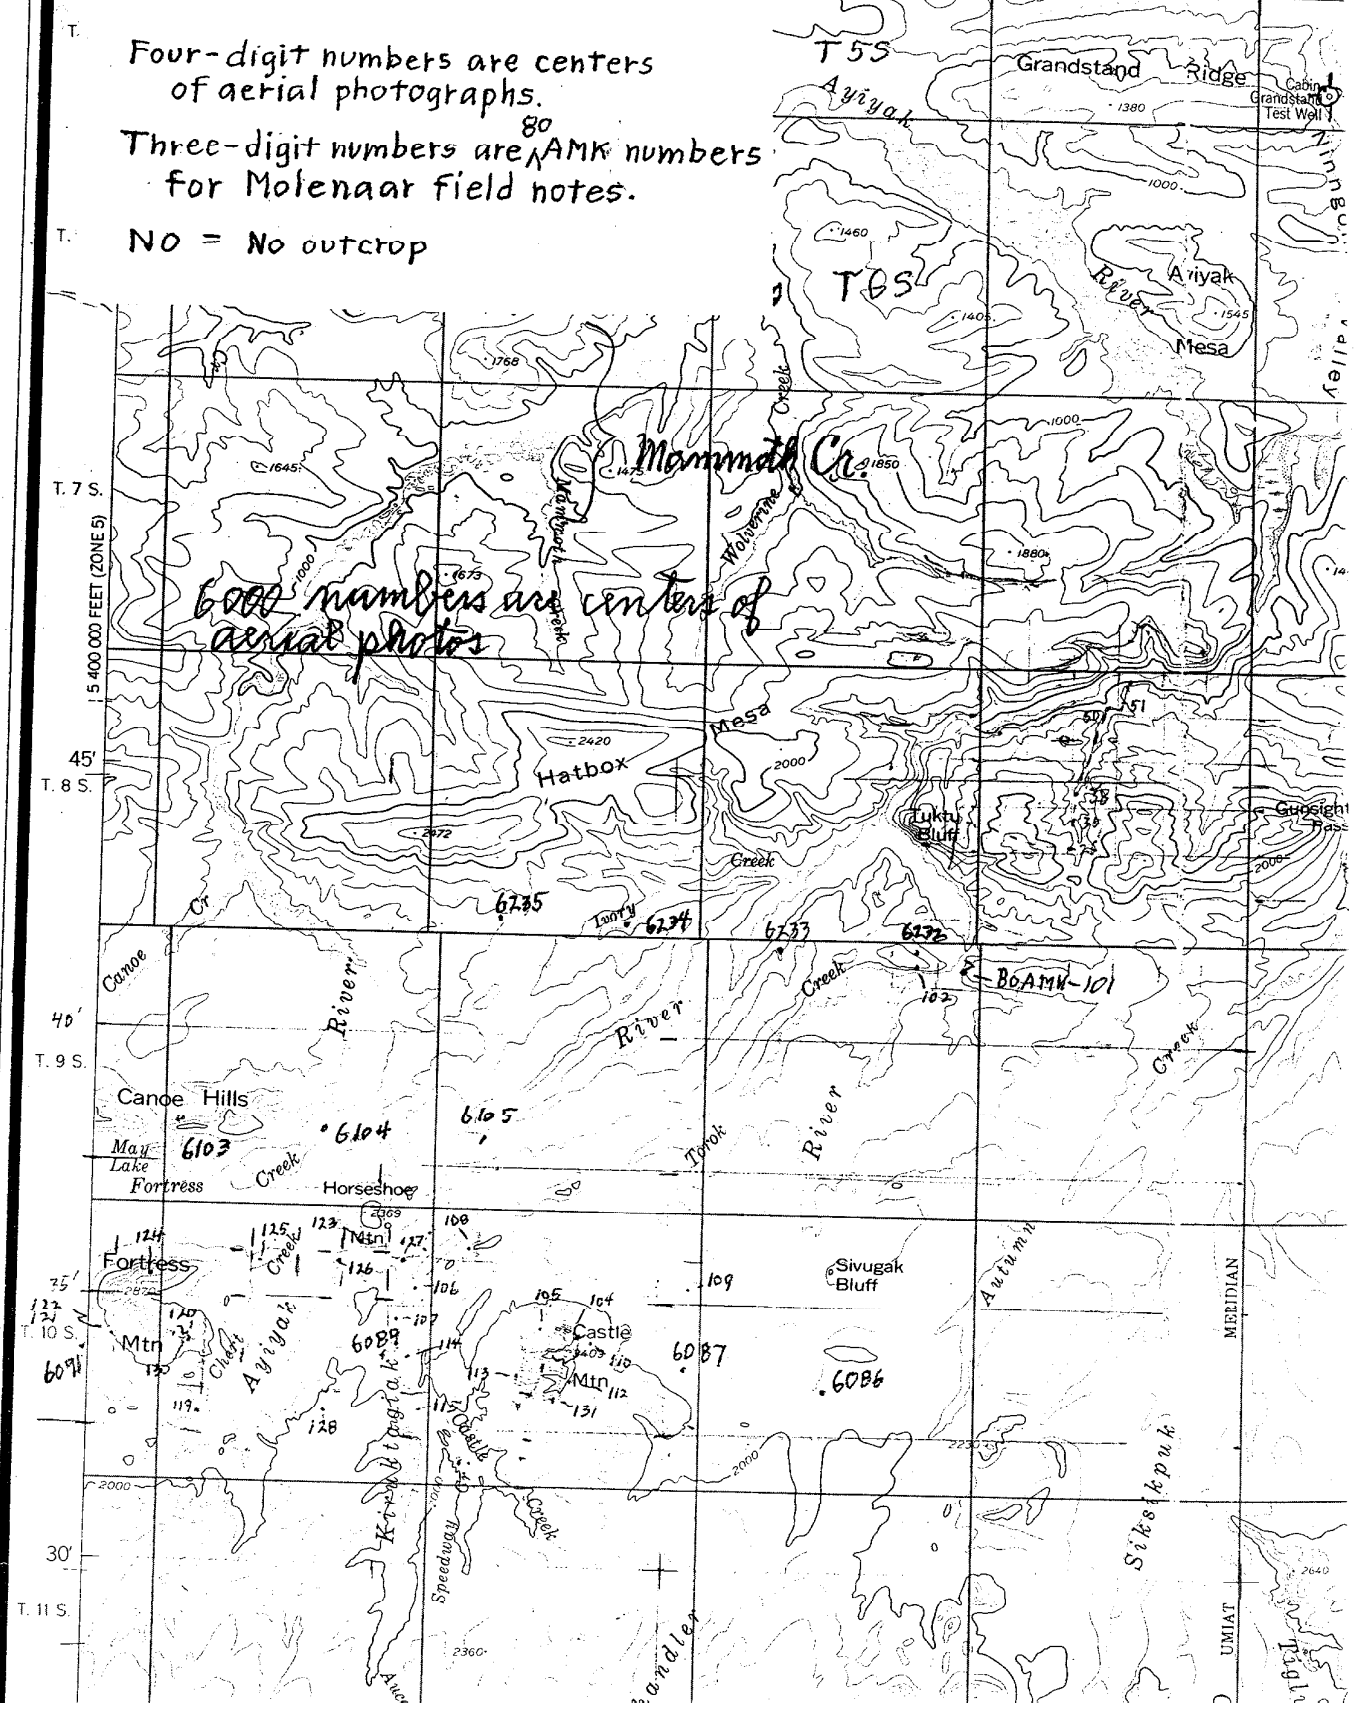

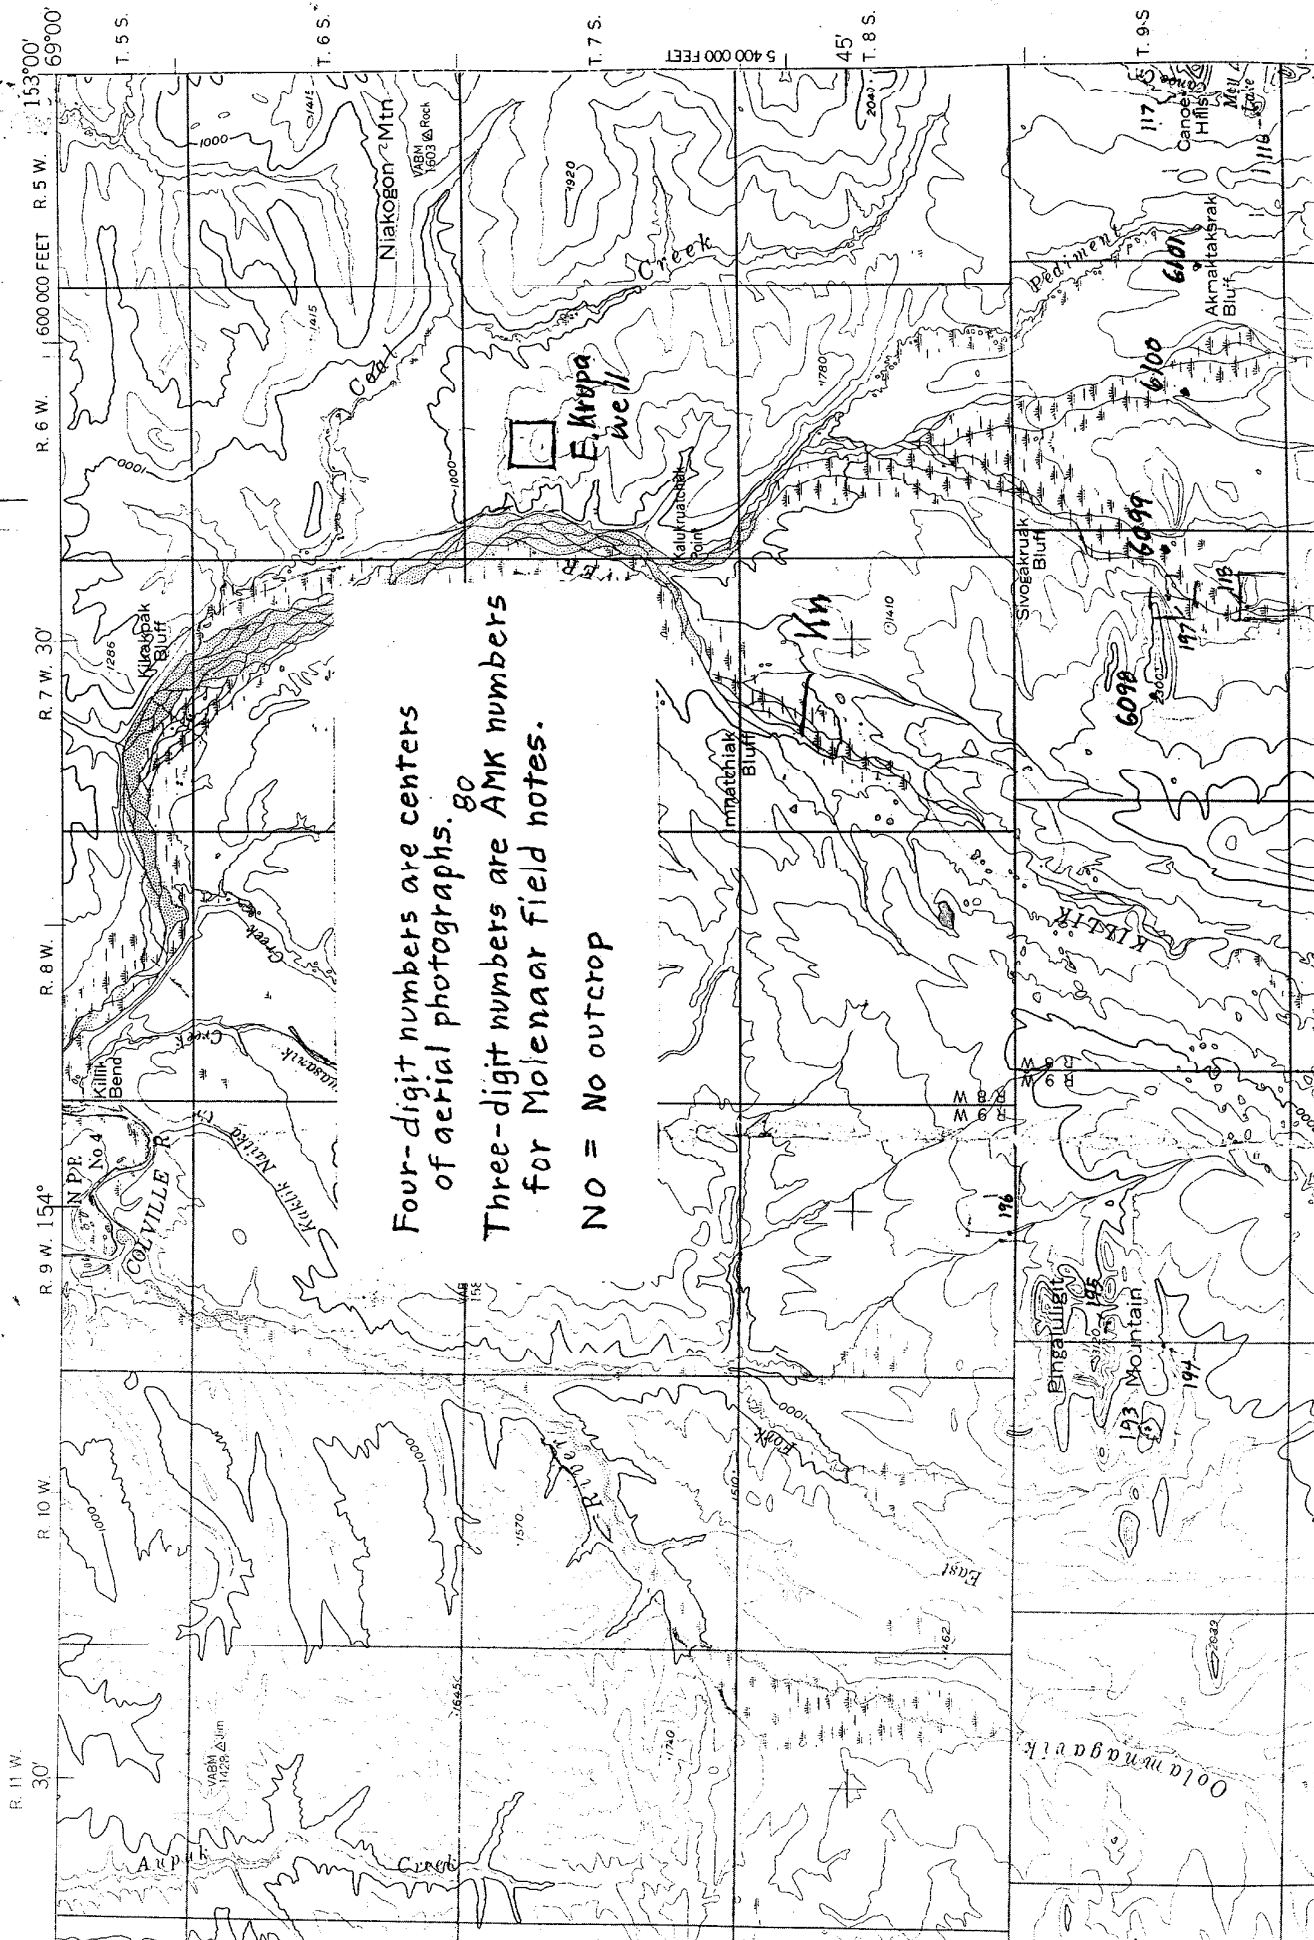

Four-digit numbers are centers  
of aerial photographs.<sup>80</sup>  
Three-digit numbers are AMK numbers  
for Molenaar field notes.  
NO = No outcrop

Killik River 1:250,000 NW

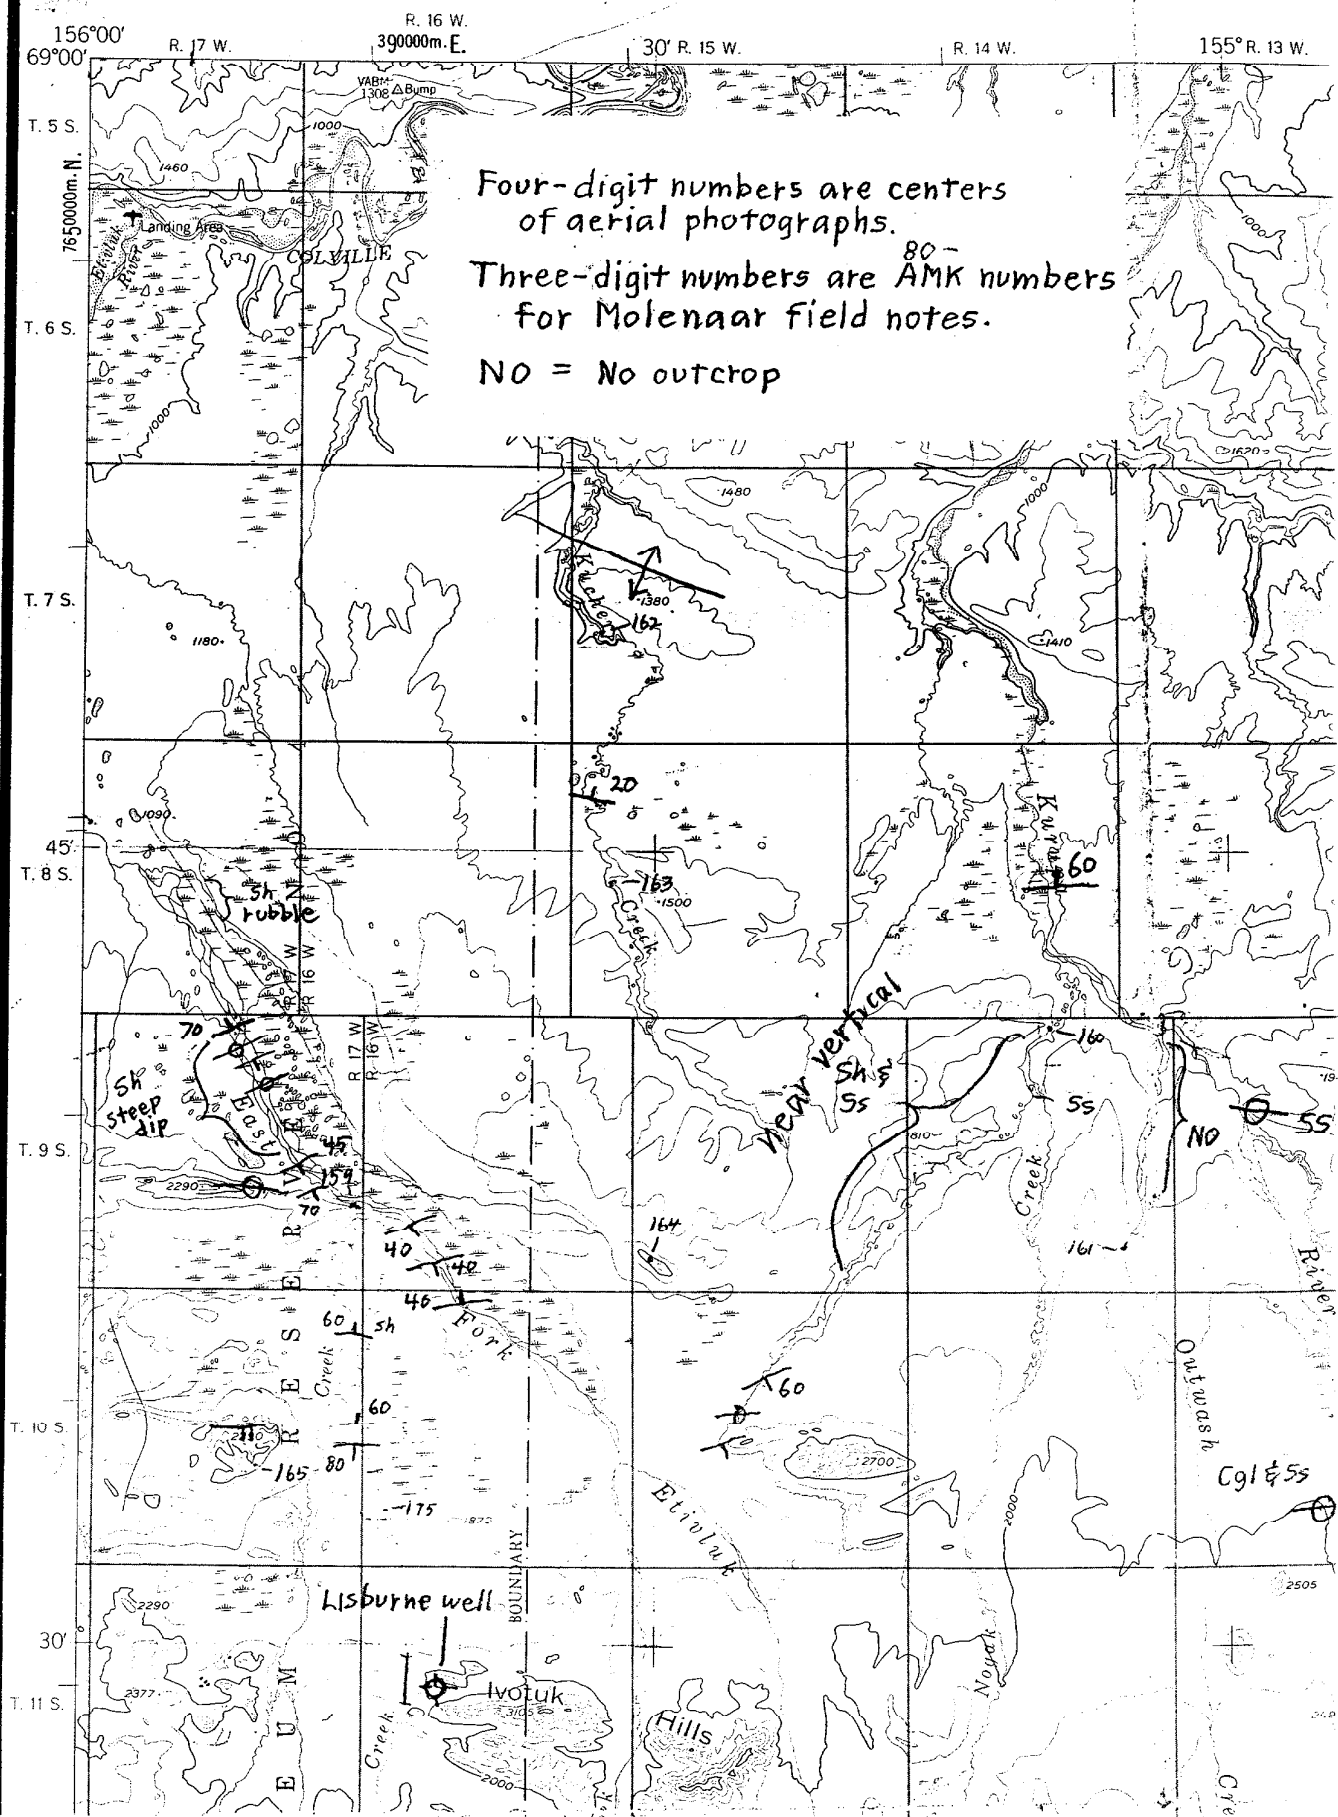

Four-digit numbers are centers  
of aerial photographs.  
Three-digit numbers are AMK numbers  
for Molenaar field notes.  
NO = No outcrop

1:250,000

Howard Pass

R. 22 W. 157°

R. 21 W.

R. 20 W.

R. 19 W.

R. 18 W.


156°00'

69°0'

Four-digit numbers are centers of aerial photographs.

Three-digit numbers are AMK numbers for Molenaar field notes.


NO = No outcrop

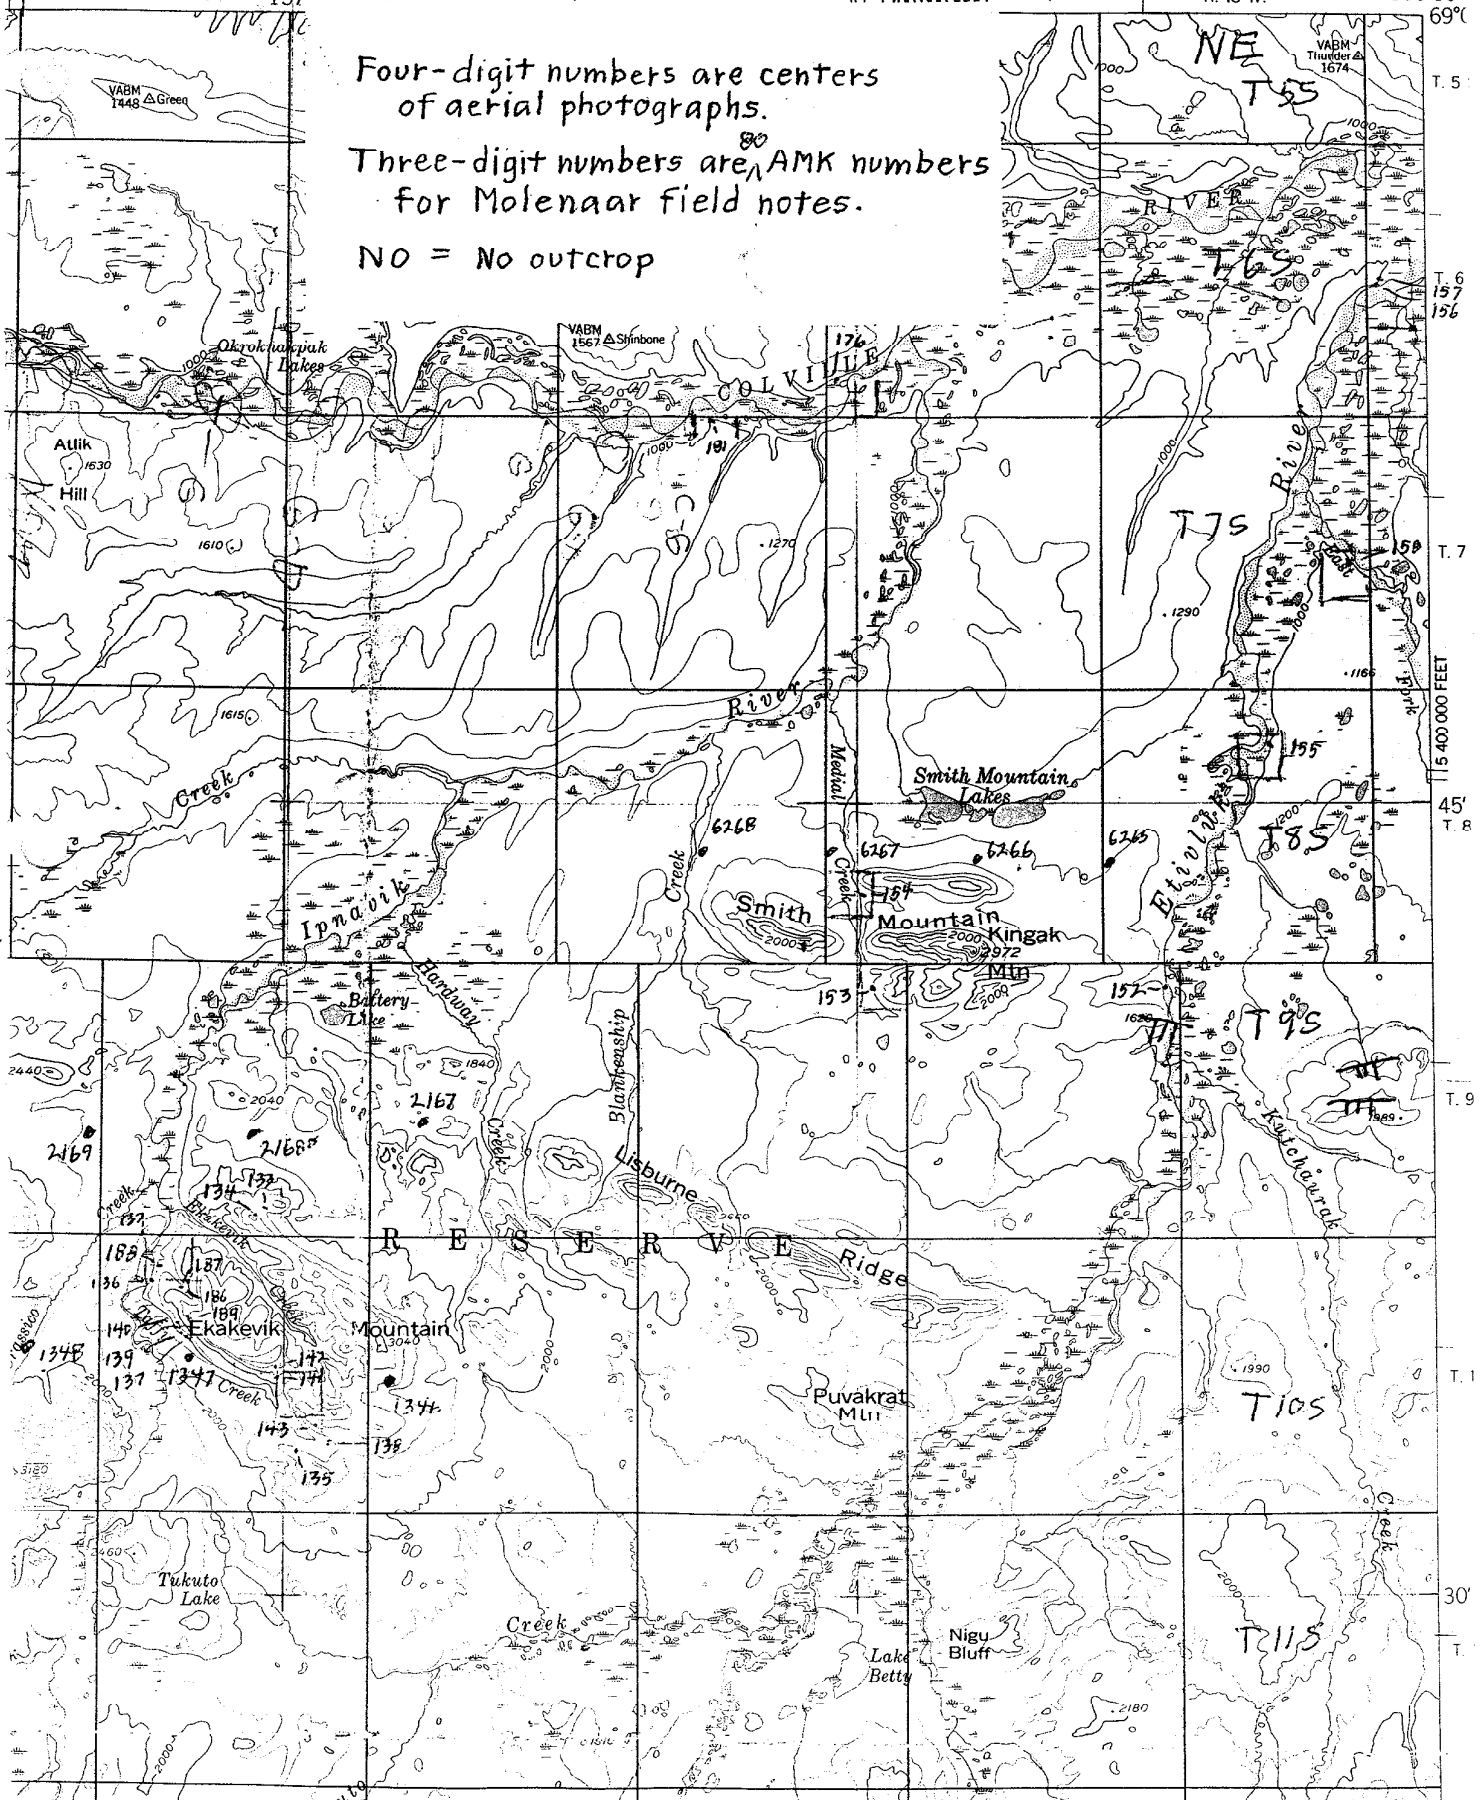


DEPARTMENT OF THE INTERIOR  
GEOLOGICAL SURVEY

110 W. AND 11 A

Howard Pass 1:250,000 NW

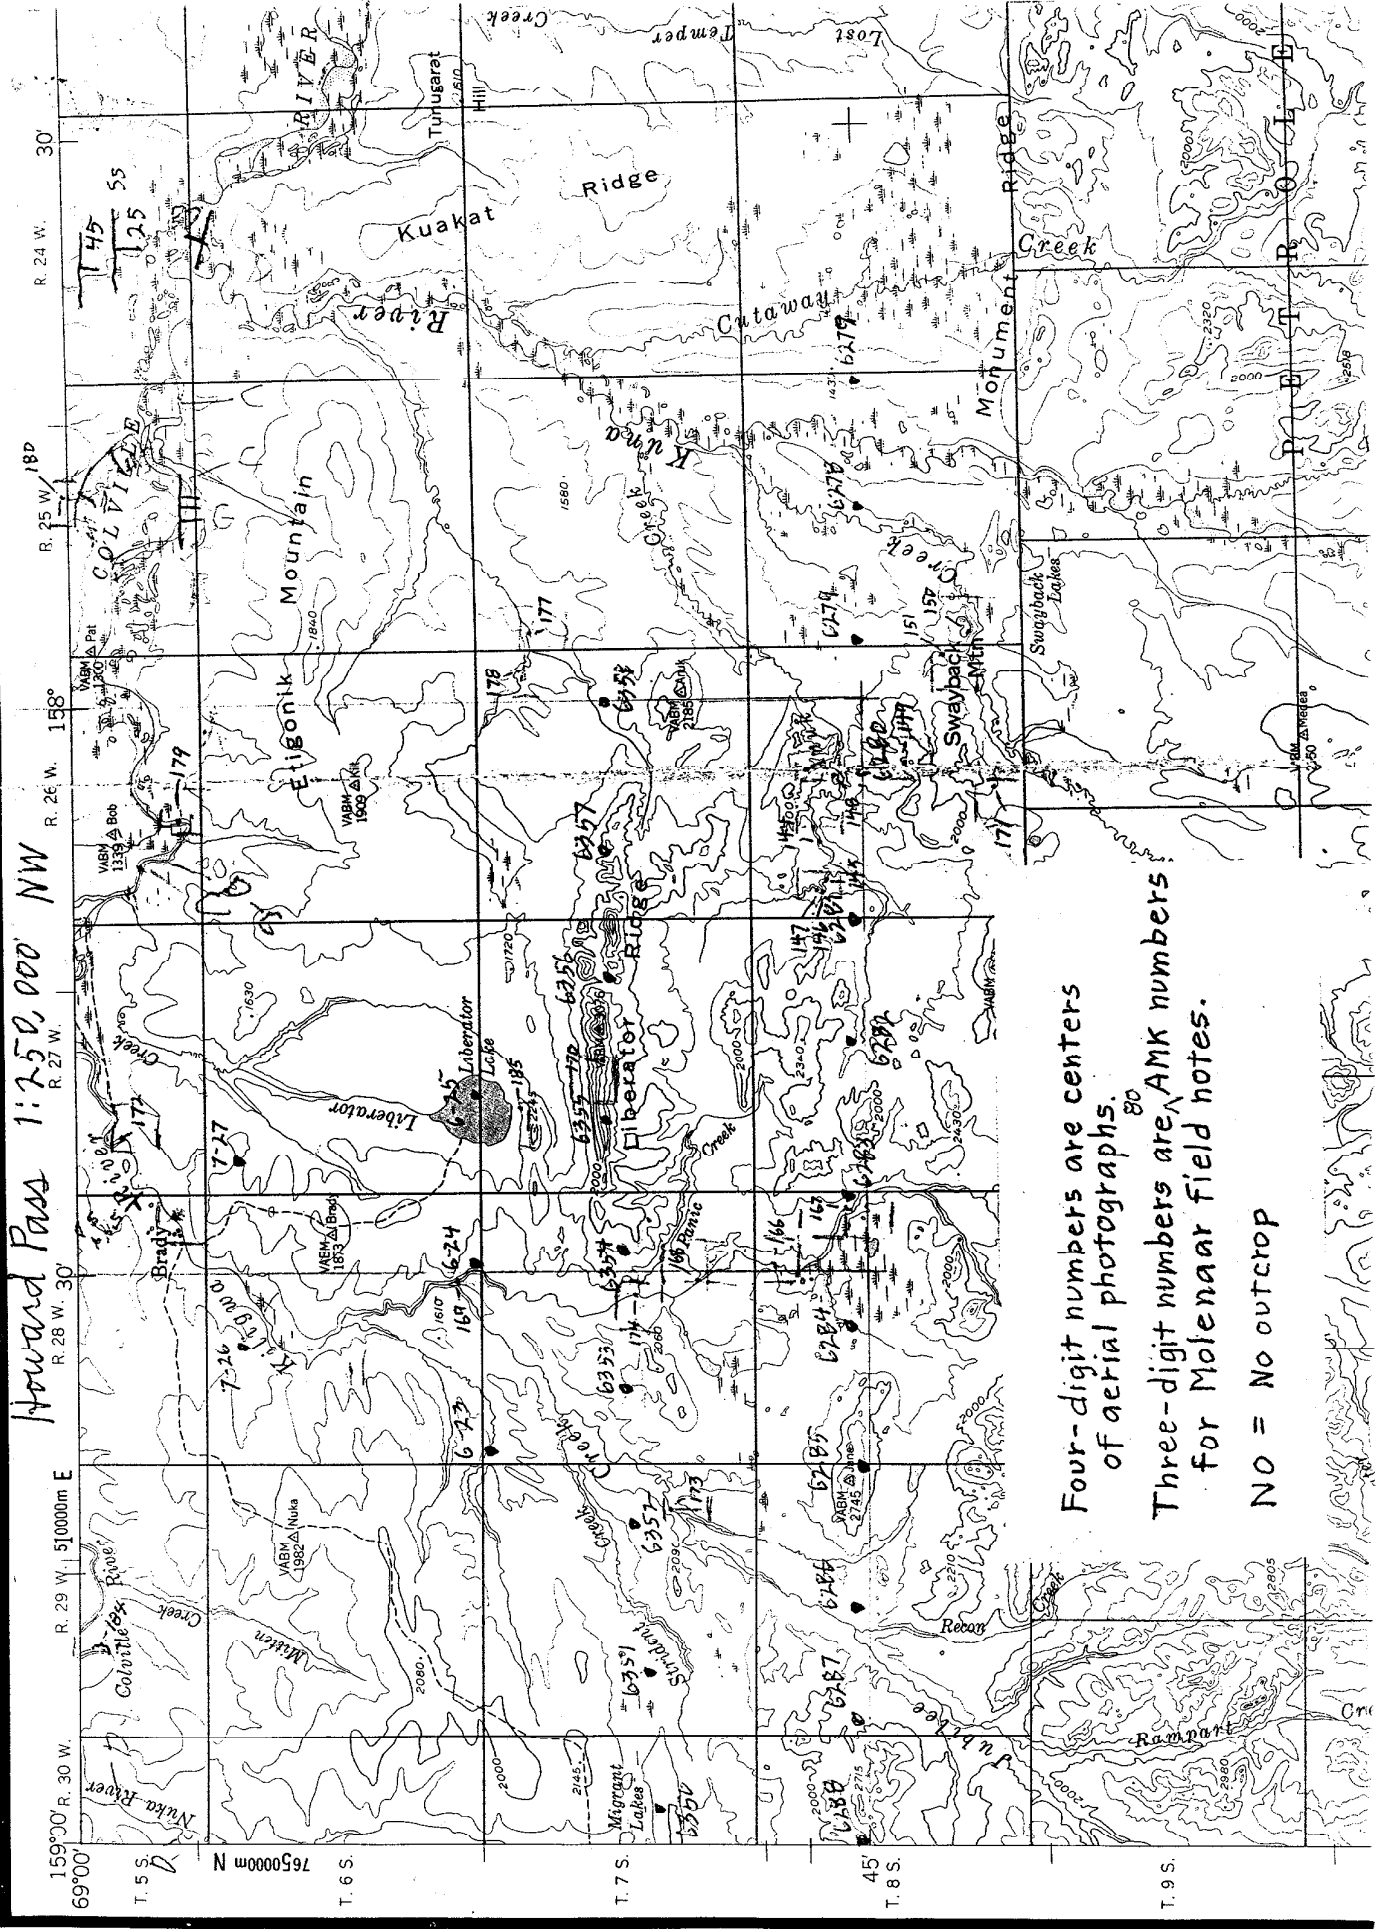

Four-digit numbers are centers  
of aerial photographs.  
Three-digit numbers are AMK numbers  
for Molenaar field notes.  
NO = No outcrop

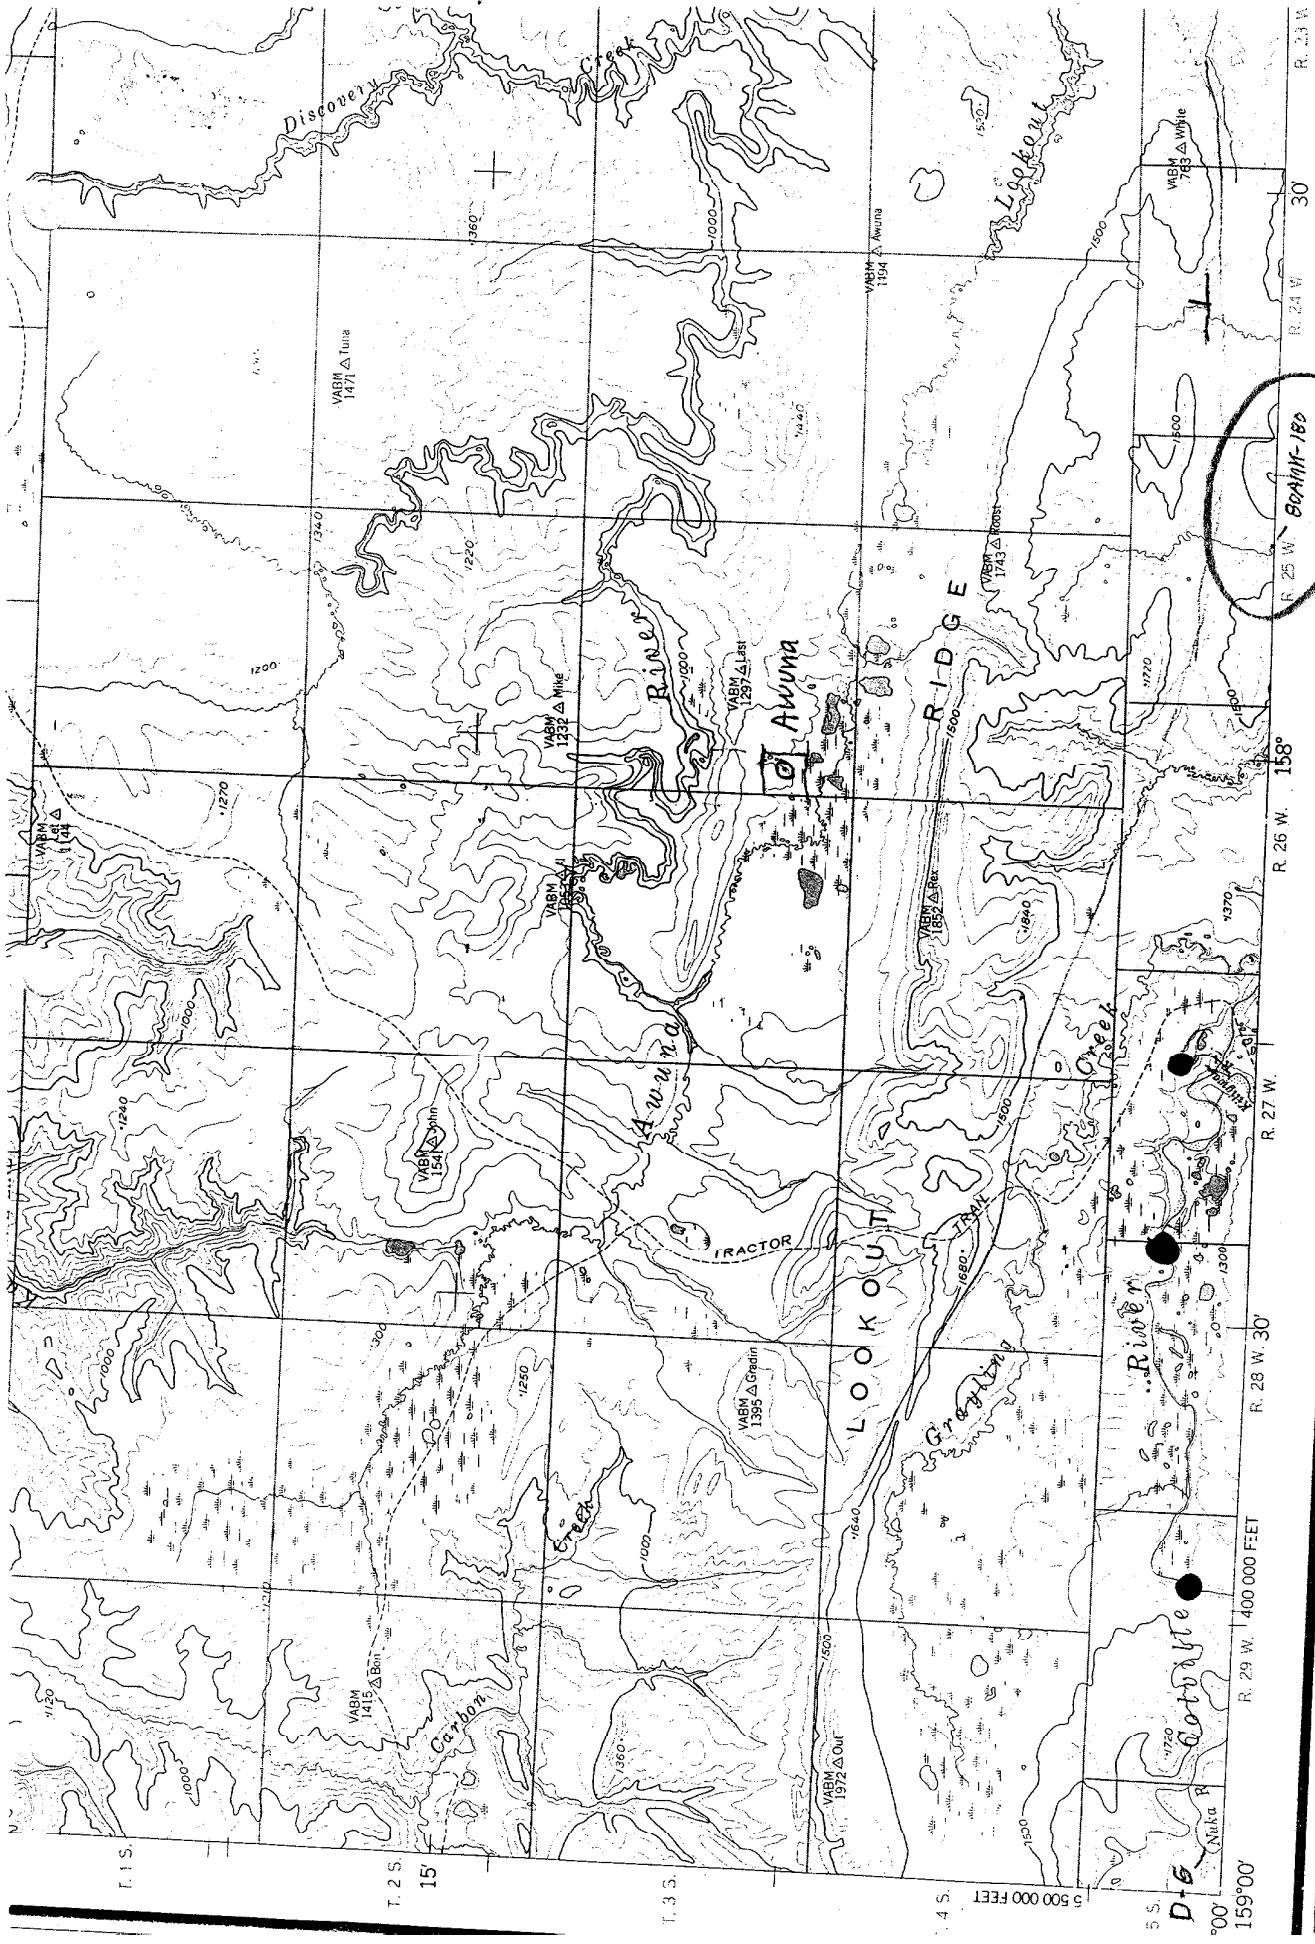


**Lookout Ridge (SW)**

D, EDITED, AND PUBLISHED BY THE GEOLOGICAL SURVEY  
 BY USGS, USC&GS, AND USCE  
 PHOTODUPLICATION METHODS FROM AERIAL PHOTOGRAPHS  
 55, AND 1956. FIELD ANNOTATED 1956. MAP NOT FIELD CHECKED  
 1 TRANSFERRED FROM

SCALE 1:250,000




Misheguk Mtn. 1:250,000 NE  
ALASKA TOPOGRAPHIC SERIES

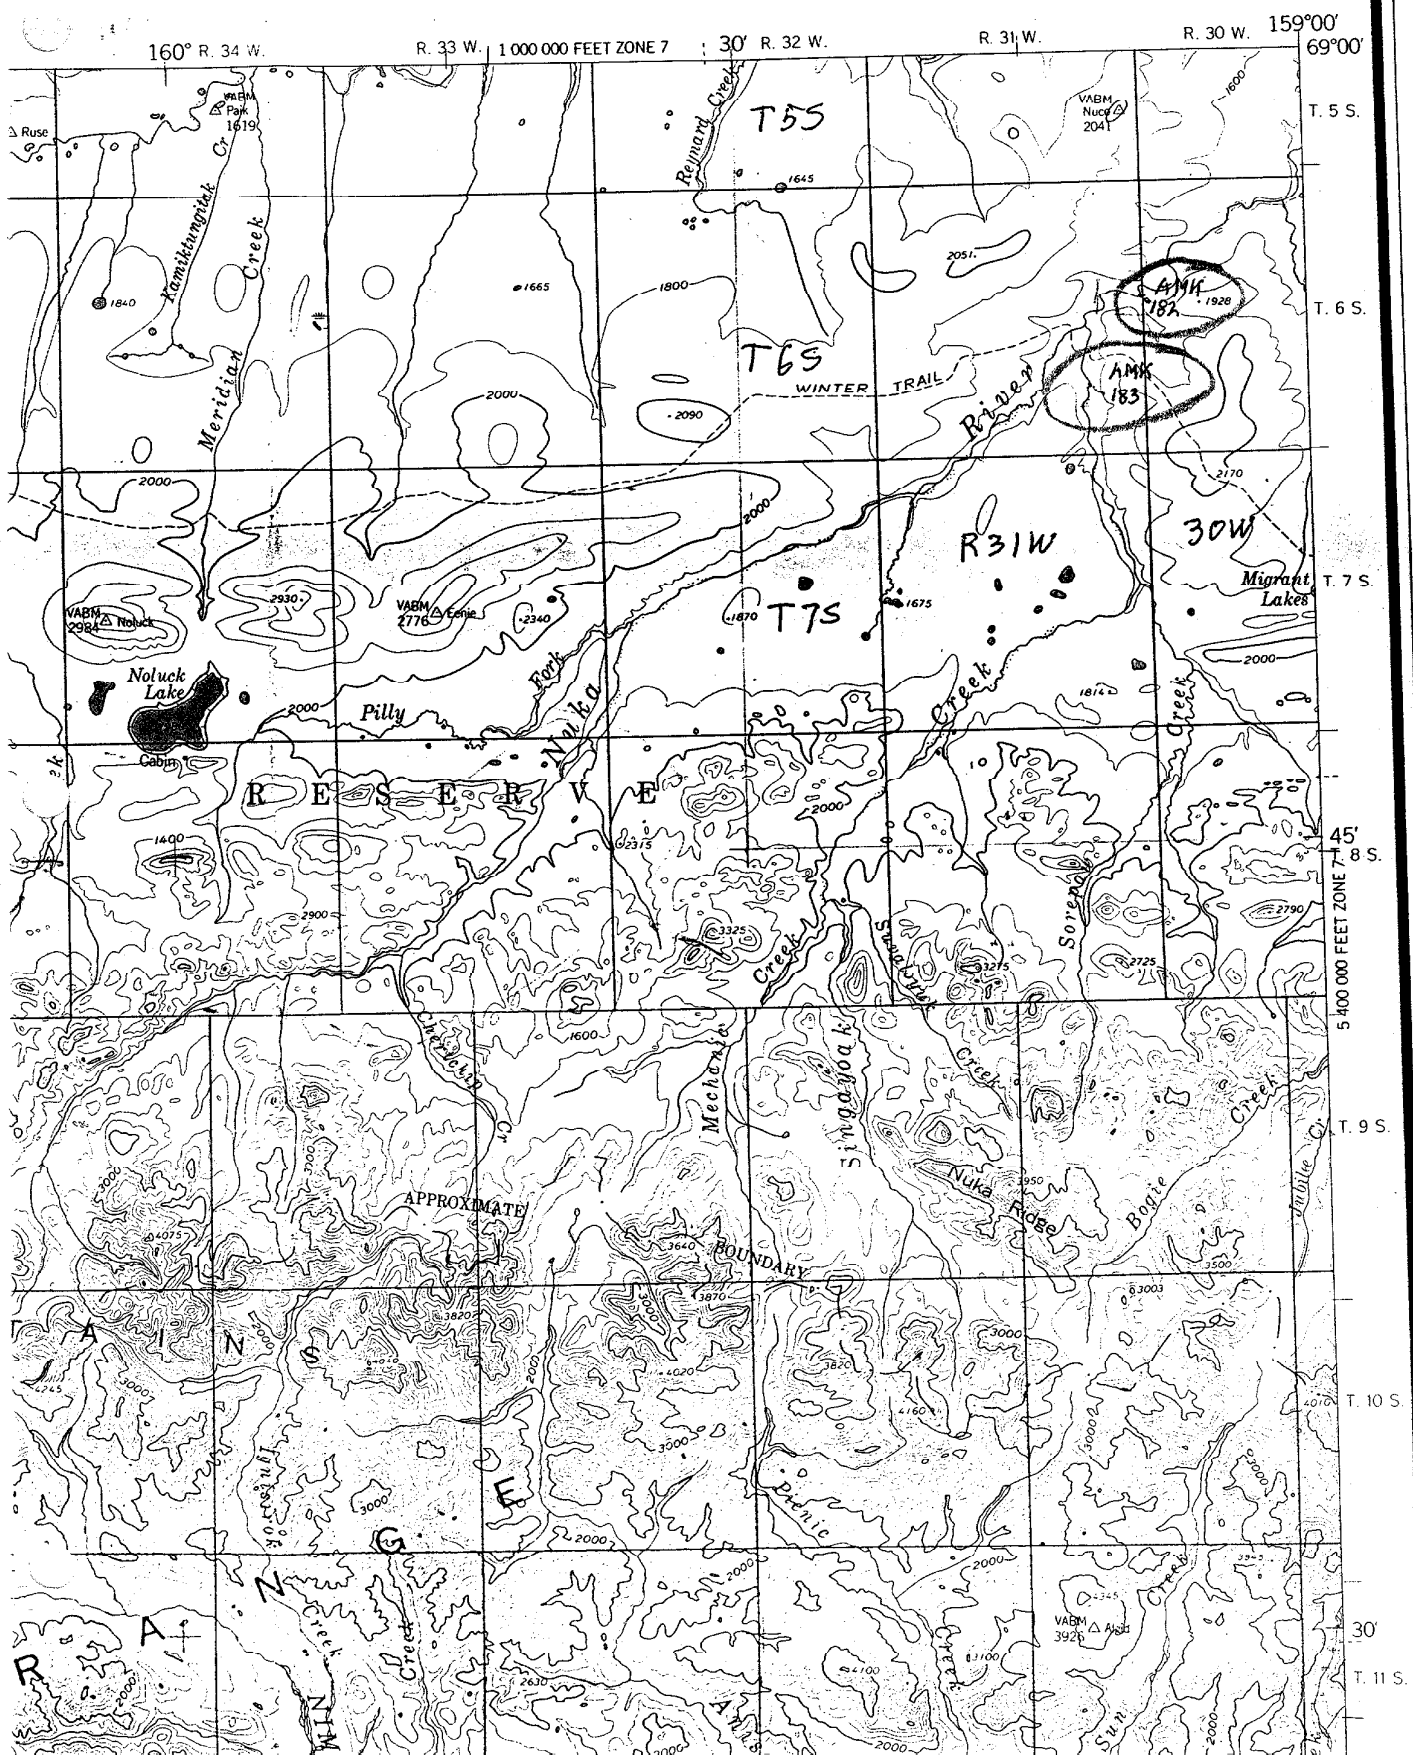



De Long Mtns 1:250,000

ALASKA  
TOPOGRAPHIC SERIES  
NE

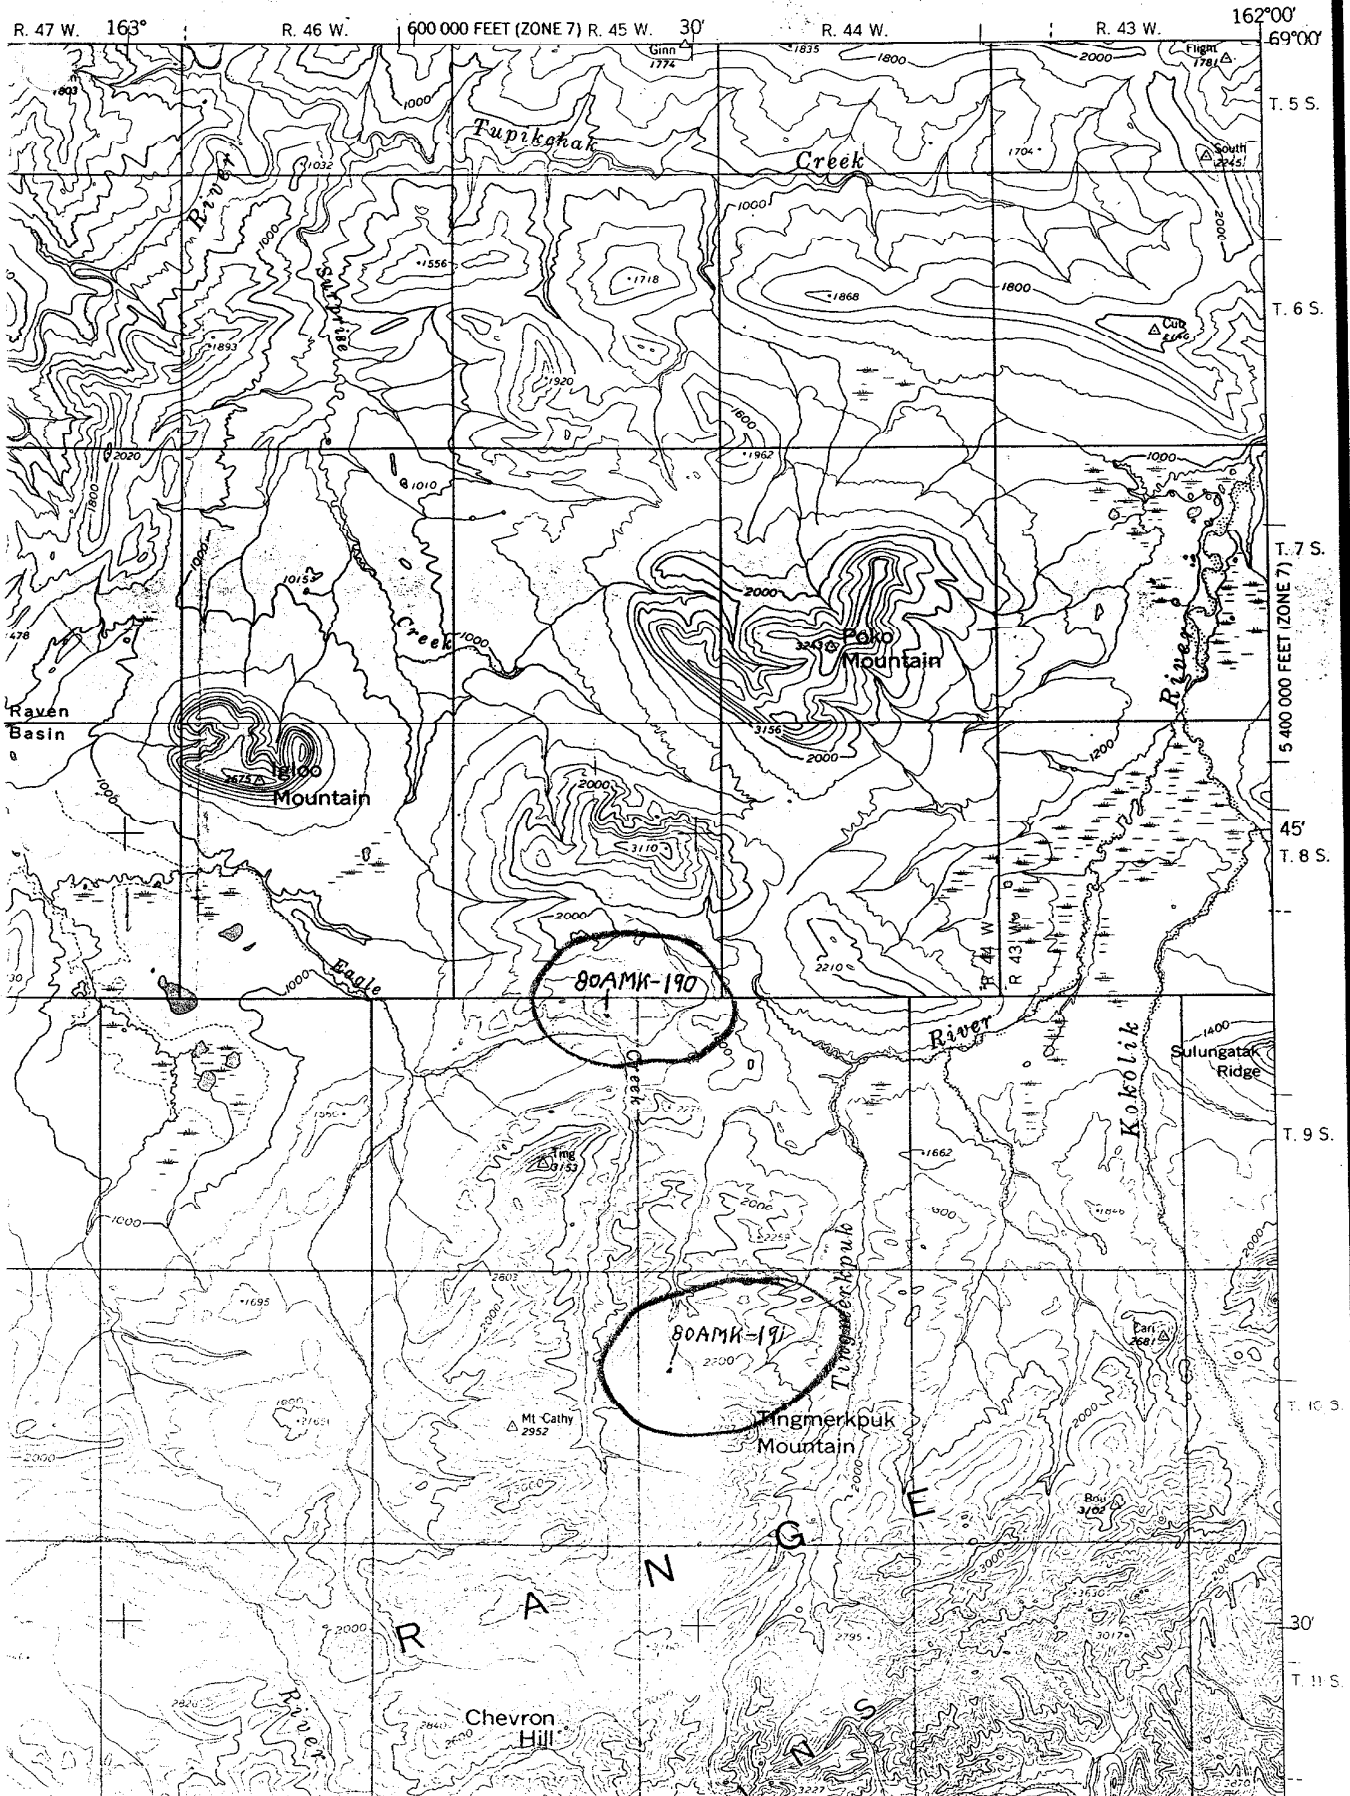

# DE LONG MOUNTAINS

1:250,000 N-central part

Chevron Akulik

